
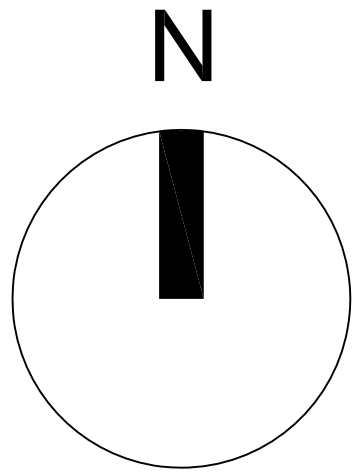
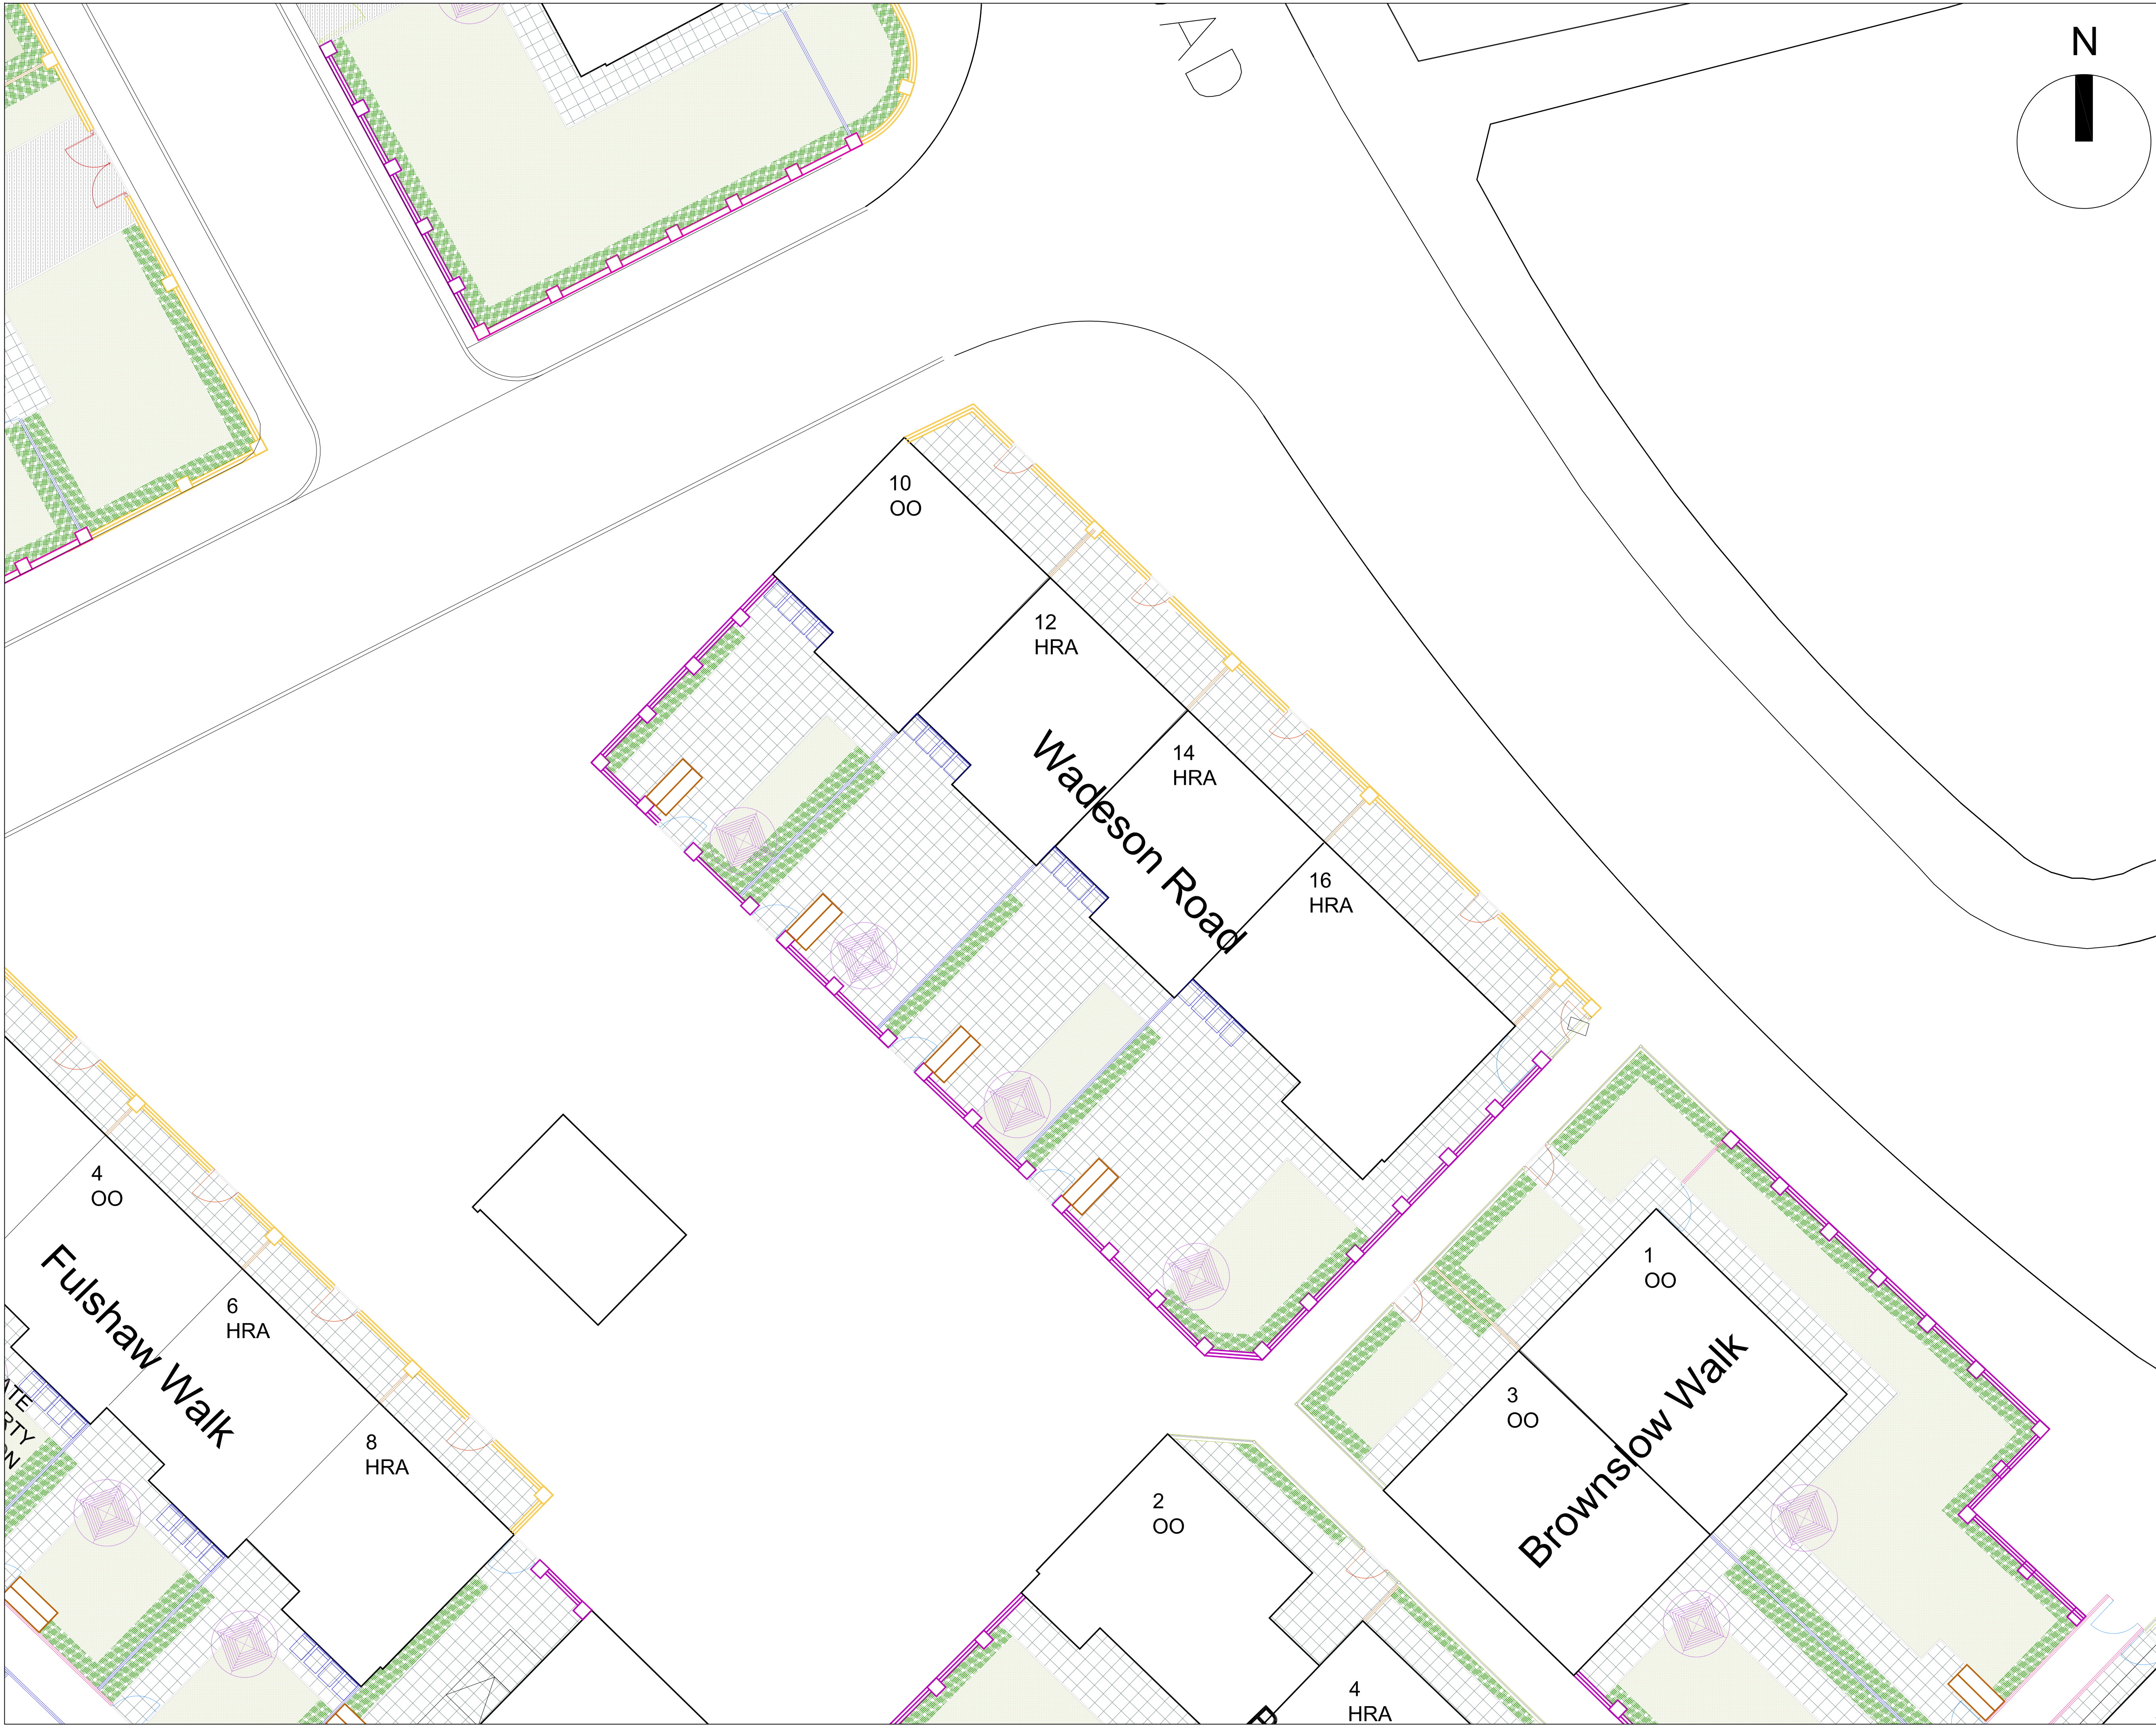
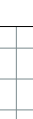
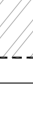
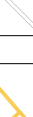
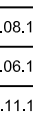


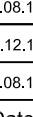

Do not scale from this drawing. All dimensions should be checked on site.
Refer to architects for further information.

- | | |
|---|--|
|  | Proposed Turf / Grass Seeding. 150mm Depth of Topsoil. Refer to Spec Items Q28 & Q30 |
|  | Proposed Planting Bed. 600mm Depth of Topsoil. Refer to Spec Items Q28 & Q31 |
|  | Proposed Concrete Flag Paving. Refer to Spec Item Q25 |
|  | Proposed Footpath Bitmac Paving. Refer to Spec Item Q22 |
|  | Proposed Concrete Block Paving. Refer to Spec Item Q25. Works by others. |
|  | Proposed Vehicular Bitmac Paving. Refer to Spec Item Q22. Works by others. |
|  | Proposed Footpath Bitmac Paving. Refer to Spec Item Q22. Works by others. |
|  | Proposed Concrete Pin Kerb. Refer to Spec Item Q10 |
|  | Low Brick Walls and Railings, Built on New Foundations and DPC. New Engineering/Facing Brick. Refer to Spec Item F10 |
|  | Proposed 2.1m High Brick Piers, Low Walls and Timber Panels, Built on New Foundation and DPC. New Engineering/Facing Brick. Refer to Spec Item F10 |
|  | Proposed 1m High Timber Front Divisional Fencing. Refer to Spec Item Q40 and Drawing 302 |
|  | Proposed 1.8m High Rear Divisional Timber Fencing to Rear Gardens. Refer to Spec Item Q40 and Drawing 306 |
|  | Proposed 1.8m High Rear Boundary Timber Fencing to Rear Gardens. Refer to Spec Item Q40 and Drawing 306 |
|  | Proposed 1.8m High Timber Driveway Gates Refer to Spec Item Q40. |
|  | Proposed 1m High Double Leaf Metal Gates to Front Gardens. Refer to Spec Item Q40 |
|  | Timber Sheds. Refer to Spec Item B91 |
|  | Rotary Washing Lines. Refer to Spec Item Q50 |
|  | Wheelie Bins |
|  | Existing Tree, Retained and Protected to BS 5837:2012 |

C05	10.08.16	As Built	JPF	WGC
C04	13.08.16	As Built	JPF	WGC
C03	07.11.17	Updated for As Built Information	DCS	WGC
C02	16.08.16	Highway Design Added	JPF	WGC
C01	02.12.14	Front boundary changed back to existing line	JPF	WGC
C00	15.08.14	Draft Issue for Comment	JPF	WGC
Rev	Date	Detail	Made	Chk'd/As'd

Clients:

Mears Construction

Project

Mears Brunswick PFI

Title:

Proposed
Wadeson Road 10-16

Design: MS	Sheet Size - A1 (594mm x 841mm)
Drawn: JPF	
Chk'd: WGC	Date: 14.08.14
App'd: JG	Scale: 1:100

GILLESPIES

GILLESPIES LLP
Westgate House
44 Hale Road
Hale
Cheshire
WA14 2EX

T: 0161 928 7715
F: 0161 927 7680
E: admin.manchester@gillespies.co.uk

File Location	R:\M5115 Mears Brunswick PF\Drawings\CAD	
No.	M5115-237-22	Rev: CC