




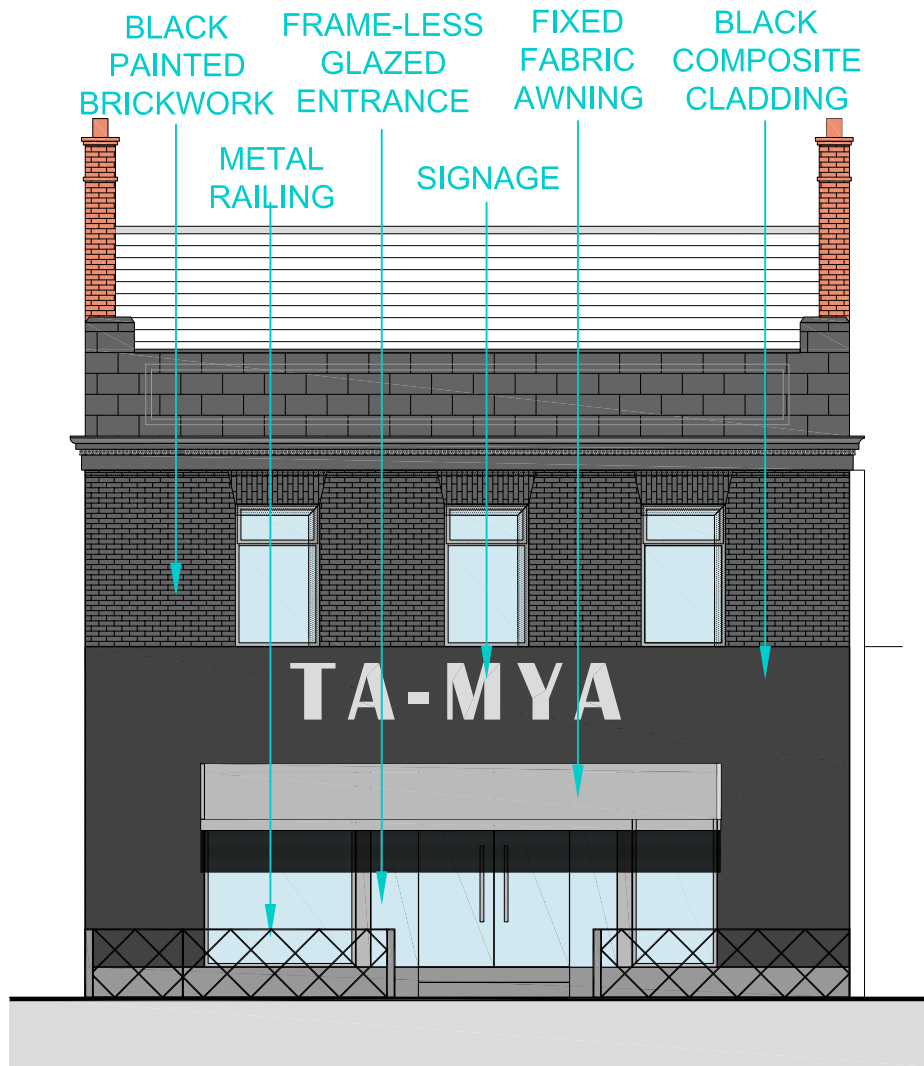


AS-BUILT FRONT ELEVATION
Scale 1:100@A1

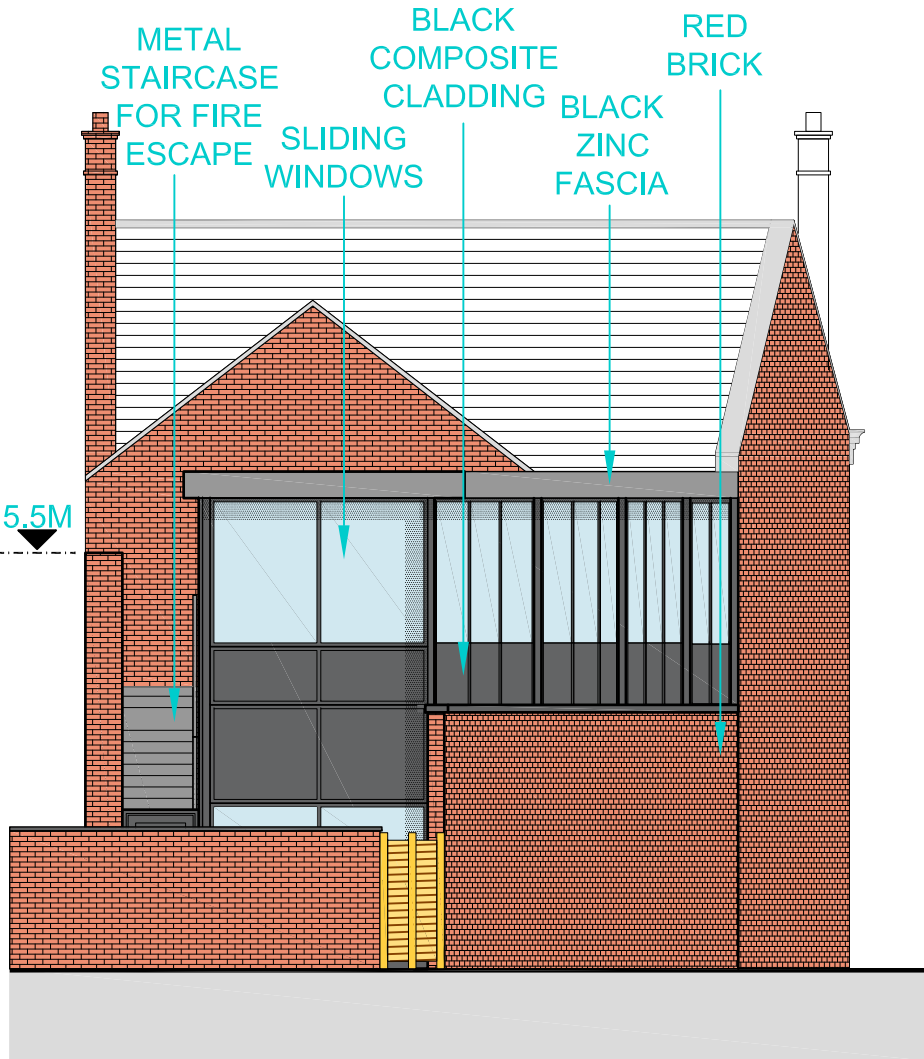


AS-BUILT REAR ELEVATION
Scale 1:100@A1

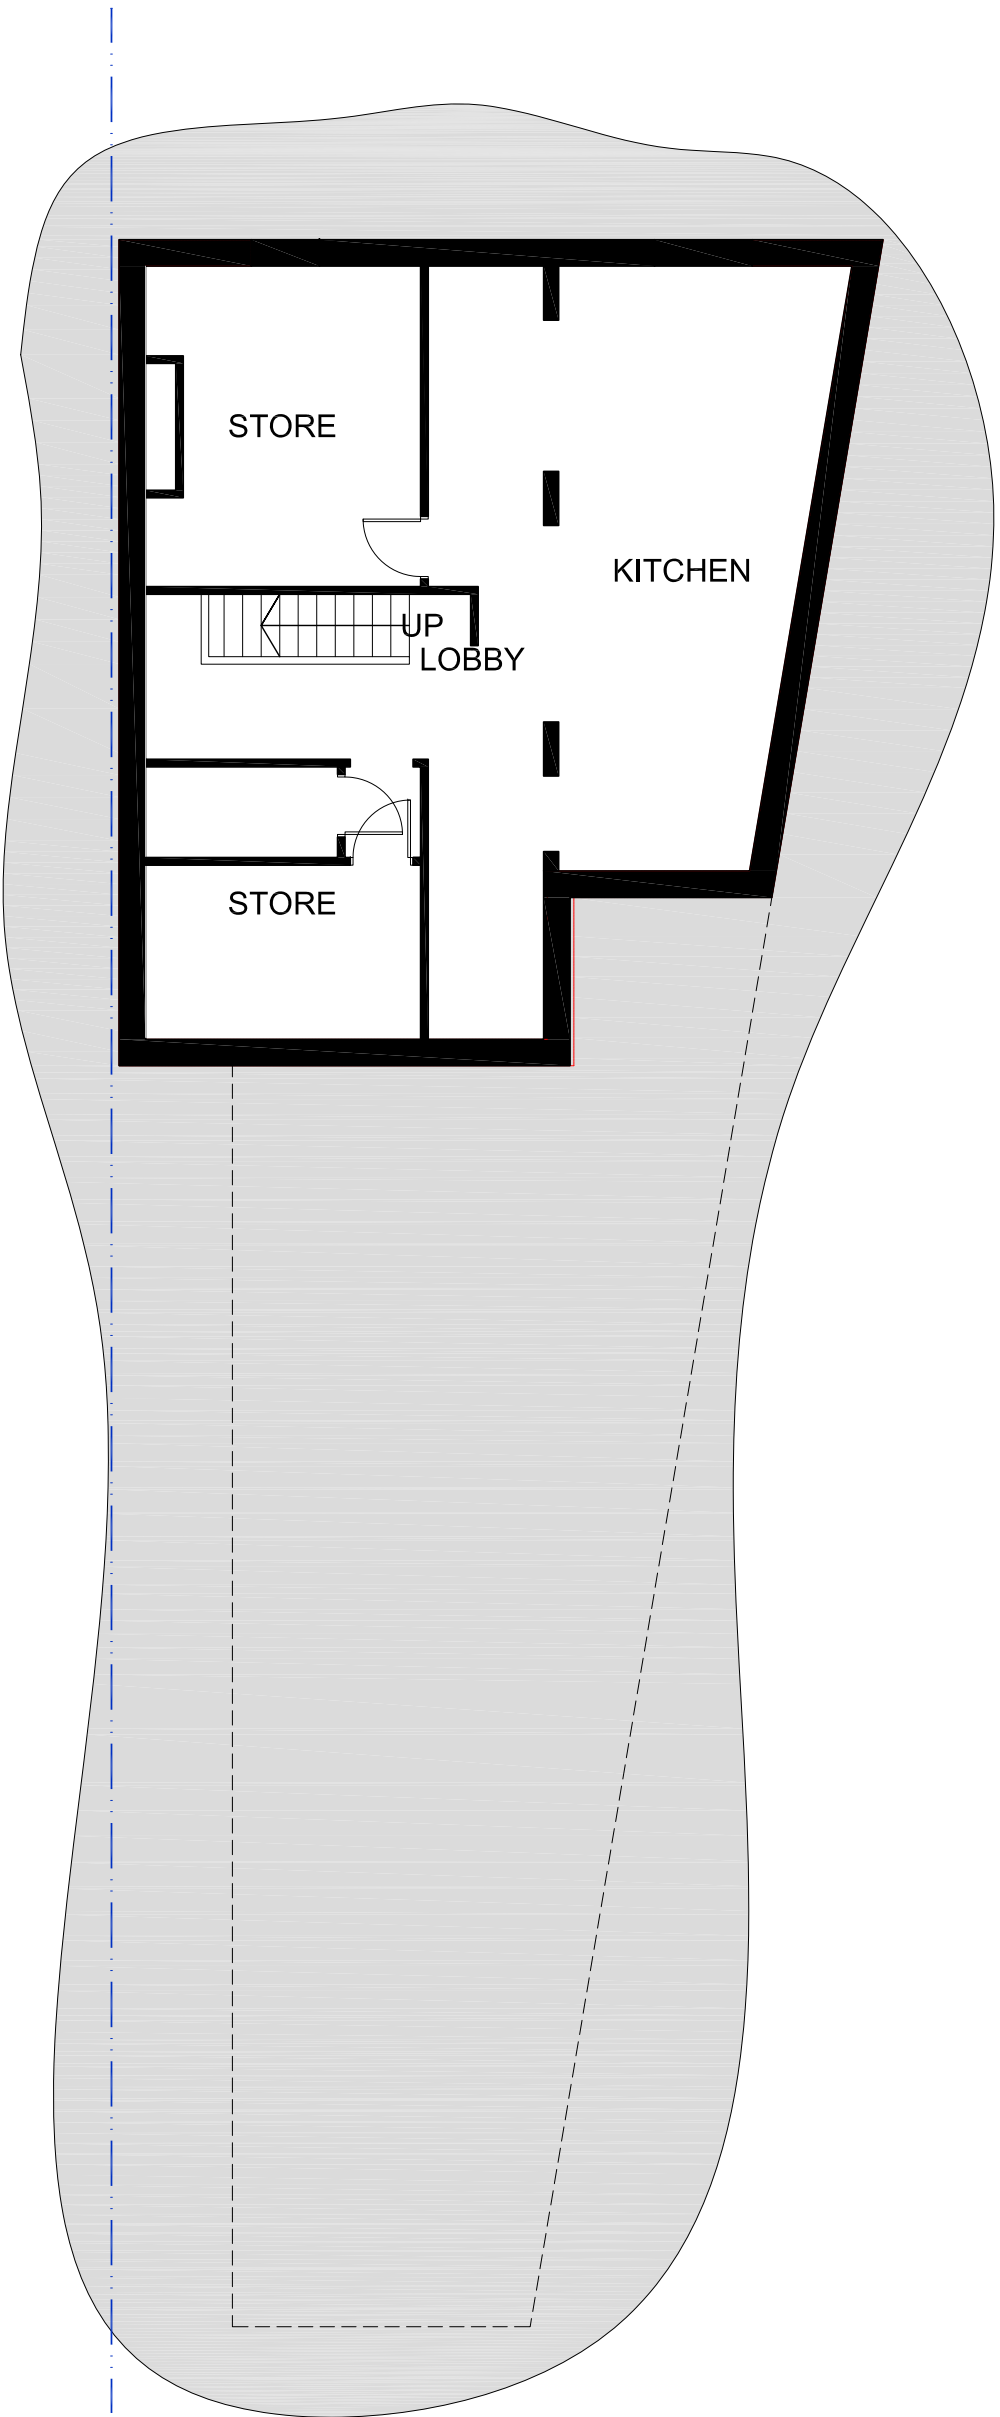


AS-BUILT BASEMENT FLOOR PLAN
Scale 1:100@A1

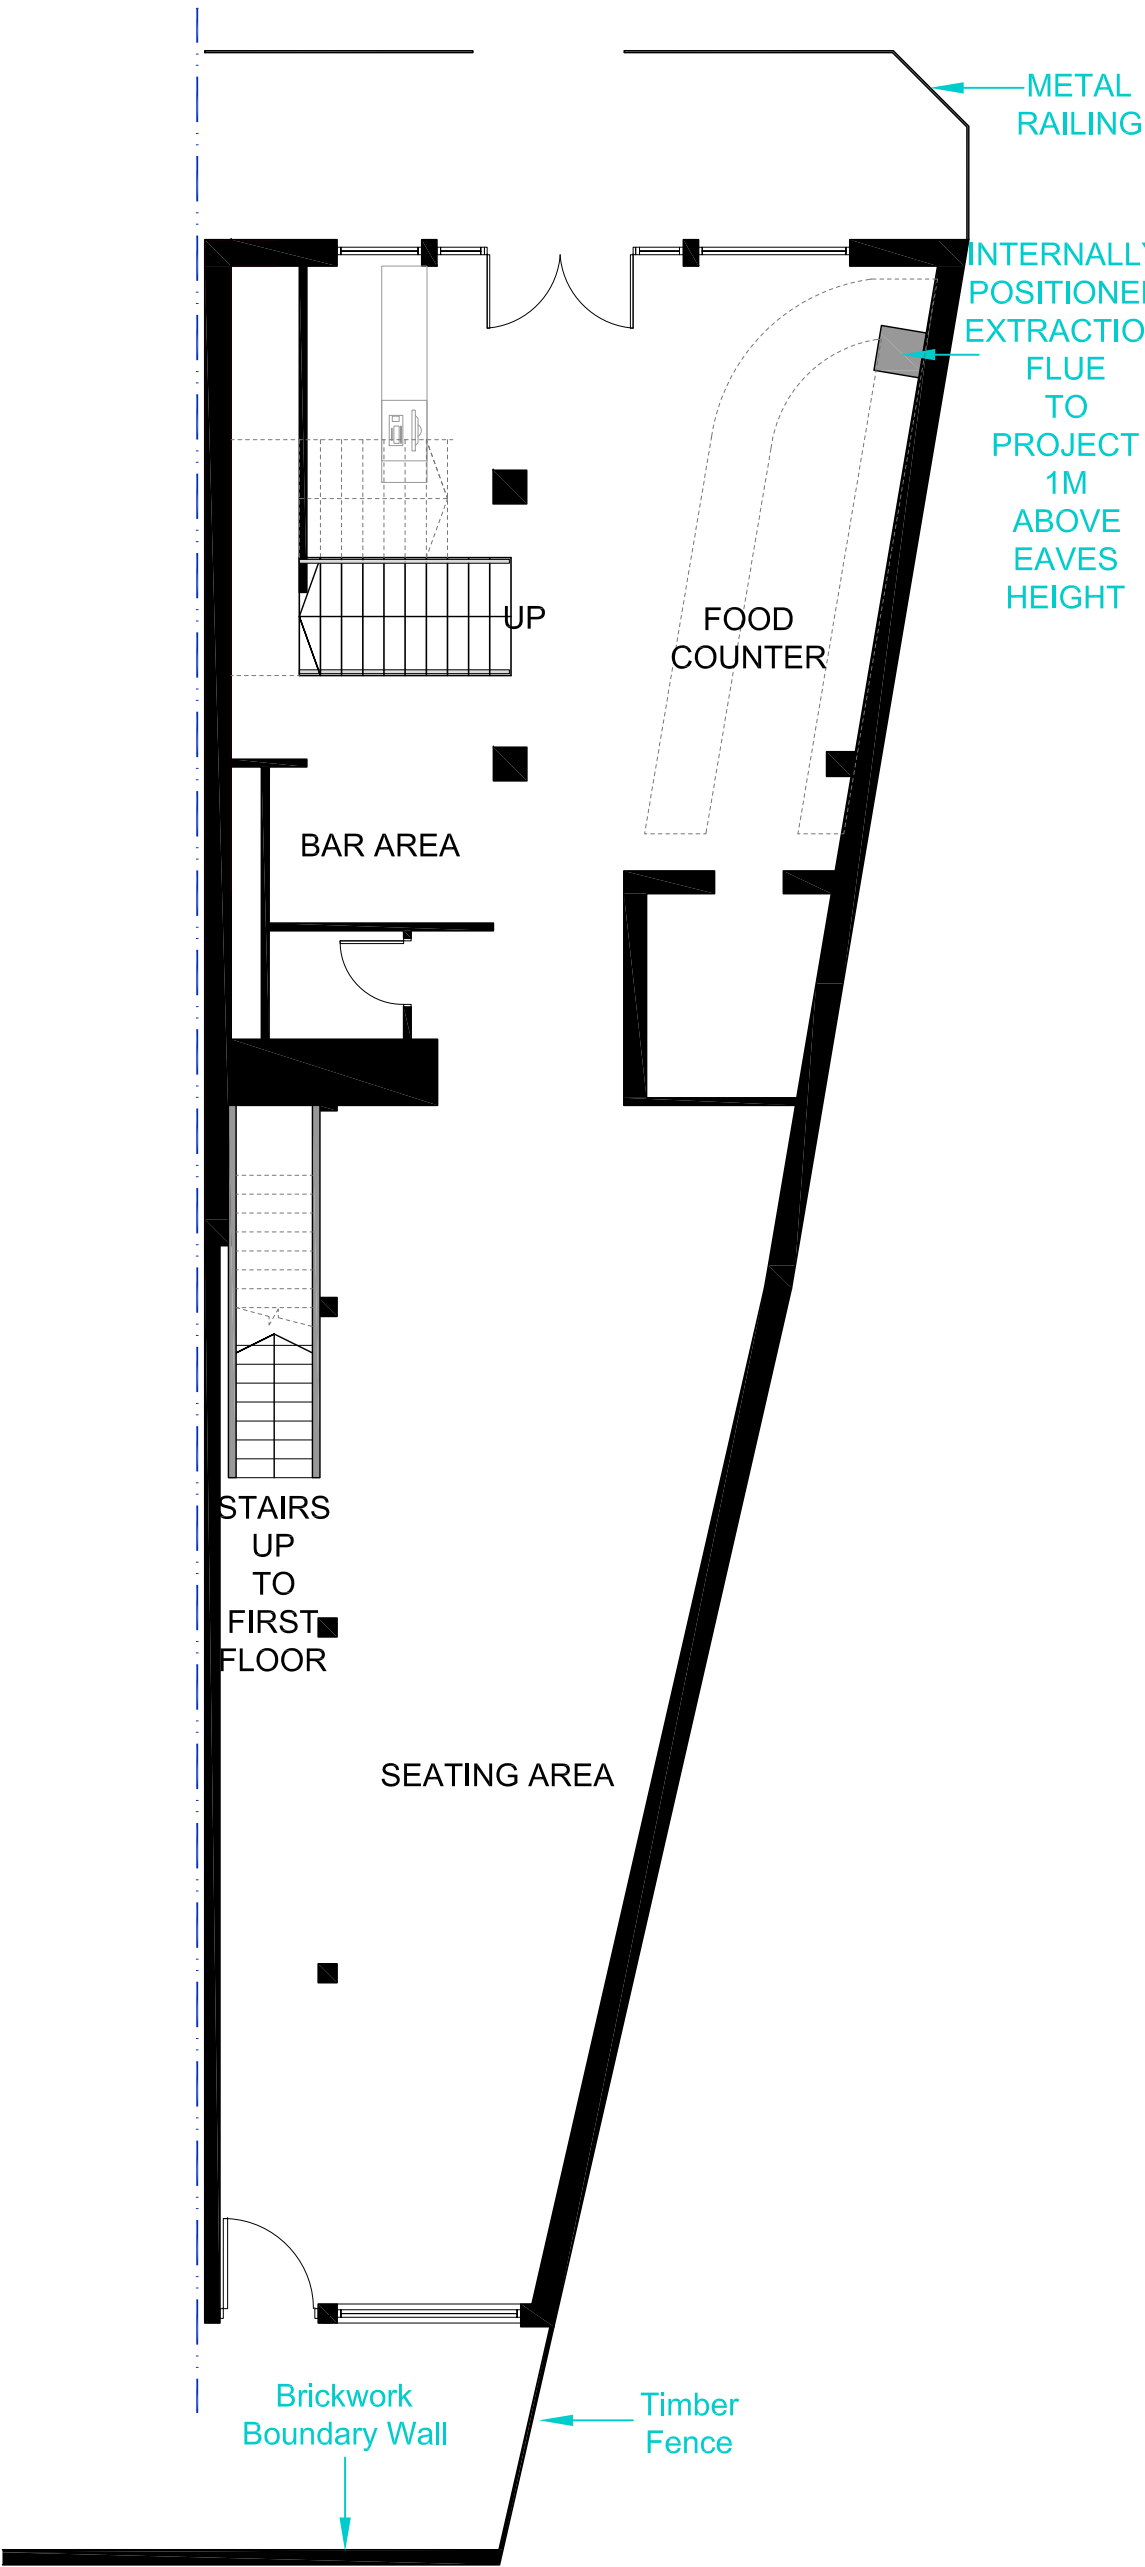


AS-BUILT GROUND FLOOR PLAN
Scale 1:100@A1

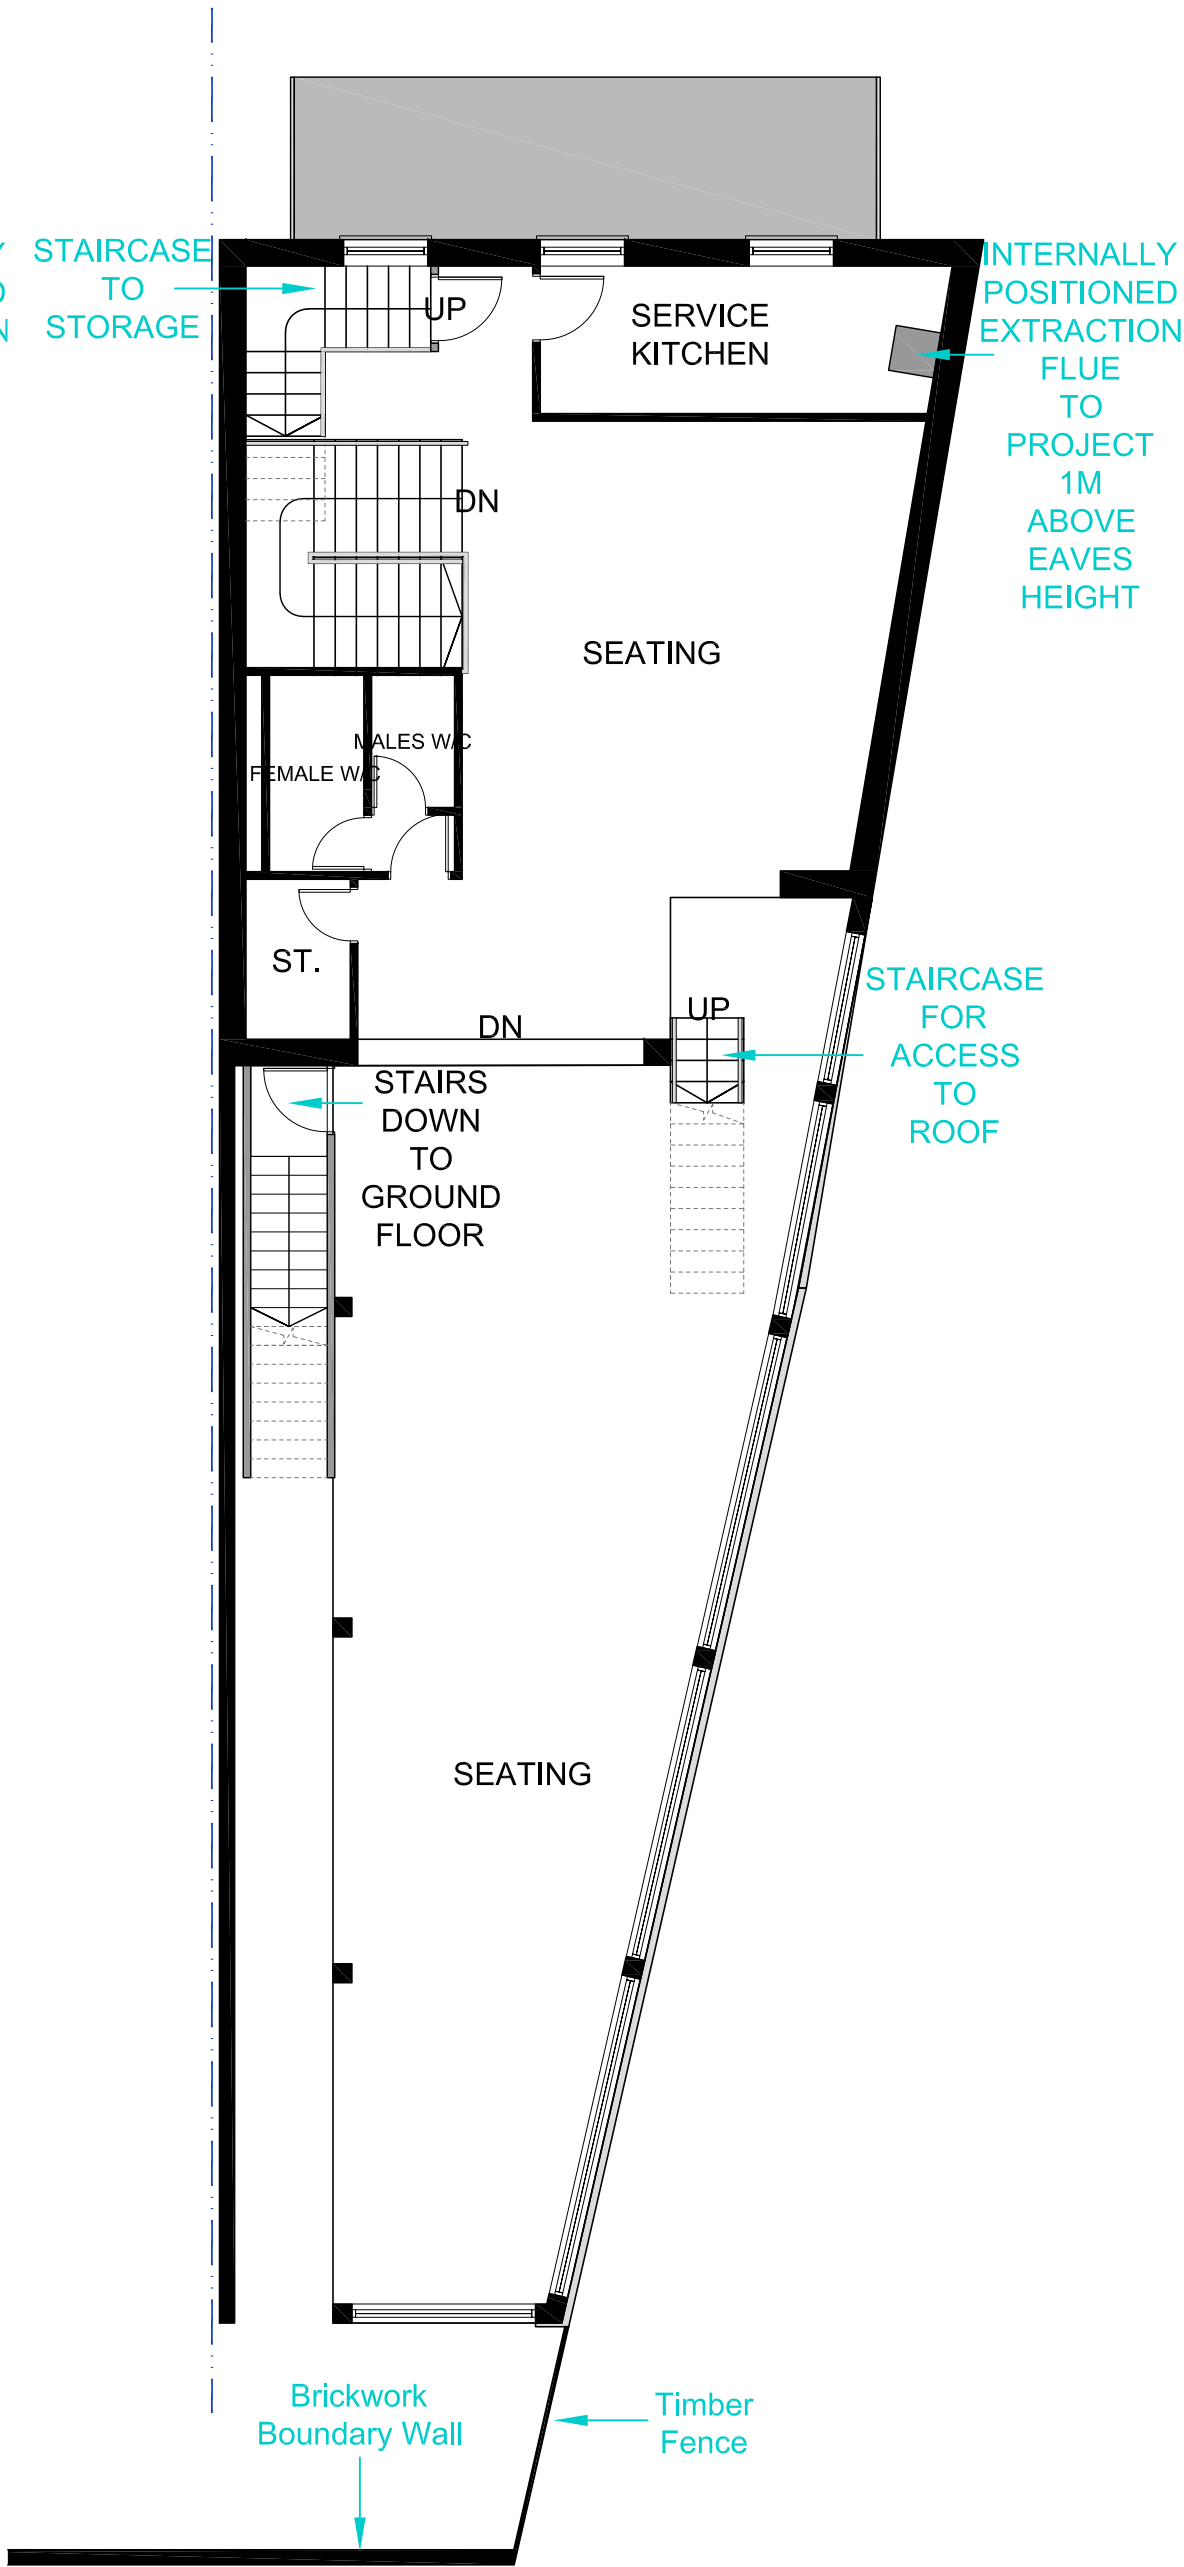


AS-BUILT FIRST FLOOR PLAN
Scale 1:100@A1

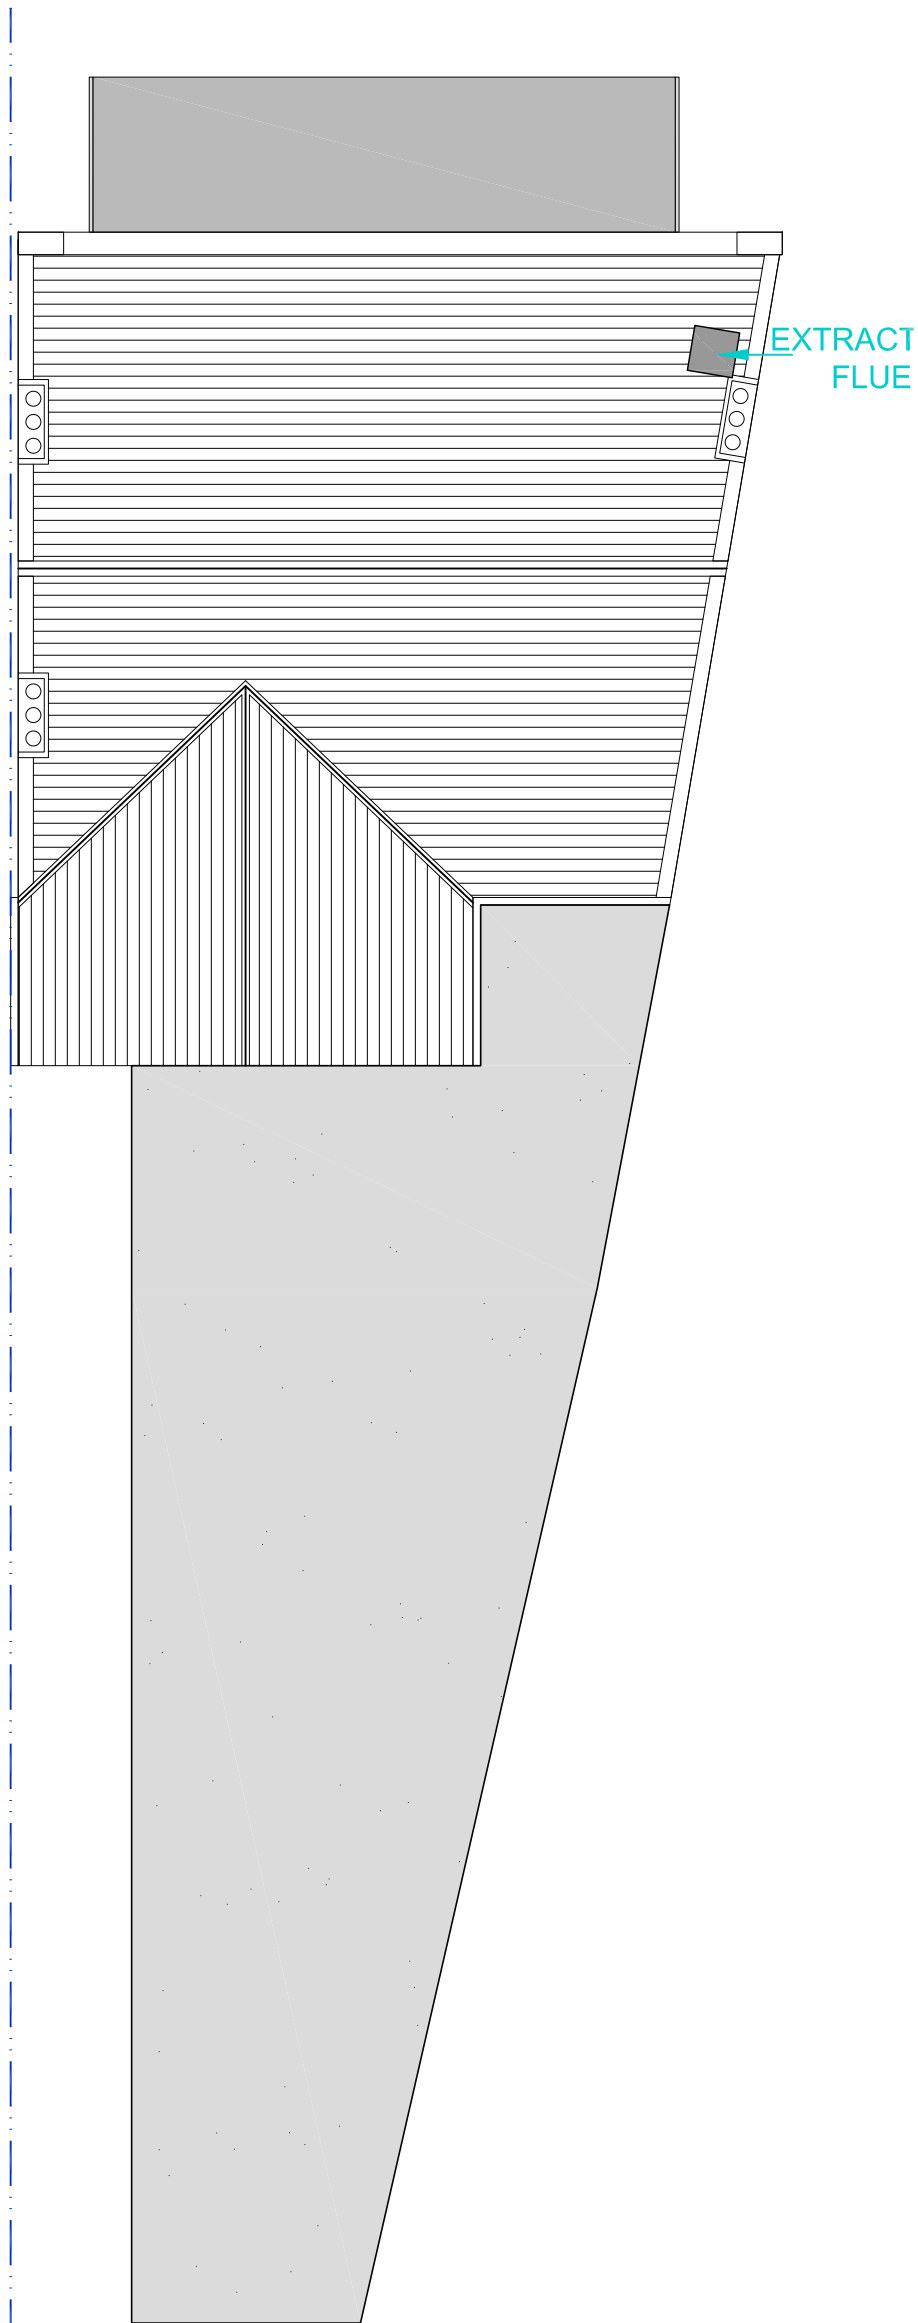

AS-BUILT ROOF PLAN
Scale 1:100@A1

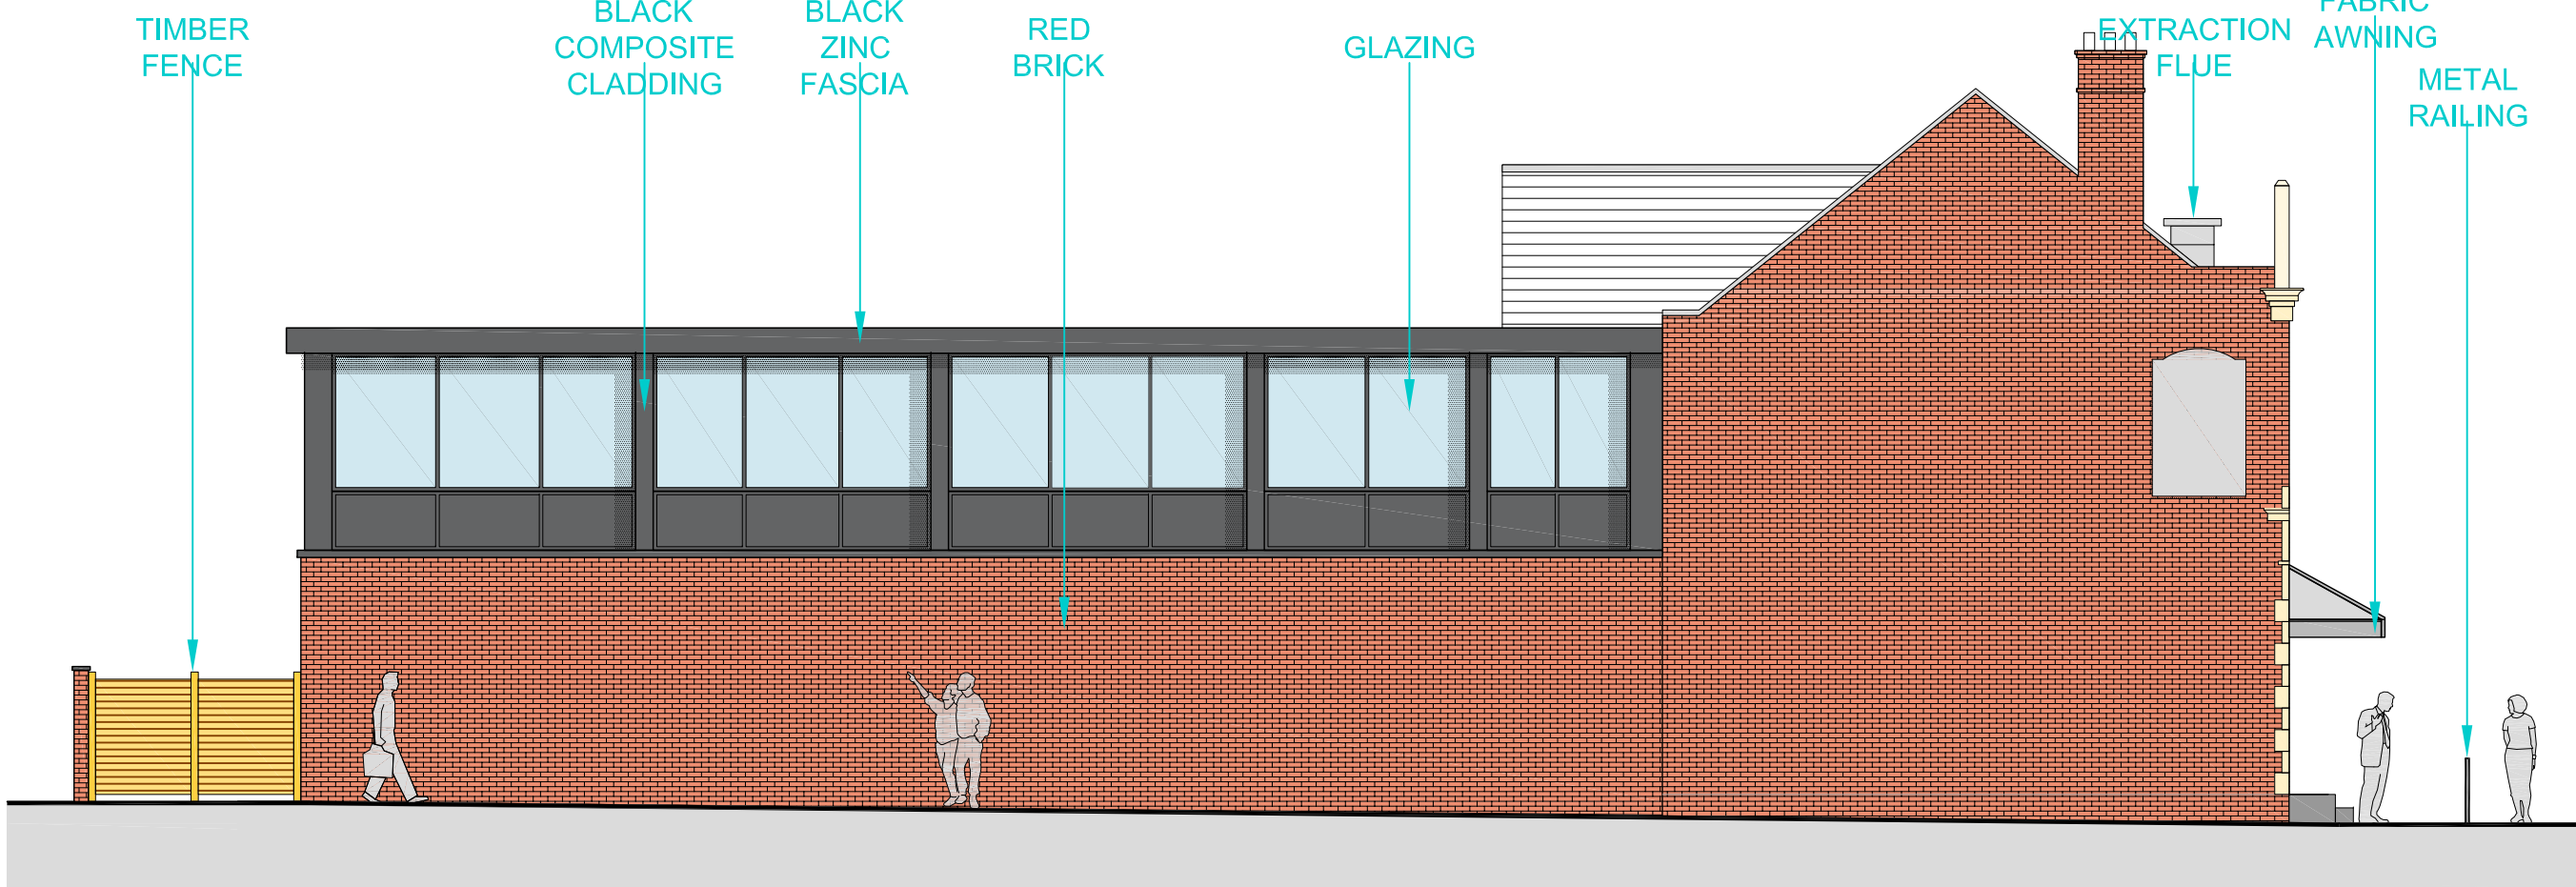

AS-BUILT SOUTH FACING ELEVATION
Scale 1:100@A1

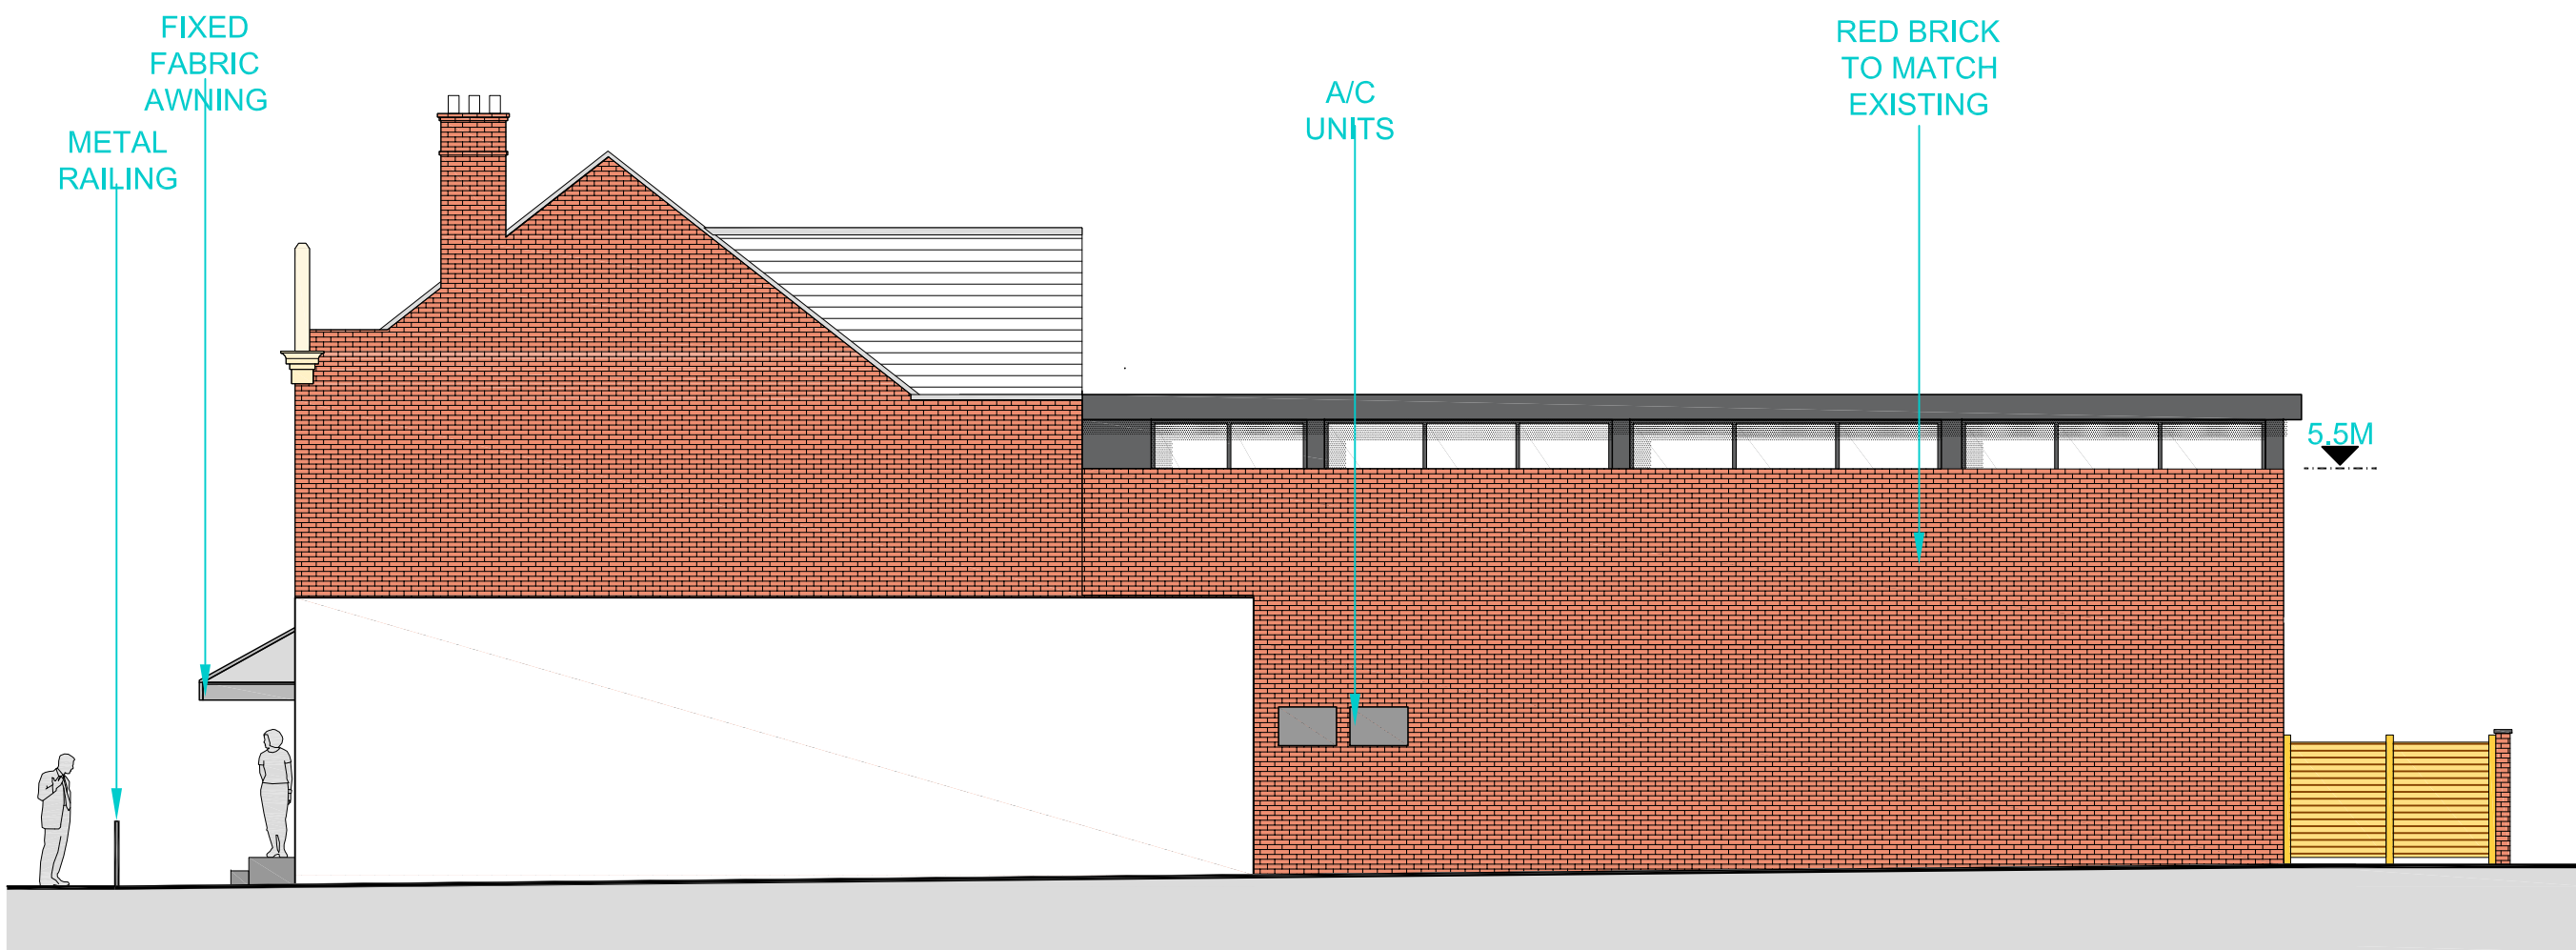

AS-BUILT NORTH FACING ELEVATION
Scale 1:100@A1

NOTE: Do not scale drawing. Work to fixed dimensions. This drawing has been prepared for planning purposes only and is to be read in conjunction with all other relevant specialist drawings, details and specifications. All works are to be carried out in accordance with the latest edition of the Building Regulations and any amendments, together with all relevant British Standards and codes of practice. All dimensions unless stated otherwise are in millimetres. All dimensions and levels are to be checked by the contractor on the day prior to order, installation or commencement of work on site. Contractor to check and satisfy himself of the positions of all existing statutory authorities make services on and around site. All materials and proprietary items are to be fixed / installed / applied in strict accordance with the respective manufacturers recommendations. At all stages of work, the contractor will be responsible for and must ensure the overall stability of all buildings, structures and excavations etc. is maintained. During the construction works all existing fire drainage is to be adequately protected and normal flows maintained.

Issue Purpose : Full Planning Application			
Client	N/A	Drawn	EH
Project	N/A	Date	21-10-2021
		Scale	1:100 @ A1
Address	130 Wilmslow road, Manchester, M14 5AH	Stage Identification	
		Design - D	Sketch Scheme - SK
Title	As-Built Plans and Elevations	Planning - P	Construction - C