

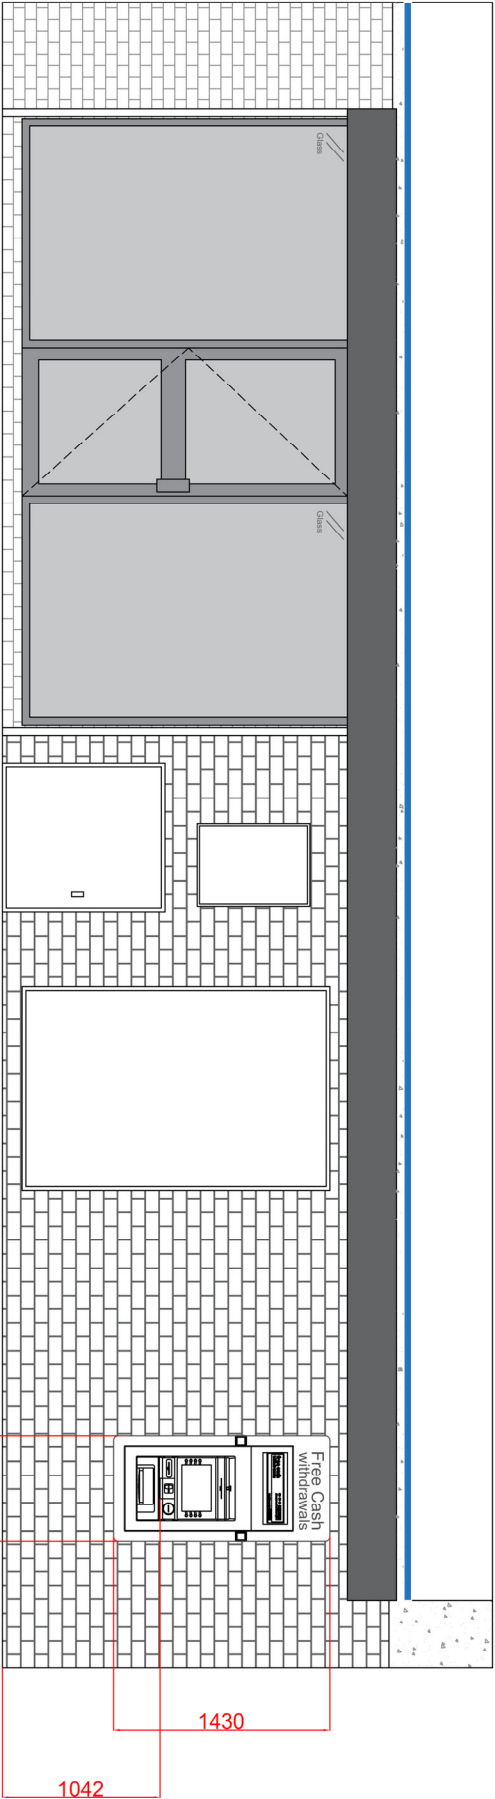


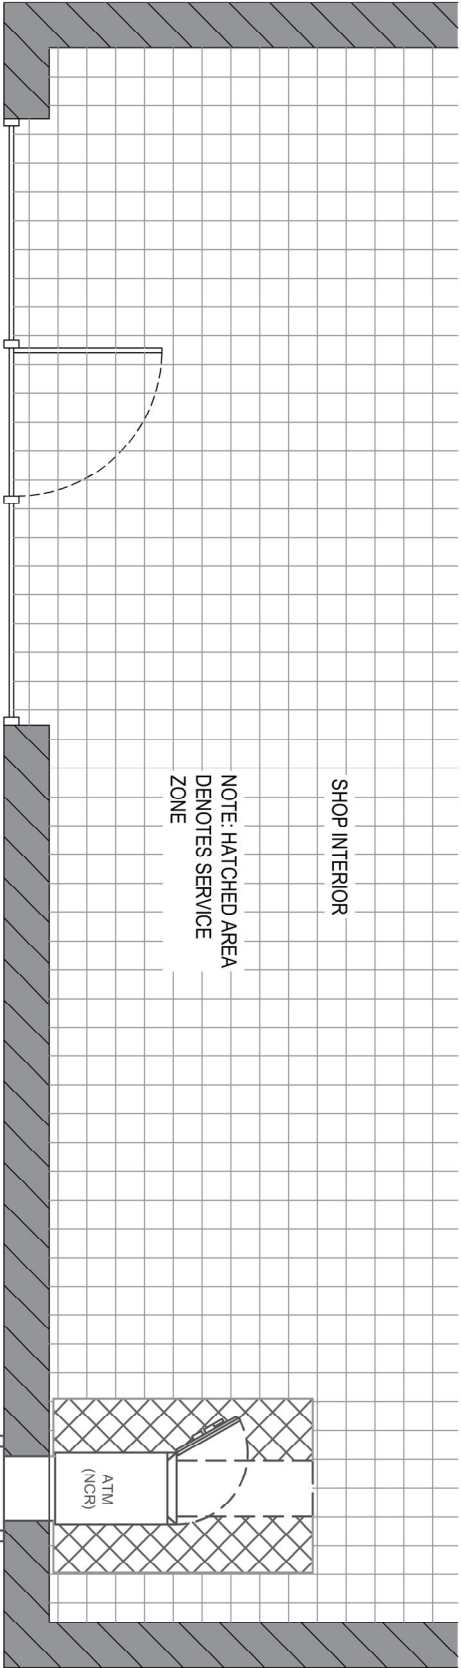


AS-INSTALLED FRONT ELEVATION

Scale 1:50

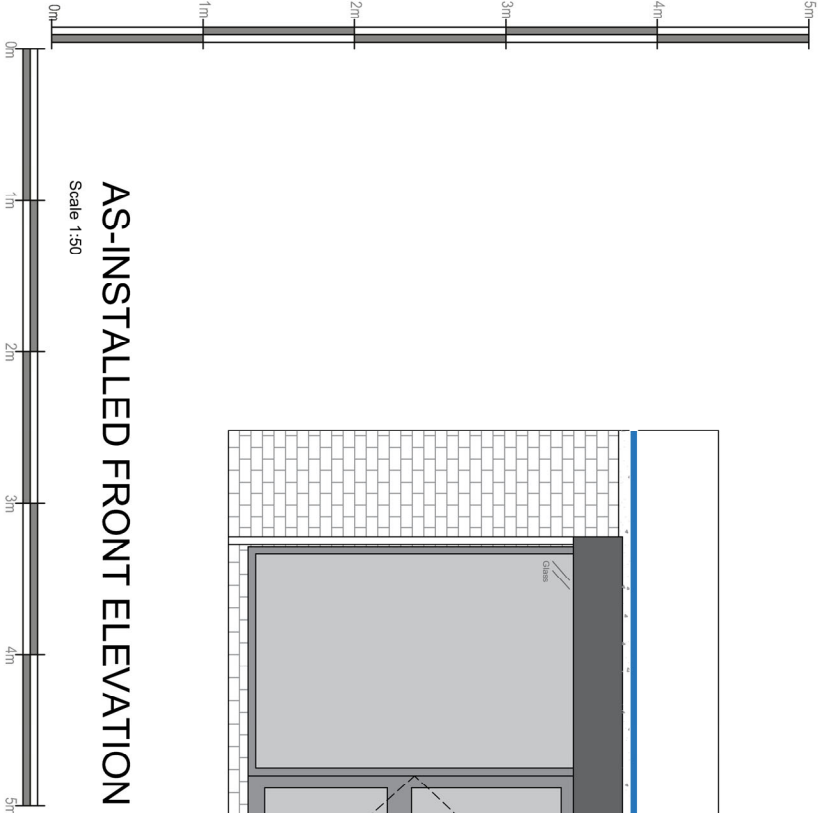

AS-INSTALLED PART PLAN

Scale 1:50

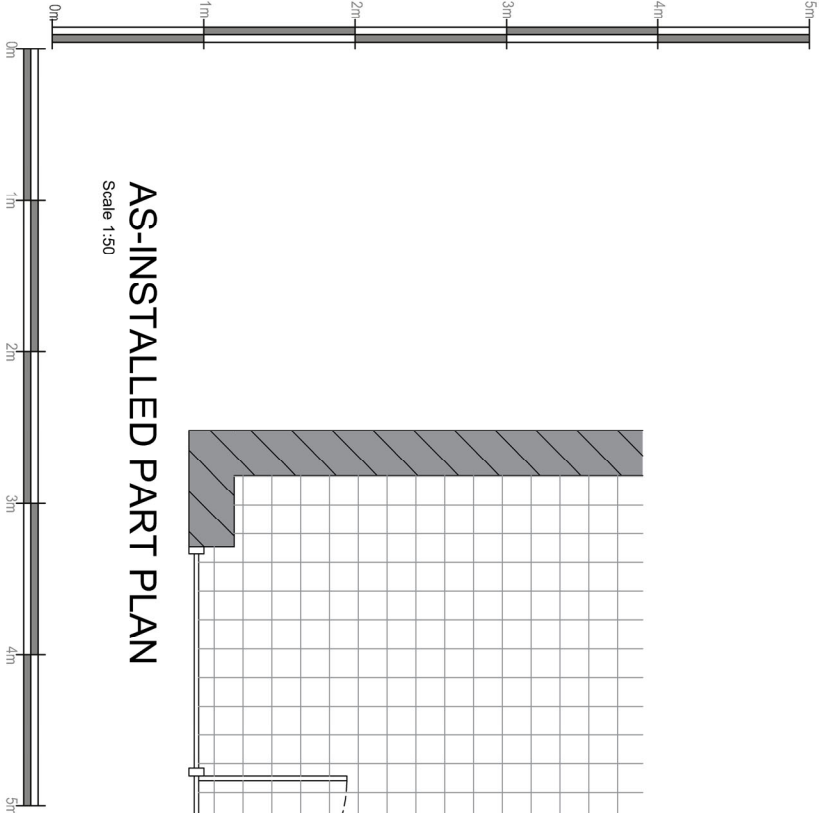

|                                                                     |                     |           |     |
|---------------------------------------------------------------------|---------------------|-----------|-----|
|                                                                     |                     |           |     |
|                                                                     |                     |           |     |
| Date:                                                               | Comments:           |           | By: |
|                                                                     |                     |           |     |
| GENERAL NOTES:                                                      |                     |           |     |
| All dimensions in millimeters unless otherwise stated.              |                     |           |     |
| Site:<br>Premier,<br>229-231 The Fairway,<br>Manchester,<br>M40 3WA |                     |           |     |
| Drawing Title:                                                      |                     |           |     |
| As-Installed Plan and Elevation                                     |                     |           |     |
| Ref:<br>T020540_AI                                                  | Date:<br>20/07/2021 | Rev:      |     |
| Scale:<br>1:50                                                      | Paper:<br>A3        | Date Rev: |     |