


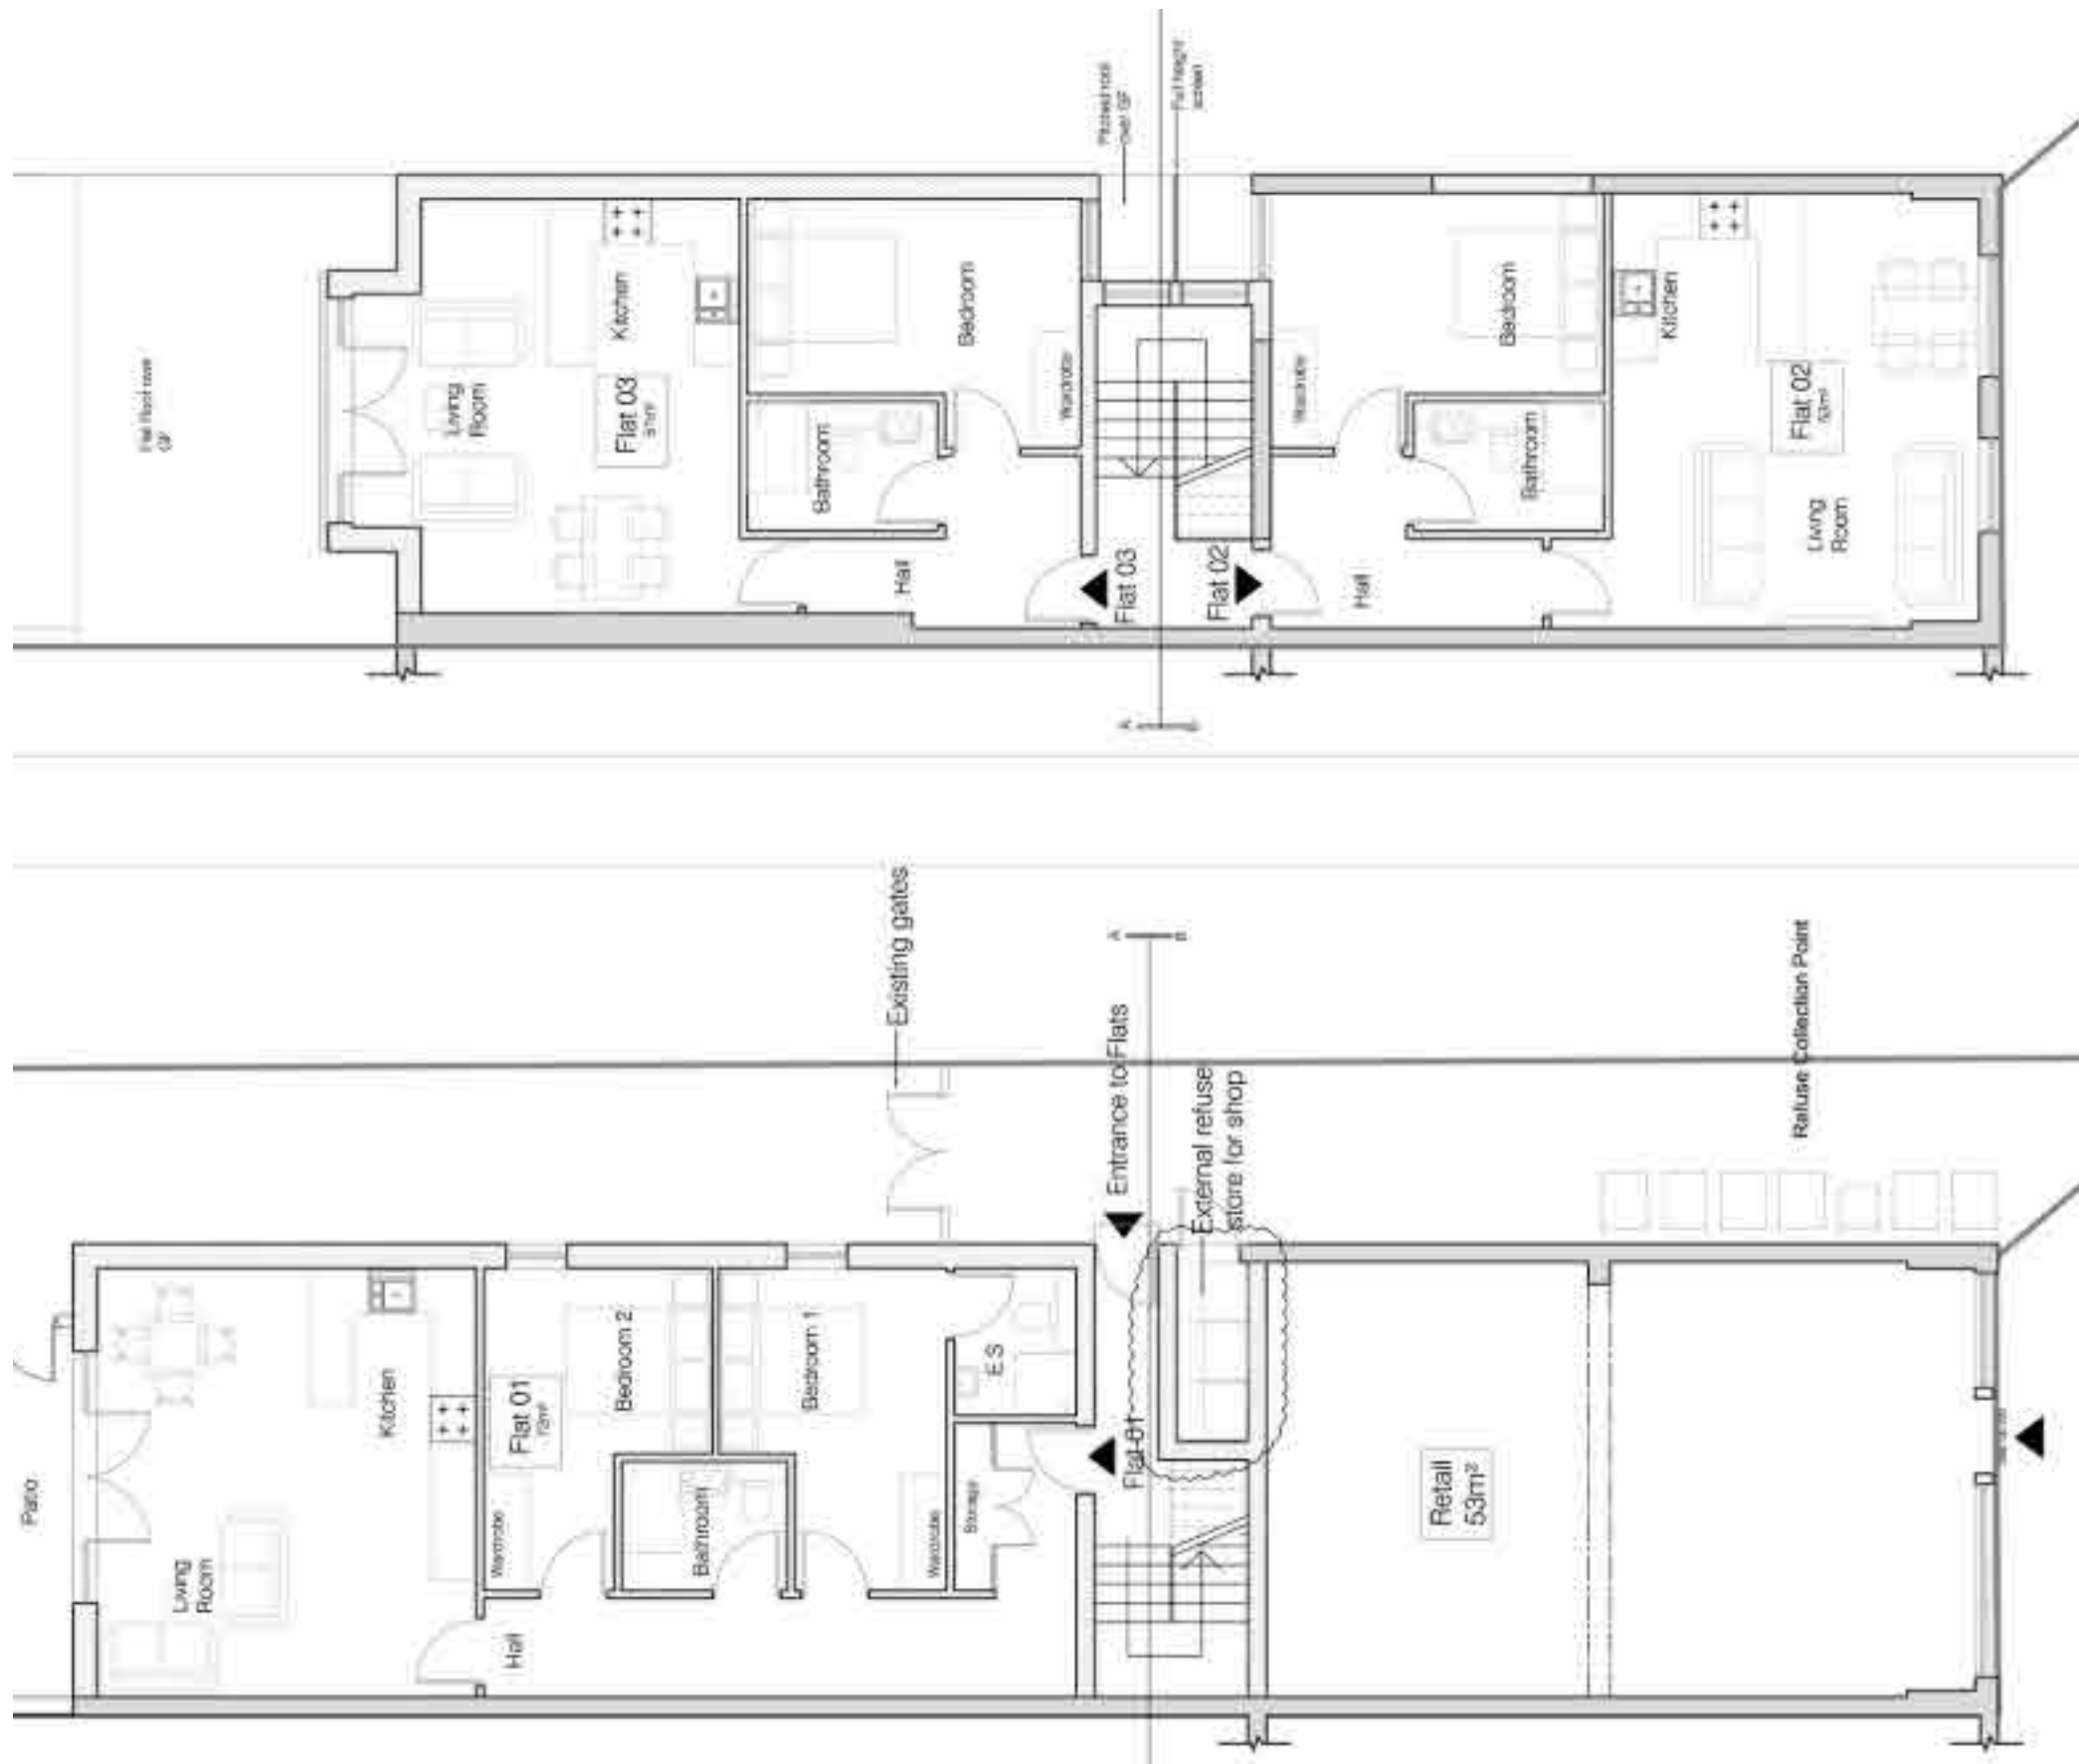

First Floor

Ground Floor

COPYRIGHT © ALL RIGHTS RESERVED BY VIKAS ALYAS LTD. DO NOT SCALE FROM DRAWING. DRAWING INDICATES DESIGN INTENT ONLY. REPORT ANY DISCREPANCIES TO CLIENT / VA LTD. NOT TO BE USED FOR CONSTRUCTION UNLESS STATED SO. TO BE READ IN CONJUNCTION WITH OTHER DRAWINGS OR SPECIFICATION WHERE PROVIDED.

ARCHITEK
BUILDING DESIGN CONSULTANCY

0161 511 8479
vikas@architek.uk
916 Stockport Road, Levenshulme, Manchester, M19 3AB

No.	Description	Date
P1	Issue to Planning	14.02.2023

PROJECT		ADDRESS		CLIENT			
Canopy extraction flue duct to side elevation and outdoor seating area		365 Barlow Moor Rd, Chorlton Manchester M21 7FZ		Mr M Ilyas Chaudhury			
Manchester City Council	PURPOSE OF ISSUE Planning	SHEET	Asbuilt Floor Plans - APP No 108574/EO/2015	Date 10.01.2023	Project number M21	Scale (@ A3) 1 : 100	
				Drawn by VA	DRAWING NUMBER		REV
				Checked by VA	A102		P1