


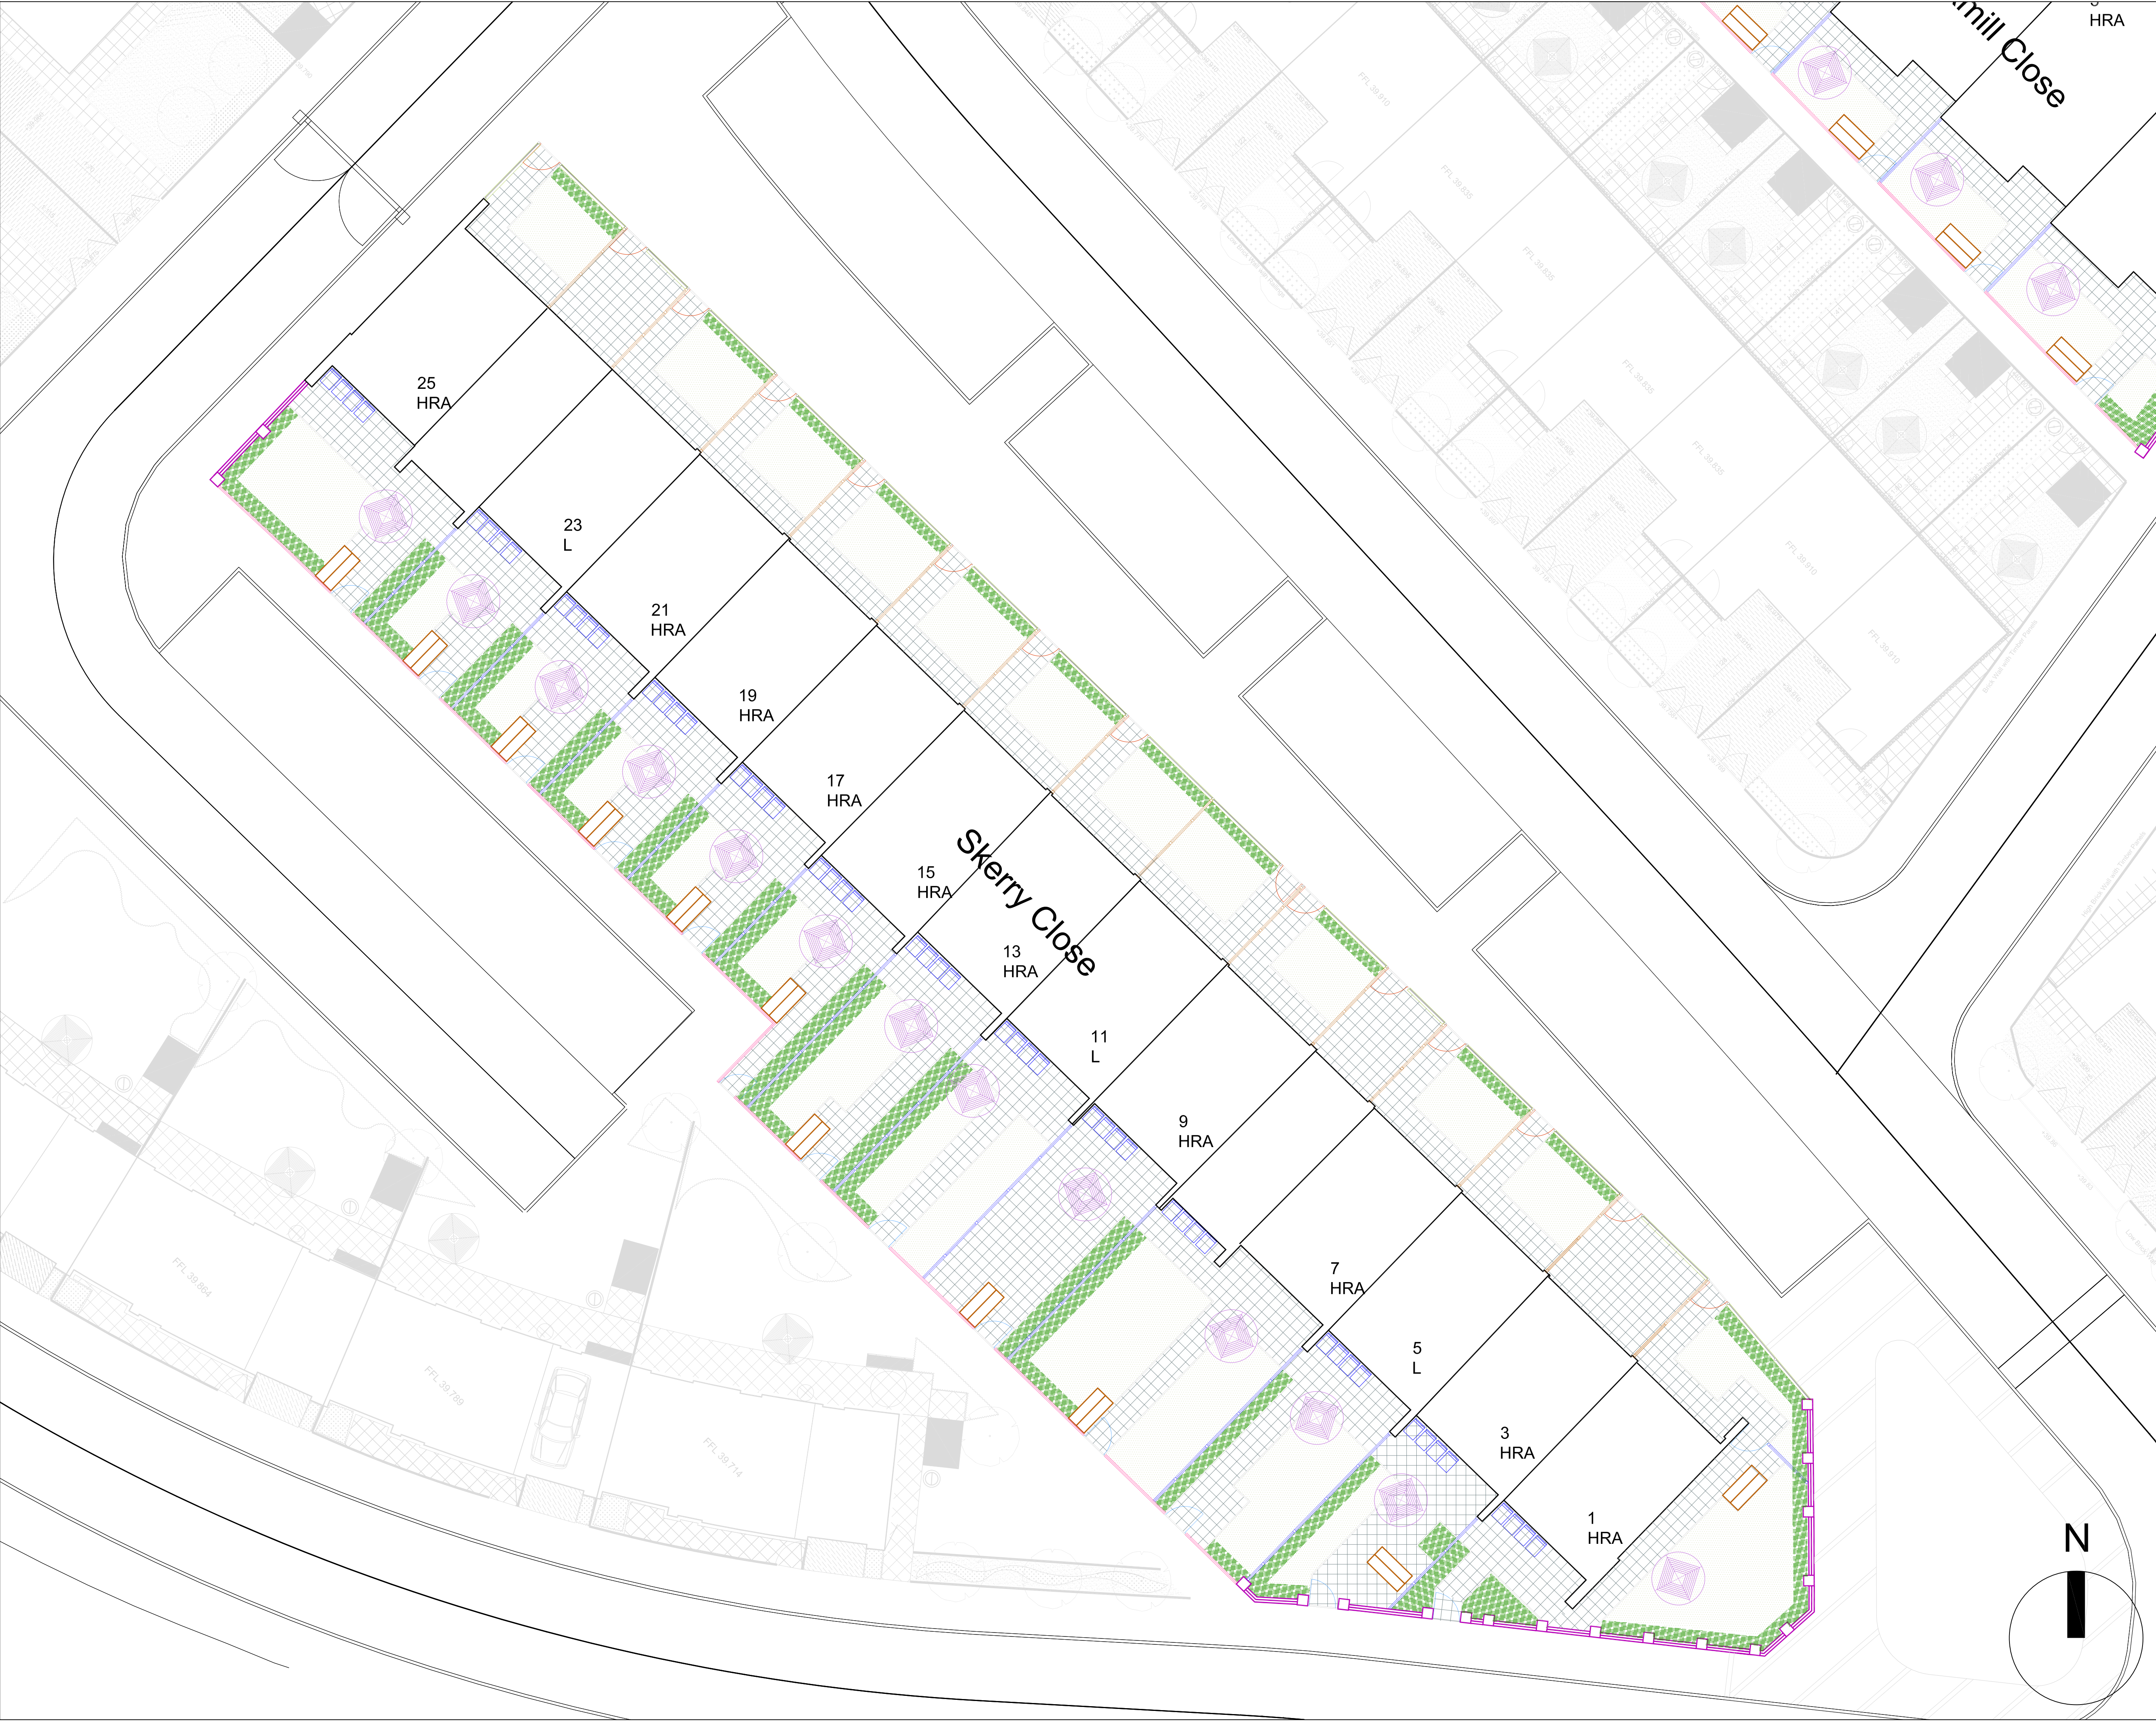

Do not scale from this drawing. All dimensions should be checked on site. Refer to architects for further information.

- Turf / Grass Seeding, 150mm Depth of Topsoil. Refer to Spec Items Q28 & Q30
- Planting Bed, 600mm Depth of Topsoil. Refer to Spec Items Q28 & Q31
- Concrete Flag Paving, Refer to Spec Item Q25
- Footpath Bitmac Paving, Refer to Spec Item Q22
- Driveway Bitmac Paving, Refer to Spec Item Q22
- Vehicular Bitmac Paving, Refer to Spec Item Q22. Works by others.
- Footpath Bitmac Paving, Refer to Spec Item Q22. Works by others.
- Limestone Chippings
- Concrete Pin Kerb, Refer to Spec Item Q10
- Concrete Road Kerb, Refer to Highway Engineer's Spec
- Low Brick Walls and Railings, Built on New Foundations and DPC. New Engineering/Facing Brick, Refer to Spec Item F10
- 2.1m High Brick Wall, Built on New Foundation and DPC. New Engineering/Facing Brick, Refer to Spec Item F10
- 2.1m High Brick Piers, Low Walls and Timber Panels, Built on Existing Foundation and DPC. New Engineering/Facing Brick, Refer to Spec Item F10
- 2.1m High Brick Piers, Low Walls and Timber Panels, Built on New Foundation and DPC. New Engineering/Facing Brick, Refer to Spec Item F10
- Proposed 1m Low Metal Railings to Front Gardens with 100mm Upstand Conservation Kerb Underneath, Refer to Spec Item Q40 & Q10 and Drawing 303
- 1m High Timber Front Divisional Fencing, Refer to Spec Item Q40 and Drawing 302
- 1.8m High Rear Divisional Timber Fencing to Rear Gardens, Refer to Spec Item Q40 and Drawing 306
- 1.8m High Rear Divisional Timber Fencing with trellis to Rear Gardens, Refer to Spec Item Q40 and Drawing 306
- 1.8m High Timber Gates to Rear Gardens and Sides of Properties, Refer to Spec Item Q40 and Drawing 306
- 1m High Single Leaf Metal Gates to Front Gardens, Refer to Spec Item Q40 and Drawing 304
- 1m High Double Leaf Metal Gates to Front Gardens, Refer to Spec Item Q40
- 1.8m High Timber Driveway Gates Refer to Spec Item Q40.
- Timber Sheds, Refer to Spec Item B91
- Rotary Washing Lines, Refer to Spec Item Q50
- Wheelle Bins
- Proposed Trees
- Existing Tree, Retained and Protected to BS 5837:2012

C05	07.08.20	Context added	LB	WGCI	JG
C04	17.09.18	Updated As Built Information	SK	WGCI	JG
C03	19.06.17	New garden boundary	SJH	WGCI	JG
C02	16.06.16	Highway Designs Added	TSD	WGCI	JG
C01	16.06.14	Mask applied over topo	TSD	WGCI	JG
C00	13.06.14	Draft Issue for Comment	TSD	WGCI	JG
Rev	Date	Detail	Made	Chkd	App'd
☐ PLANNING ☐ DRAFT ☐ FOR COMMENT ☐ TENDER ☒ CONSTRUCTION					

Client:

Mears Construction

Project:

Mears Brunswick PFI

Title:

Proposed Skerry Close 1-25

Design: MS	Sheet Size - A1 (594mm x 841mm)
Drawn: TSD	Date: 13.06.14
Chk'd: WGC	Scale: 1:125
App'd: JG	

GILLESPIES

GILLESPIES LLP
Westgate House
44 Hale Road
Hale
Cheshire
WA14 2EX

T: 0161 928 7715
F: 0161 927 7680
E: admin.manchester@gillespies.co.uk

File Location	R:\M5115 Mears Brunswick PFI\Drawings\CAD	
No.	M5115-162-27	Rev: C05