



GENERAL NOTES

1. DRAWINGS ARE TO BE READ IN CONJUNCTION WITH ALL RELEVANT SPECIFICATIONS, ENGINEERS, ARCHITECTS & SERVICES DRAWINGS, INCLUDING APPROVED BUILDERS WORK DRAWINGS. CONTRACTOR TO NOTIFY ENGINEER OF DISCREPANCIES BETWEEN STRUCTURAL DRAWINGS AND SPECIFICATIONS OR OTHER DRAWINGS.
2. ALL DIMENSIONS ARE IN MILLIMETRES UNLESS NOTED OTHERWISE.
3. DO NOT SCALE FROM THIS DRAWING. WORK TO DIMENSIONS OR CO-ORDINATES PROVIDED. ALL LEVELS ARE IN METRES AND ALL DIMENSIONS ARE IN MILLIMETRES, UNLESS OTHERWISE NOTED. ANY AMBIGUITIES, OMISSIONS AND ERRORS ON DRAWINGS, SHALL BE BROUGHT TO THE ENGINEERS ATTENTION IMMEDIATELY.

CONSTRUCTION RECORD DRAWING

THE INFORMATION SHOWN ON THIS CONSTRUCTION RECORD DRAWING IS BASED ON THE LATEST ISSUED CONSTRUCTION DRAWINGS WHICH HAVE BEEN MODIFIED AS NECESSARY WITH INFORMATION SUPPLIED BY THE CONTRACTOR TO INCORPORATE CHANGES MADE DURING CONSTRUCTION. INFORMATION OBTAINED FROM THIRD PARTIES HAS NOT BEEN INDEPENDENTLY VERIFIED BY SCOTT HUGHES DESIGN AND MAY NOT BE WHOLLY ACCURATE. ANY PARTY SEEKING TO USE THIS DRAWING MUST FIRST VERIFY ITS FITNESS FOR THE INTENDED PURPOSE WITH SUITABLE SITE INSPECTIONS/INVESTIGATIONS AS DEEMED APPROPRIATE.

Manhole Details									
Structure Name	Cover Level	Co-Ords	Pipe Invert Levels & Dia	Manhole Size	Cover	MH-Type	MH Depth	MH Depth CL/Outgoing Soffit	Notes
C02	49.895	E: 384676.254 N: 398815.494	FROM ADDINGTON STREET IL:45.773 Ø375mm From C01 IL:46.043 Ø225mm To ADDINGTON STREET IL:45.773 Ø375mm	1500	D400	TYPE 1	4.122	3.747	

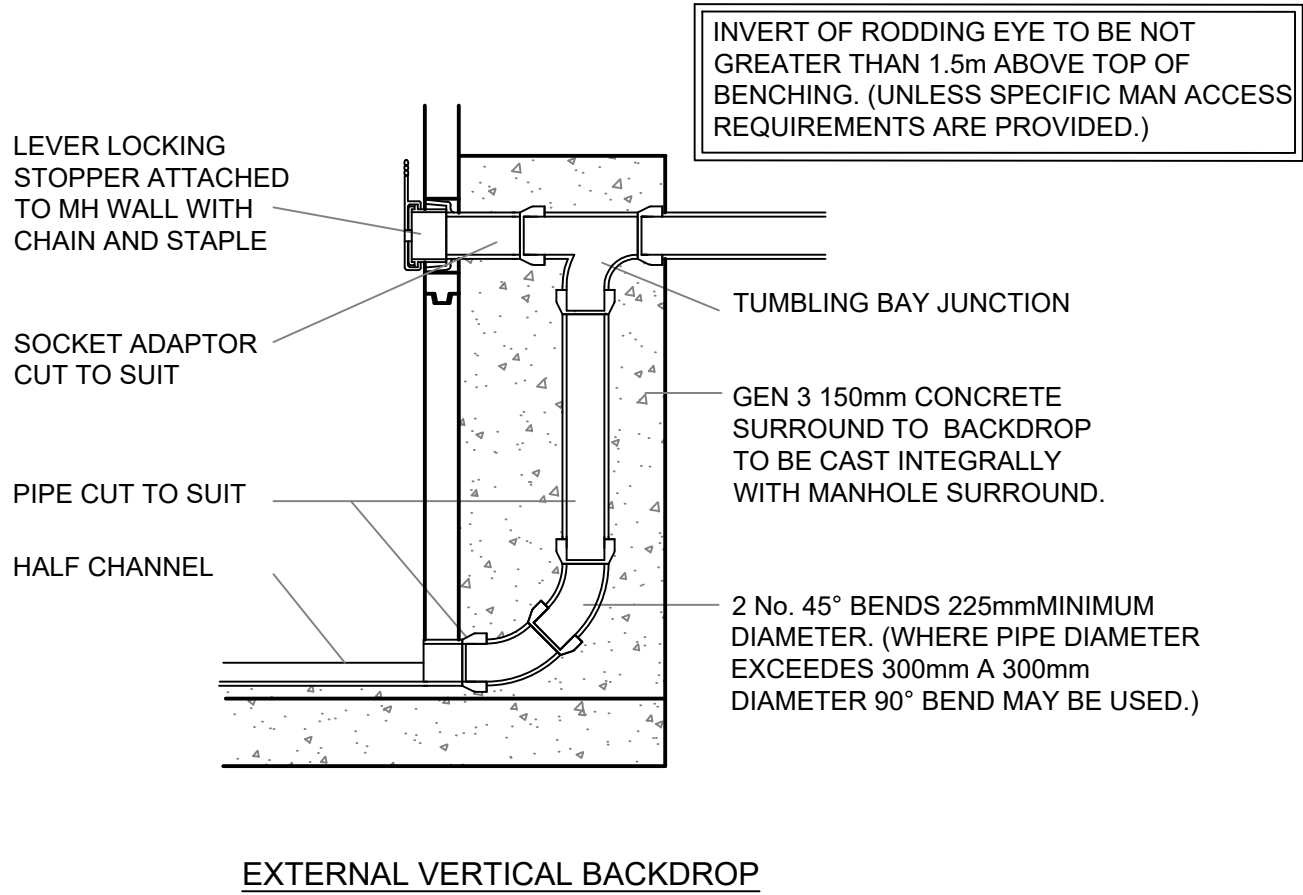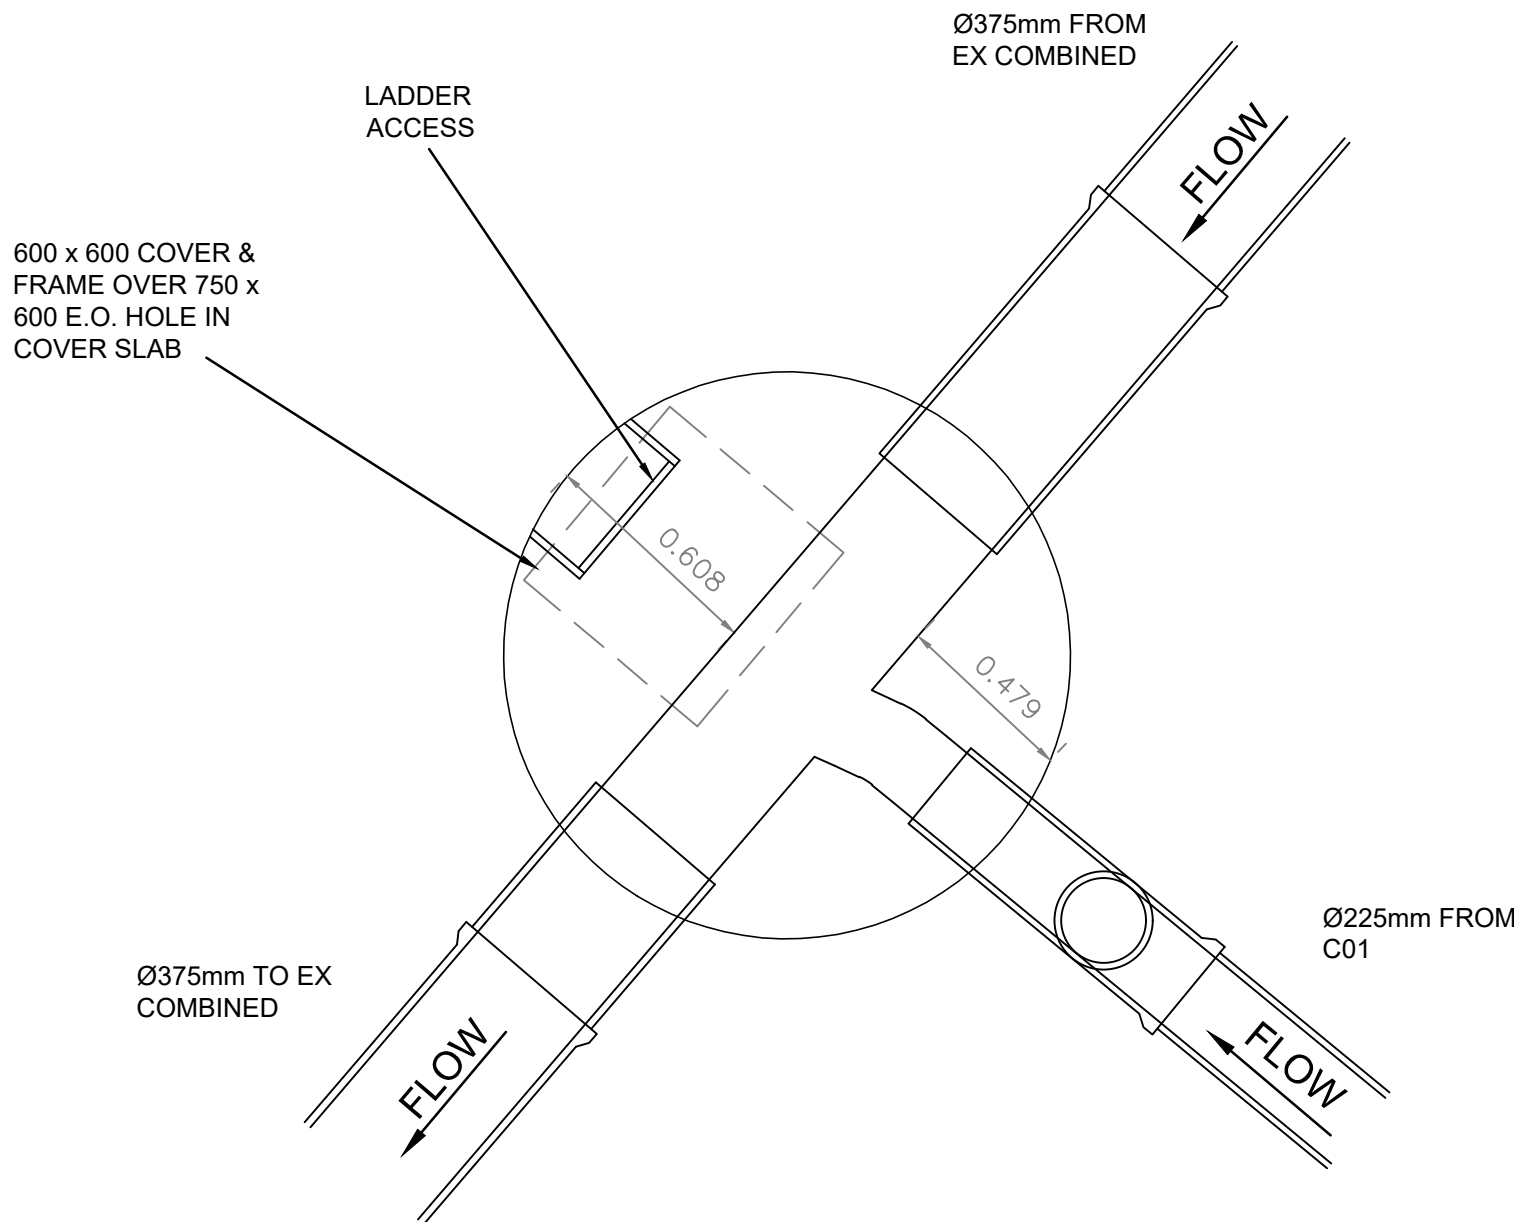

NOTE:

ALL DRAINAGE WORKS TO CONFORM TO UU STANDARD DETAILS

NOTE:

THIS DRAWING IS TO BE READ IN PARALLEL WITH THE FOLLOWING UU DETAILS:

- STND/19/001
- STND/19/007
- STND/19/008
- STND/19/010

C02	07.07.23	AS	EDM	CONSTRUCTION RECORD
C01	01.06.23	AS	EDM	CONSTRUCTION RECORD
P01	26.11.21	EJD	EJD	PRELIMINARY ISSUE
No	DATE	DRAWN	REV'D ENG.	AMENDMENT

STATUS	PURPOSE OF ISSUE
CR	CONSTRUCTION RECORD

COPYRIGHT:
The concepts and the information contained in this document are the copyright of Ridge and Partners LLP. Use or copying of the document in whole or in part without written permission of Ridge and Partners LLP constitutes an infringement of copyright.

RIDGE

CLIENT GMI CONSTRUCTION	
PROJECT NEW CROSS - OLDHAM ROAD	
DRAFTER AS	ENGINEER EDM
TITLE C02 MANHOLE SCHEMATIC	
PROJECT REFERENCE:	
SCALE 1:20	SHEET A1
DRAWING No D464-RDG-00-ZZ-DR-C-0105	REV C02