



AS-INSTALLED FRONT ELEVATION

Scale 1:50

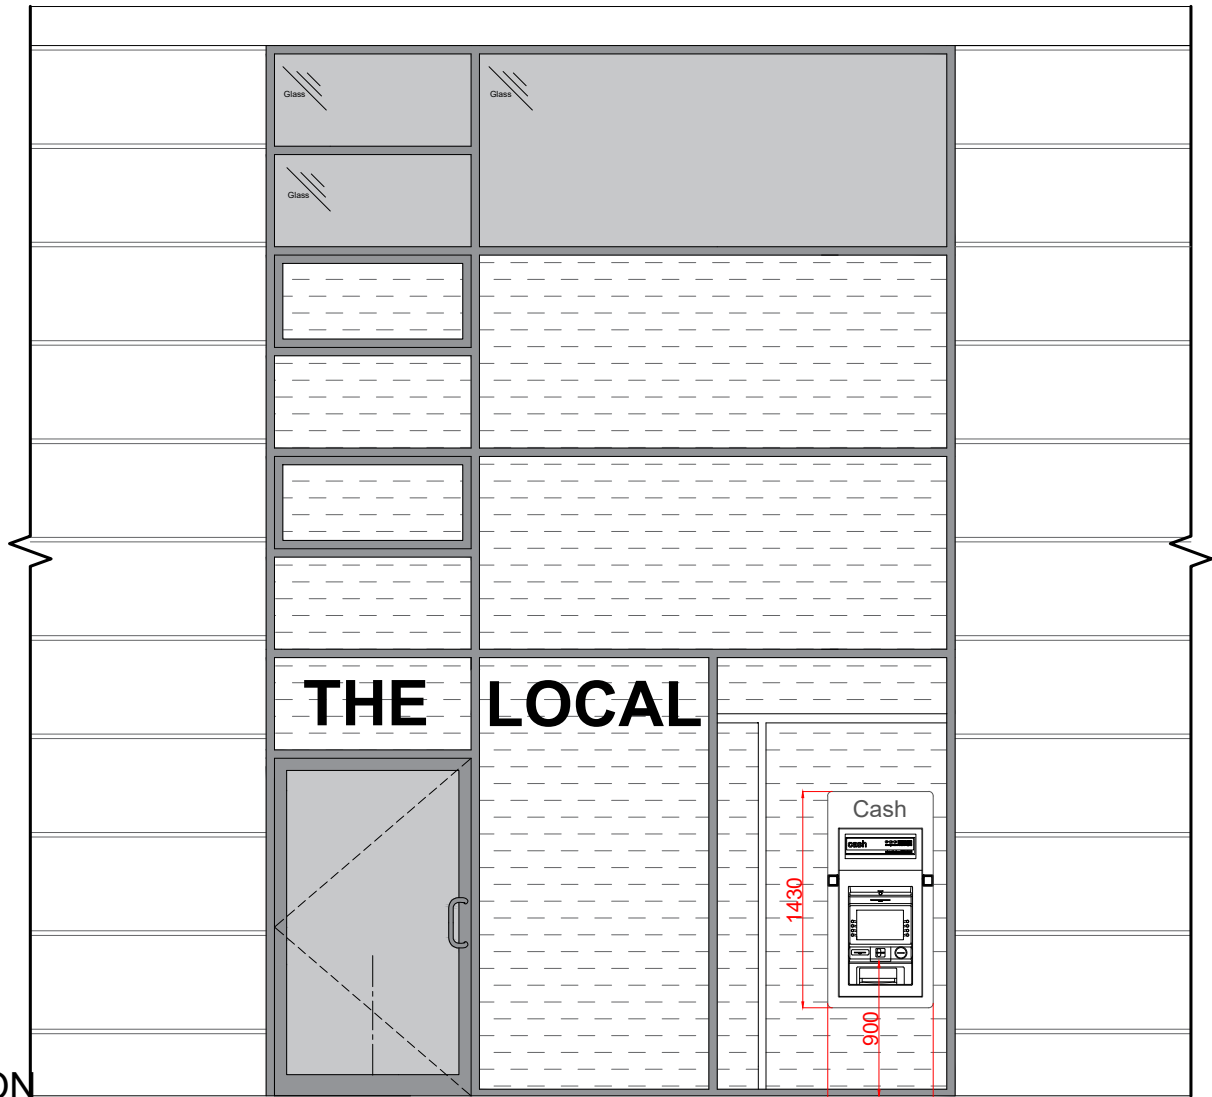


NEW ATM INSTALLED THROUGH
NEW SECURE PANEL

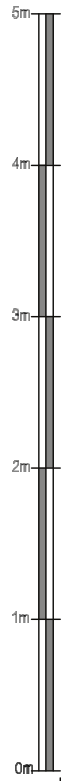

AS-INSTALLED PART PLAN

Scale 1:50

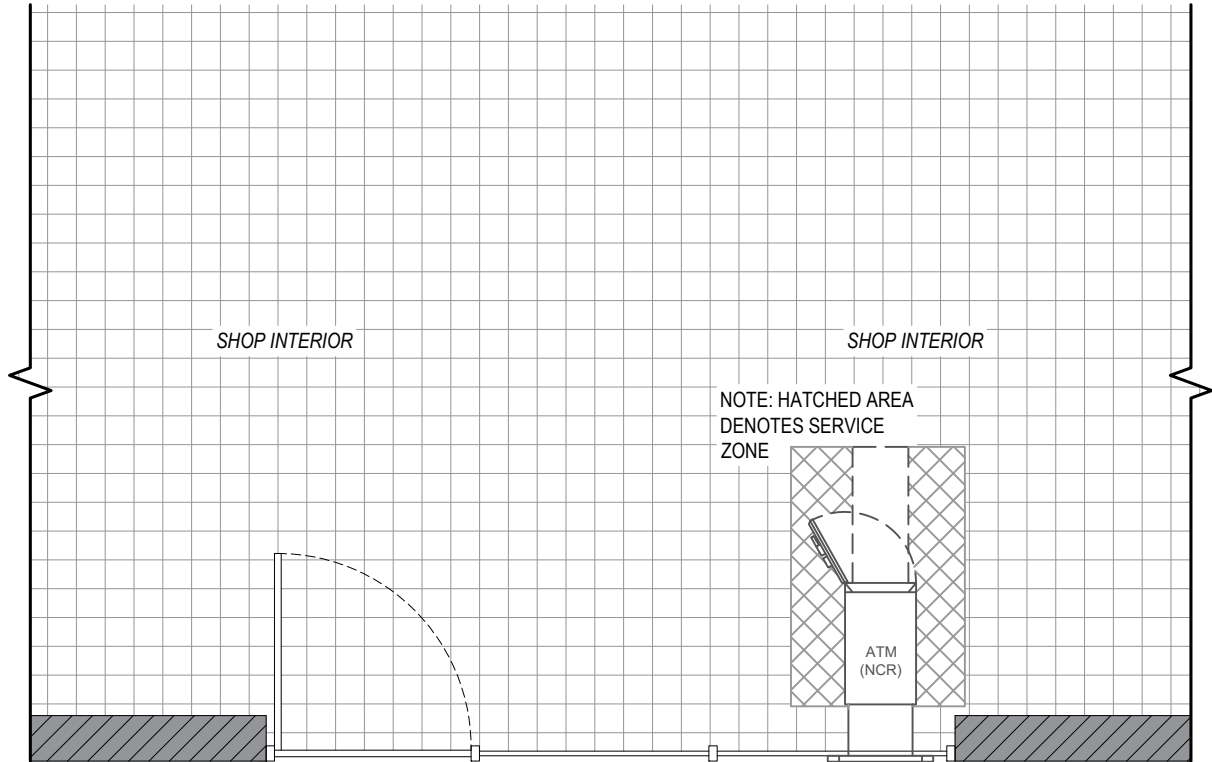

NOTE: HATCHED AREA
DENOTES SERVICE
ZONE

ATM
(NCR)

Date: Comments: By:

GENERAL NOTES:
1) All dimensions in millimeters unless otherwise stated.

Site:
The Local,
141 Great Ancoats St,
Manchester,
M4 6DH

Drawing Title:
As-Installed Plan and Elevation

Ref: T020964_AI	Date: 18/07/2022	Rev:
Scale: 1:50	Paper: A3	Date Rev: