


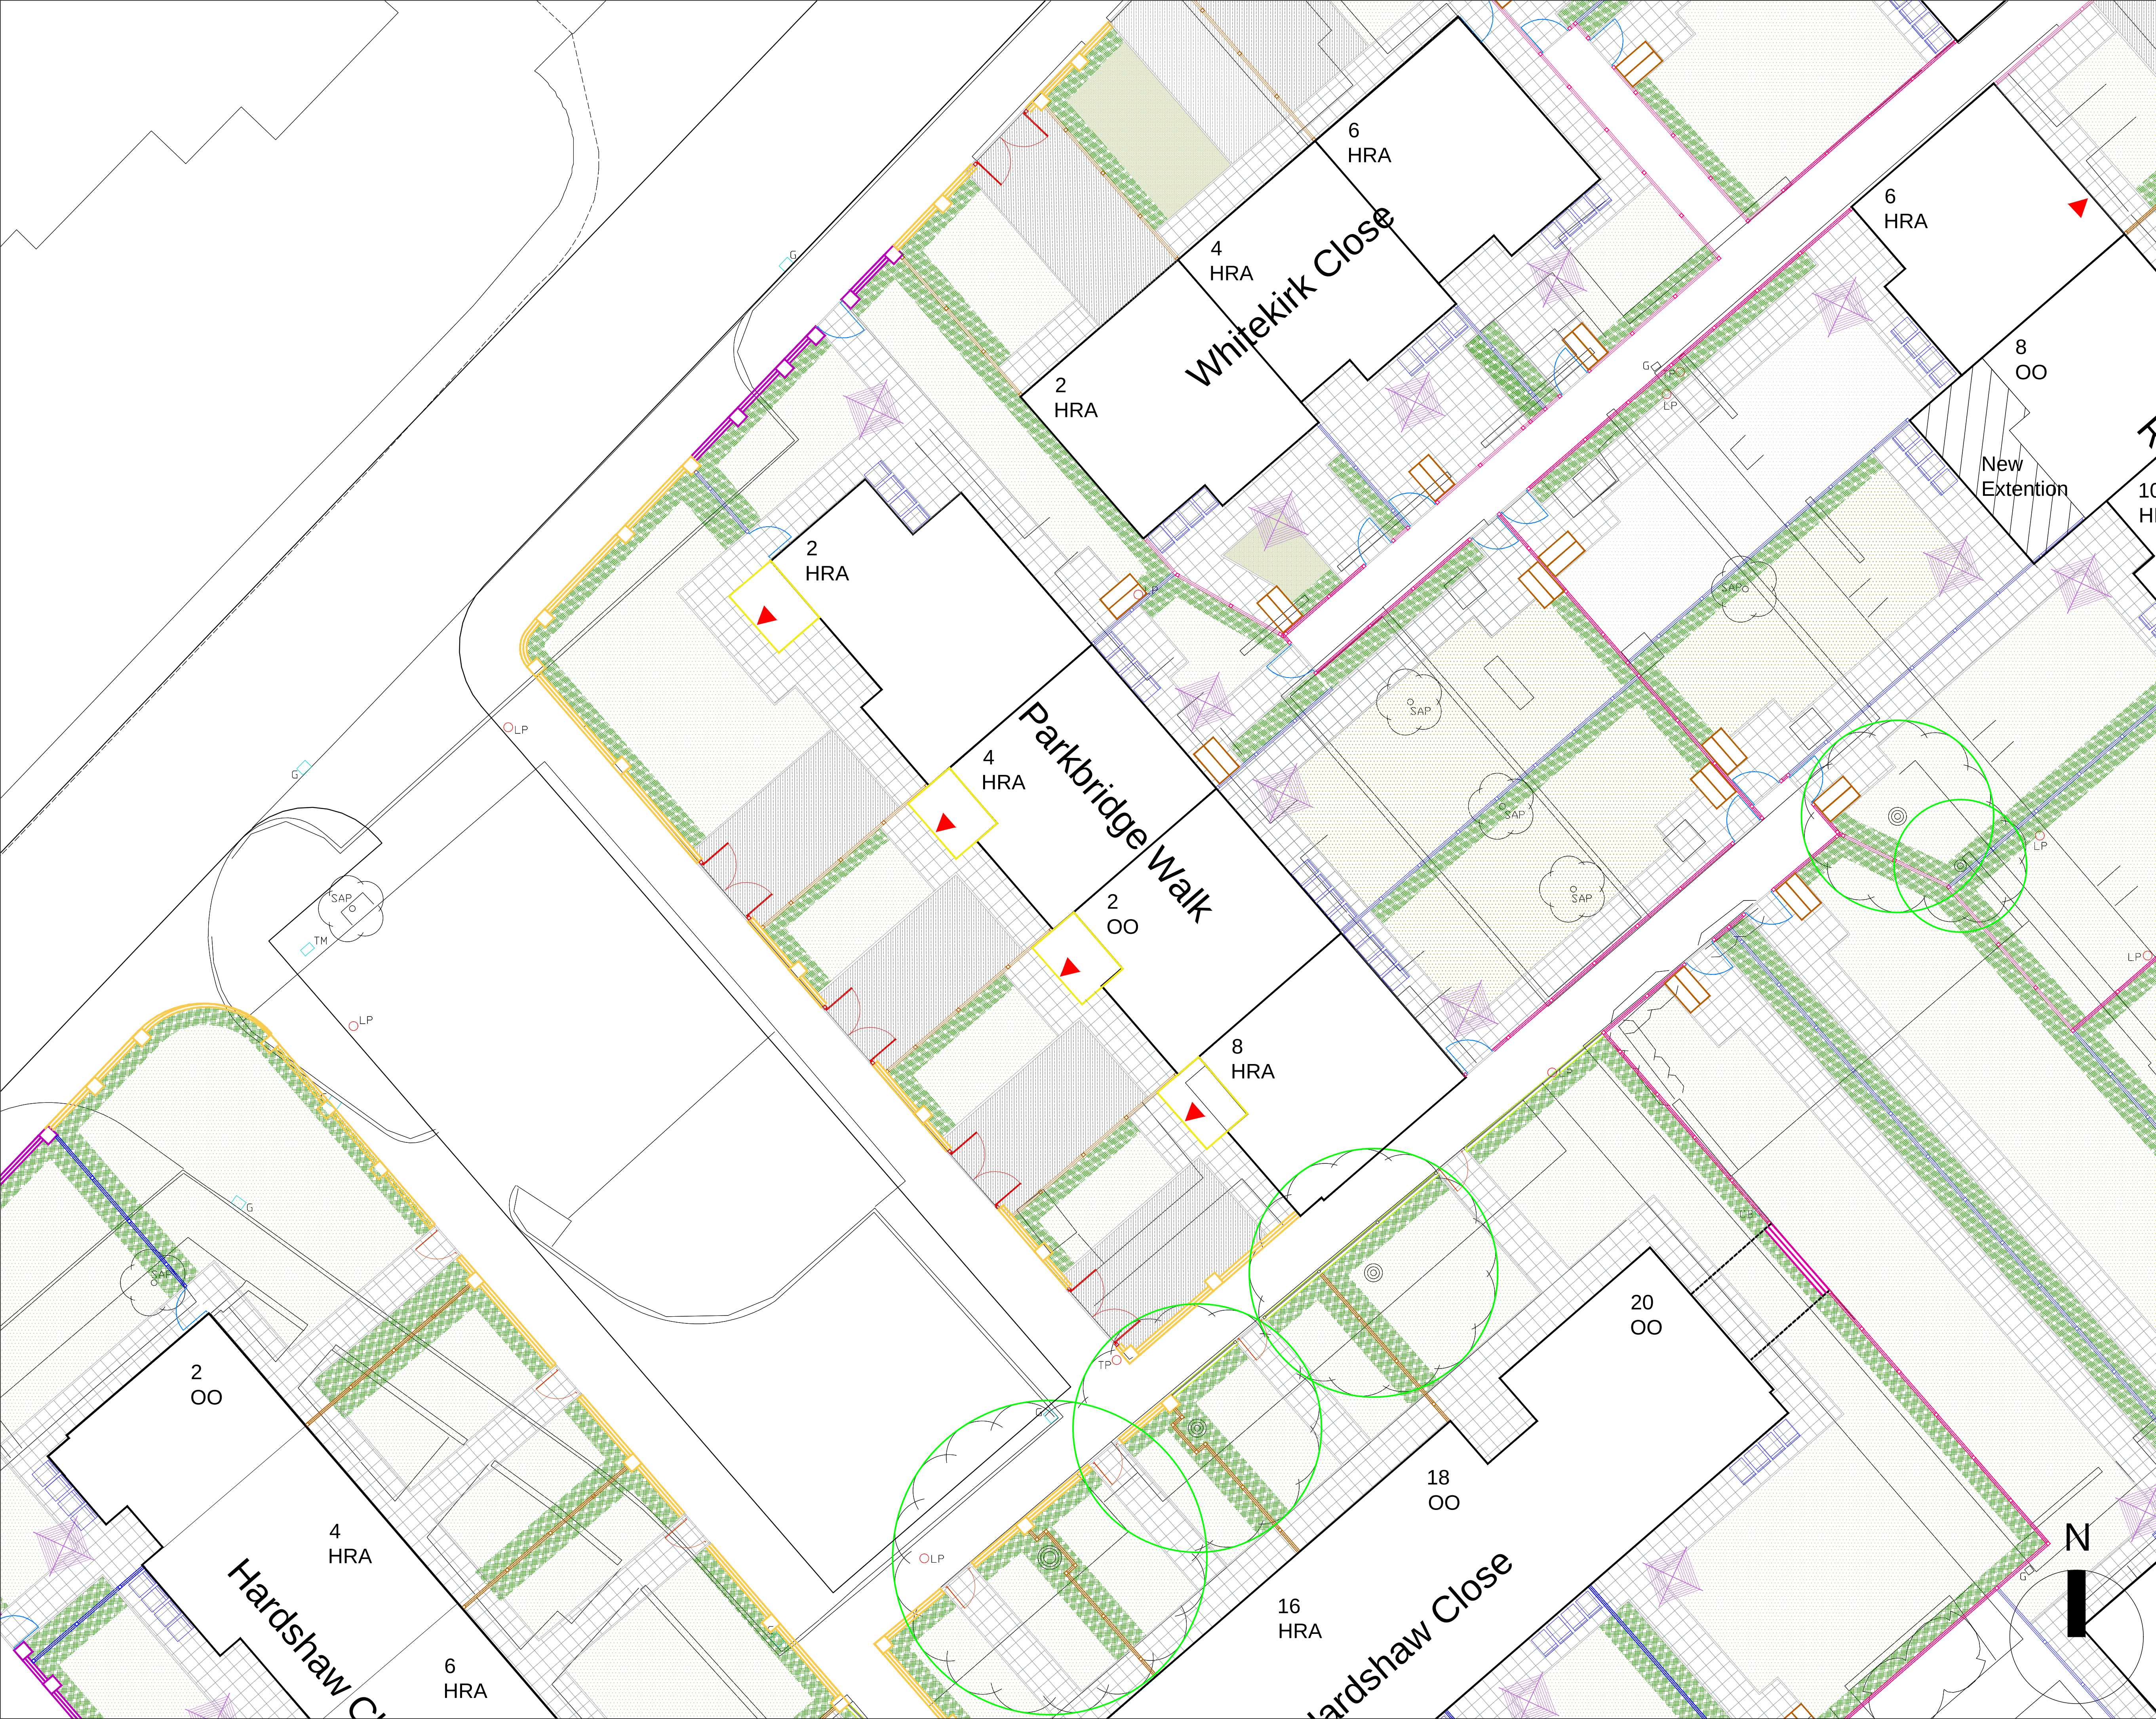

Do not scale from this drawing. All dimensions should be checked on site. Refer to architects for further information.

Proposed Turf / Grass Seeding. 150mm Depth of Topsoil. Refer to Spec Items Q28 & Q30

Proposed Planting Bed. 600mm Depth of Topsoil. Refer to Spec Items Q28 & Q31

Proposed Concrete Flag Paving. Refer to Spec Item Q25

Proposed Footpath Bitmac Paving. Refer to Spec Item Q22

Proposed Concrete Block Paving. Refer to Spec Item Q25. Works by others.

Proposed Vehicular Bitmac Paving. Refer to Spec Item Q22. Works by others.

Proposed Footpath Bitmac Paving. Refer to Spec Item Q22. Works by others.

Proposed Concrete Pin Kerb. Refer to Spec Item Q10

Low Brick Walls and Railings, Built on New Foundations and DPC. New Engineering/Facing Brick. Refer to Spec Item F10

Proposed 2.1m High Brick Piers, Low Walls and Timber Panels, Built on New Foundation and DPC. New Engineering/Facing Brick. Refer to Spec Item F10

Proposed 1m High Timber Front Divisional Fencing. Refer to Spec Item Q40 and Drawing 302

Proposed 1.8m High Rear Divisional Timber Fencing to Rear Gardens. Refer to Spec Item Q40 and Drawing 306

Proposed 1.8m High Rear Boundary Timber Fencing to Rear Gardens. Refer to Spec Item Q40 and Drawing 306

Proposed 1.8m High Timber Driveway Gates Refer to Spec Item Q40.

Proposed 1m High Double Leaf Metal Gates to Front Gardens. Refer to Spec Item Q40

Timber Sheds. Refer to Spec Item B91

Rotary Washing Lines. Refer to Spec Item Q50

Wheelee Bins

Potential driveway locations if space is returned to typical garden unit

Existing Tree, Retained and Protected to BS 5837:2012

Door location

C0328.03.19As BuiltLEBWGCJG

C0203.01.18Updated in response to S73 UpdateDCSWGCJG

C0116.08.16Highway Design AddedTSDWGCJG

C0015.08.14Draft Issue for CommentTSDWGCJG

RevDateDetailMade/Chk'd/Approved

☐ PLANNING☐ DRAFT☐ FOR COMMENT☐ TENDER☒ CONSTRUCTION

Client:

Mears Construction

Project:

Mears Brunswick PFI

Title:

Proposed Parkbridge Walk 2-8

Design: MSTSD

Drawn: TSD

Chk'd: WGC

App'd: JG

Sheet Size - A1
(594mm x 841mm)

Date: 14.08.14

Scale: 1:100

GILLESPIES LLP
Westgate House
44 Hale Road
Hale
Cheshire
W14 2EX

T: 0161 928 7715
F: 0161 927 7680
E: admin.manchester@gillespies.co.uk

File LocationR:\M5115 Mears Brunswick PFI\Drawings\CAD

No.M5115-207-66RevC03