


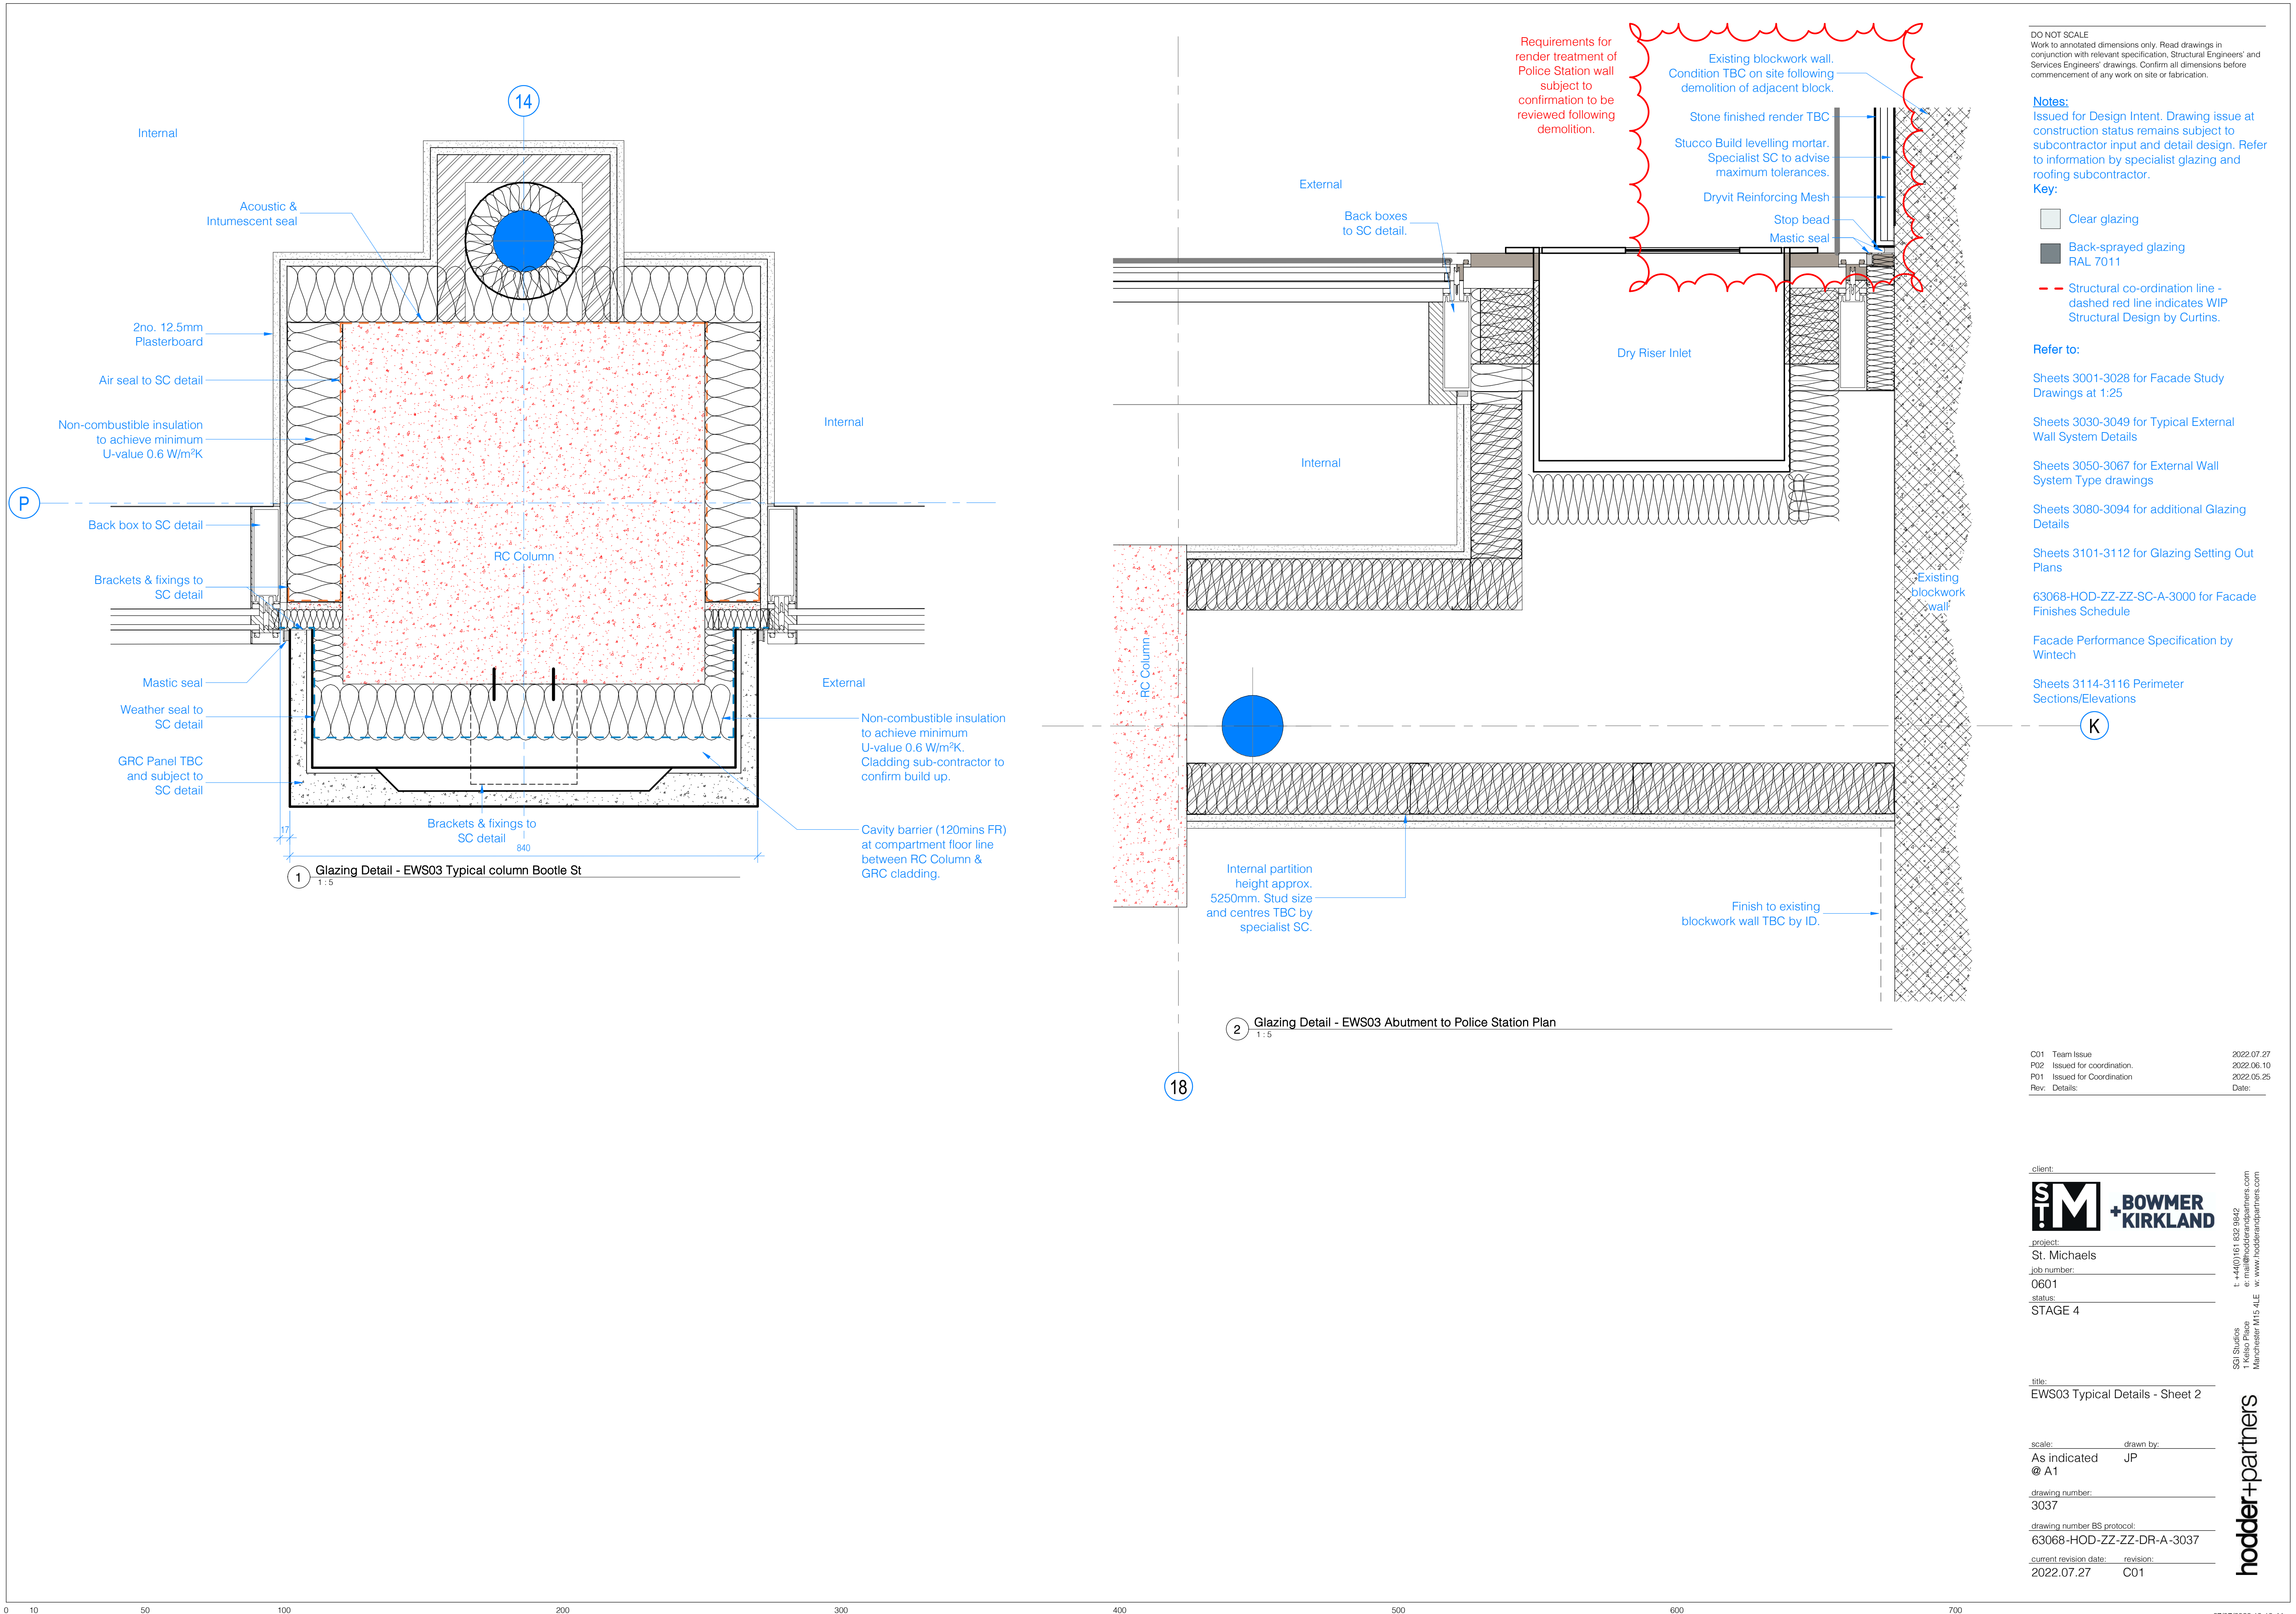

DO NOT SCALE
Work to annotated dimensions only. Read drawings in conjunction with relevant specification, Structural Engineers' and Services Engineers' drawings. Confirm all dimensions before commencement of any work on site or fabrication.

Notes:
Issued for Design Intent. Drawing issue at construction status remains subject to subcontractor input and detail design. Refer to information by specialist glazing and roofing subcontractor.
Key:

- Clear glazing
- Back-sprayed glazing RAL 7011
- Structural co-ordination line - dashed red line indicates WIP Structural Design by Curtins.

- Refer to:**
- Sheets 3001-3028 for Facade Study Drawings at 1:25
 - Sheets 3030-3049 for Typical External Wall System Details
 - Sheets 3050-3067 for External Wall System Type drawings
 - Sheets 3080-3094 for additional Glazing Details
 - Sheets 3101-3112 for Glazing Setting Out Plans
 - 63068-HOD-ZZ-ZZ-SC-A-3000 for Facade Finishes Schedule
 - Facade Performance Specification by Wintech
 - Sheets 3114-3116 Perimeter Sections/Elevations

C01	Team Issue	2022.07.27
P02	Issued for coordination.	2022.06.10
P01	Issued for Coordination	2022.05.25
Rev:	Details:	Date:

client:
S+M + BOWMER + KIRKLAND
project:
St. Michaels
job number:
0601
status:
STAGE 4

title:
EWS03 Typical Details - Sheet 2

scale: As indicated @ A1
drawn by: JP

drawing number:
3037

drawing number BS protocol:
63068-HOD-ZZ-ZZ-DR-A-3037

current revision date: 2022.07.27
revision: C01

SGI Studios
1 Kelso Place
Marine Parade M15 4LE
t: +44(0)161 832 9942
e: mail@hodderandpartners.com
w: www.hodderandpartners.com

hodder+partners