


KEY STAGE 1 WING


ADMIN
CENTRAL
ZONE

KEY STAGE 2 WING

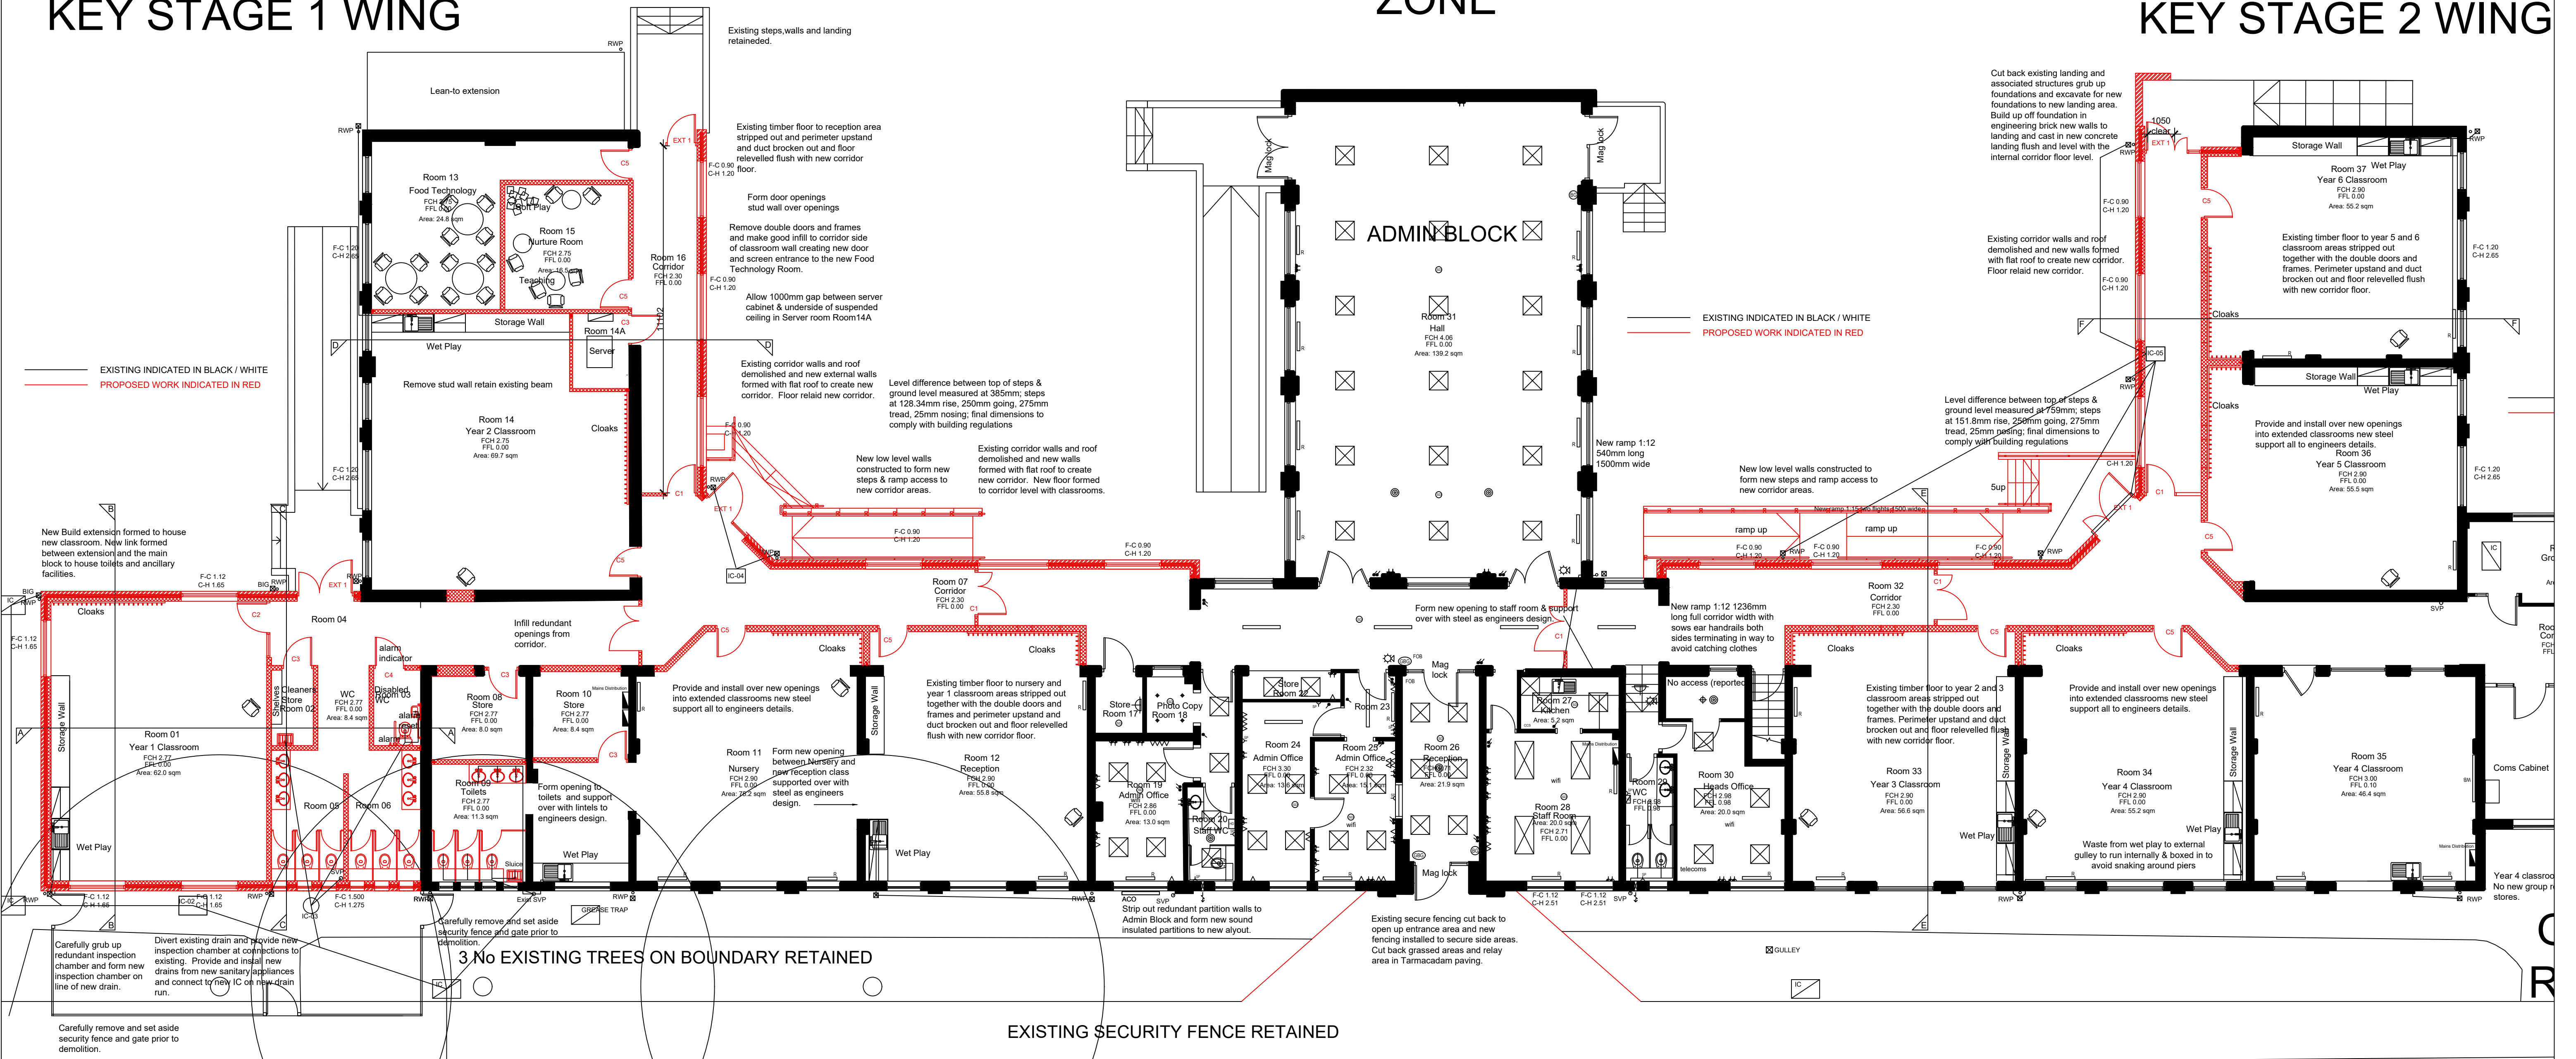

GROUND FLOOR

GROUND FLOOR
RIGHT HANDSIDE

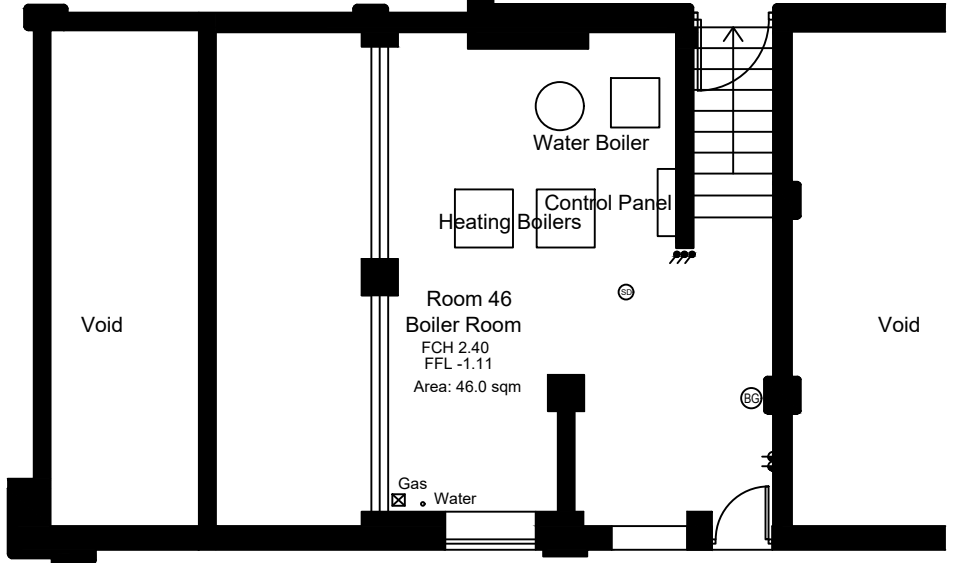

BASEMENT (PLANT ROOM)

Rev	Date	Description
A	24.09.20	VALUE ENGINEERING
B	08.10.20	DRAINAGE, DIMS, FIRE ALARM ADDED
C	AUG 21	SERVER ROOM UPDATED
D	AUG 21	ROOM 34 WET PLAY SWAPPED
E	AUG 21	PHASE 1 RAMP REVERTED, HANDRAILS ADDED
F	NOV 21	AMENDED INLINE WITH AR EMAIL 10.11.21
G	OCT 22	AS BUILT
H	MAY 23	STAGE UPDATED TO AS BUILT



Arcus Consulting LLP
Warrfield 0192 466 9000
Liverpool 0151 708 1080
info@arcus.uk.com

Manchester 0161 905 3222
Newcastle 0191 280 4000
www.arcus.uk.com

London 0208 8742 2512

Client
OASIS COMMUNITY LEARNING

Project
OASIS ACADEMY ASPINAL

Title
PLANS PROPOSED

Scale	Date	Stage
1:50	22.08.19	AS BUILT
Job No	Drawing No	Rev
5926-03	201	AS INDICATED

Drawn
AW

Approved
AR

This drawing is the copyright of Arcus. Contractors must check all dimensions on site. Do not scale the drawings. Only figured dimensions are to be worked to.