




Front as Built

Rear as Built

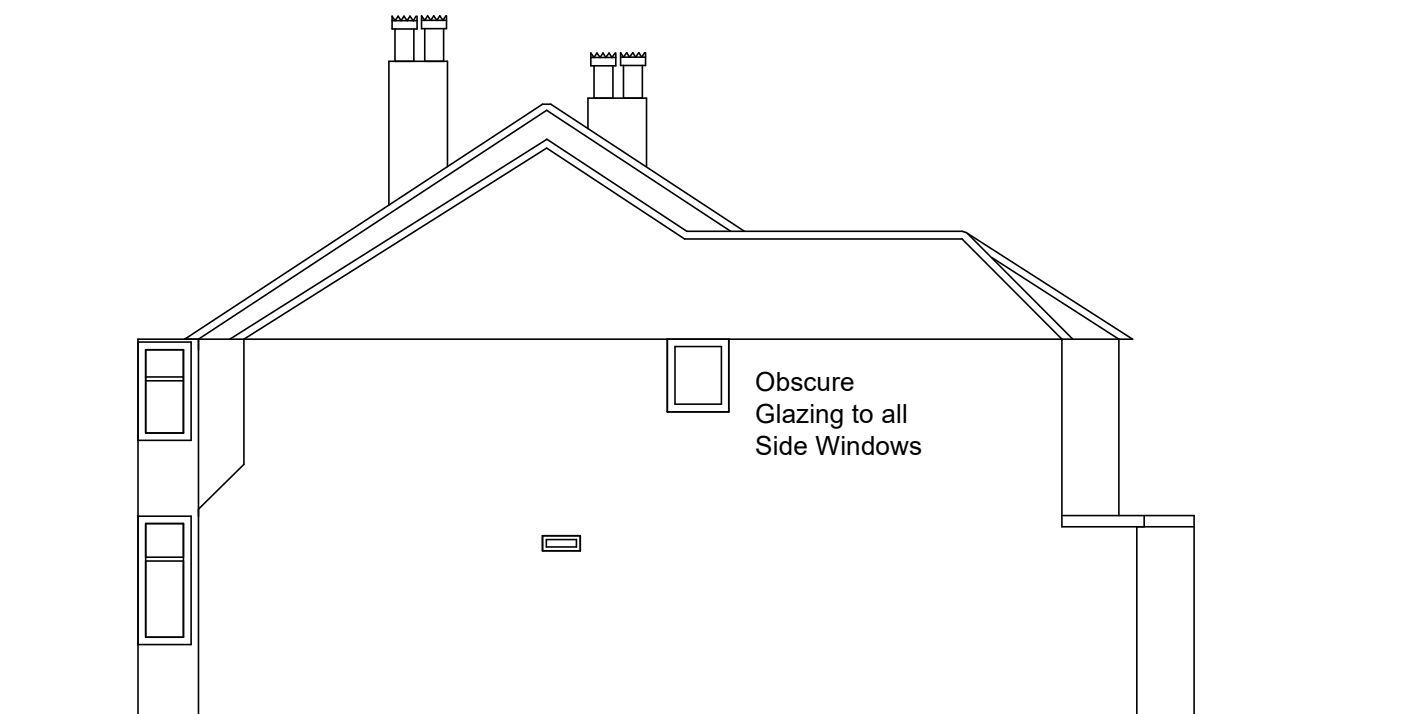

Side to 406 as Built

408 Mauldeth Road West Chorlton
Manchester M21 7RA

Two Storey Extension Resubmission
Drawing 2 Elevations As Built

Drawing Number 2301-02 12/01/23
Loganbuilding@outlook.com

07904 649901
Scale 1:100@A3