



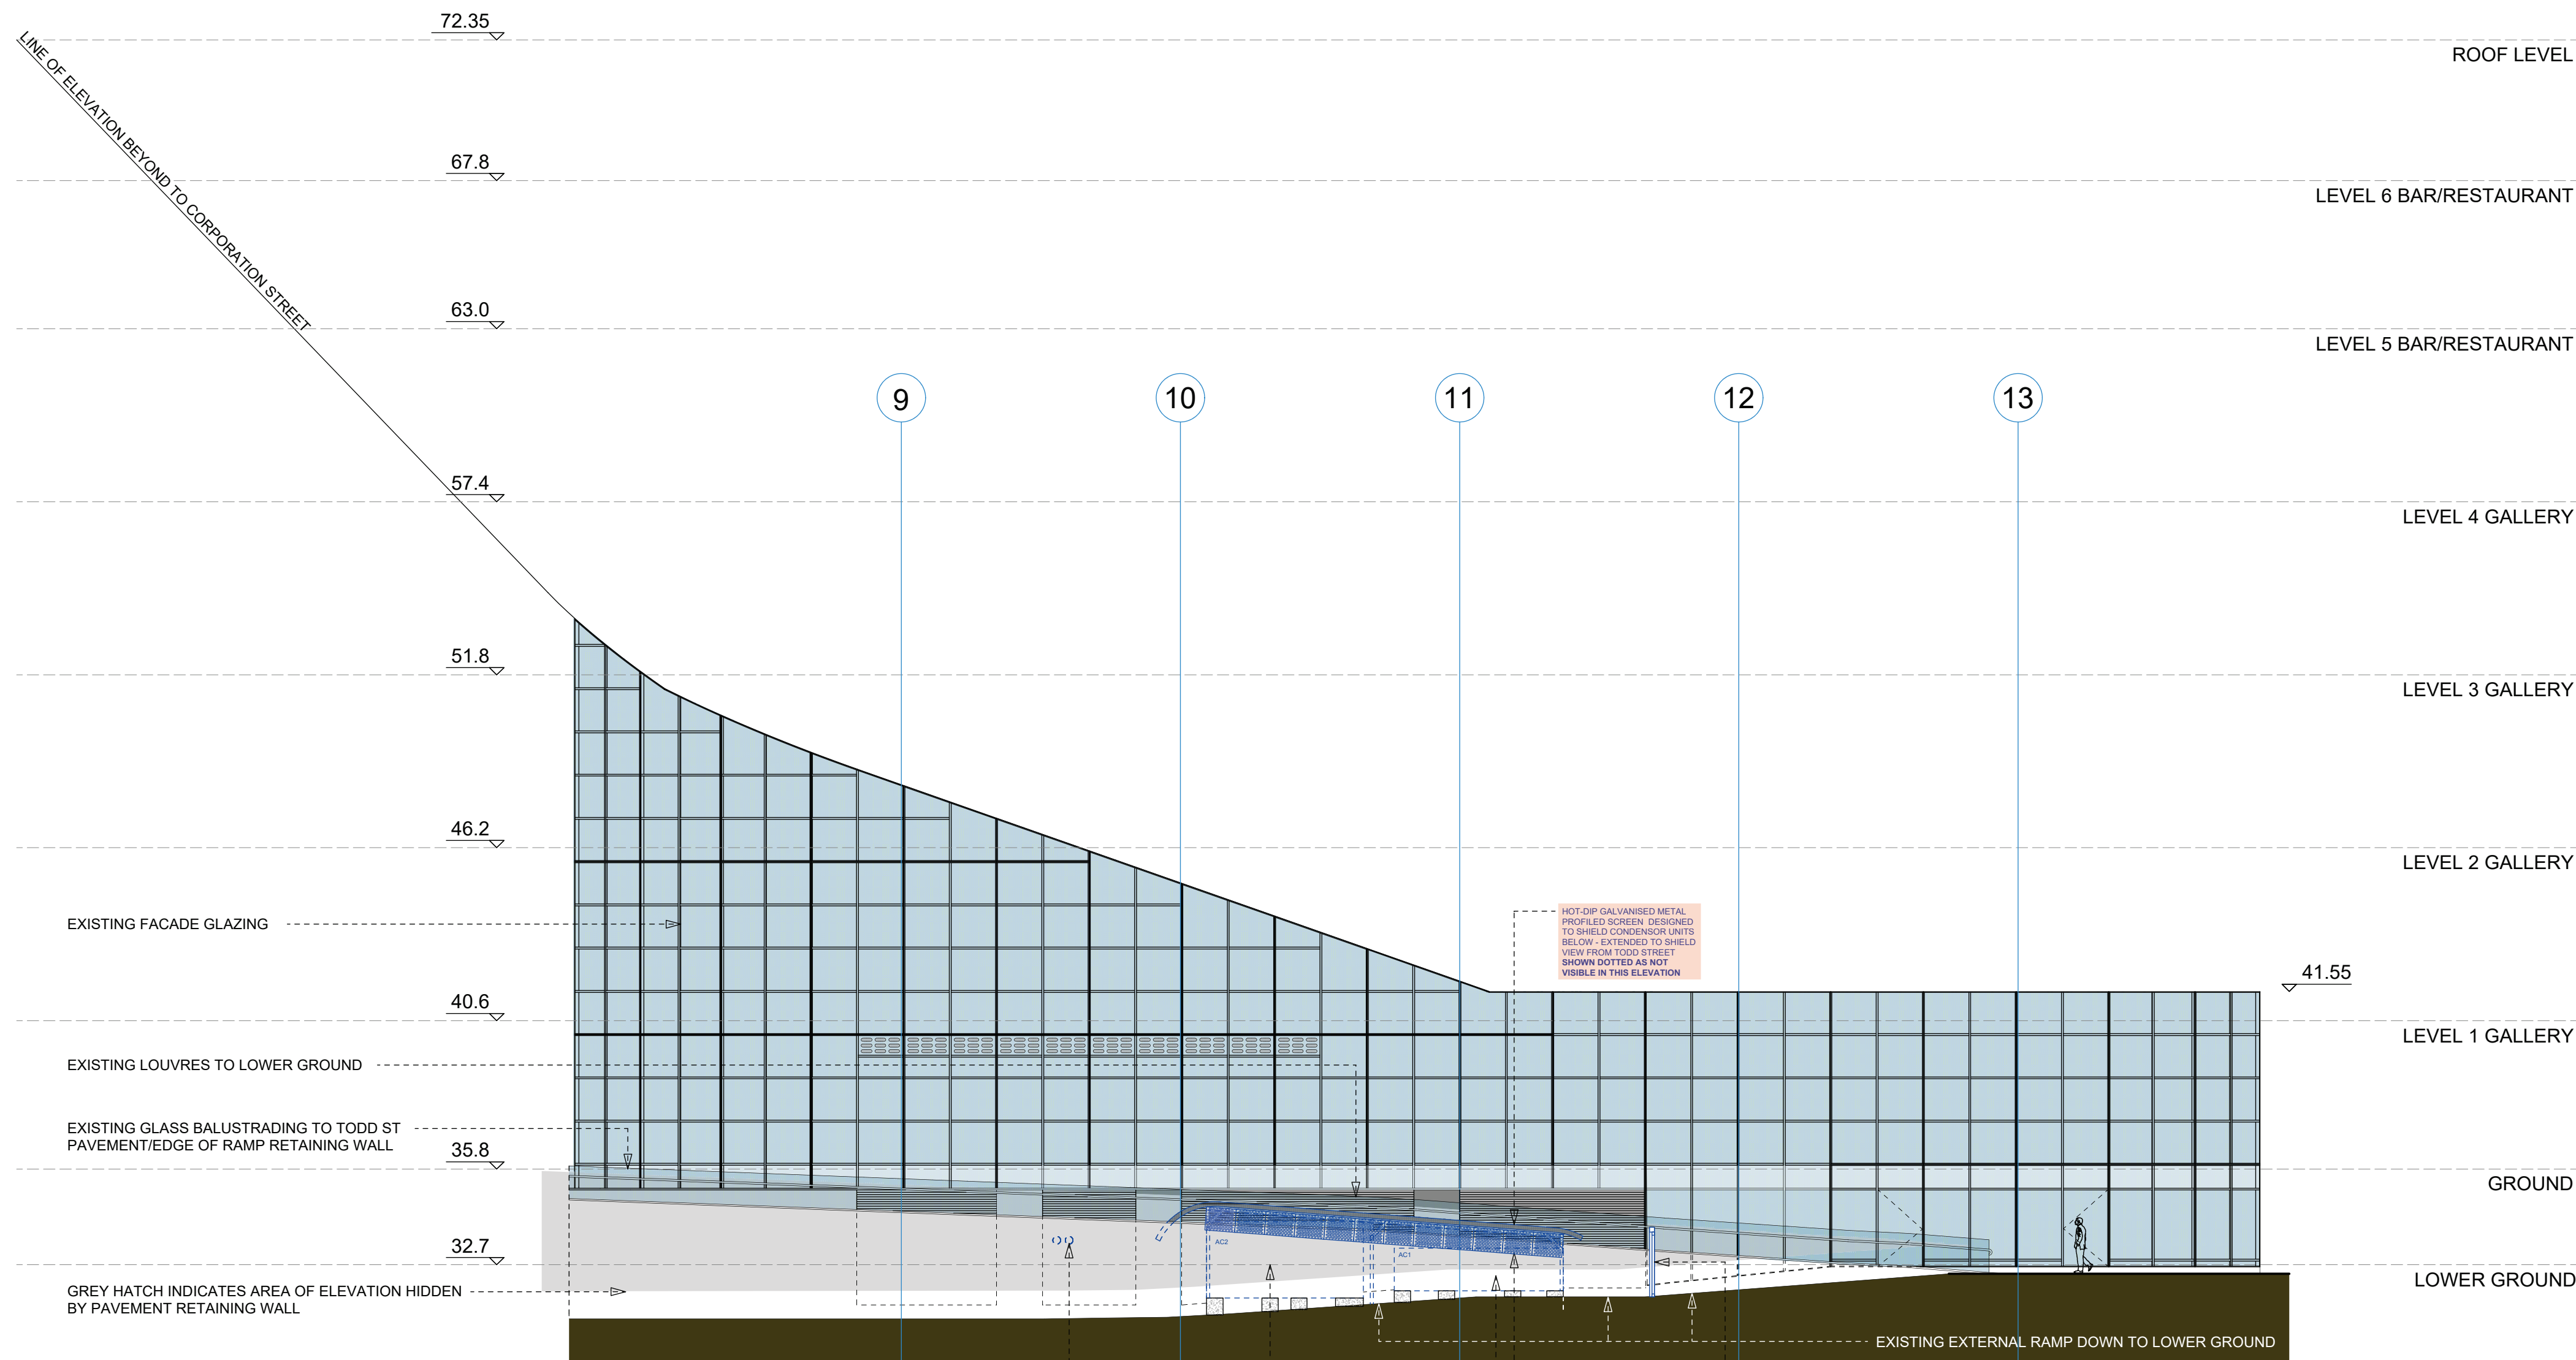

2500 CONDENSER WATER PIPELINES FROM INTERNAL CHILLER TO ADABATIC COOLING UNITS RETROCLAD WITH STUCCO EMBOSSED ALUMINUM CLADDING SHOWN DOTTED AS NOT VISIBLE IN THIS ELEVATION	CARRIER AIR COOLED CONDENSERS DISCHARGING TOWARDS THE BUILDING (NOT VERTICALLY) REJECTING HEAT SHOWN DOTTED AS NOT VISIBLE IN THIS ELEVATION	HOT-DIP GALVANISED PERFORATED METAL SCREENS RETROFITTED TO SHIELD CONDENSER UNITS FROM VIEW ALONG TOWN STREET SHOWN DOTTED AS NOT VISIBLE IN THIS ELEVATION	HOT-DIP GALVANISED METAL FIXED MESH PANEL AND OPENING MESH GATES
--	---	--	---

REFER TO LARGE SCALE
FENCE & GATE DETAIL

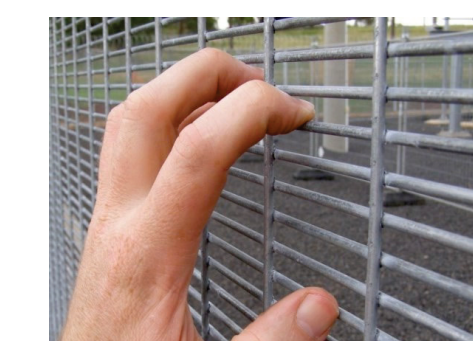

- BOWKER SADLER PARTNERSHIP LIMITED
- THIS DRAWING IS THE SUBJECT OF COPYRIGHT WHICH VESTS IN BOWKER SADLER PARTNERSHIP LIMITED. IT IS AN INFRINGEMENT OF COPYRIGHT TO REPRODUCE THIS DRAWING, BY WHATEVER MEANS, INCLUDING ELECTRONIC, WITHOUT THE EXPRESS WRITTEN CONSENT OF BOWKER SADLER PARTNERSHIP LIMITED WHICH RESERVES ALL ITS RIGHTS
- BOWKER SADLER PARTNERSHIP LIMITED ASSERTS ITS RIGHTS TO BE IDENTIFIED AS THE AUTHOR OF THIS DESIGN
- DRAWING NOT TO BE SCALED
- REPORT ERRORS & OMISSIONS TO ARCHITECT.
- CHECK ALL DIMENSIONS ON SITE
- DRAWINGS TO BE READ IN CONJUNCTION WITH THE HEALTH AND SAFETY PLAN AND ALL RELEVANT RISK ASSESSMENTS

A	NOV 2022	DL	DRAWING UPDATED TO AS-BUILT SHOWING REVISED DETAIL TO CANOPY AND GATE AS INSTALLED	AS
---	----------	----	--	----

REV	DATE	DRN	CH
-----	------	-----	----

CLIENT
Conlon Construction

SCALE	SHEET SIZE	DRAWN	CHECKED	DATE
1:150 / 1:50	@A1	DL	AS	11.03.21

A: Hatherlow House, Hatherlow, Romiley, Stockport SK6 3DY
T: 0161 406 7333
E: office@bowker-sadler.co.uk
W: www.bowker-sadler.co.uk

JOB No 21-023	DRAWING No 1006	REVISION B
STATUS MINOR AMENDMENT		