
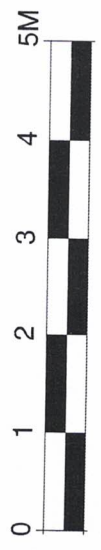


6970

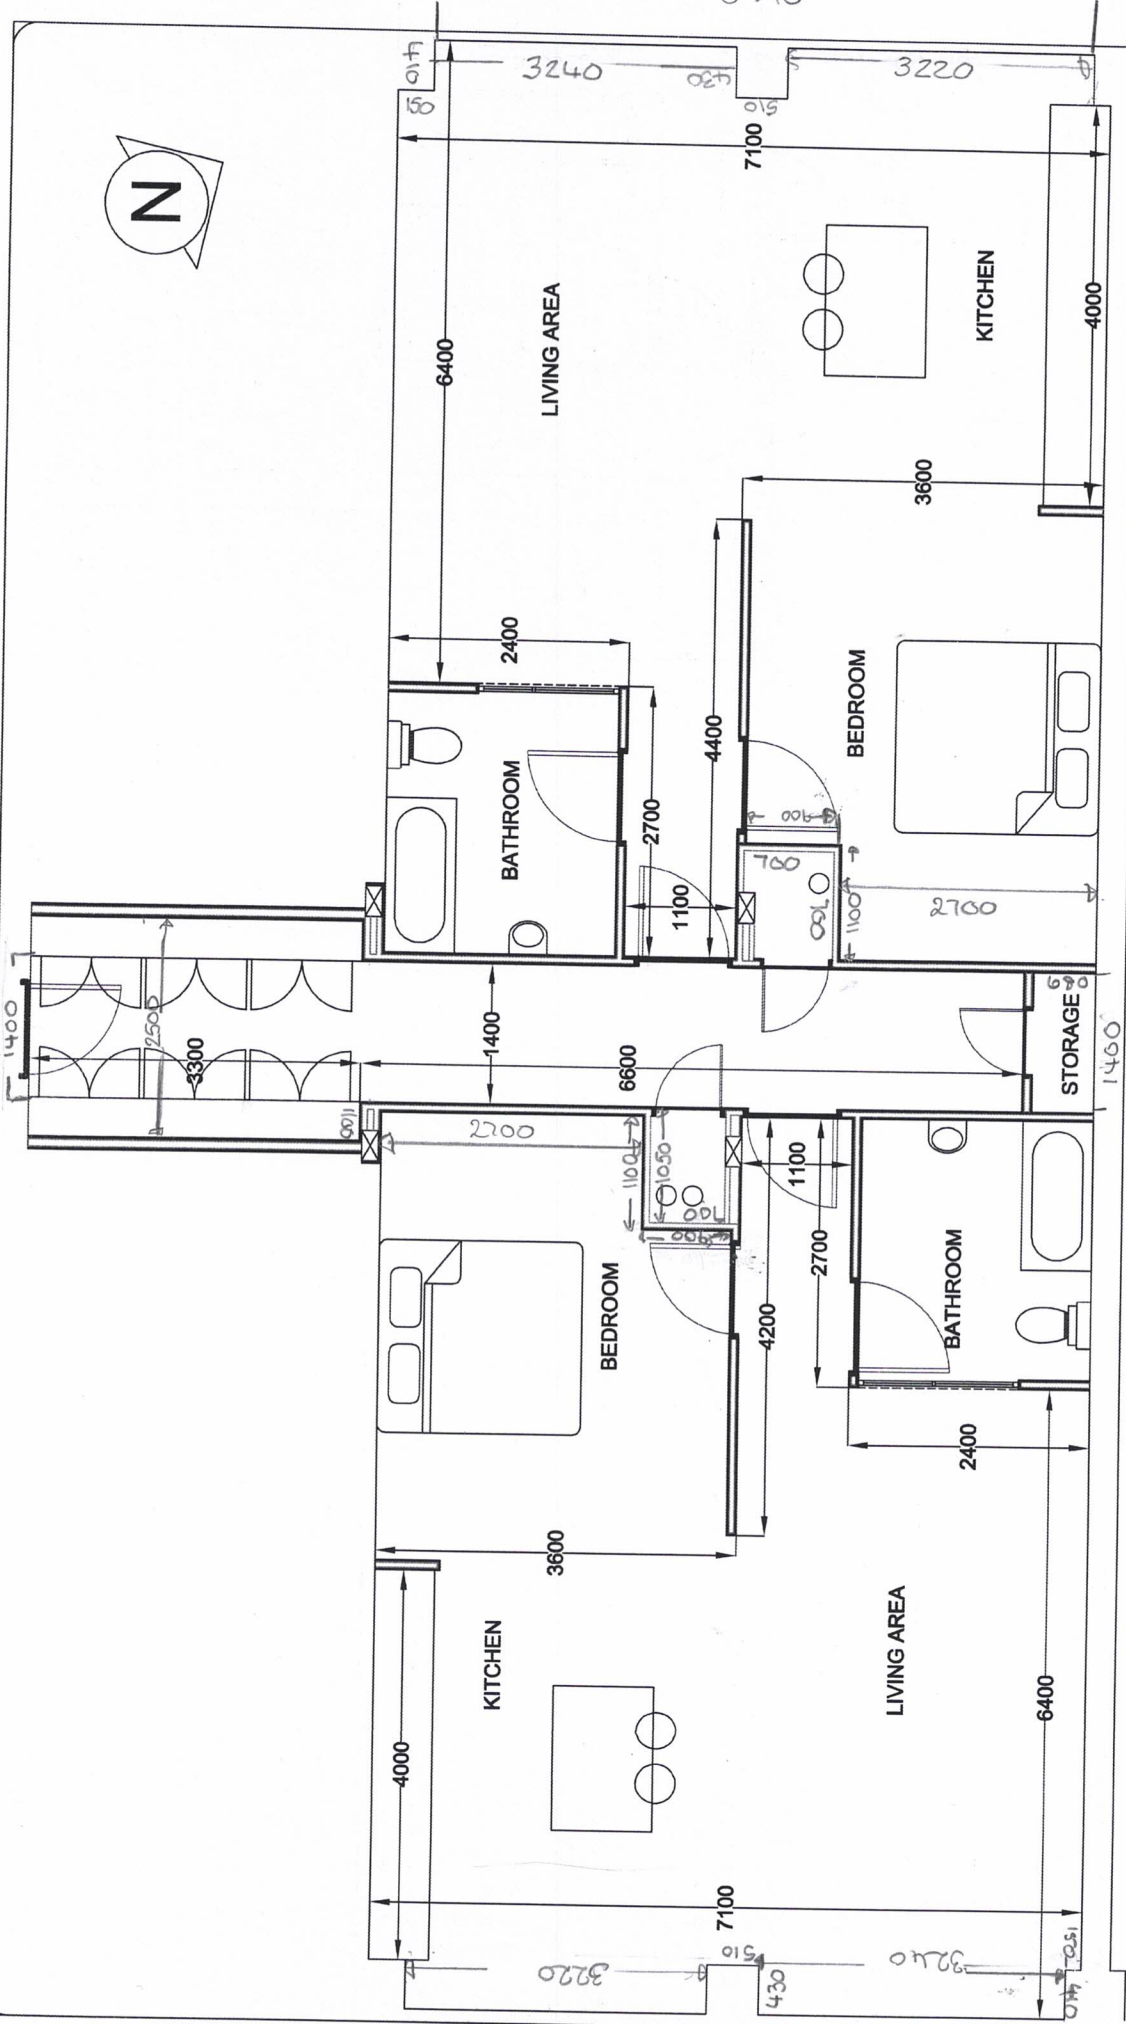

Client	N J Group
Project	Left Bank Apartment Manchester
Title	As-built layout
Drawn	CA
Checked by	-
Date	FEB 2019
Scale (or A3)	1:50
Revision No.	B
Drawing name	Apartment 10.53 - complete

Drawing history			
A	100419	Class wall removed between kitchen and bathroom	CA
B	230519	Adjustments made to match drawing to site dims	CA
Rev	Date	Details of Issue	Initials