



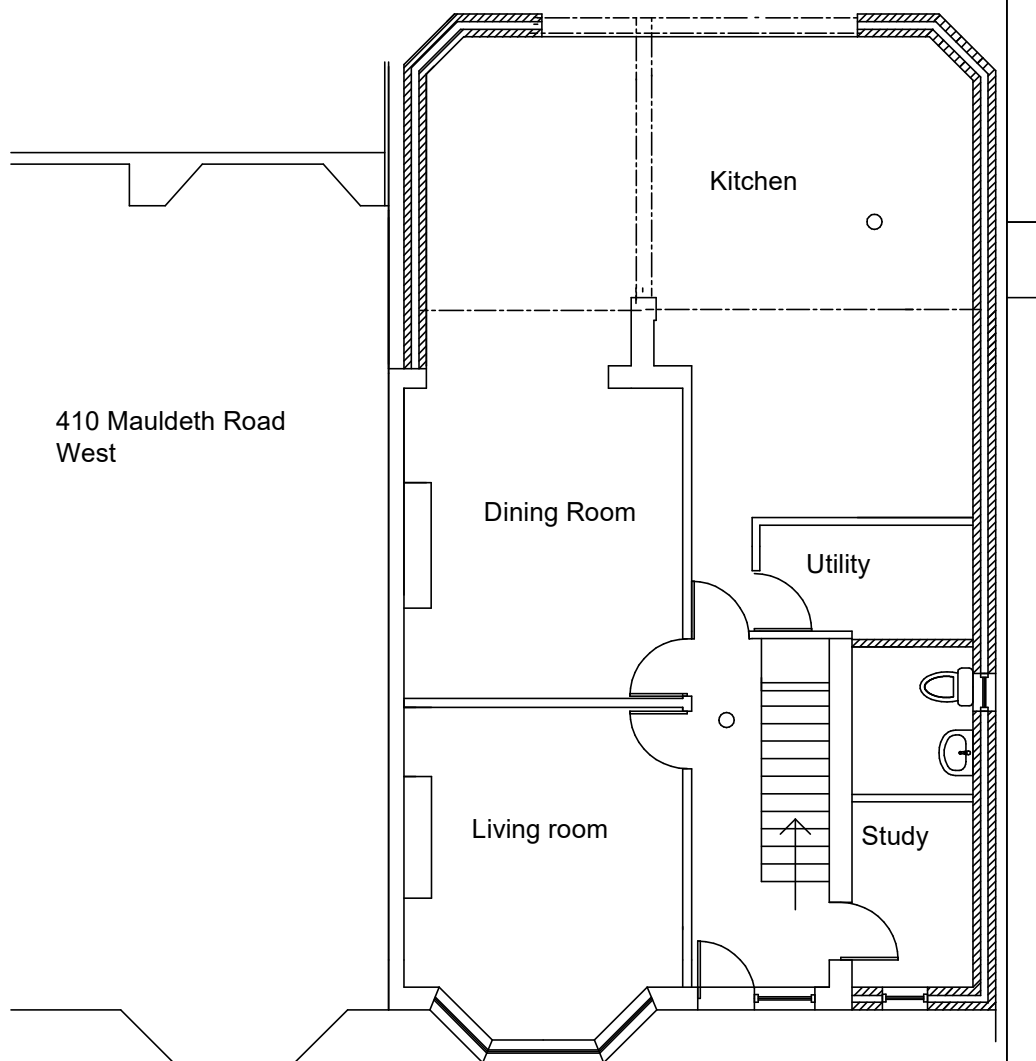

As Built Ground Floor

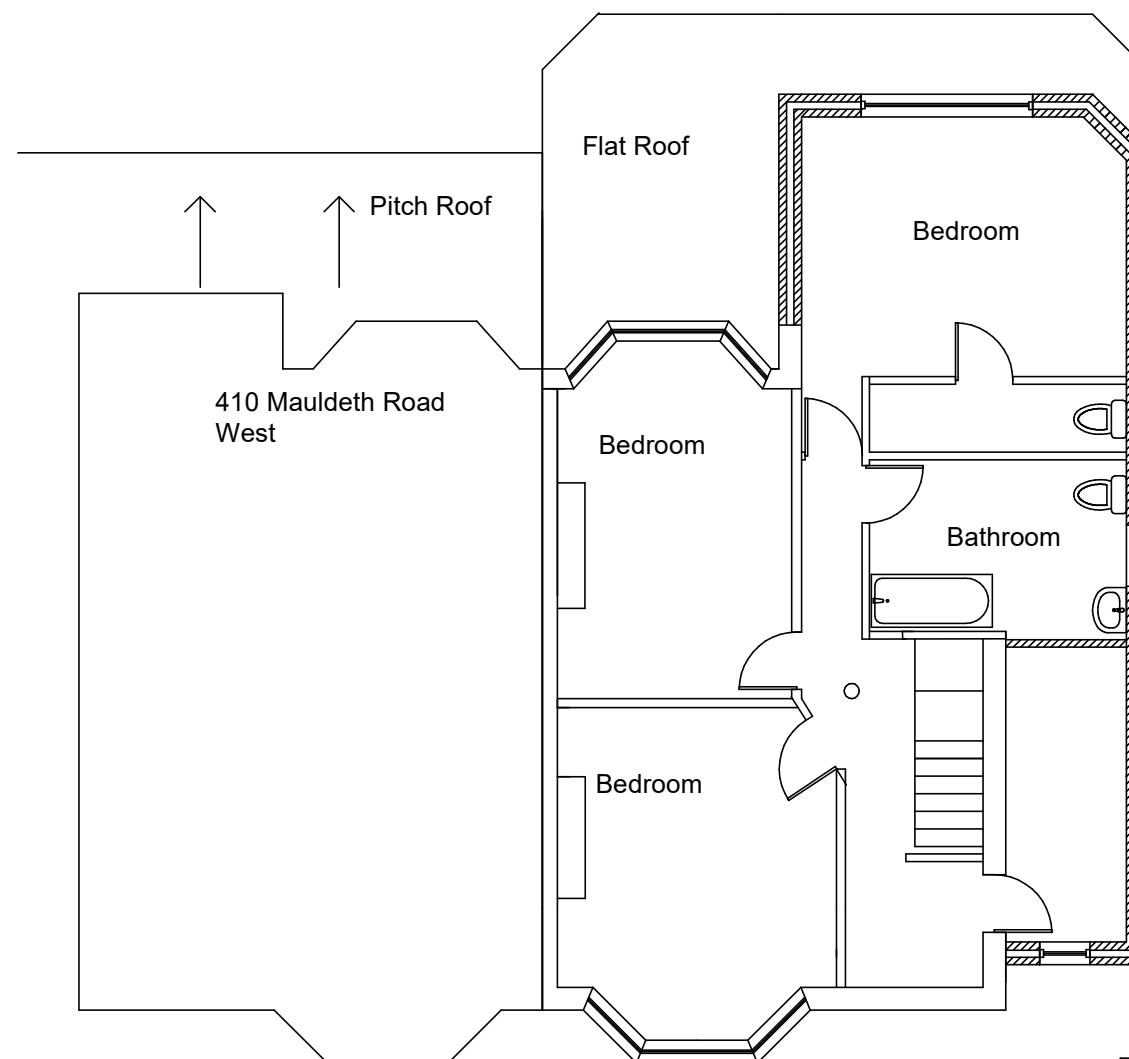

As Built First Floor

408 Mauldeth Road West Chorlton
Manchester M21 7RA

Two Storey Extension Resubmission
Drawing 3 Plans as Built

Drawing Number 2301-03 12/01/23
Loganbuilding@outlook.com

07904 649901
Scale 1:100@A3