


FRONT ELEVATION

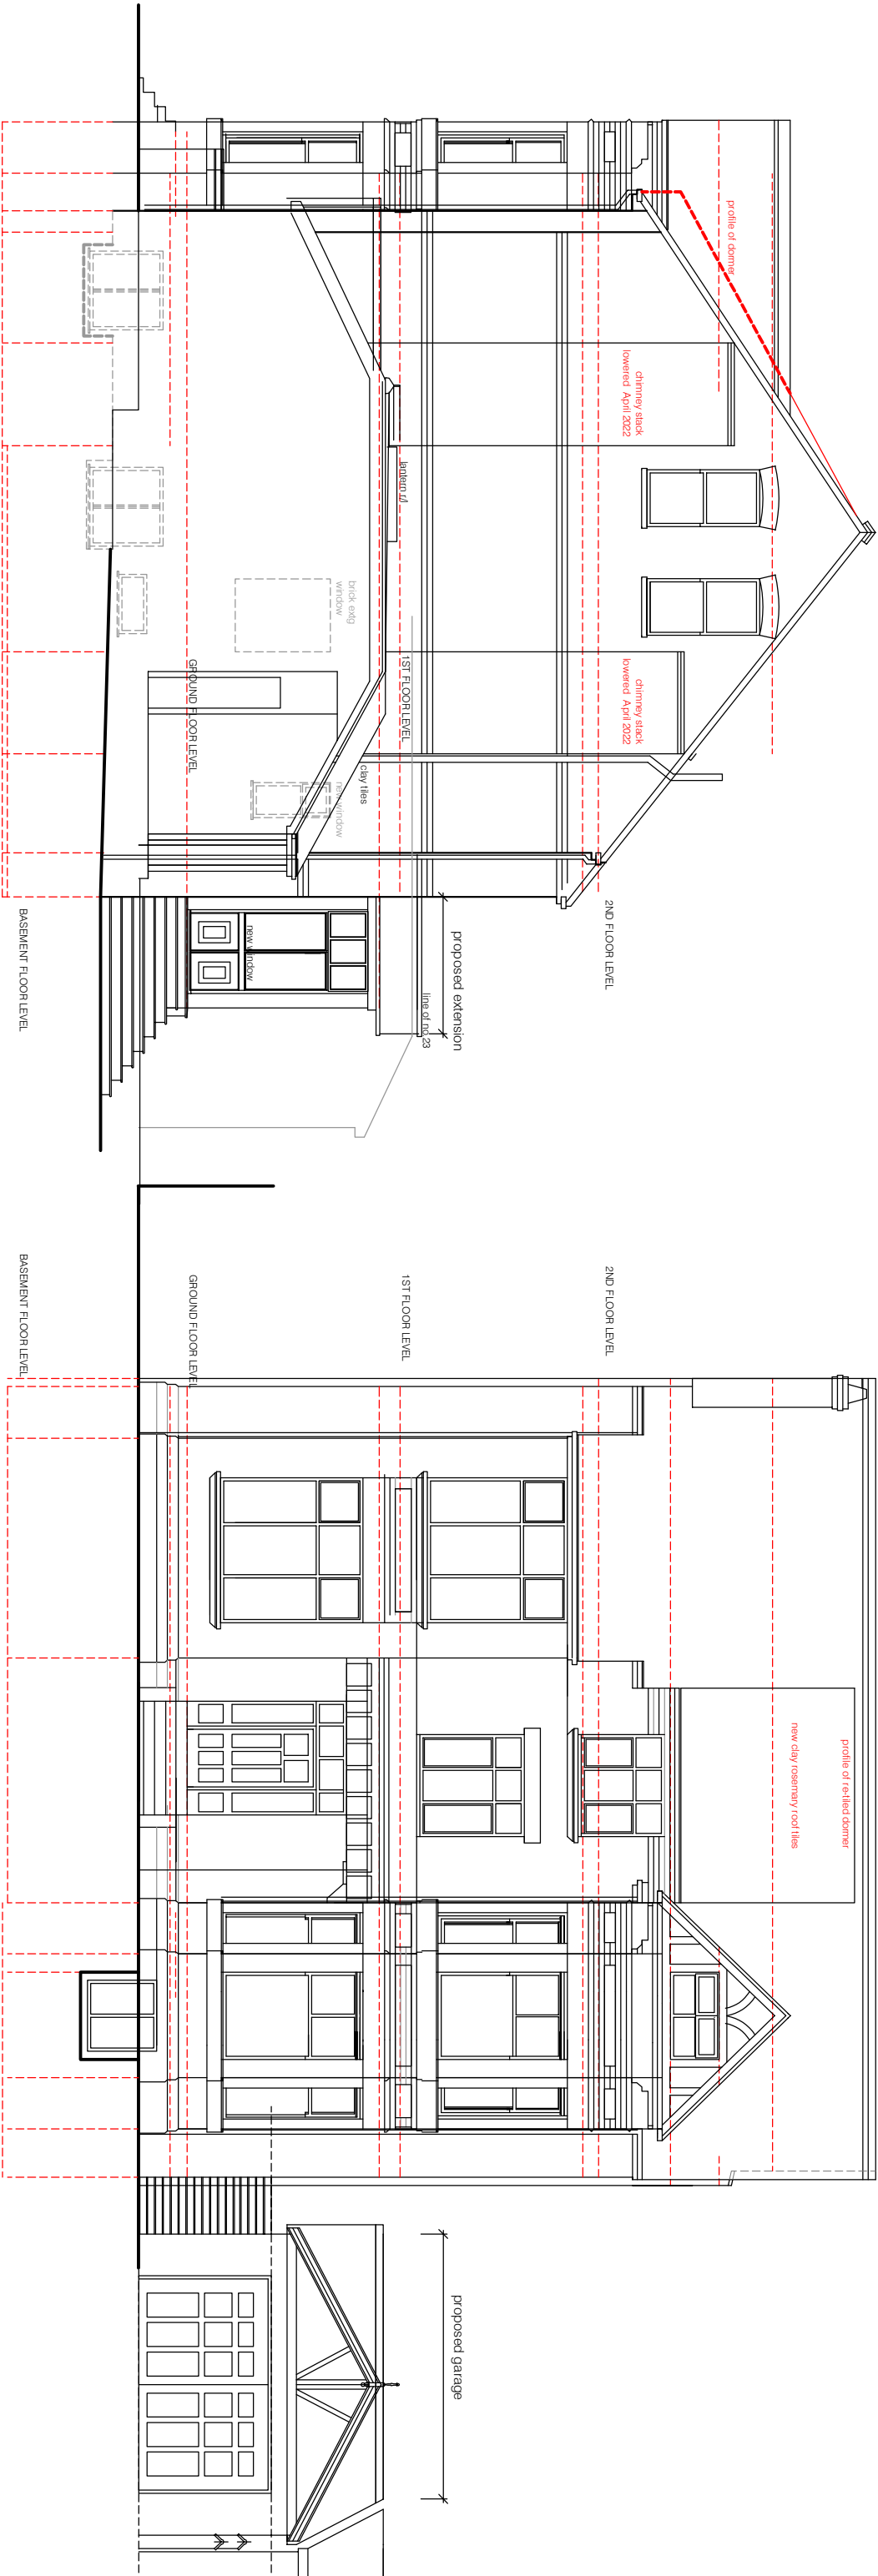

SIDE ELEVATION

FRONT ELEVATION

Proposed finishes:
new rosemary clay tiled roof to main house and new garage
dark grey epdm/GRP flat roof to extension
white timber framed d/g windows to front/side elevation
white upvc timber effect d/g windows to basement windows
black aluminium framed d/g windows to rear elevation house and garage
red/buff facing brick to front walls of garage to match house
common brick walls to side/rear walls of extension and garage to match house
black upvc rw goods and fascias to match existing

Simon R Miles			
Chartered Architect			
Didsbury			
Manchester			
T: 07778 137830			
E: srmilesarchitect@gmail.com			
Revision	Date	Revision note	Notes
P1	22.12.2021	Garage side elevation added	
P2	05.04.2023	fenestration pattern updated to reflect as installed	

Do not scale. Contractor must check all dimensions on site before preparing production drawings or commencing any work. This drawing and its design is the copyright of S.R Miles Ltd and may not be reproduced in any form whatsoever without their prior express written consent.

Project:
25 Parkfield Road South Didsbury

Title:
Elevations as proposed - 2

Drawing number: **Issue:**
21 308 PL203 P2

Client:
Mr & Mrs McDonald

Scale:
100@A3

Date:
15.12.2021

CAD Ref:
21 308

Drawn by:
SRM