


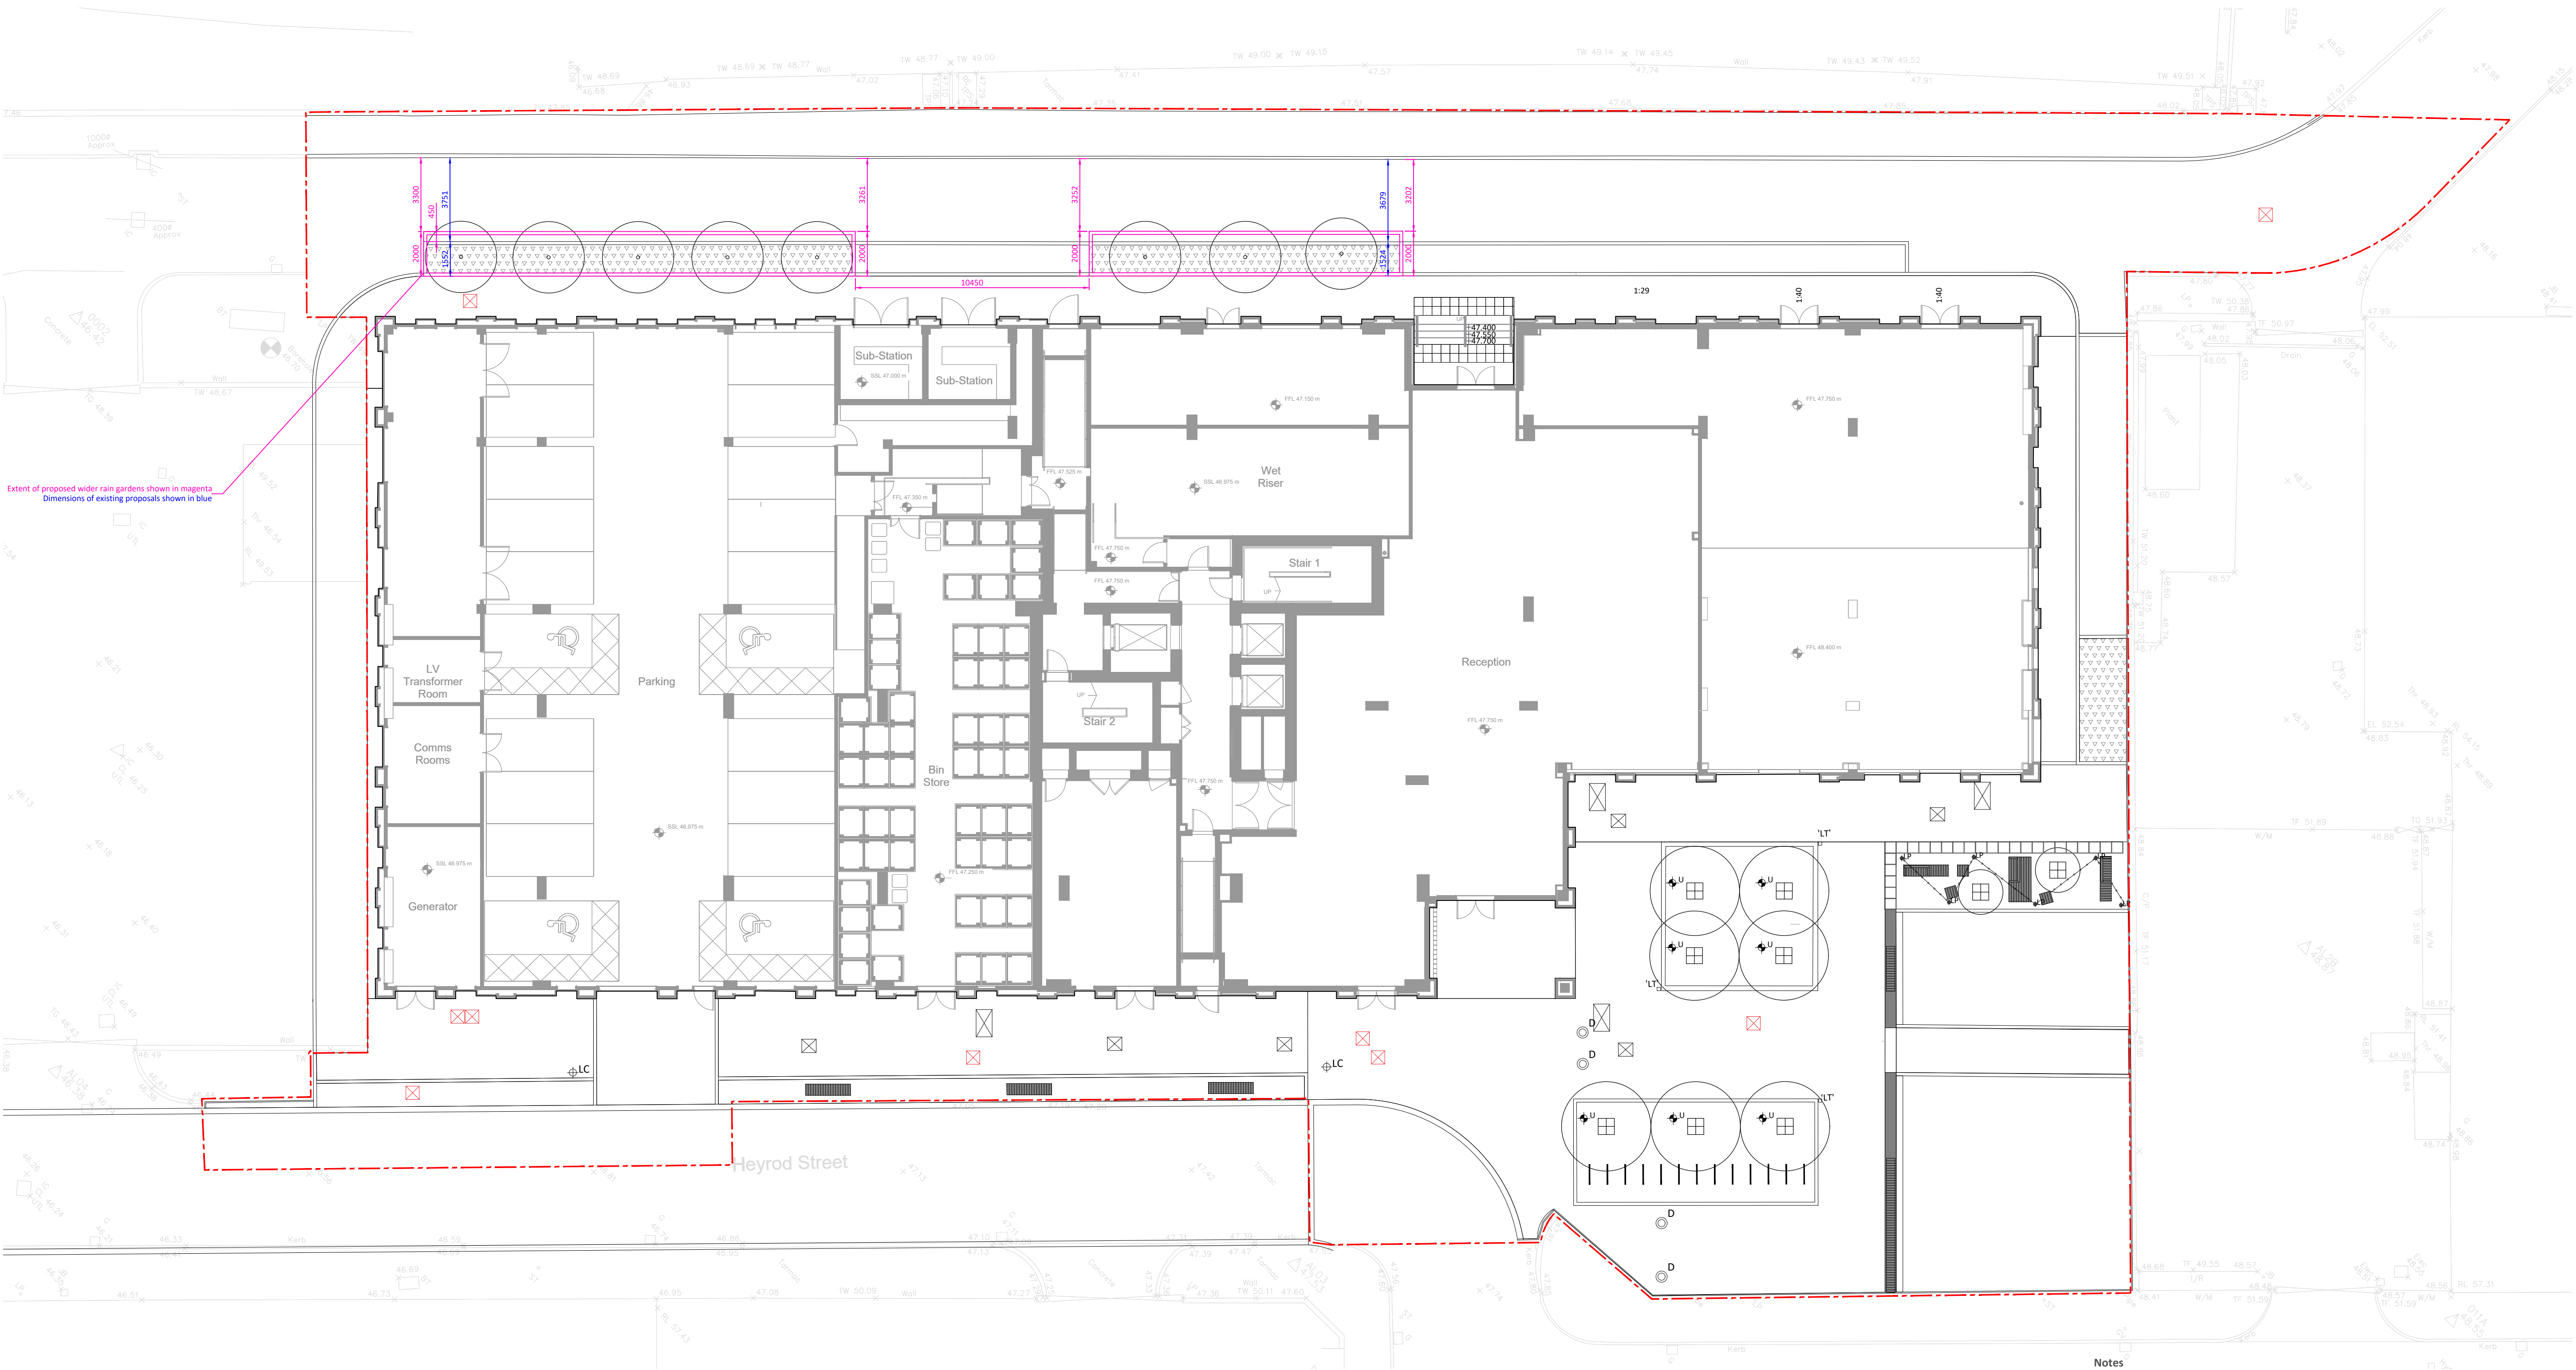

Notes

- All dimensions in mm, unless otherwise stated.
- Scaling from drawing if printed incorrectly may lead to errors.
- All information outside red line boundary shown for contextual purpose only.
- All hatch patterns are indicative only unless stated otherwise.
- This drawing is to be read in conjunction with the following re-form landscape architecture documentation:
 - CAS-RFM-XX-L0-DR-L-19-0003- Landscape General Arrangement -Level 00
 - CAS-RFM-XX-L0-DR-L-19-0022- Planning Condition Landscape General Arrangement-Level 00
 - CAS-RFM-XX-L0-DR-L-19-8008-Planning Conditions Tree Details
- AND all relevant documentation from the design team
- Levels information on this drawing illustrates the design intent. The contractor is to check and verify all levels and dimensions against site survey information.
- Any discrepancies in the design information are to be brought to the attention of re-form landscape architecture, in writing, prior to commencement of construction works.
- All proprietary products shall be installed in strict accordance with manufacturers written instructions.
- Refer to other consultants' drawings and specifications for the following design information:
 - Foundation details
 - Base course and/or sub bases design & specification
 - Waterproofing of any element
 - Levels & Drainage design and infrastructure
 - Lighting and ducting
 - Existing & proposed utilities
- Plant quantities are to suit site areas in accordance with scheduled plant densities.
- Any proposed plant substitution shall be agreed with the landscape architect prior to ordering.

24.10.22	For review and comment	EB	EB	DL	P01
Date	Description of revision	Drawn	Checked	Approved	Revision

re-form

landscape architecture

Beehive Mill, Jersey Street,
Manchester M4 6JG
T: +44 (0)161 397 4953
E: info@re-formlandscape.com
W: re-formlandscape.com

Project
THE CASTINGS, 2 HEYROD STREET
RF20-799

Client
PACKAGED LIVING

Document title
PROPOSED WIDENED RAIN GARDENS SKETCH

Paper size
A1

Status
FOR INFORMATION

Drawing number
0799-RFM-XX-00-DR-SK-0021

© re-form landscape architecture

Scale
AS
SHOWN

Revision
P01