



ALL DIMENSIONS ARE IN MILLIMETRES

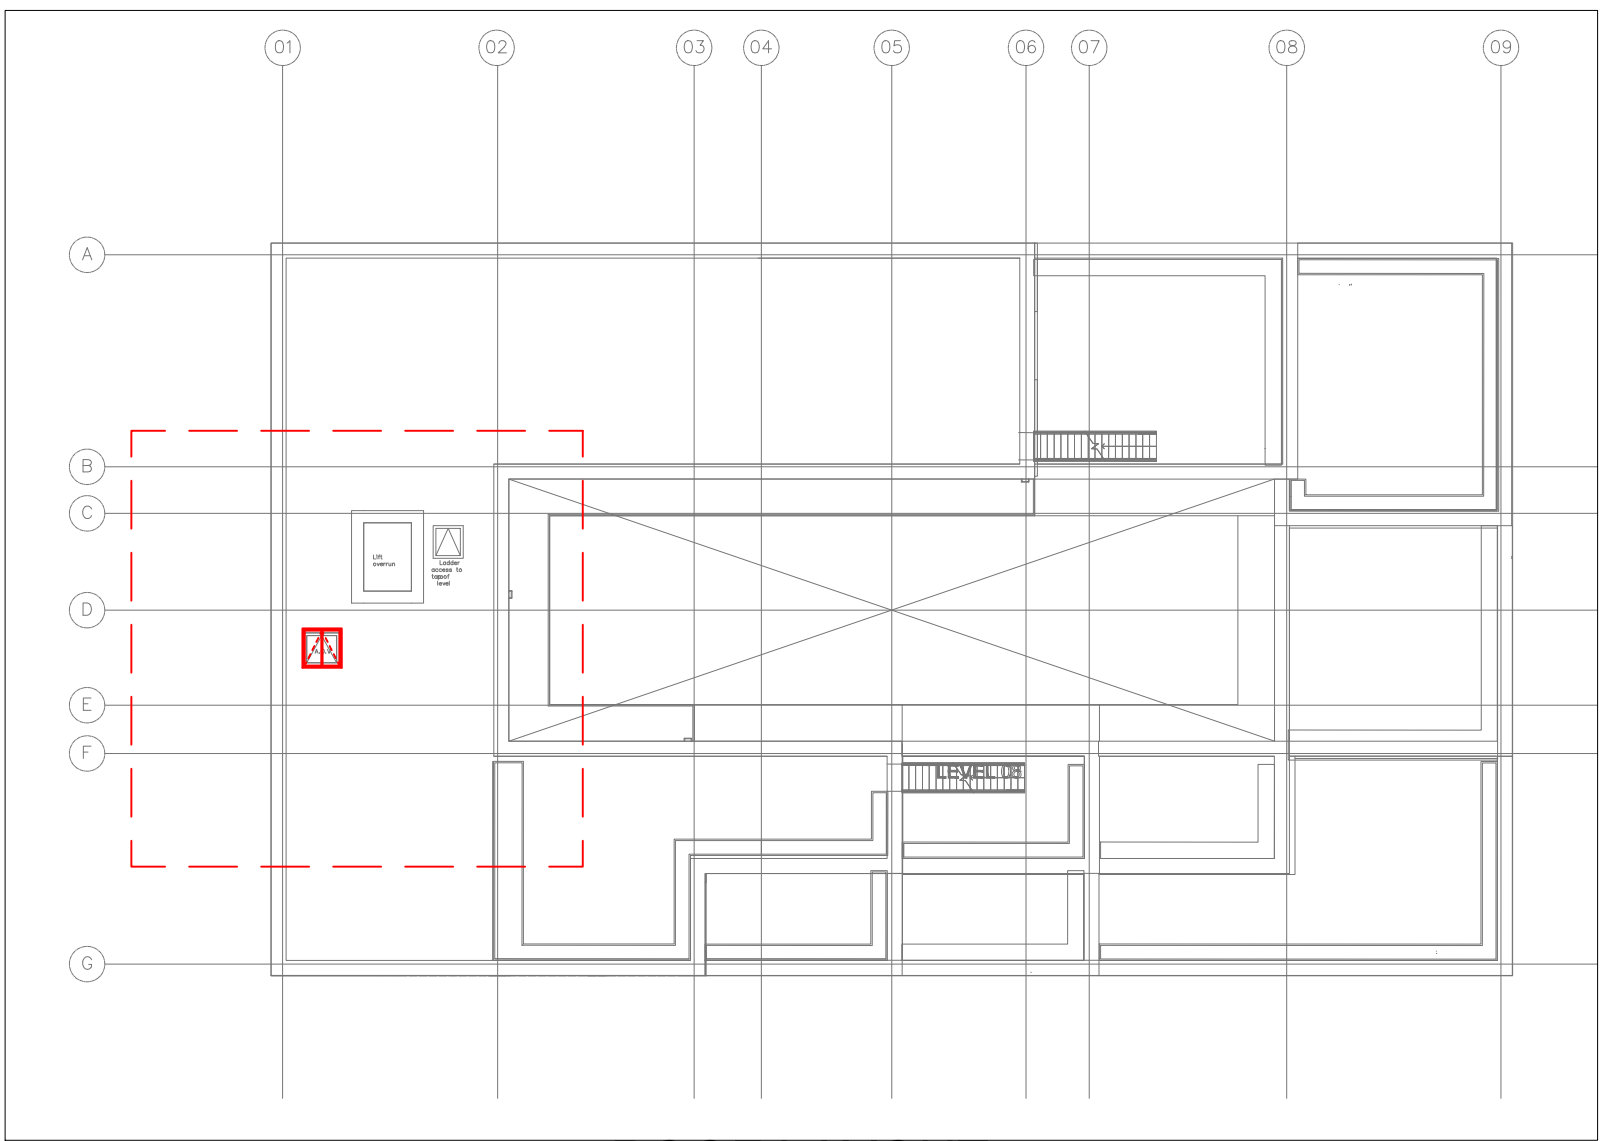

ROOF LAYOUT
(SCALE 1:250)

HEAD OF STAIR 1.0m² OSTRO AOV
SEE DRAWING AE-DS-51041-201

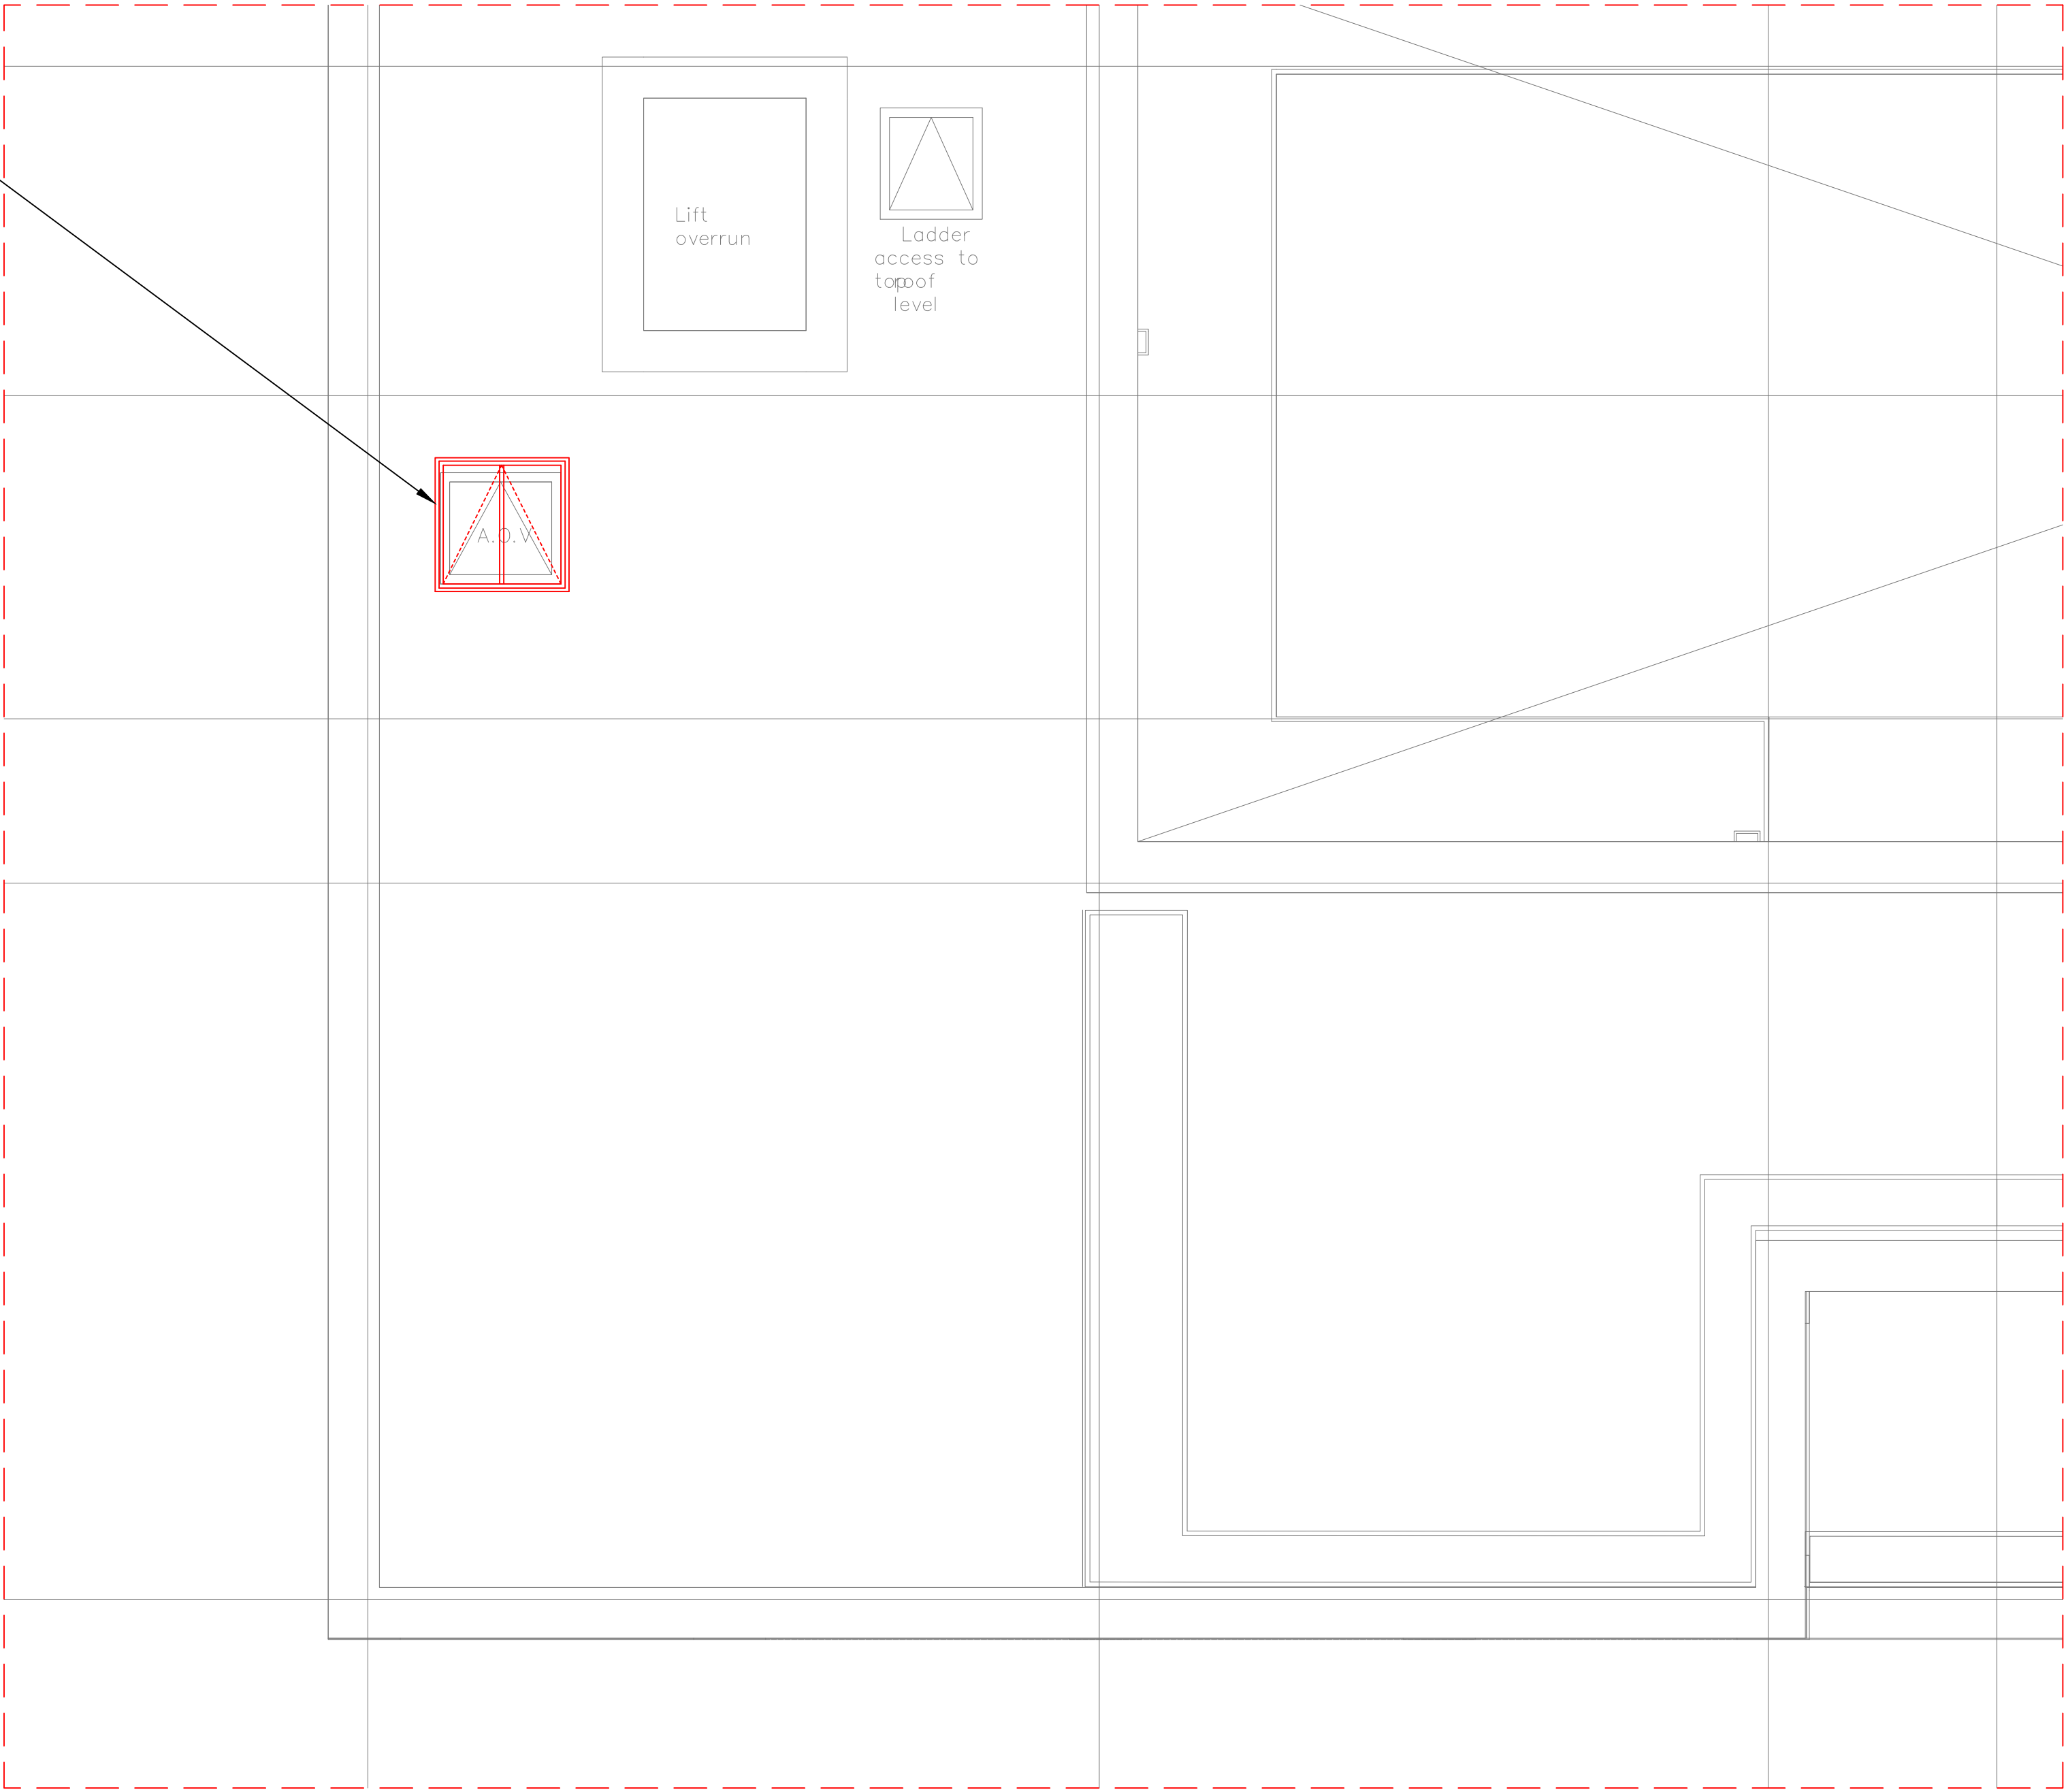

ROOF LAYOUT
(SCALE 1:50)

LAYOUT DETAIL TAKEN FROM:
WECE/214/M/120 REV T2

AF	08.12.22	AS FITTED DRAWING NUMBER UPDATED AS CLIENTS REQUEST	AJM	AJM
ABO	02.11.22	AS BUILT	RA	AJM
A	30.04.21	ISSUE FOR APPROVAL	RK	RA
REV	DATE	DETAILS	DRWCHK BY	BY

DRAWING REVISION DETAILS



VENT ENGINEERING
UNITS 16C & 16F,
CHALWYN INDUSTRIAL ESTATE
POOLE, BH12 4PE
TEL. +44(0)1202 744958
www.vent.co.uk

ALL RIGHTS RESERVED. NO PART OF
THIS DOCUMENT MAY BE REPRODUCED,
STORED IN A RETRIEVAL SYSTEM OR
TRANSMITTED IN ANY FORM OR BY ANY
MEANS, ELECTRONIC, MECHANICAL,
PHOTOCOPY, RECORDING OR
OTHERWISE WITHOUT THE PRIOR
WRITTEN PERMISSION OF VENT
ENGINEERING.
© VENT ENGINEERING 2021

CLIENT
AMEON BUILDING SERVICES ENGINEERING
PROJECT
ADDINGTON STREET

SALES ORDER No.
621124

DRAWING TITLE
ROOF LAYOUT

DRAWING STATUS
☐ PRELIMINARY ☐ APPROVAL
☐ CONSTRUCTION ☒ AS BUILT
☐ INFORMATION ONLY

DRAWN BY DATE SCALE SHEET SIZE
RK 30.04.2021 AS SHOWN A1

DRAWING No. REV
AS01-AME-57-RF-DR-M-1002 AF