


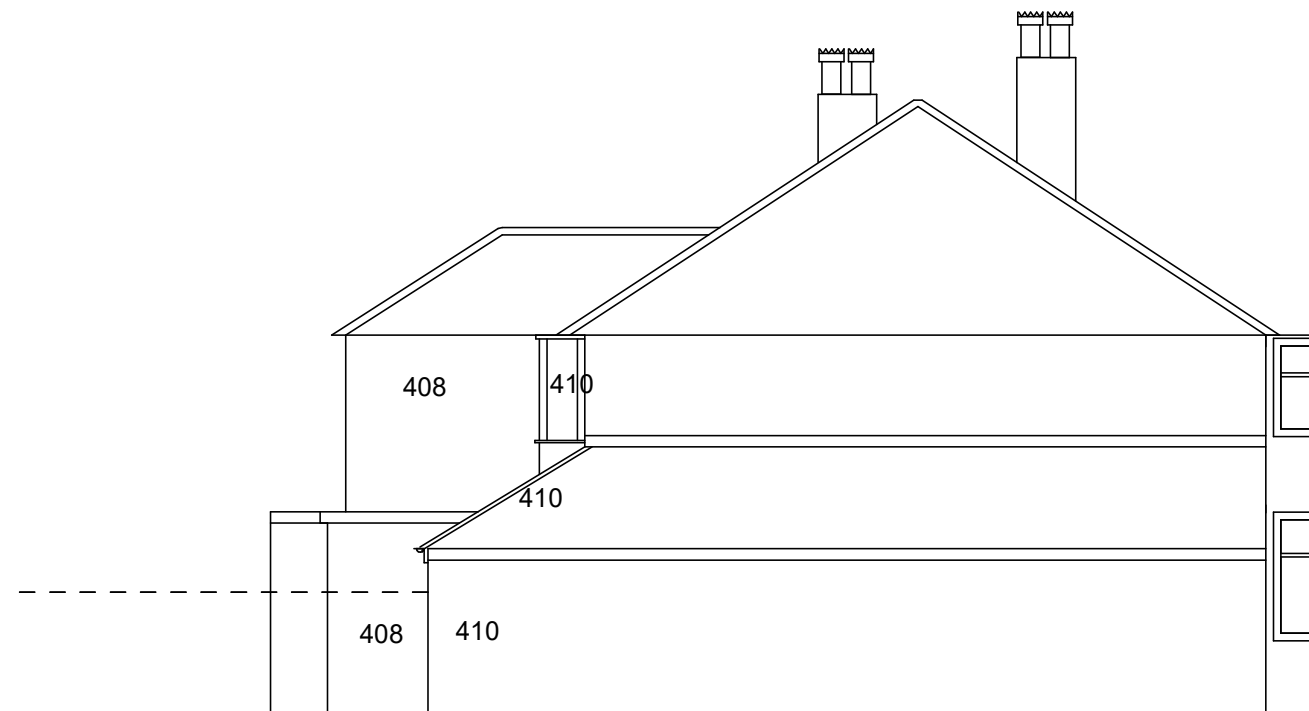

\Dotted line indicates
fencing at boundary.

Side to 410 as Built

408 Mauldeth Road West Chorlton
Manchester M21 7RA

Two Storey Extension Resubmission
Drawing 4 Elevations As Built

Drawing Number 2301-04 02/02/23

Loganbuilding@outlook.com

07904 649901

Scale 1:100@A3