



- ☐ PRELIMINARY FOR APPROVAL
- ☐ AGREED LAYOUT - SIGNED OFF
- ☒ PLANNING DRAWING
- ☐ BUILDING CONTROL DRAWING
- ☐ TENDER DRAWING
- ☐ CONTRACT DRAWING
- ☐ CONSTRUCTION DRAWING
- ☐ AS-BUILT DRAWING

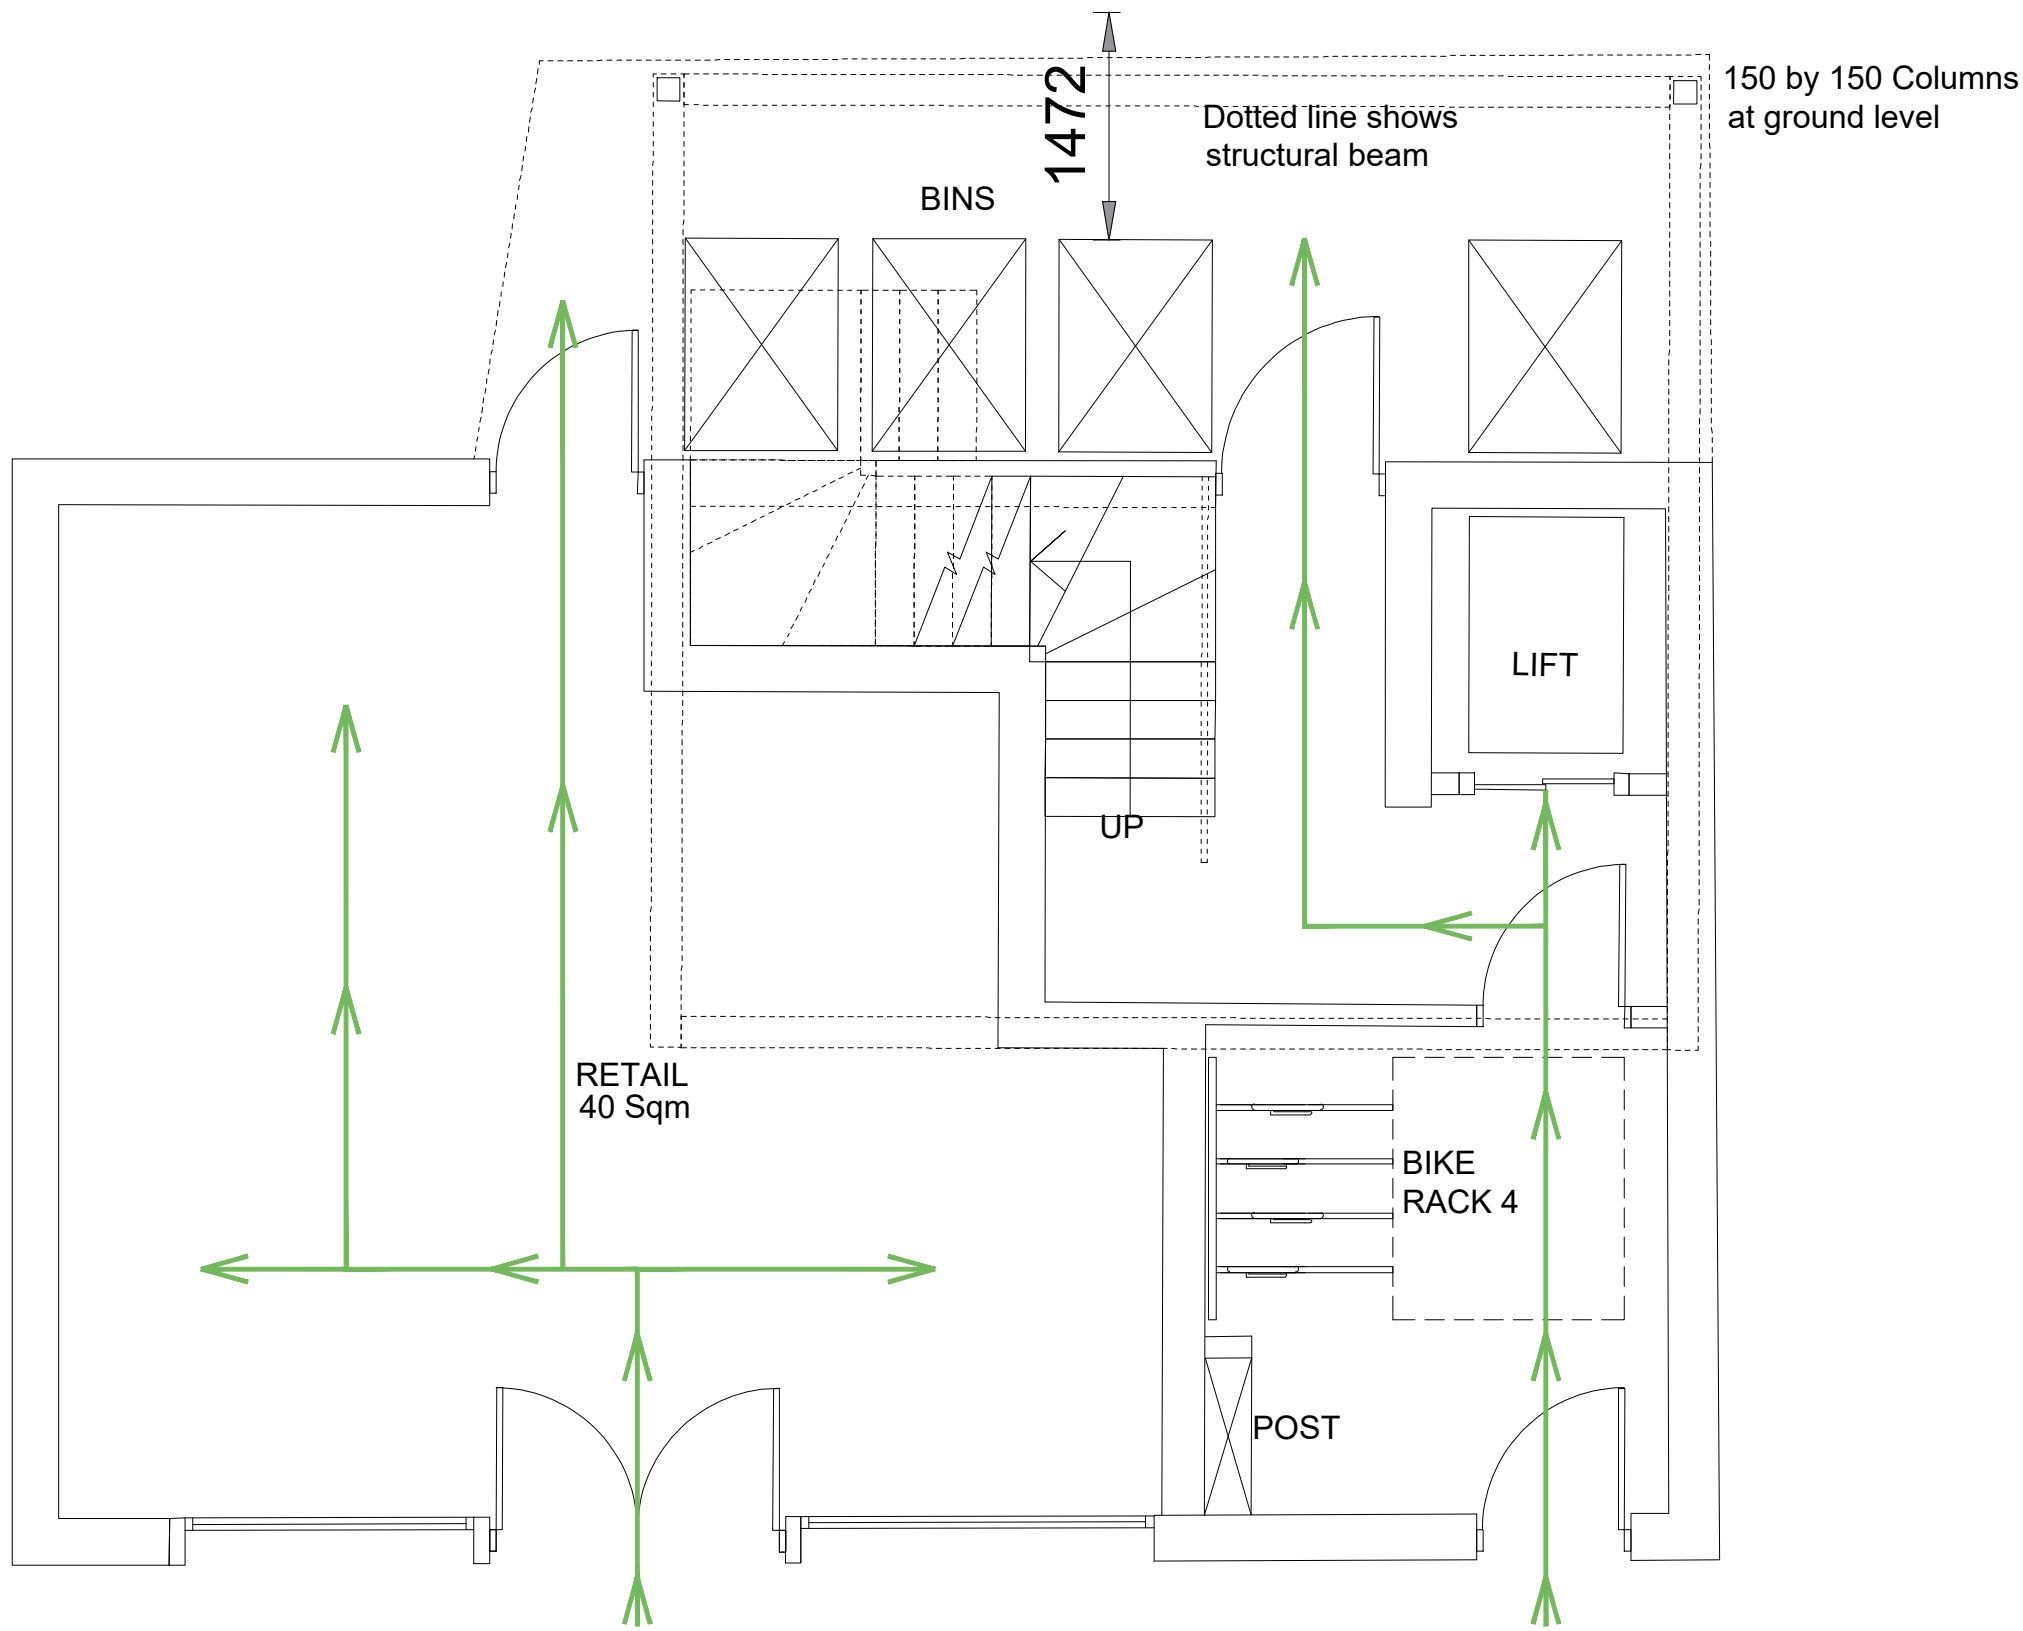

Proposed Ground Floor Plan

Scale 1:50 @ A1

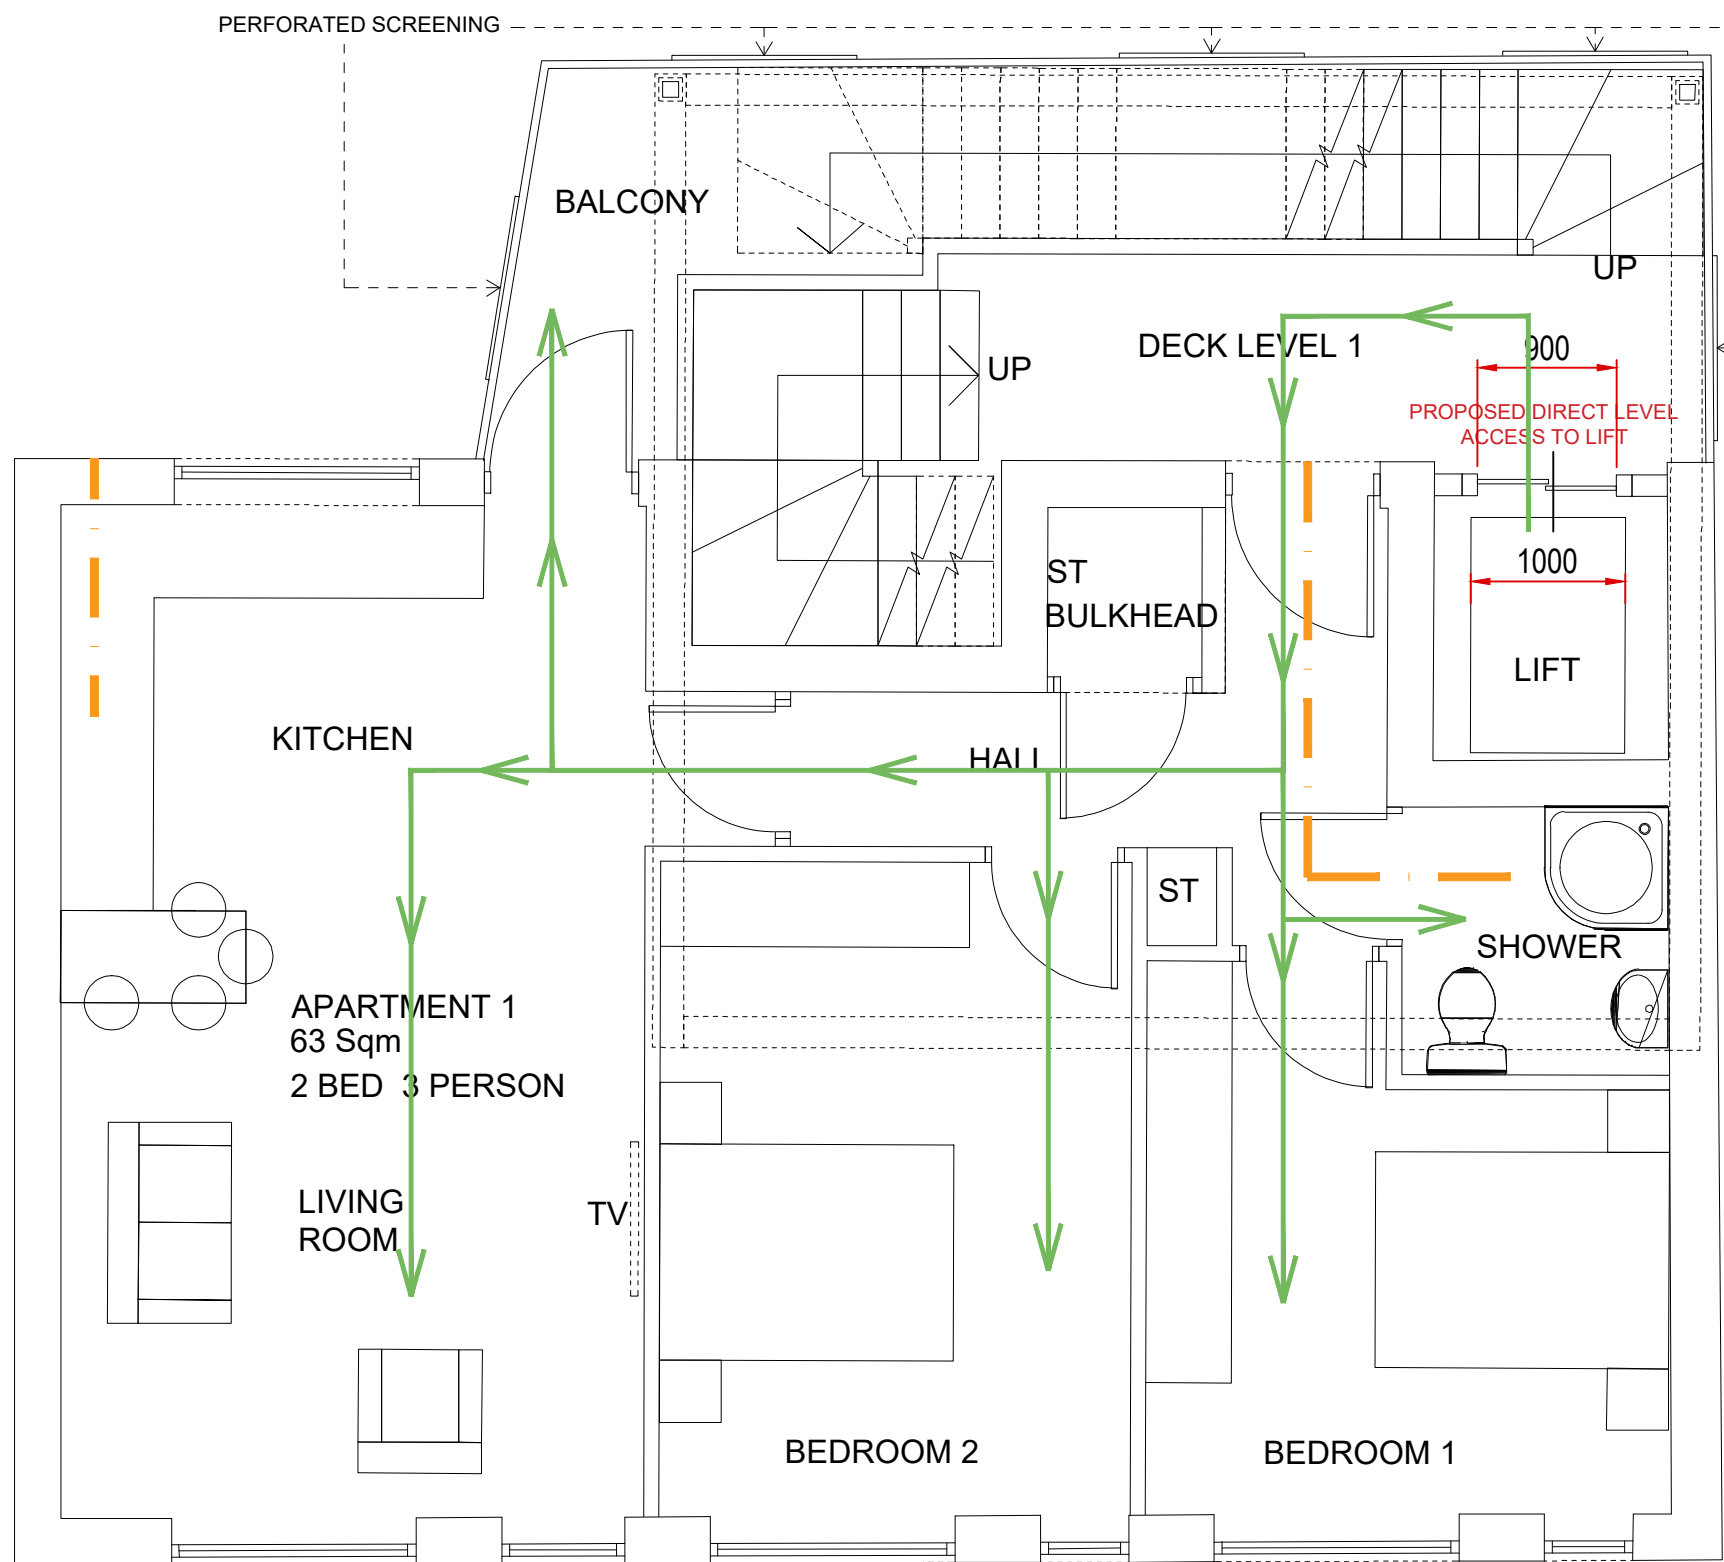


Proposed First Floor Plan

Scale 1:50 @ A1




Proposed Front Elevation

Scale 1:100 @ A1

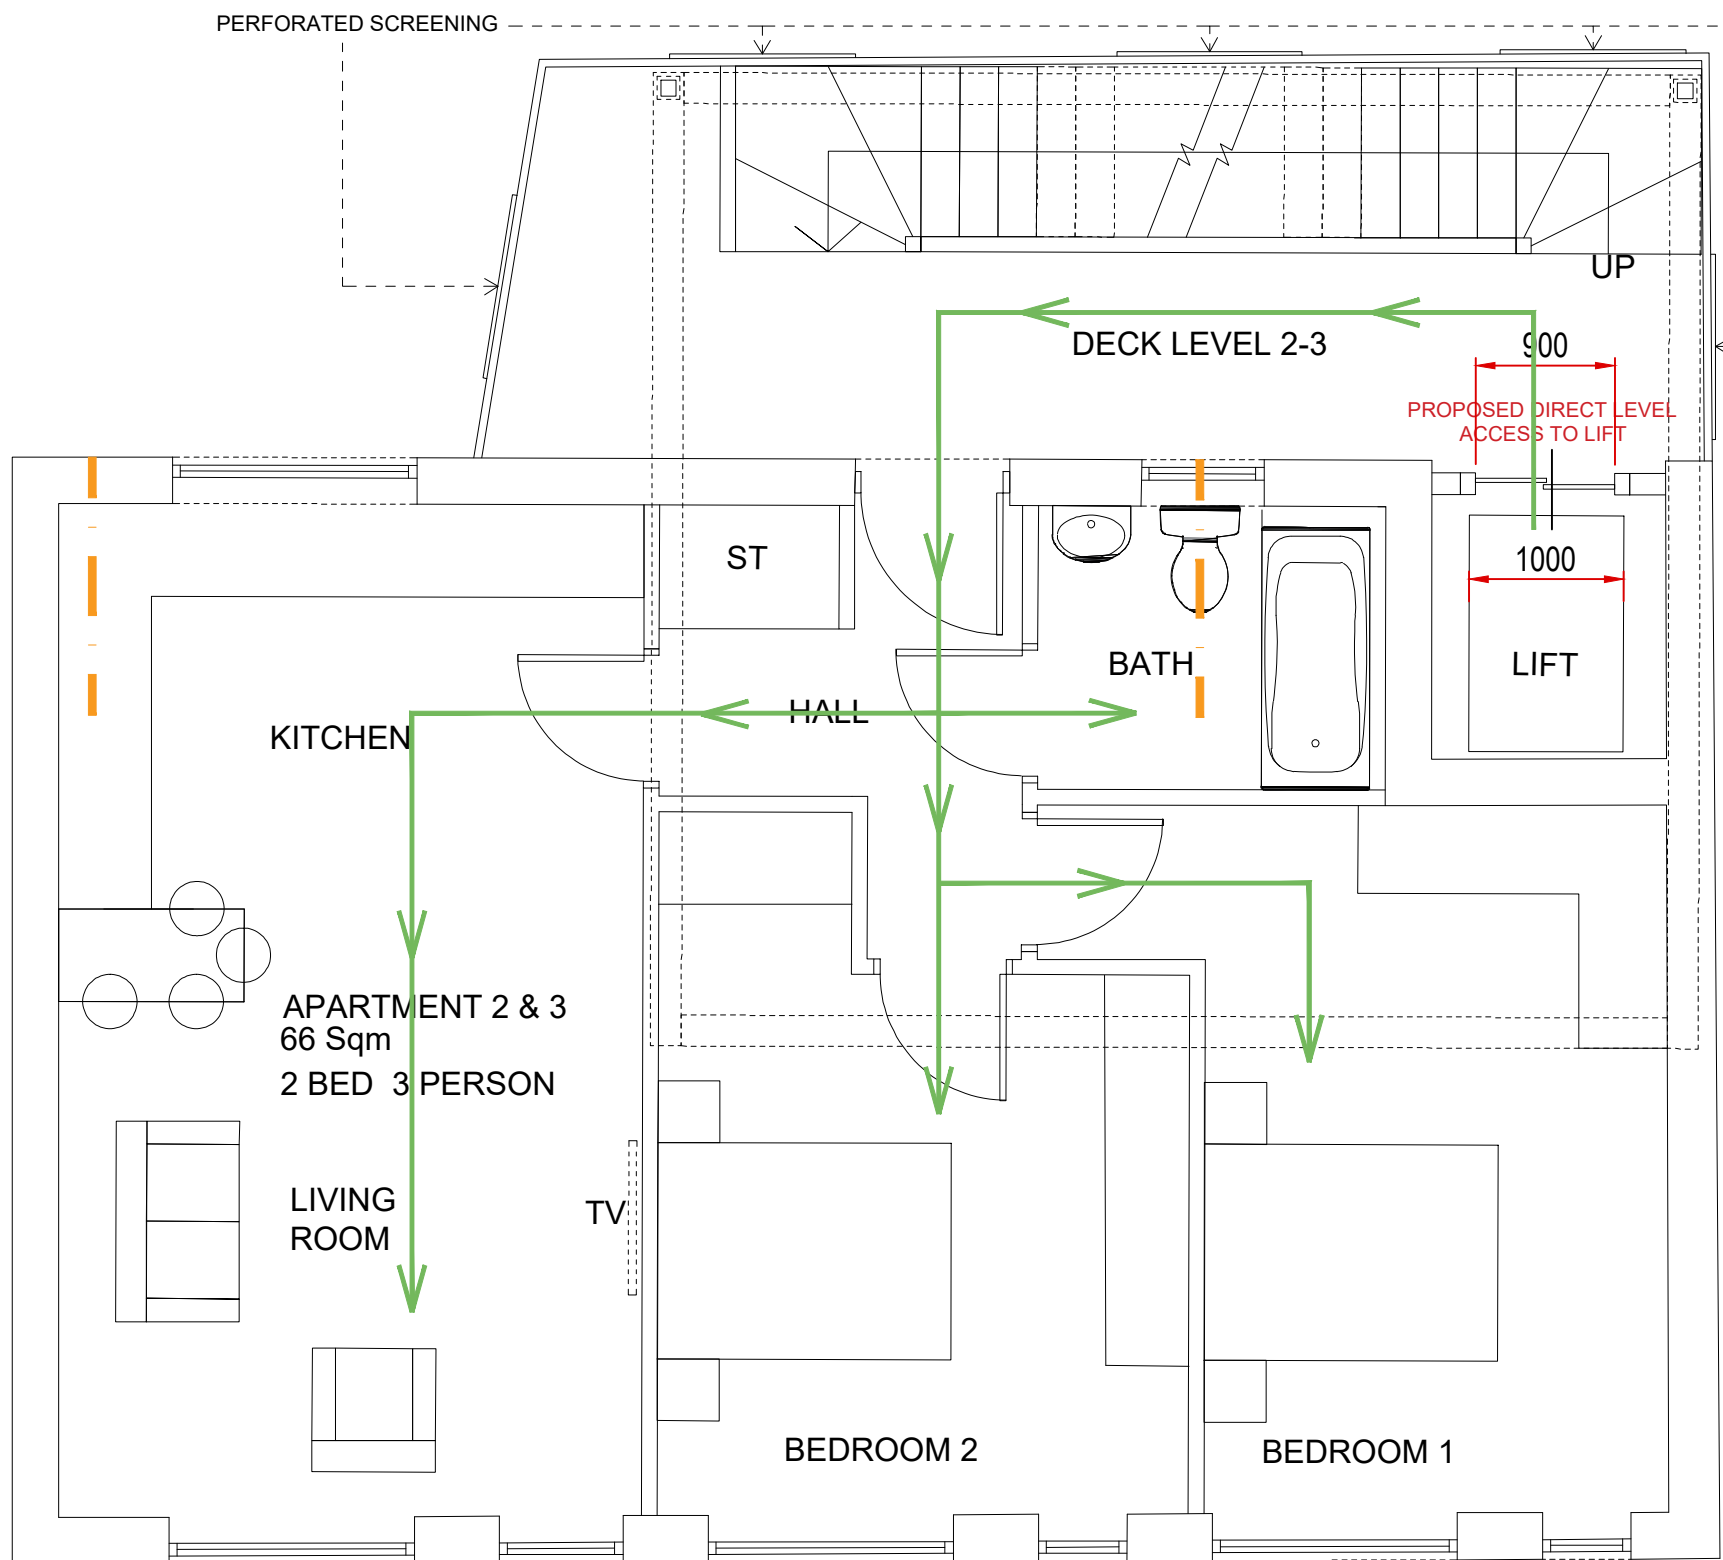

Proposed Second & Third Floor Plan

Scale 1:50 @ A1

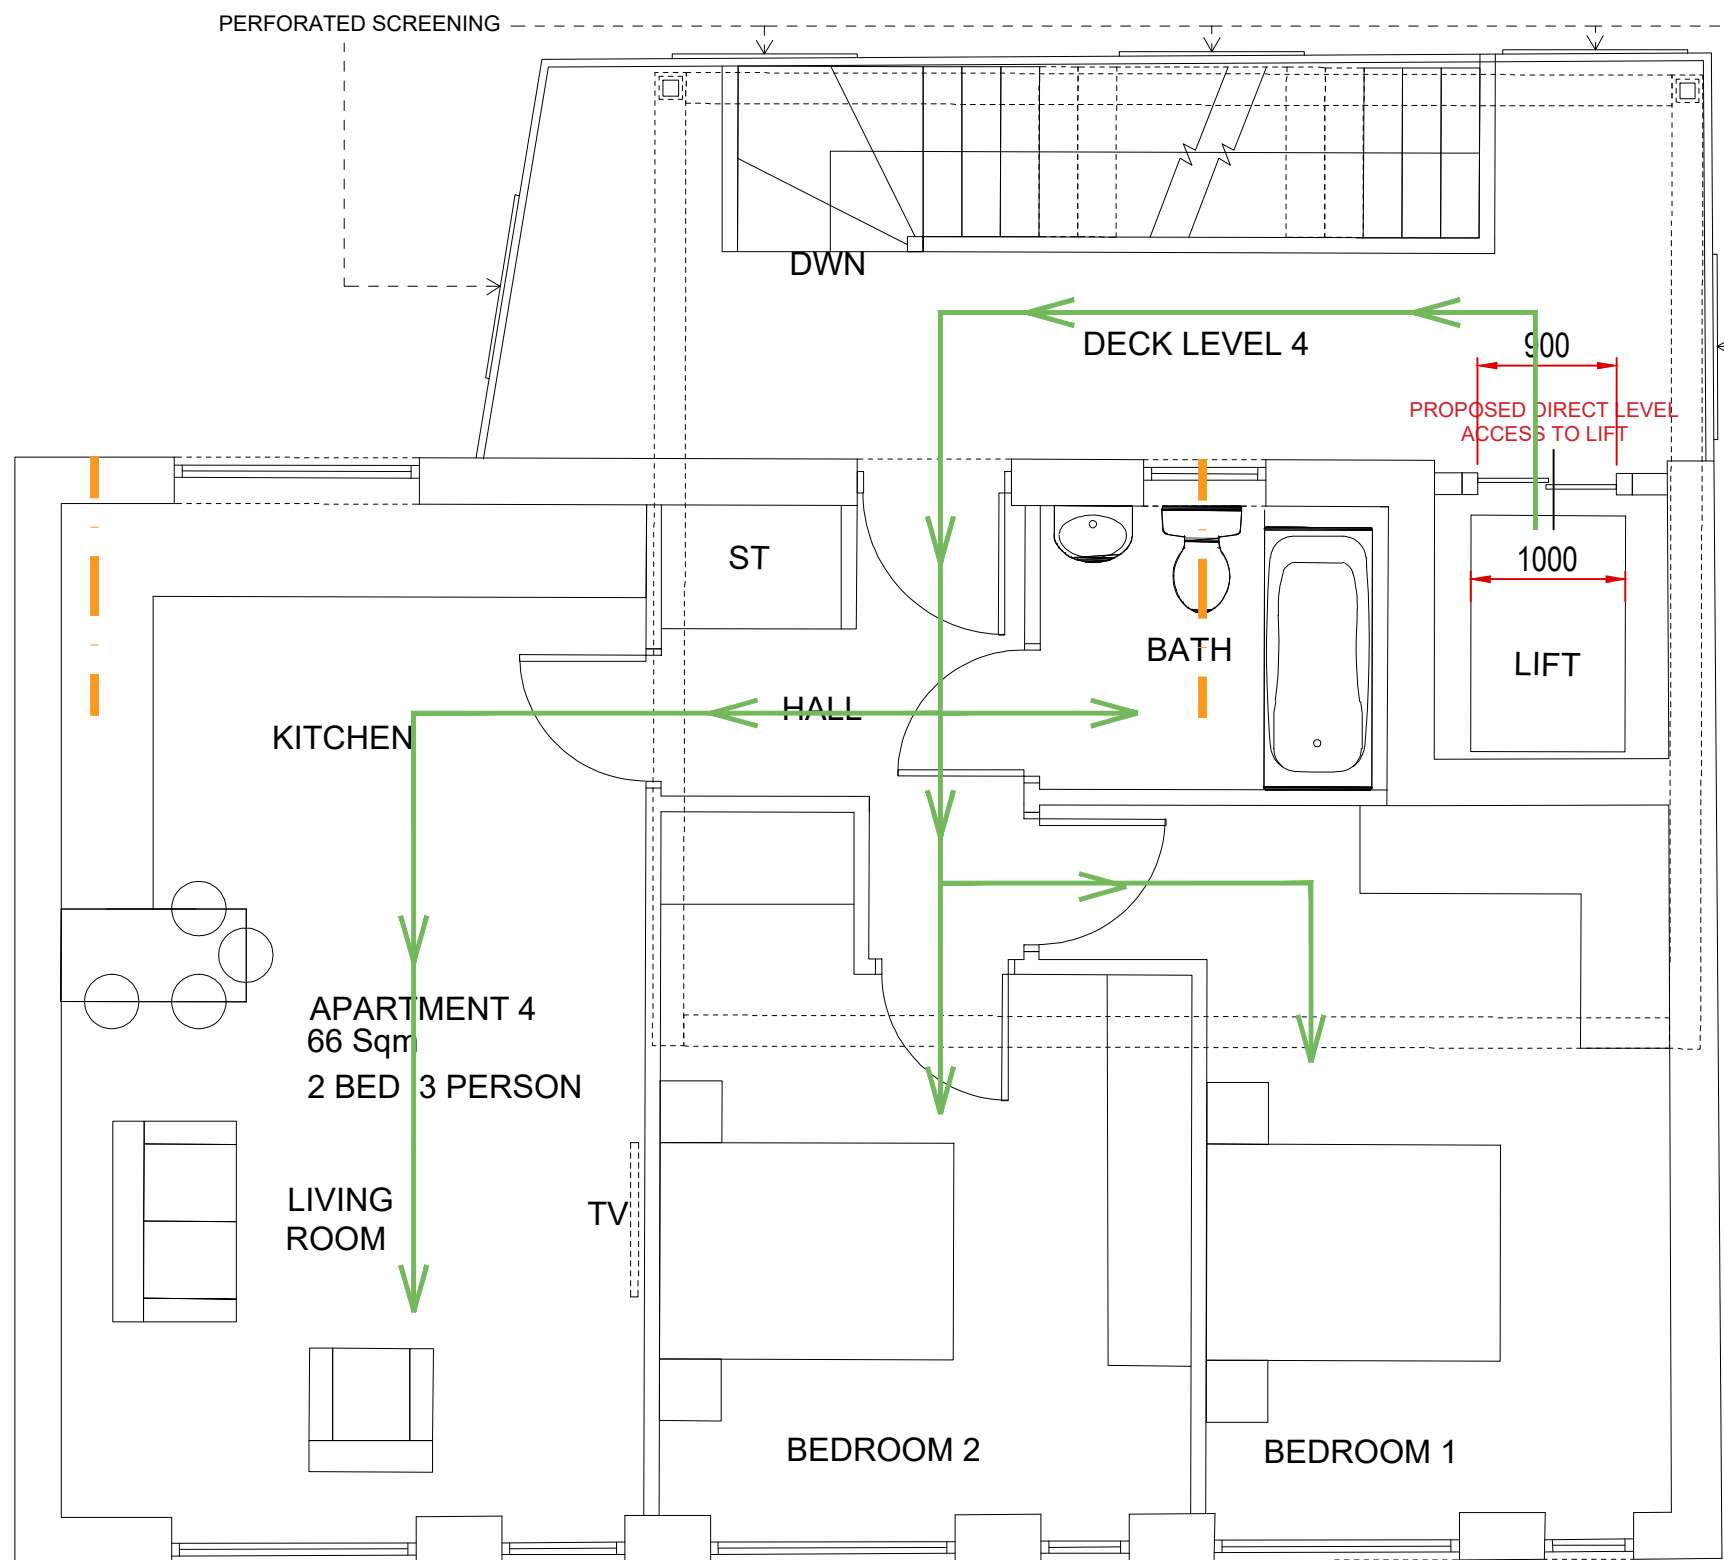


Proposed Fourth Floor Plan

Scale 1:50 @ A1



Proposed Rear Elevation

Scale 1:100 @ A1

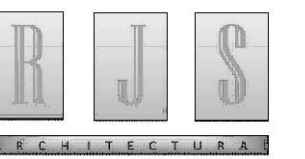

DESIGN

|                |                              |                |
|----------------|------------------------------|----------------|
| Date:          | Revision:                    | Dr:            |
| Client:        |                              |                |
| Drawing Issue: | PLANNING                     |                |
| Project:       | 86-88 TIB STREET, MANCHESTER |                |
| Drawing Title: | PROPOSED LEVEL ACCESS PLANS  |                |
| Scale:         | Drawing No:                  |                |
| Revision:      | Drawn:                       | Authorised by: |
|                | RJS                          | RJS            |
|                |                              | Date:          |
|                |                              | 11/08/2023     |