


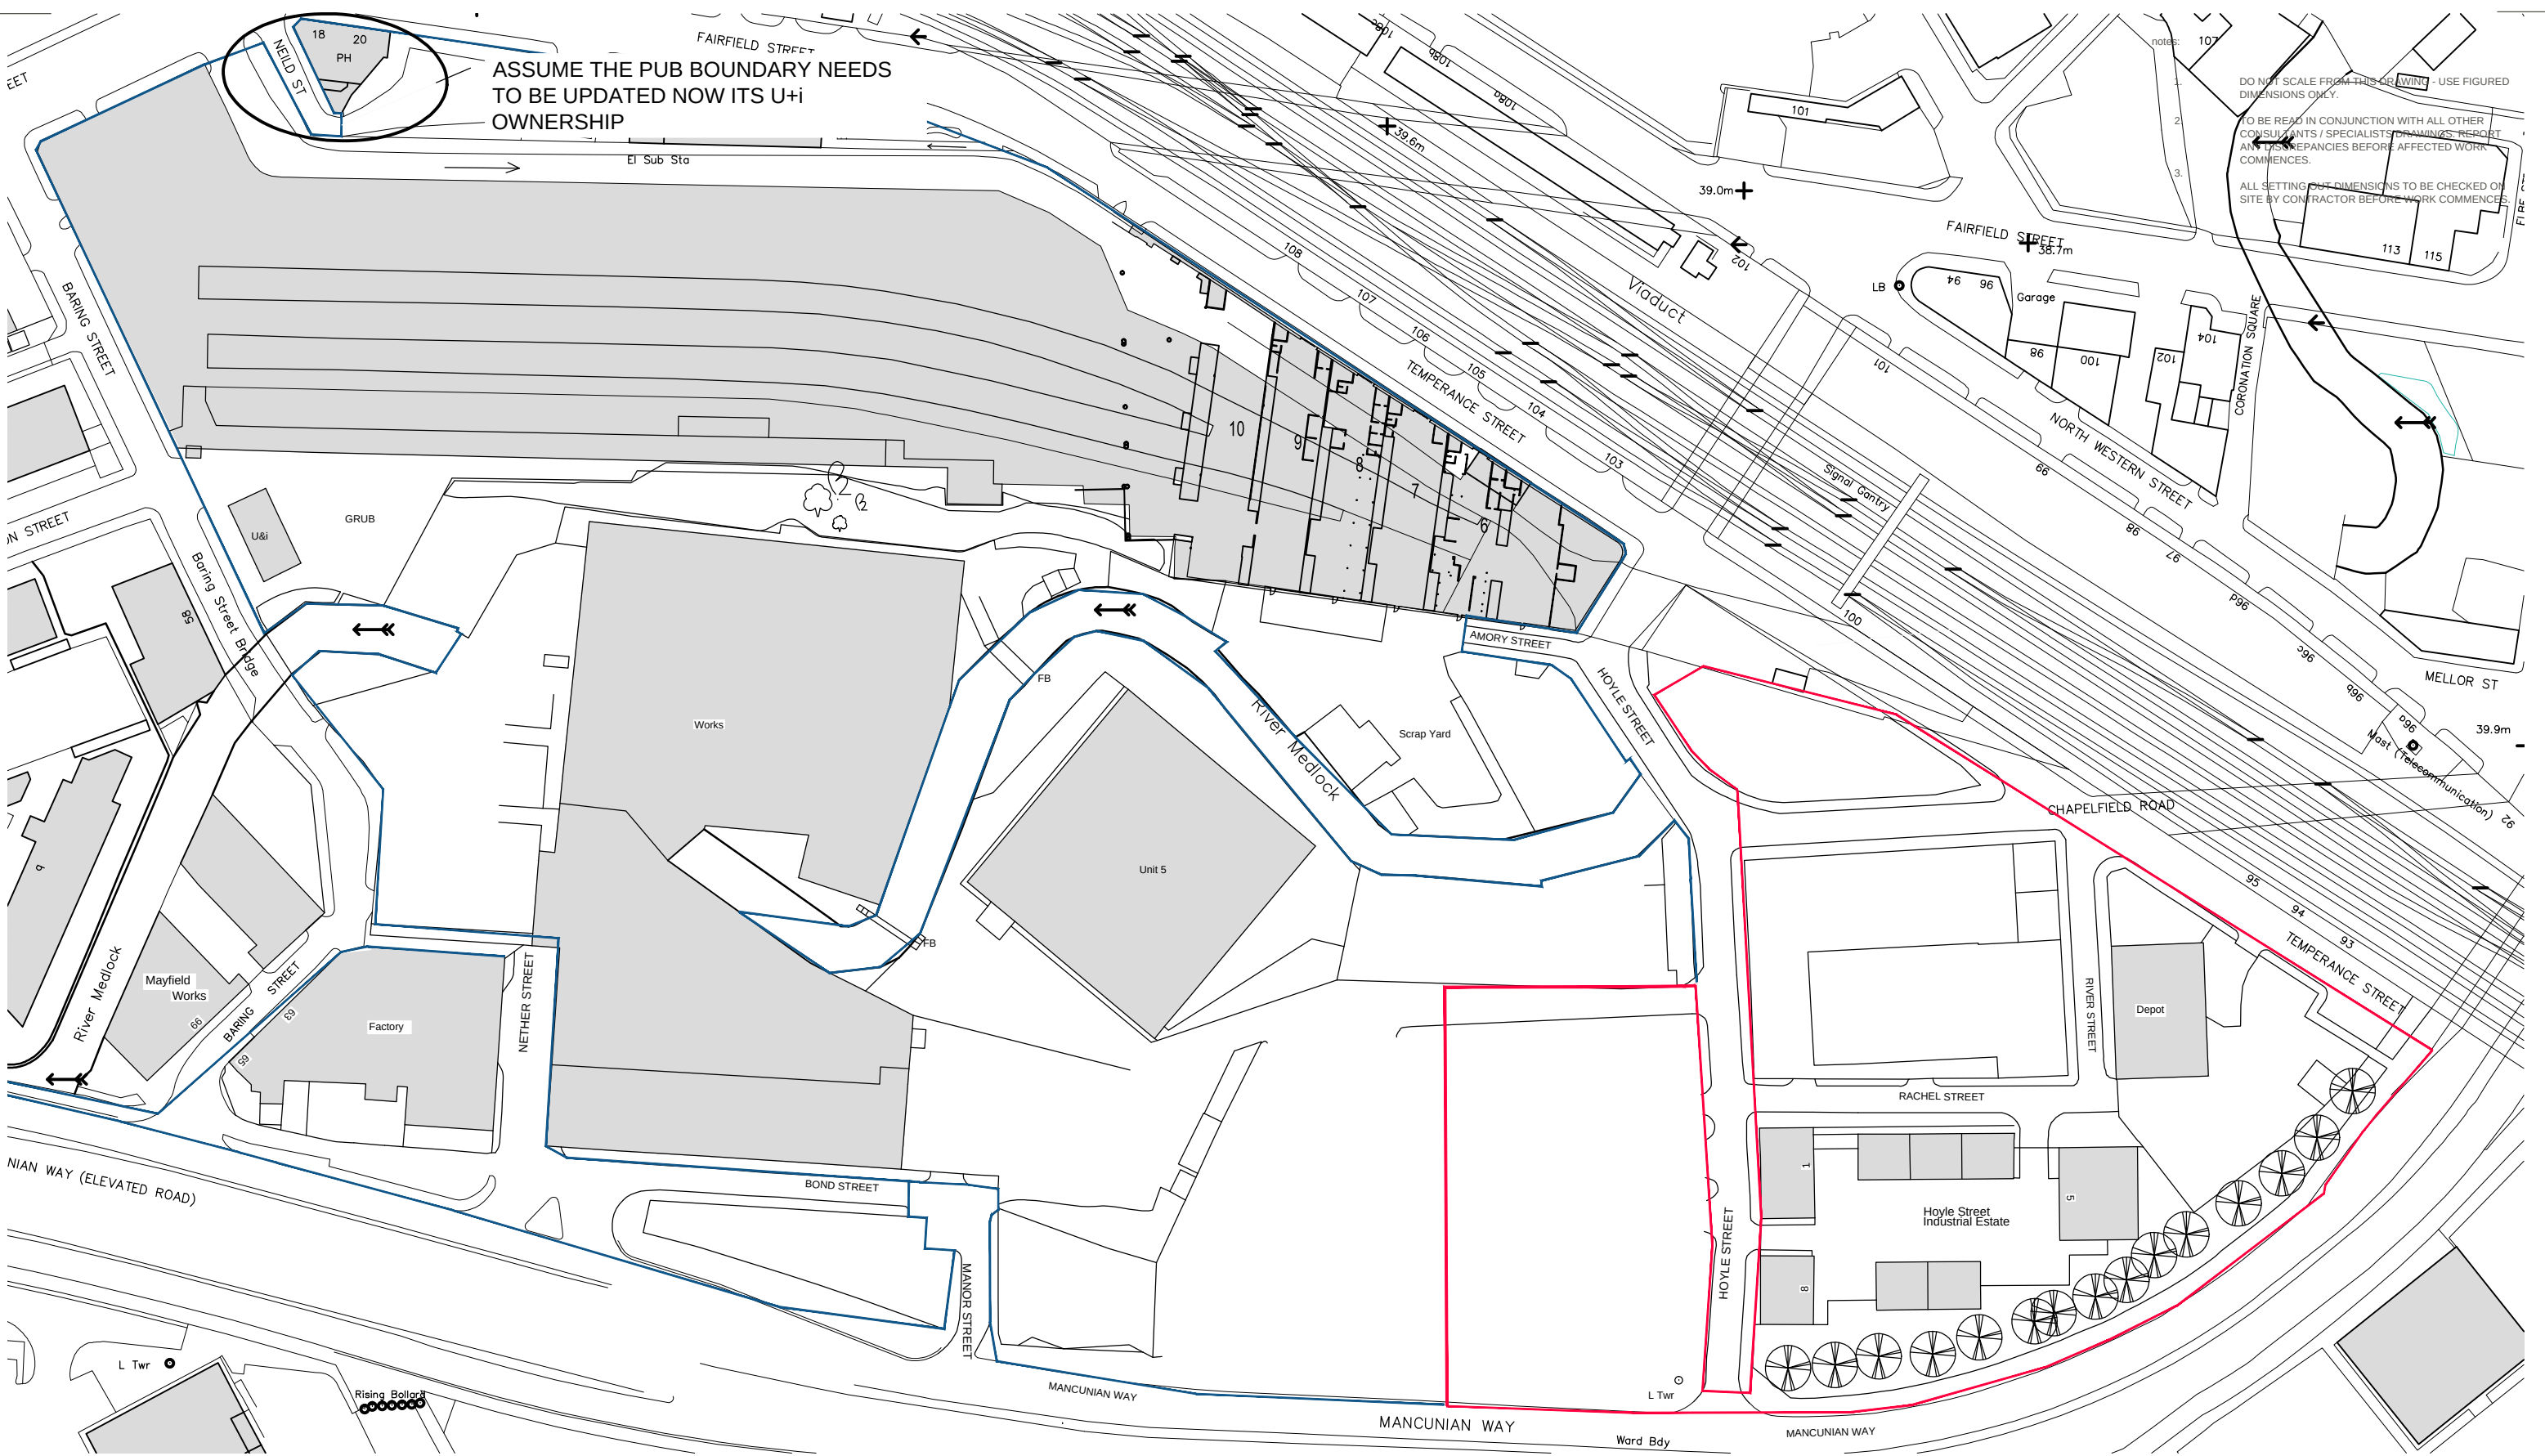

DO NOT SCALE FROM THIS DRAWING - USE FIGURED DIMENSIONS ONLY.

TO BE READ IN CONJUNCTION WITH ALL OTHER CONSULTANTS / SPECIALISTS DRAWINGS. REPORT ANY DISCREPANCIES BEFORE AFFECTED WORK COMMENCES.

ALL SETTING OUT DIMENSIONS TO BE CHECKED ON SITE BY CONTRACTOR BEFORE WORK COMMENCES.

CLIENT	U+i
PROJECT	MAYFIELD SITE COMPOUND
TITLE	EXISTING RED LINE PLAN
NUMBER	20352 SK21
REVISION	A
STATUS	PLANNING
SCALE	1:1250 @A3
DATE	16.01.20
DRAWN BY	SK
CHECKED BY	SG

seven.
SEVENARCHITECTURE.CO.UK

Studios at :

61 Oxford Street,
MANCHESTER, M1 6EQ
t : 0161 236 5655

Clarendon House, Victoria Avenue,
HARROGATE, HG1 1DY
t : 01423 709 807

Galeri 6, Doc Fictoria,
CAERNARFON, LL55 1SQ
t: 01286 685 253

24 Greville Street, **LONDON**,
EC1N 8SS
t : 0203 036 0691

REVISIONS

DATE; DRAWN; CHECK