



FIREFIGHTER LAYOUT MAP
STAIR 01

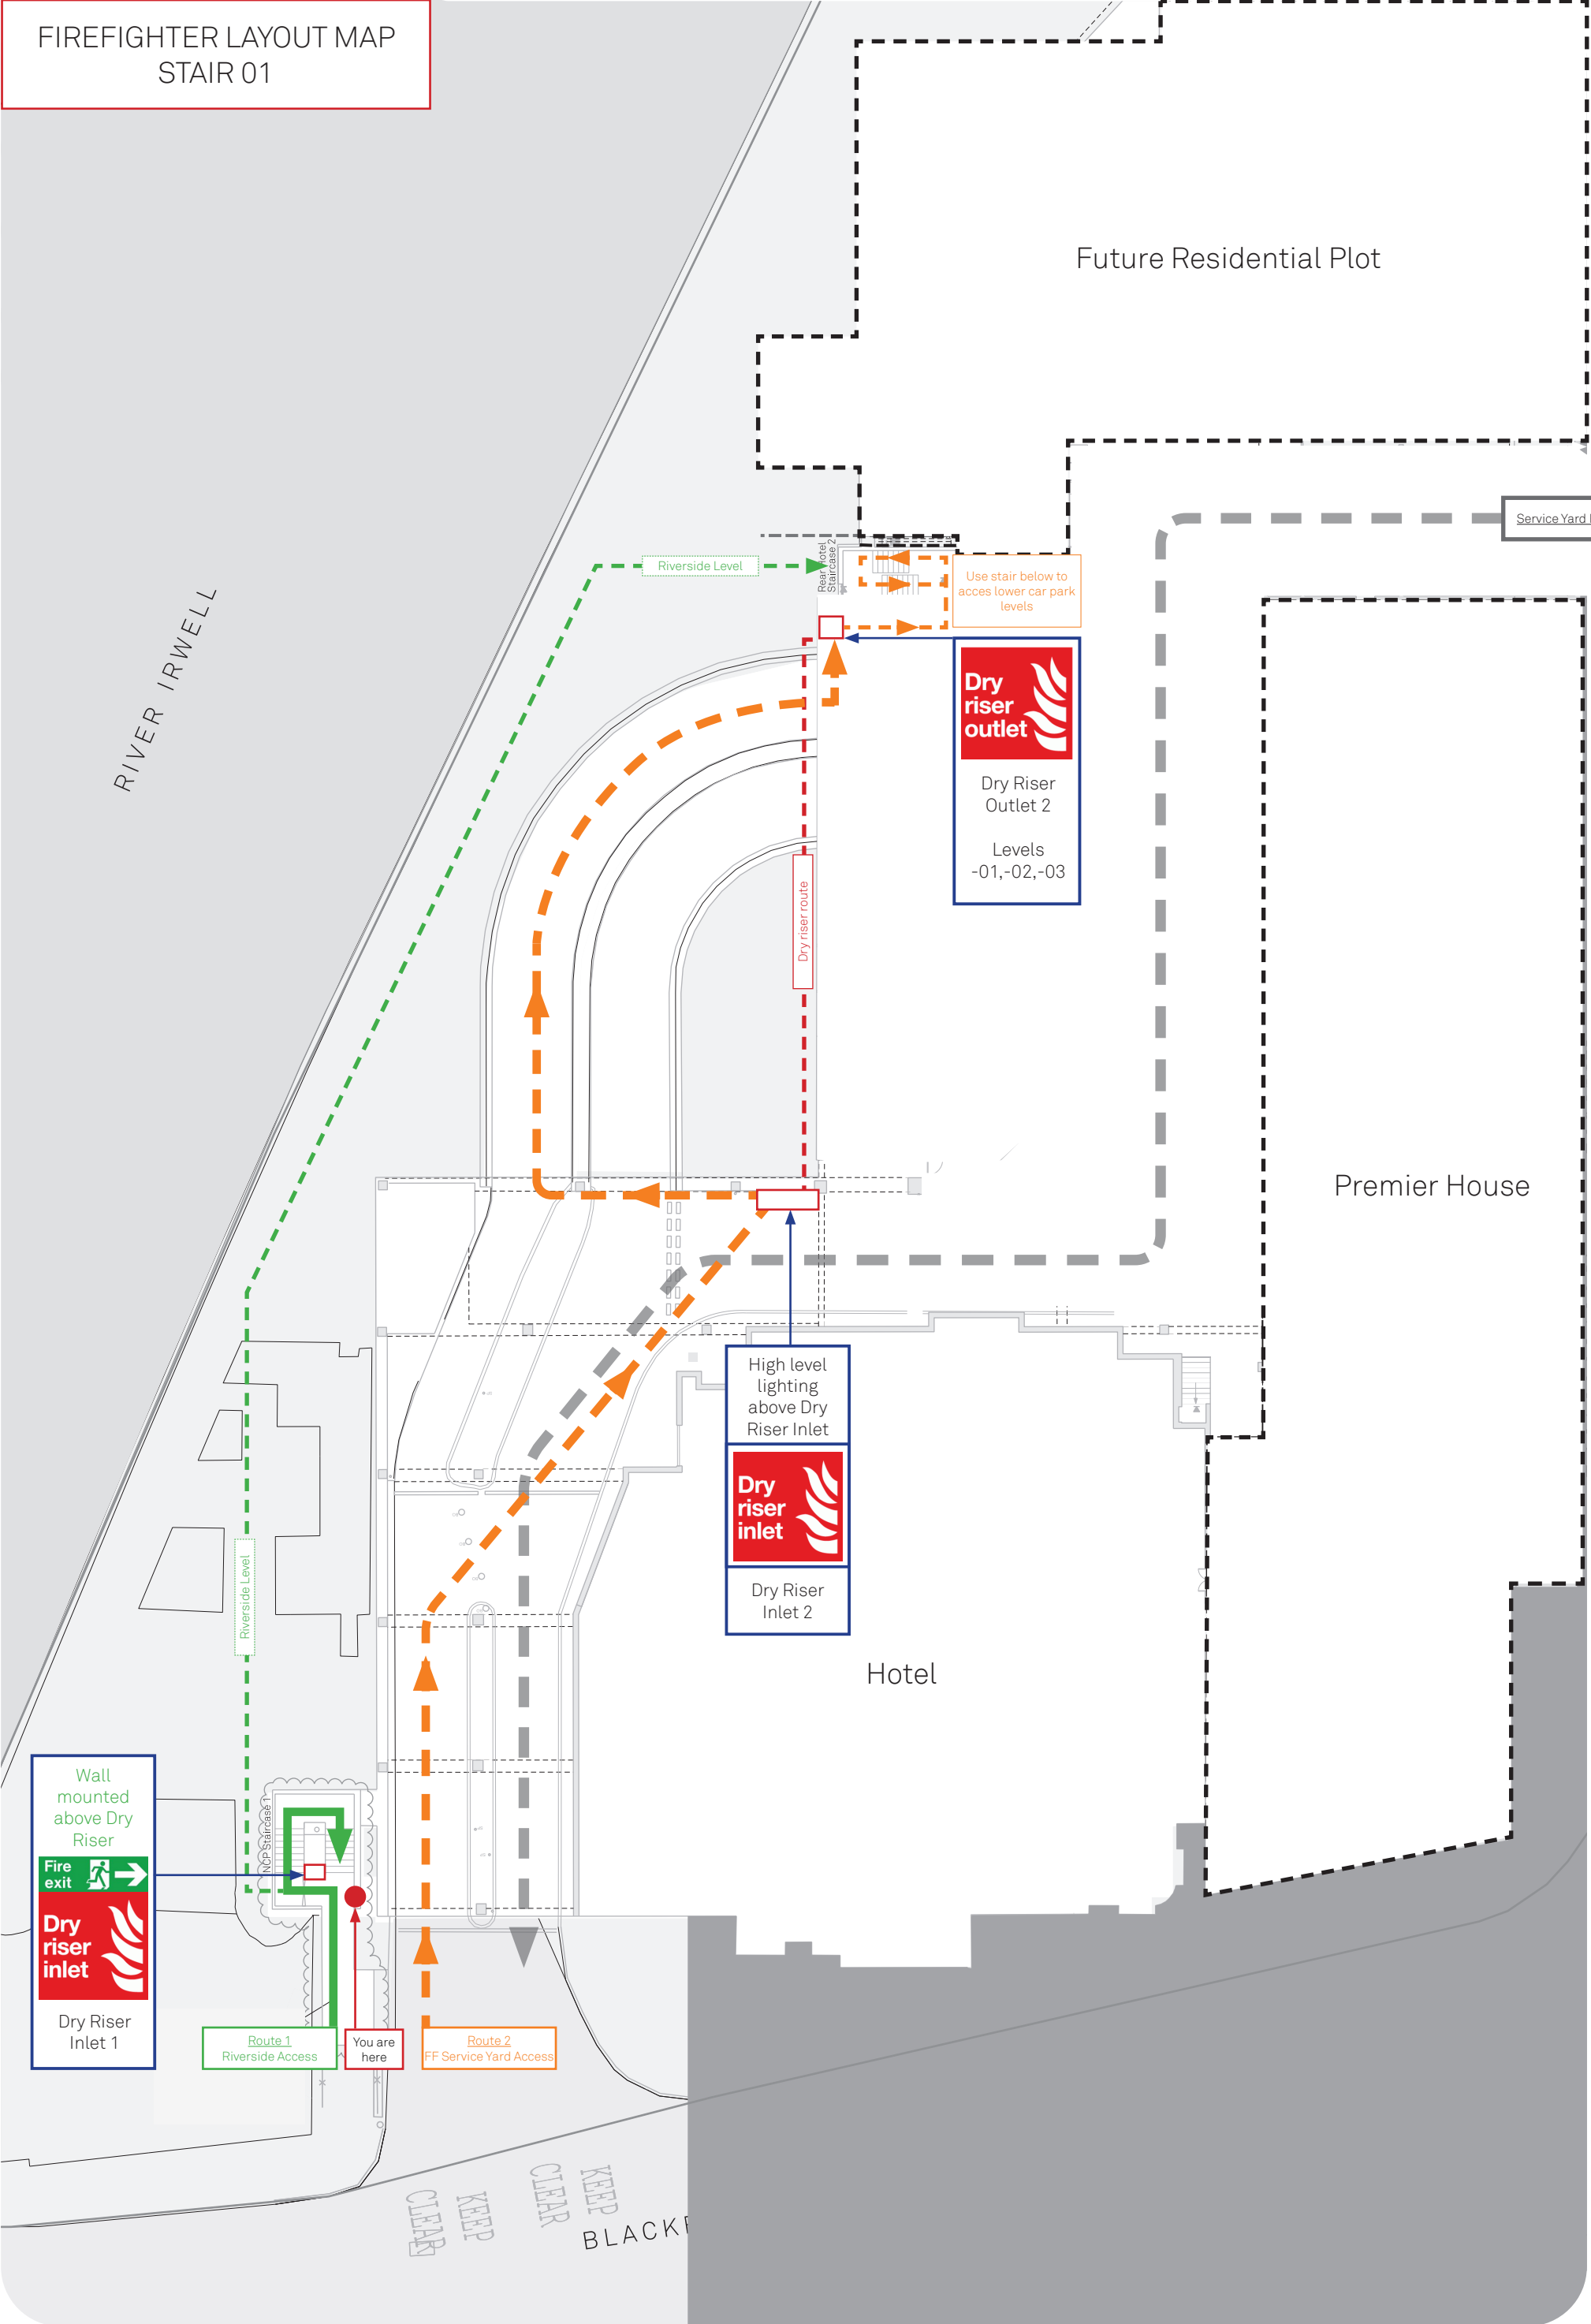

RIVER IRWELL

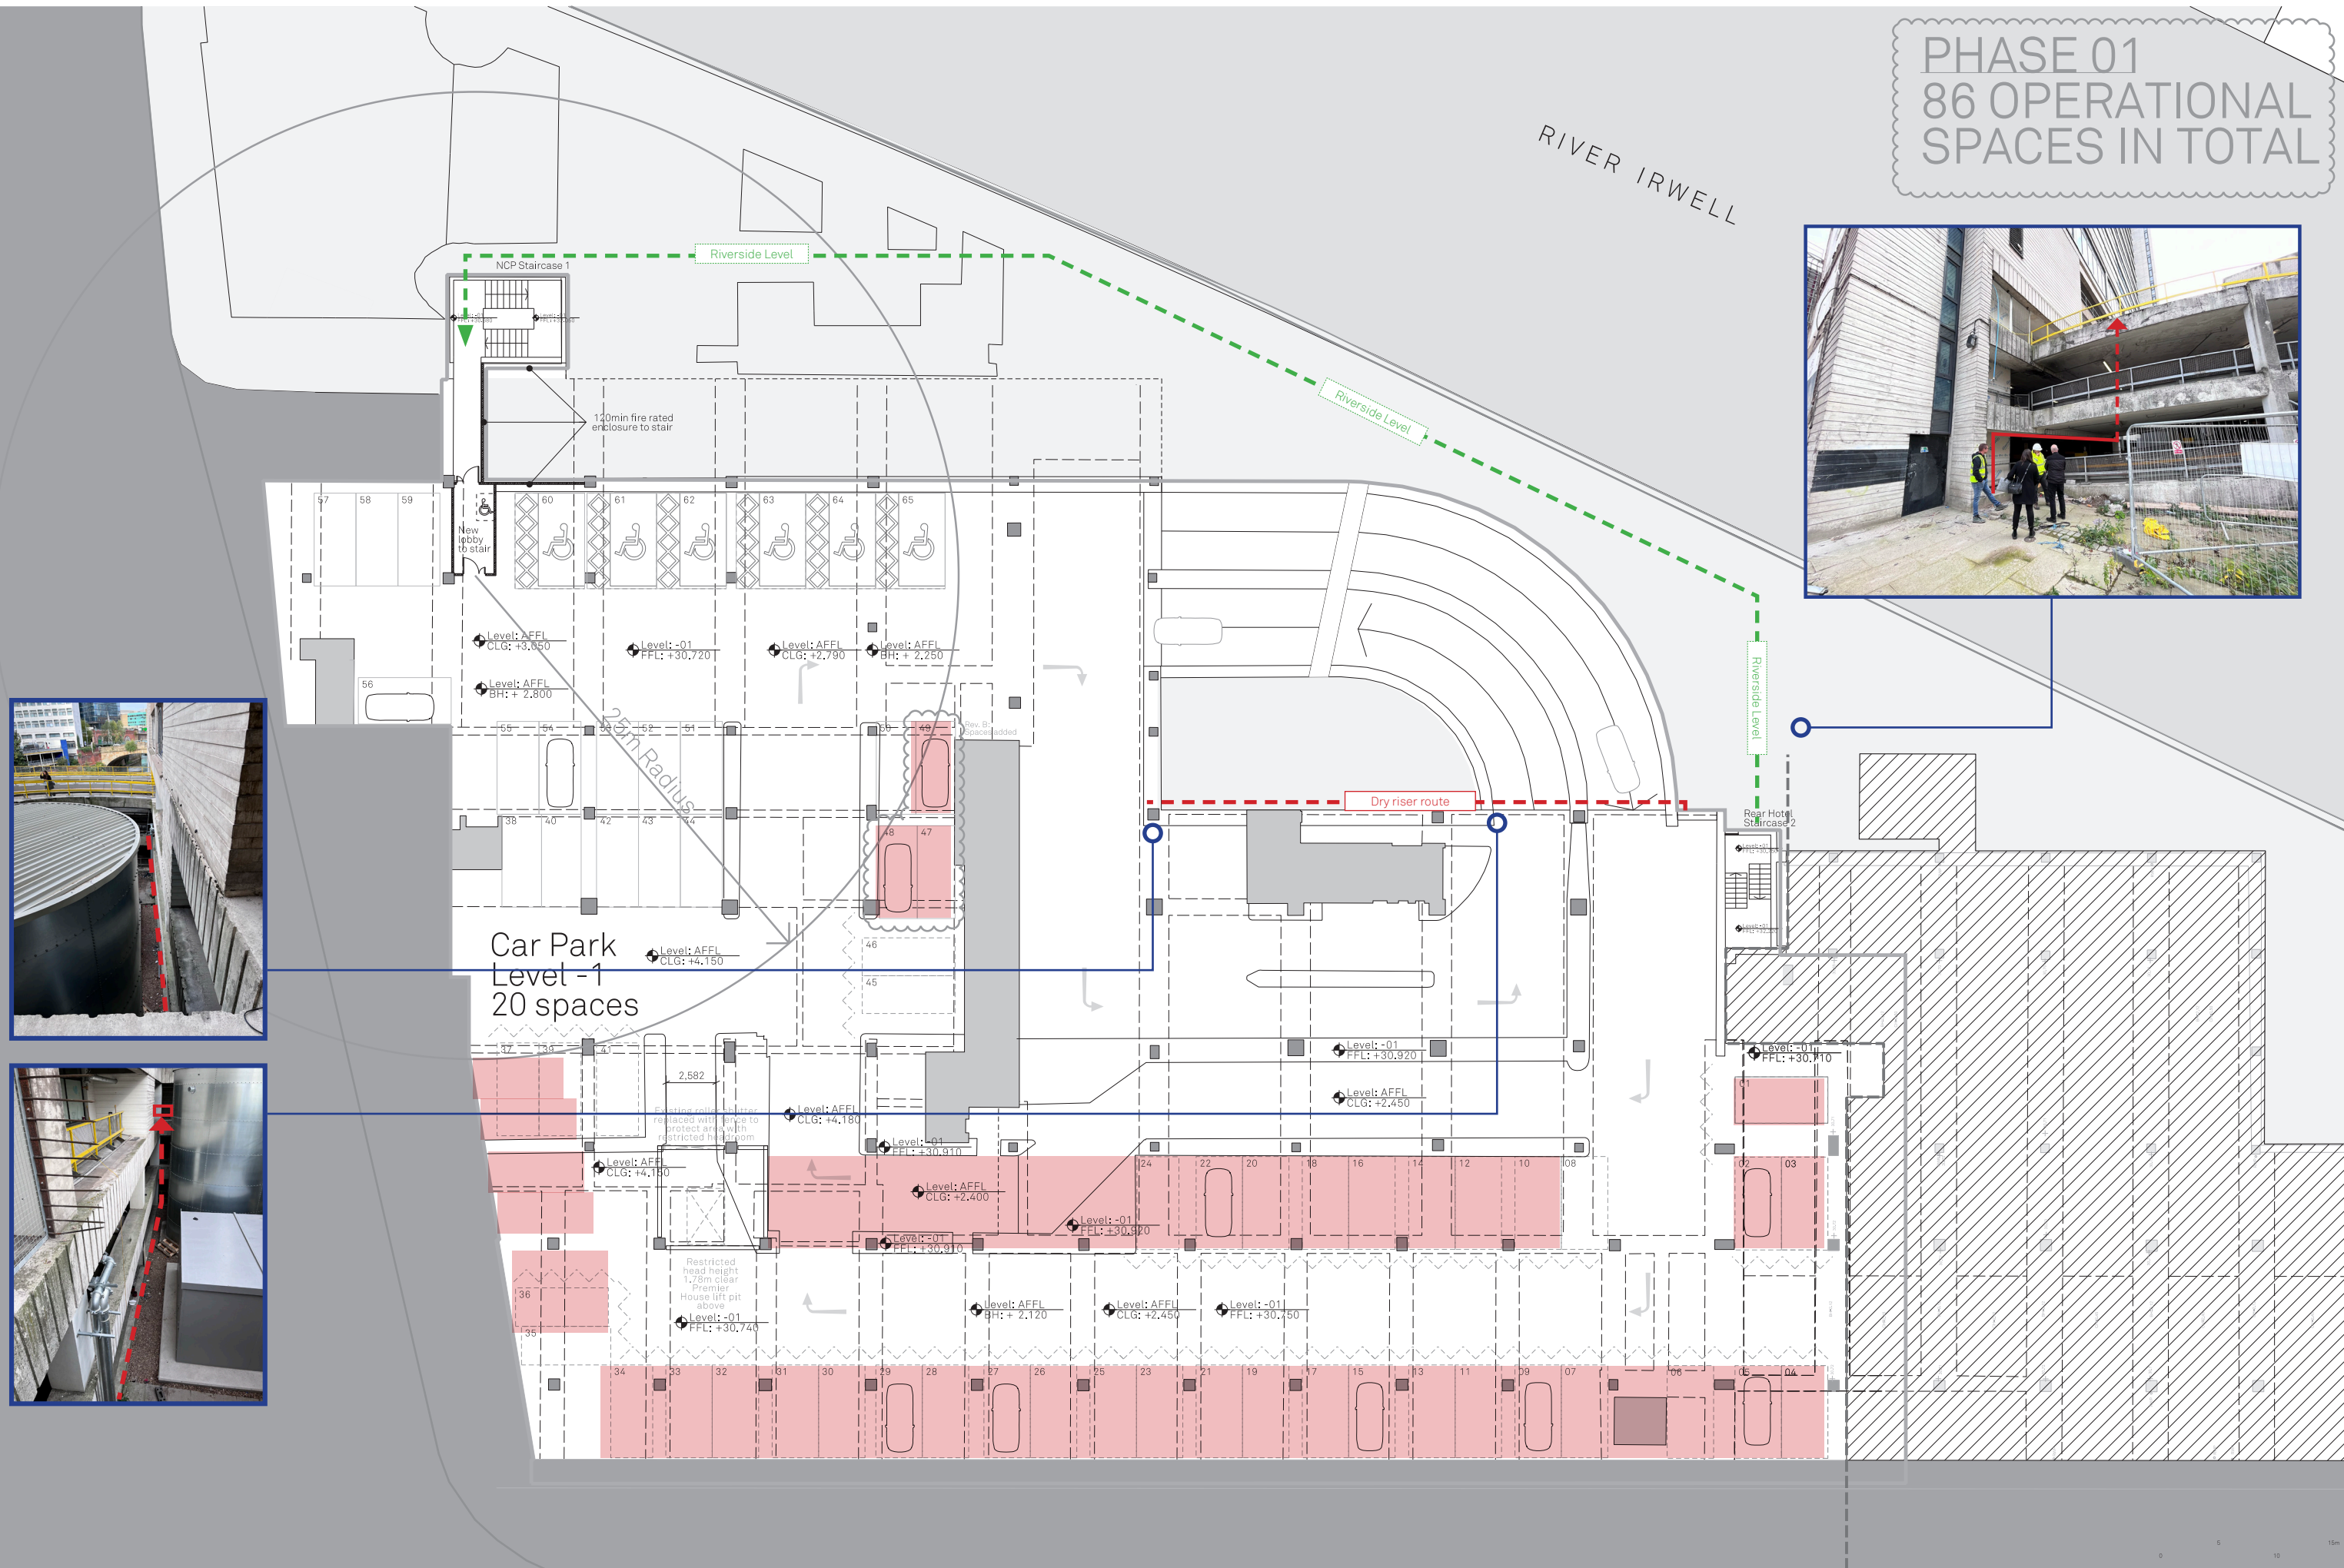

 Decommissioned Car Parking
 Indicative Escape Distance
 Car Park Application Boundary
 Indicative Car Parking Space Barrier

 Retained Car Parking
  Demolition Line
  For Demolition

Note:
For Statutory Signage, refer to Fire Strategy Report
To be read in conjunction with 1716.3 SK001.0 Phase 01 Fire Strategy mark Up. 210917

Project Name:
Renaissance

Drawn: CS Checked: JC

Details:
20.09.20

Title:
Block 03
Lower Ground Floor Level -
Status: Project:
Stage 4 150
Issued for Information


Scale:
1:150@ A1
01 (Phase 01)
Drawing No: Rev:
B3_02_2098 B

Jon Matthews Architects

Union, 2-10 Albert Square, Manchester, M2 6LW 0161 974 3690

Copyright of this drawing is vested in Jon Matthews Architects and must not be copied or reproduced without written consent. Figured dimensions only are to be taken from this drawing. Do not scale from this drawing. For full company disclosure please visit www.jonmatthewsarchitects.com

PHASE 01
86 OPERATIONAL
SPACES IN TOTAL

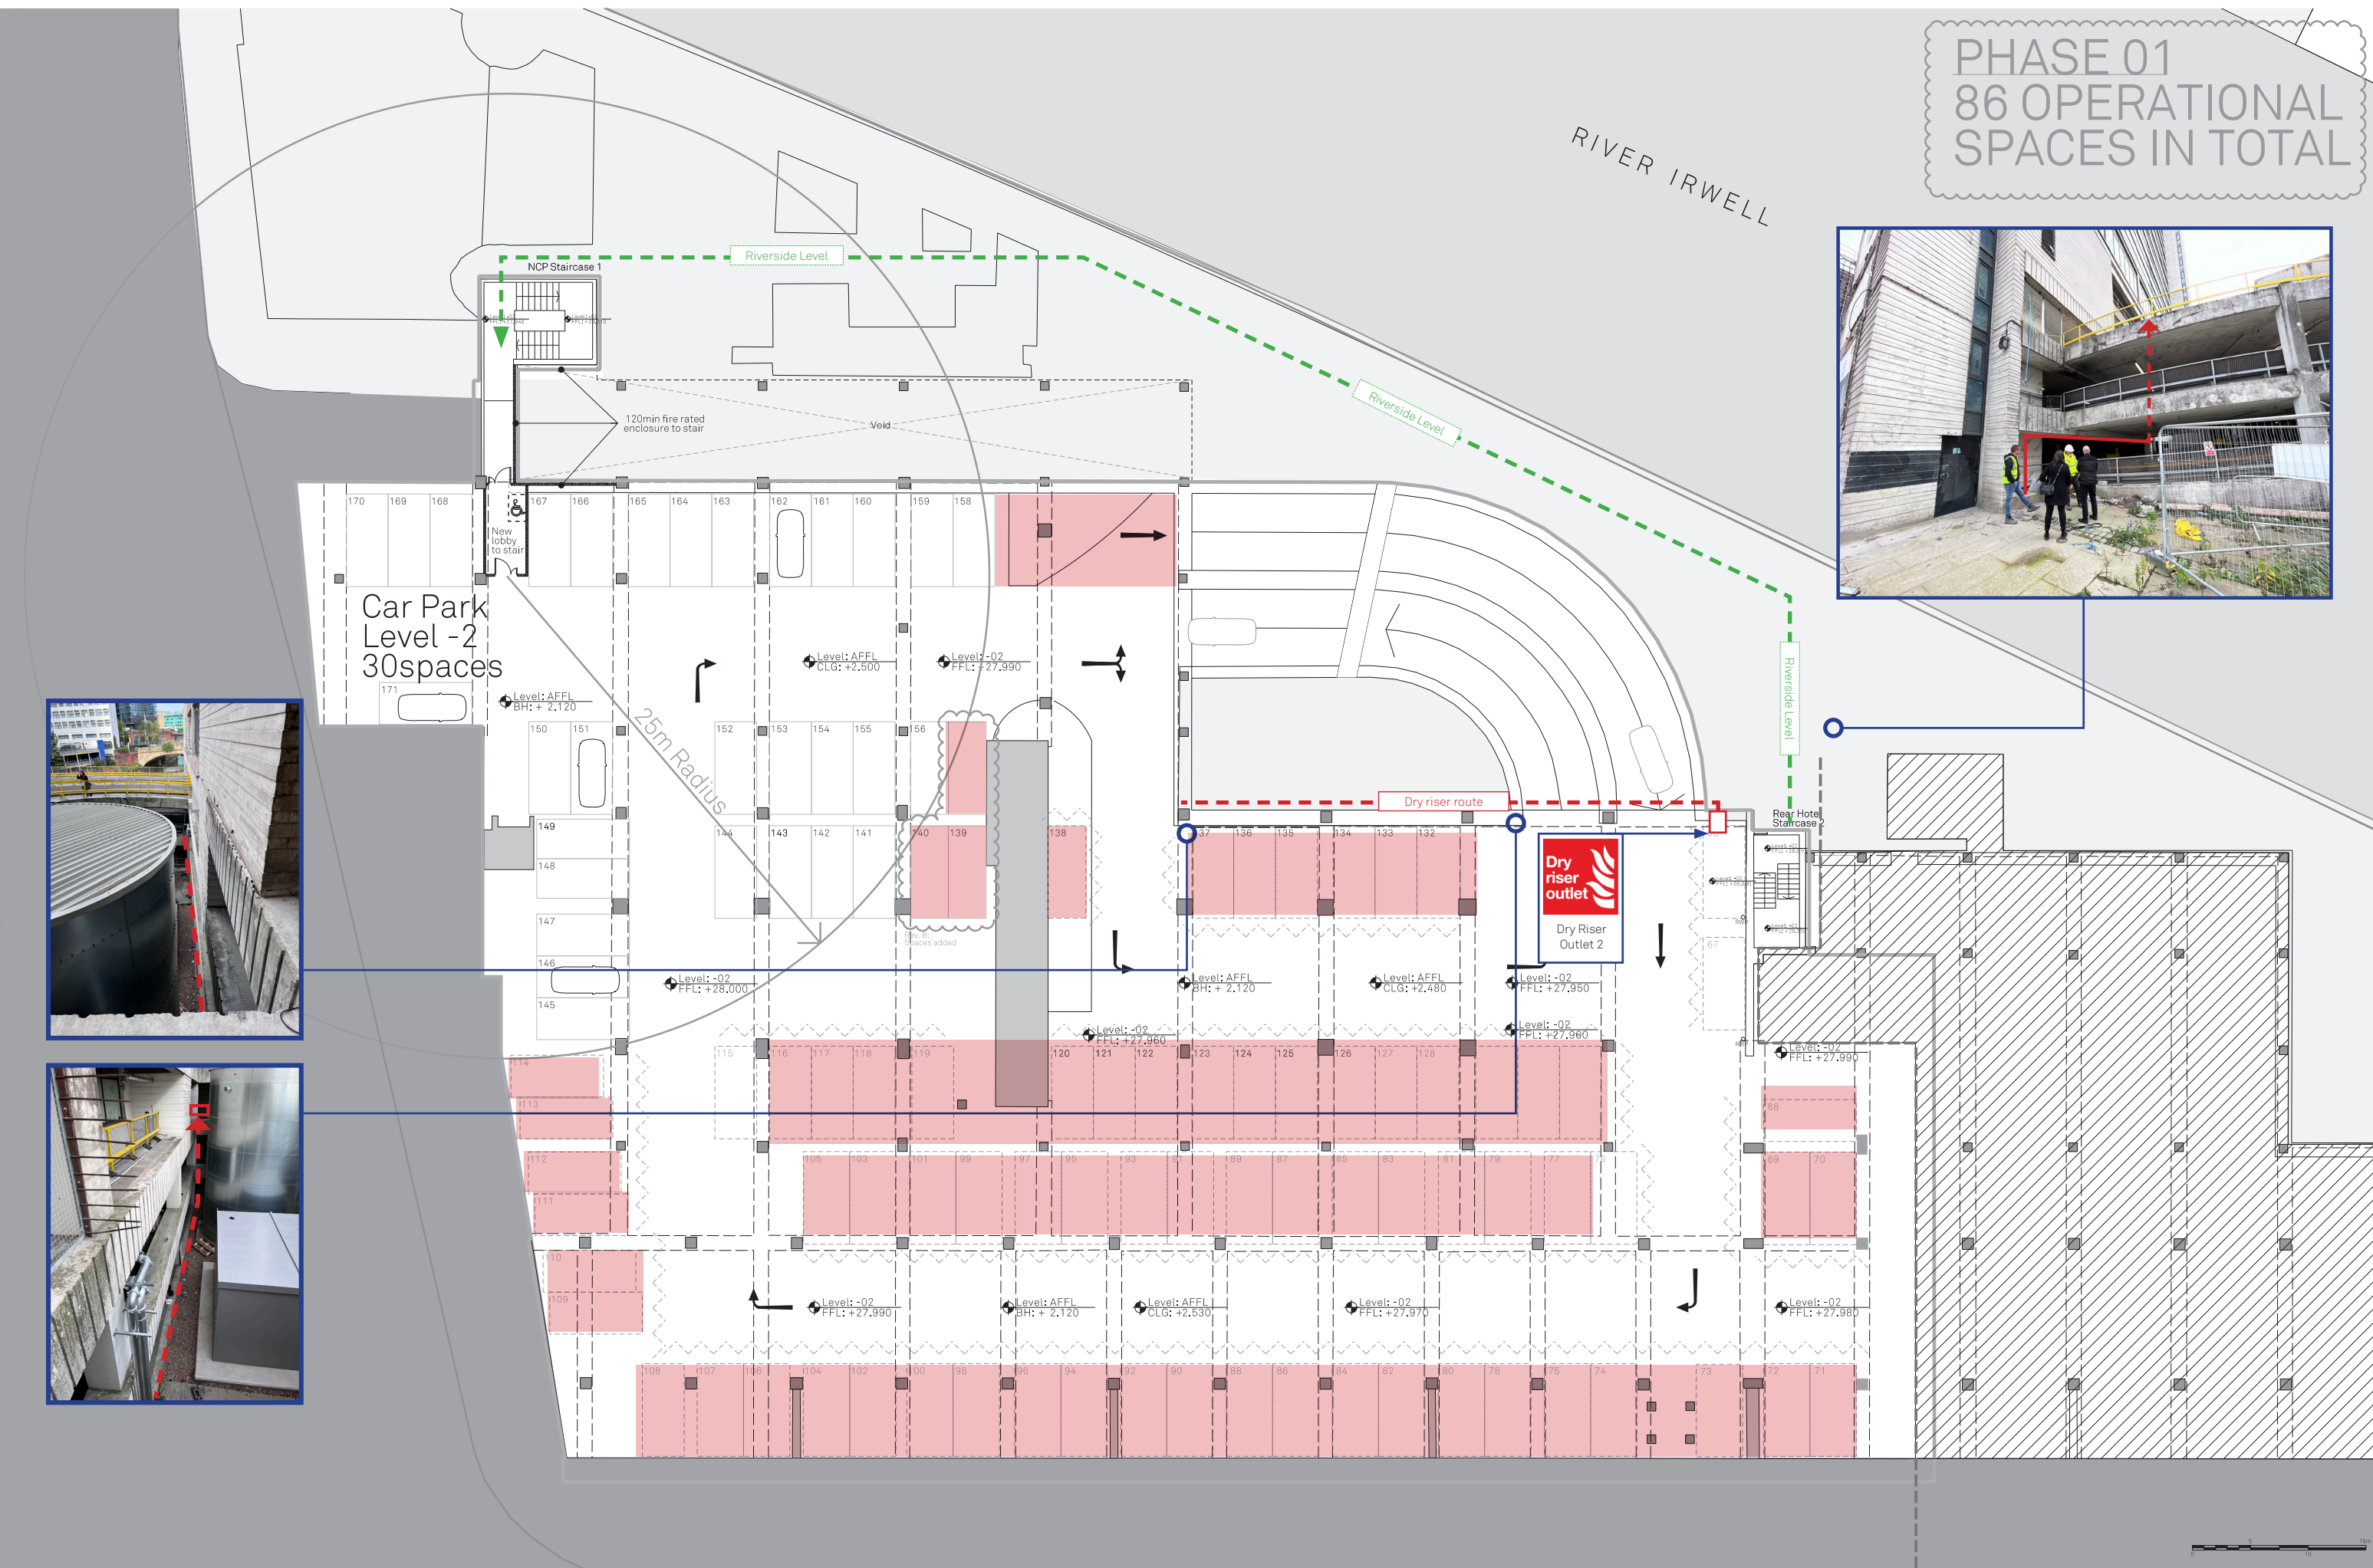

Decommissioned Car Parking Indicative Escape Distance Car Park Application Boundary Indicative Car Parking Space Barrier
Retained Car Parking Demolition Line For Demolition

Note:
For Statutory Signage, refer to Fire Strategy Report
To be read in conjunction with 1716.3_SK001.0_Phase 01 Fire Strategy mark Up_210917



Project Name:
Renaissance
Drawn:
CS
Checked:
JC
Date:
20.09.21

Title:
Block 03
Lower Ground Floor Level -02 (Phase 01)
Status:
Stage 4
Issued for Information

Scale:
1:150@ A1
Project:
150
Drawing No:
B3.02_2097
Rev:
B

Jon Matthews Architects
Union, 2-10 Albert Square, Manchester, M2 6LW
0161 974 3690
Copyright of this drawing is vested in Jon Matthews Architects and must not be copied or reproduced without written consent. Figured dimensions only are to be taken from this drawing. Do not scale from this drawing. For full company disclosure please visit www.jonmatthewsarchitects.com

RIVER IRWELL

Car Park
Level -3
27 spaces

25m Radius

Dry riser route

Dry riser outlet

Dry Riser
Outlet 2

Rear Hotel
Staircase

Level: -U3
FFL: +25.260

A horizontal timeline with a dashed line. The year 175 is marked on the left, and 176 is marked on the right. The area between 175 and 176 is shaded light red.

Level: -03
EEL: +25 290

Level: AFFL
BH: + 2 170

Level: AFFL
CLG: +2.530

Level: -03
EEL: +25.2'

Note:
For Statutory Signage, refer to Fire Strategy Report
To be read in conjunction with 1716,3_SK001,0_Phase 01 Fire Strategy mark Up_210917


Project Name:		Title:		Scale:	
Renaissance		Block 03		1:150@A1	
Lower Ground Floor Level -03 (Phase 01)					
Drawn:	Checked:	Status:	Project:	Drawing No:	Rev:
CS	JC	Stage 4	150	B3_02_2096	B
Details:					
-	20,09,21	Issued for Information			

Jon Matthews Architects

Union, 2-10 Albert Square, Manchester, M2 6LW 0161 974 3690

Copyright in this drawing is vested in Jon Matthews Architects and must not be copied or reproduced without written consent. Figured dimensions only are to be taken from this drawing. Do not scale from this drawing. For full company disclosure please visit www.jonmatthewsarchitects.com

PHASE 02
260 OPERATIONAL
SPACES IN TOTAL

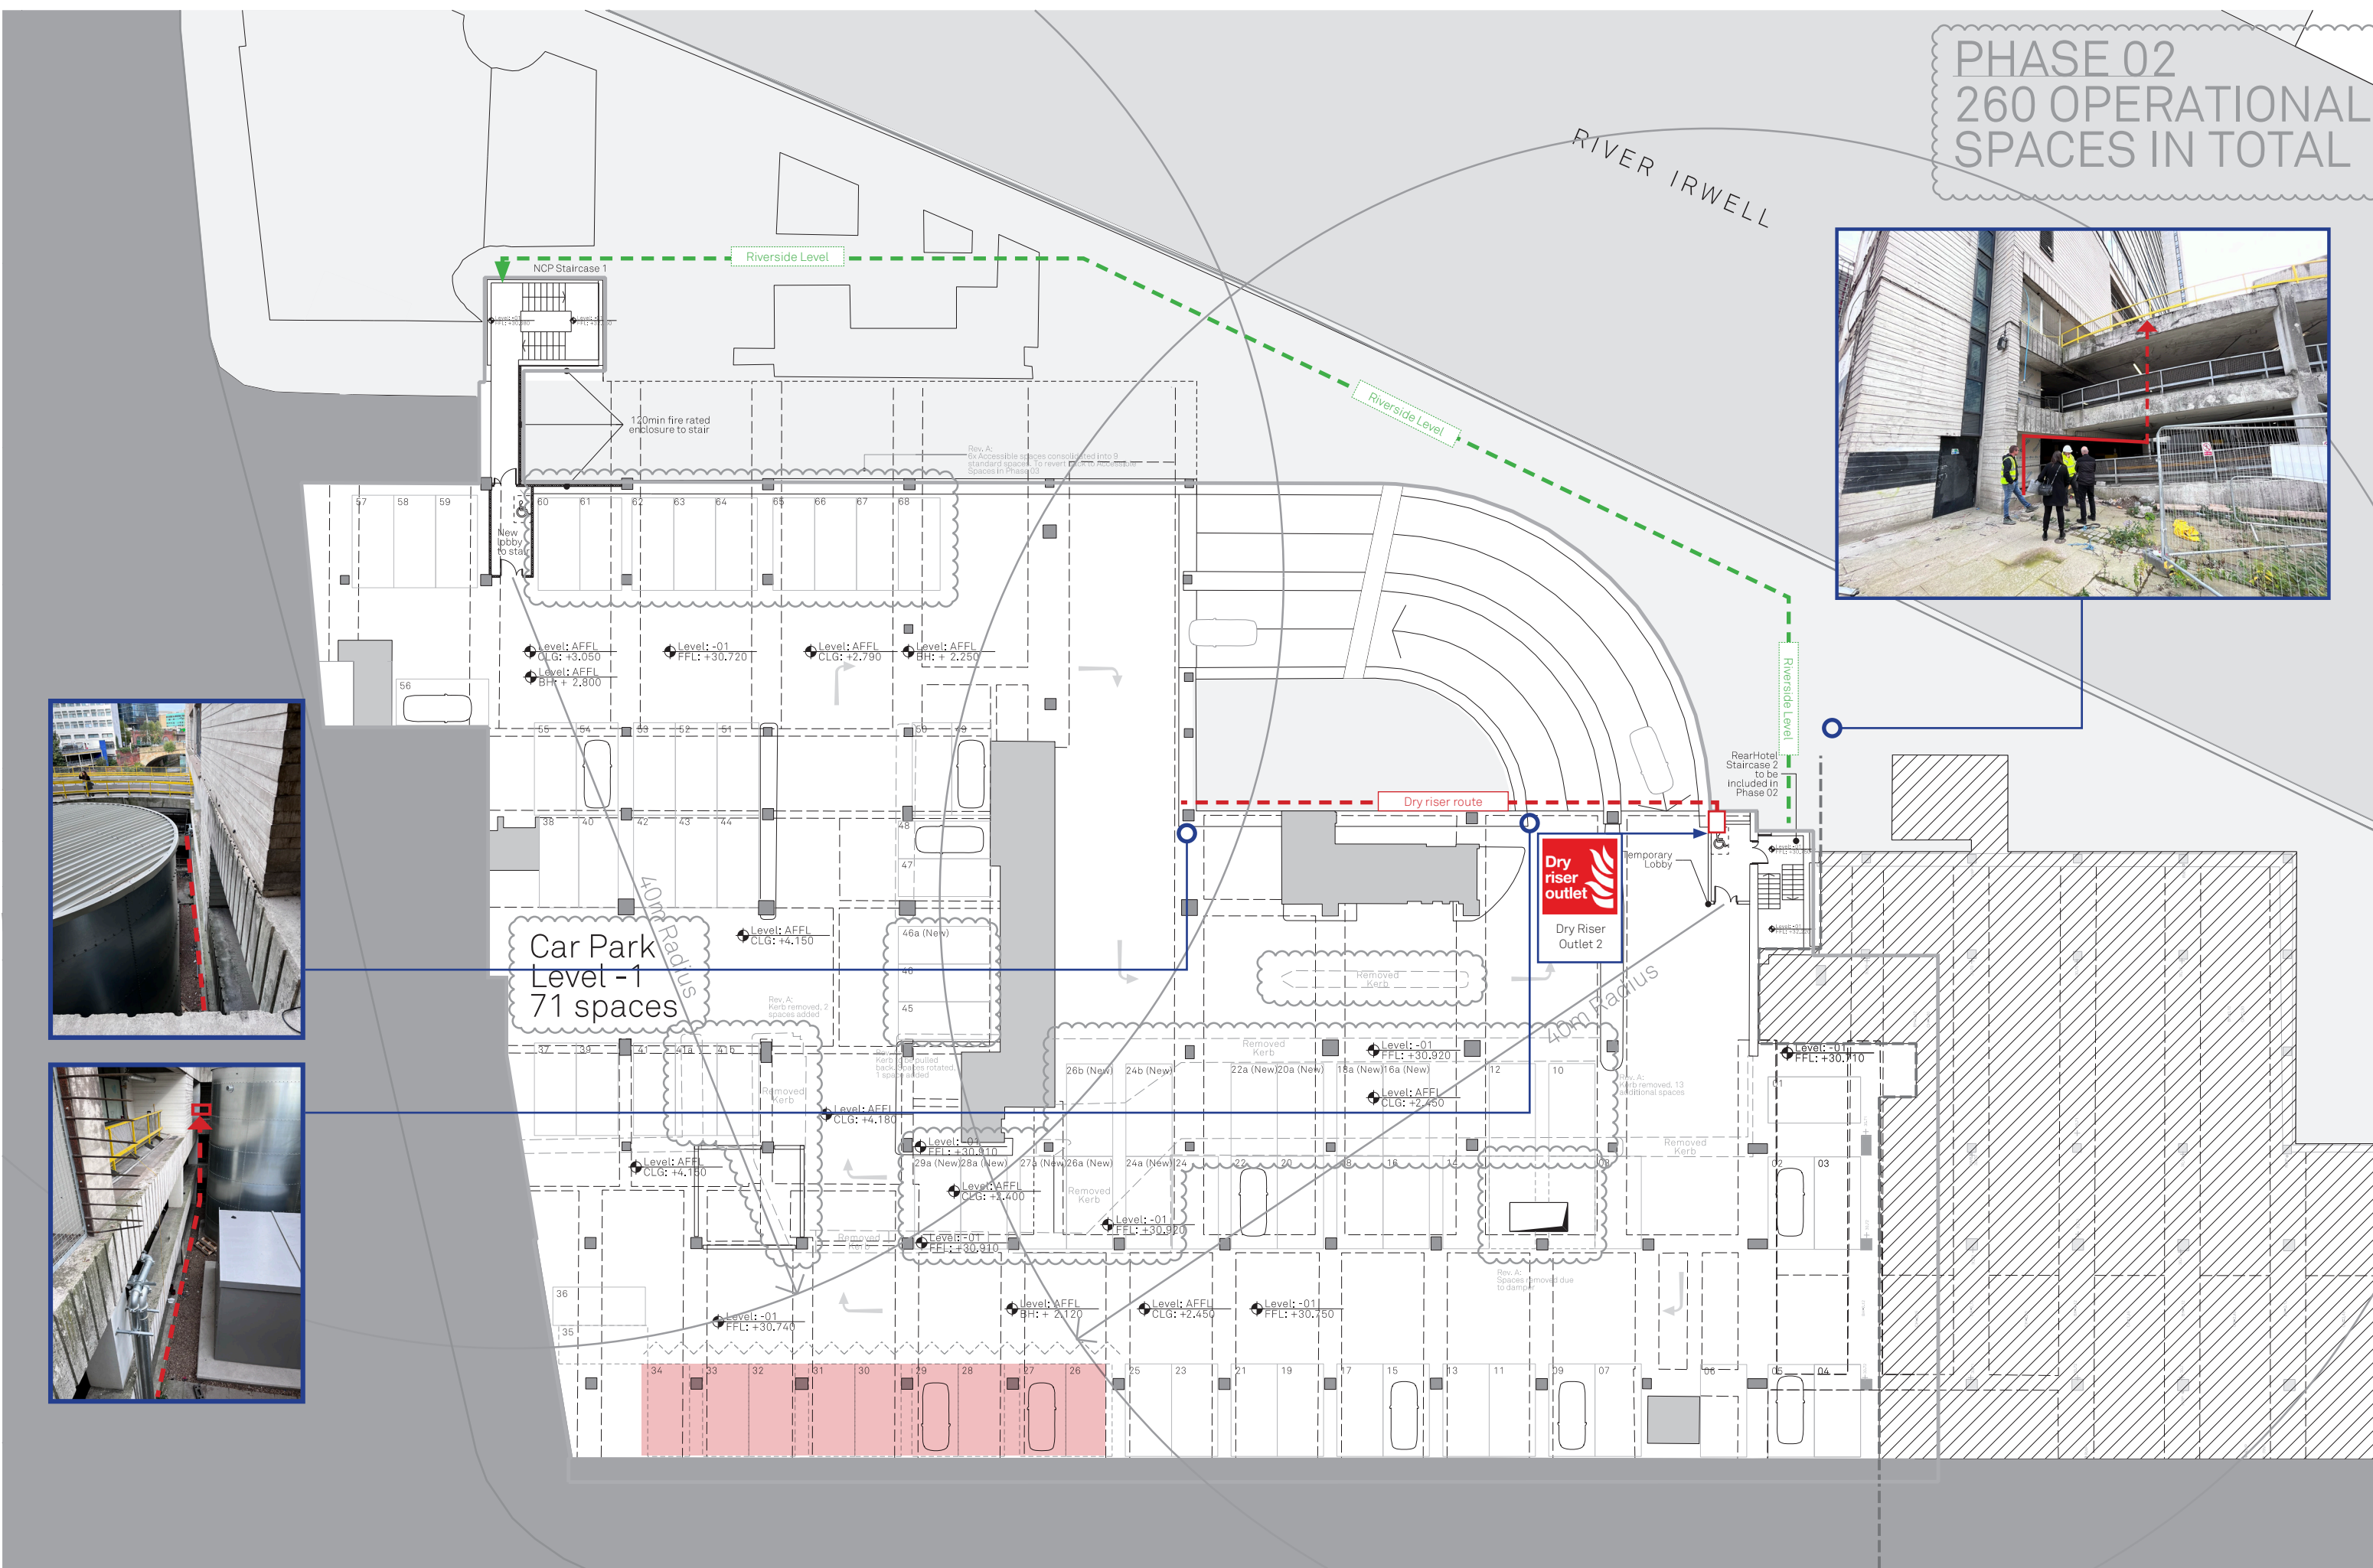

Decommissioned Car Parking
Retained Car Parking
Indicative Escape Distance
Demolition Line
Car Park Application Boundary
For Demolition
Indicative Car Parking Space Barrier

Note:
For Statutory Signage, refer to Fire Strategy Report
To be read in conjunction with 1716.3_SK002.0_Phase 02 Fire Strategy mark Up_210917



Project Name:
Renaissance
Drawn: JC
Checked: JC

Title:
Block 03
Lower Ground Floor Level -01 (Phase 02)
Status:
Stage 4

Scale:
1:150@A1
Project:
150
Drawing No:
B3_02_2198
Rev:
A

Jon Matthews Architects
4th Floor, Centurion House, 129 Deansgate, Manchester, M3 3WR
0161 974 3690

Copyright of this drawing is vested in Jon Matthews Architects and must not be copied or reproduced without written consent. Figures and dimensions only are to be taken from this drawing. Do not scale from this drawing. For full company disclosure please visit www.jonmatthewsarchitects.com

Date:
20.09.21
Issued for Information




Note:
For Statutory Signage, refer to Fire Strategy Report
To be read in conjunction with 1716.3_SK002.0_Phase 02 Fire Strategy mark Up_210917

Jon Matthews Architects

4th Floor, Centurion House, 129 Deansgate, Manchester, M3 3WR 0161 974 3690

Copyright of this drawing is vested in Jon Matthews Architects and must not be copied or reproduced without written consent. Figure dimensions only are to be taken from this drawing. Do not scale from this drawing. For full company disclosure please visit www.jonmatthewsarchitects.com

PHASE 02
260 OPERATIONAL
SPACES IN TOTAL

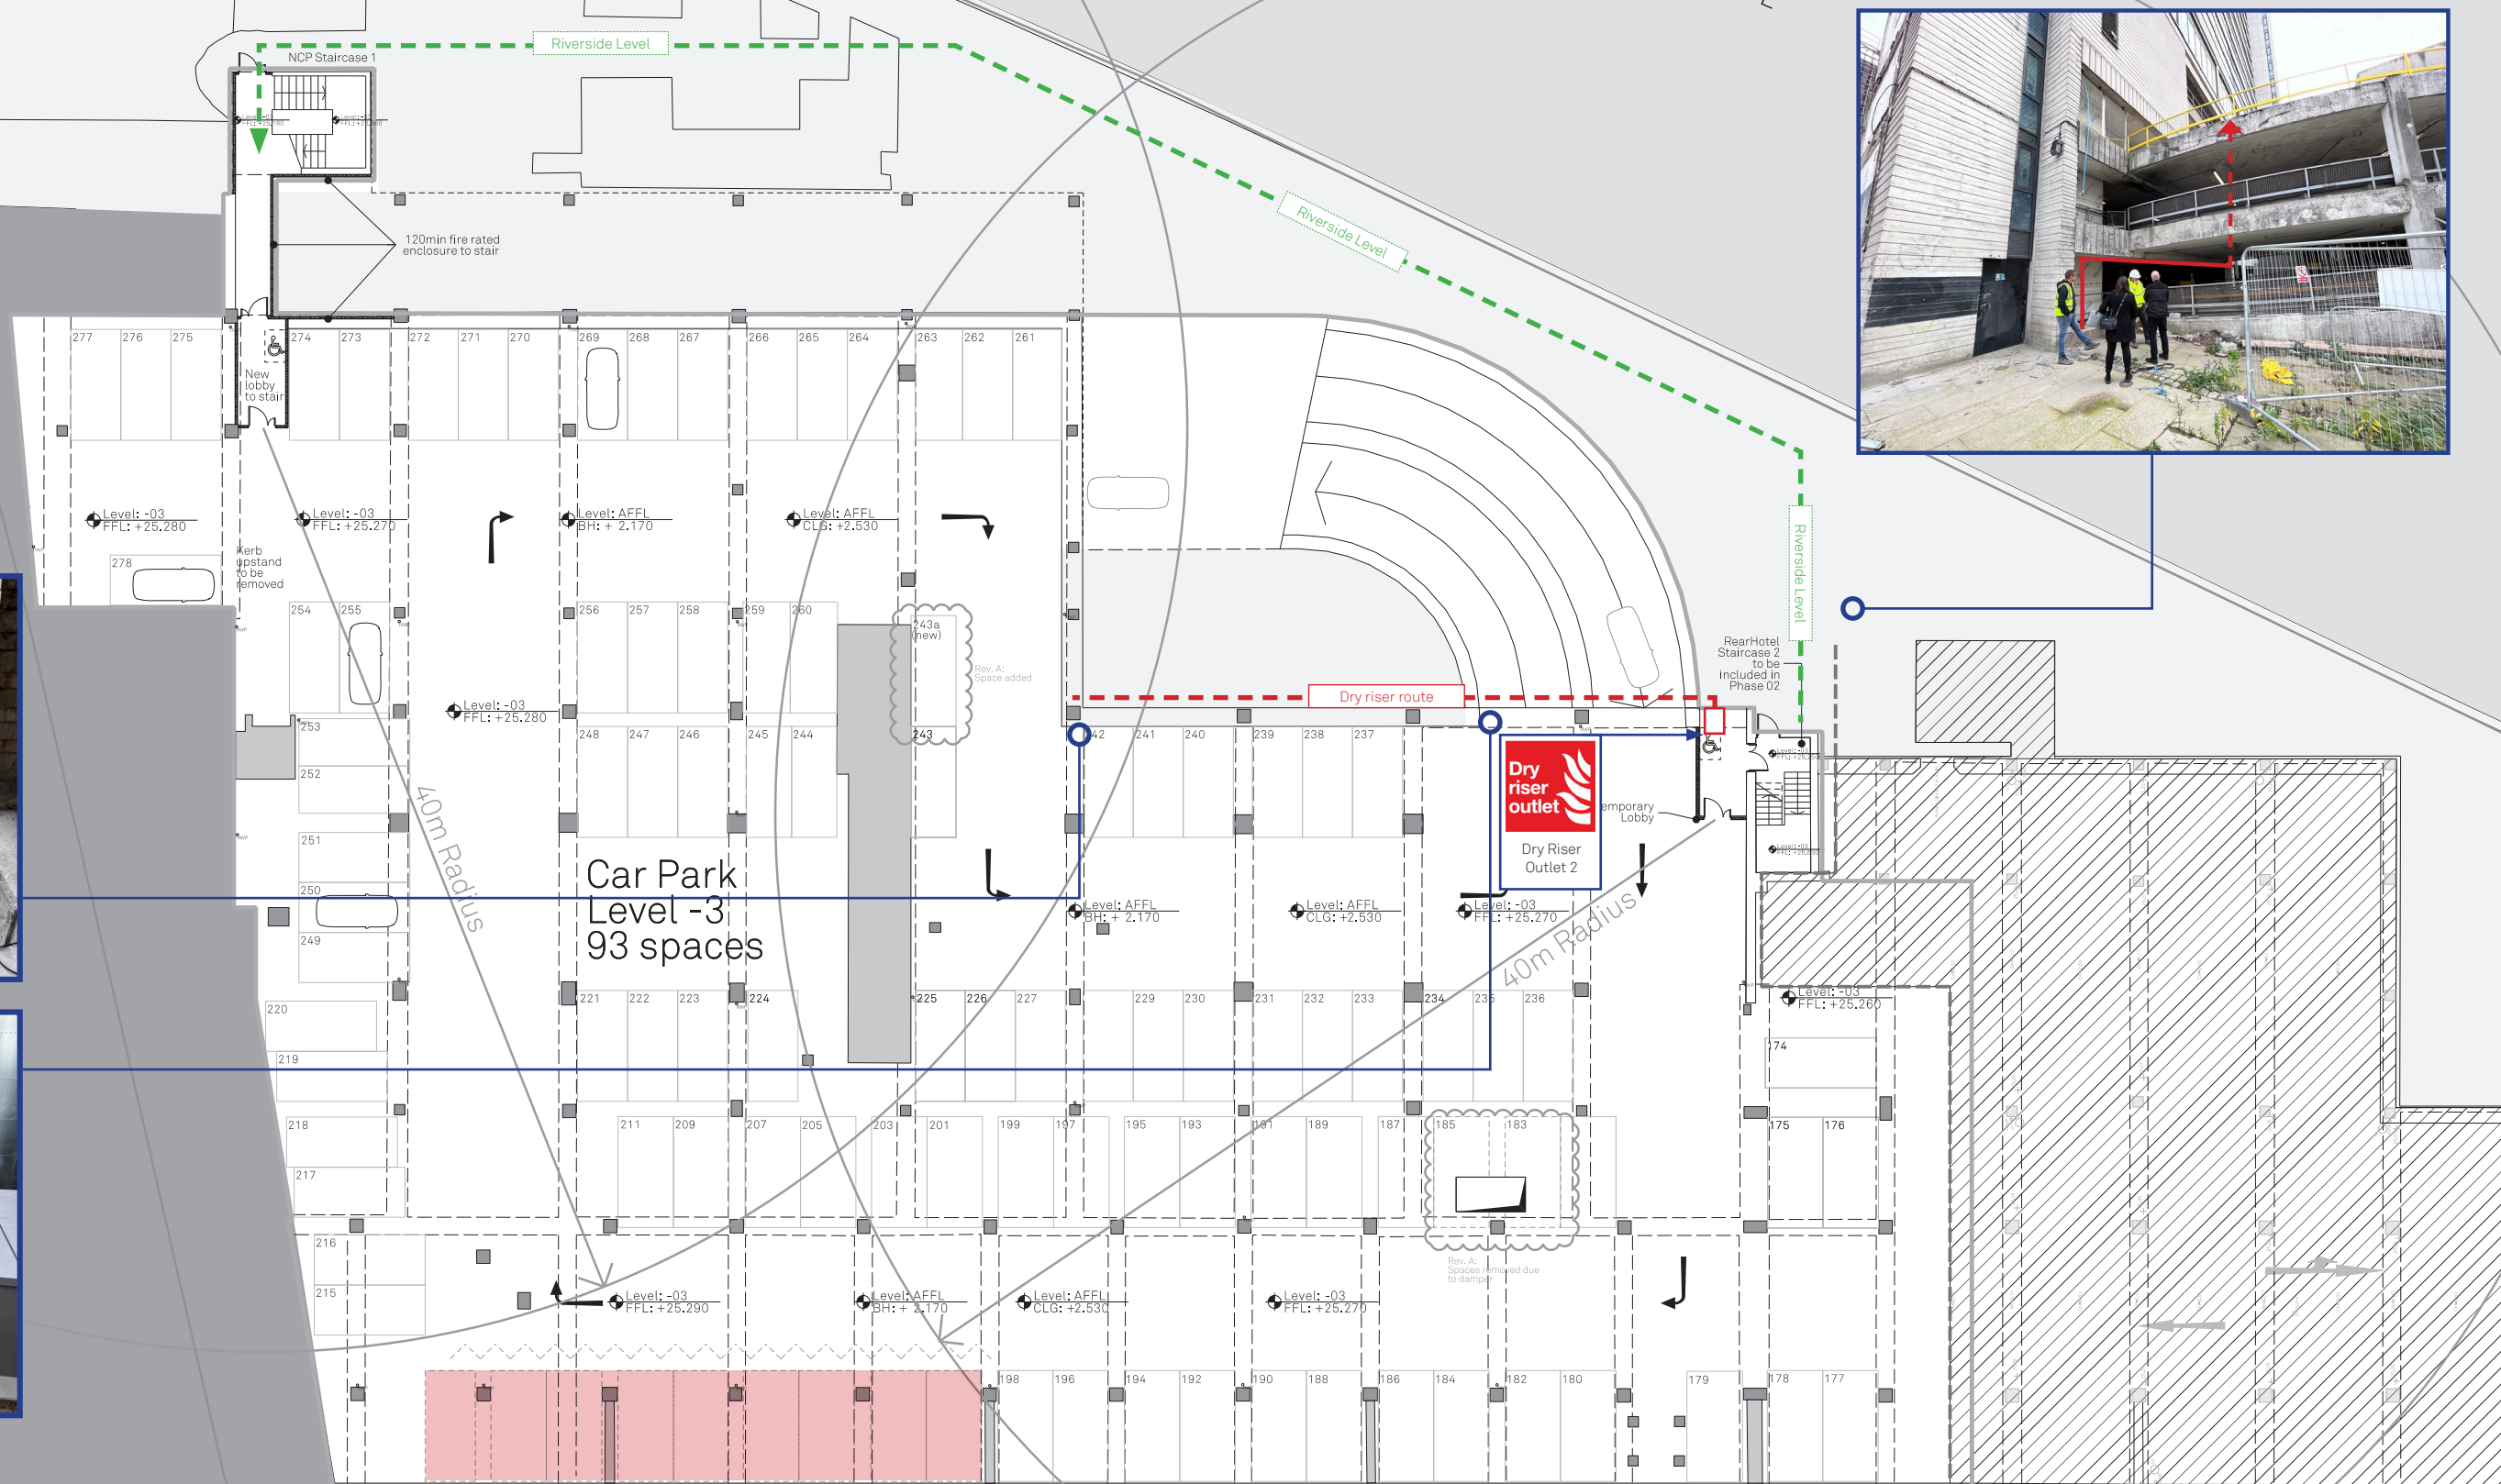

Decommissioned Car Parking
Retained Car Parking
Indicative Escape Distance
Demolition Line
Car Park Application Boundary
For Demolition
Indicative Car Parking Space Barrier

Note:
For Statutory Signage, refer to Fire Strategy Report
To be read in conjunction with 1716.3_SK002.0_Phase 02 Fire Strategy mark Up_210917

Project Name: Renaissance	Title: Block 03 Lower Ground Floor Level -03 (Phase 02)	Scale: 1:150@ A1
Drawn: CS	Checked: JC	Status: Stage 4
Details: 20,09,21		Issued for Information

Jon Matthews Architects

Union, 2-10 Albert Square, Manchester, M2 6LW

0161 974 3690

Copyright of this drawing is vested in Jon Matthews Architects and must not be copied or reproduced without written consent. Figured dimensions only are to be taken from this drawing. Do not scale from this drawing. For full company disclosure please visit: www.jonmatthewsarchitects.com