


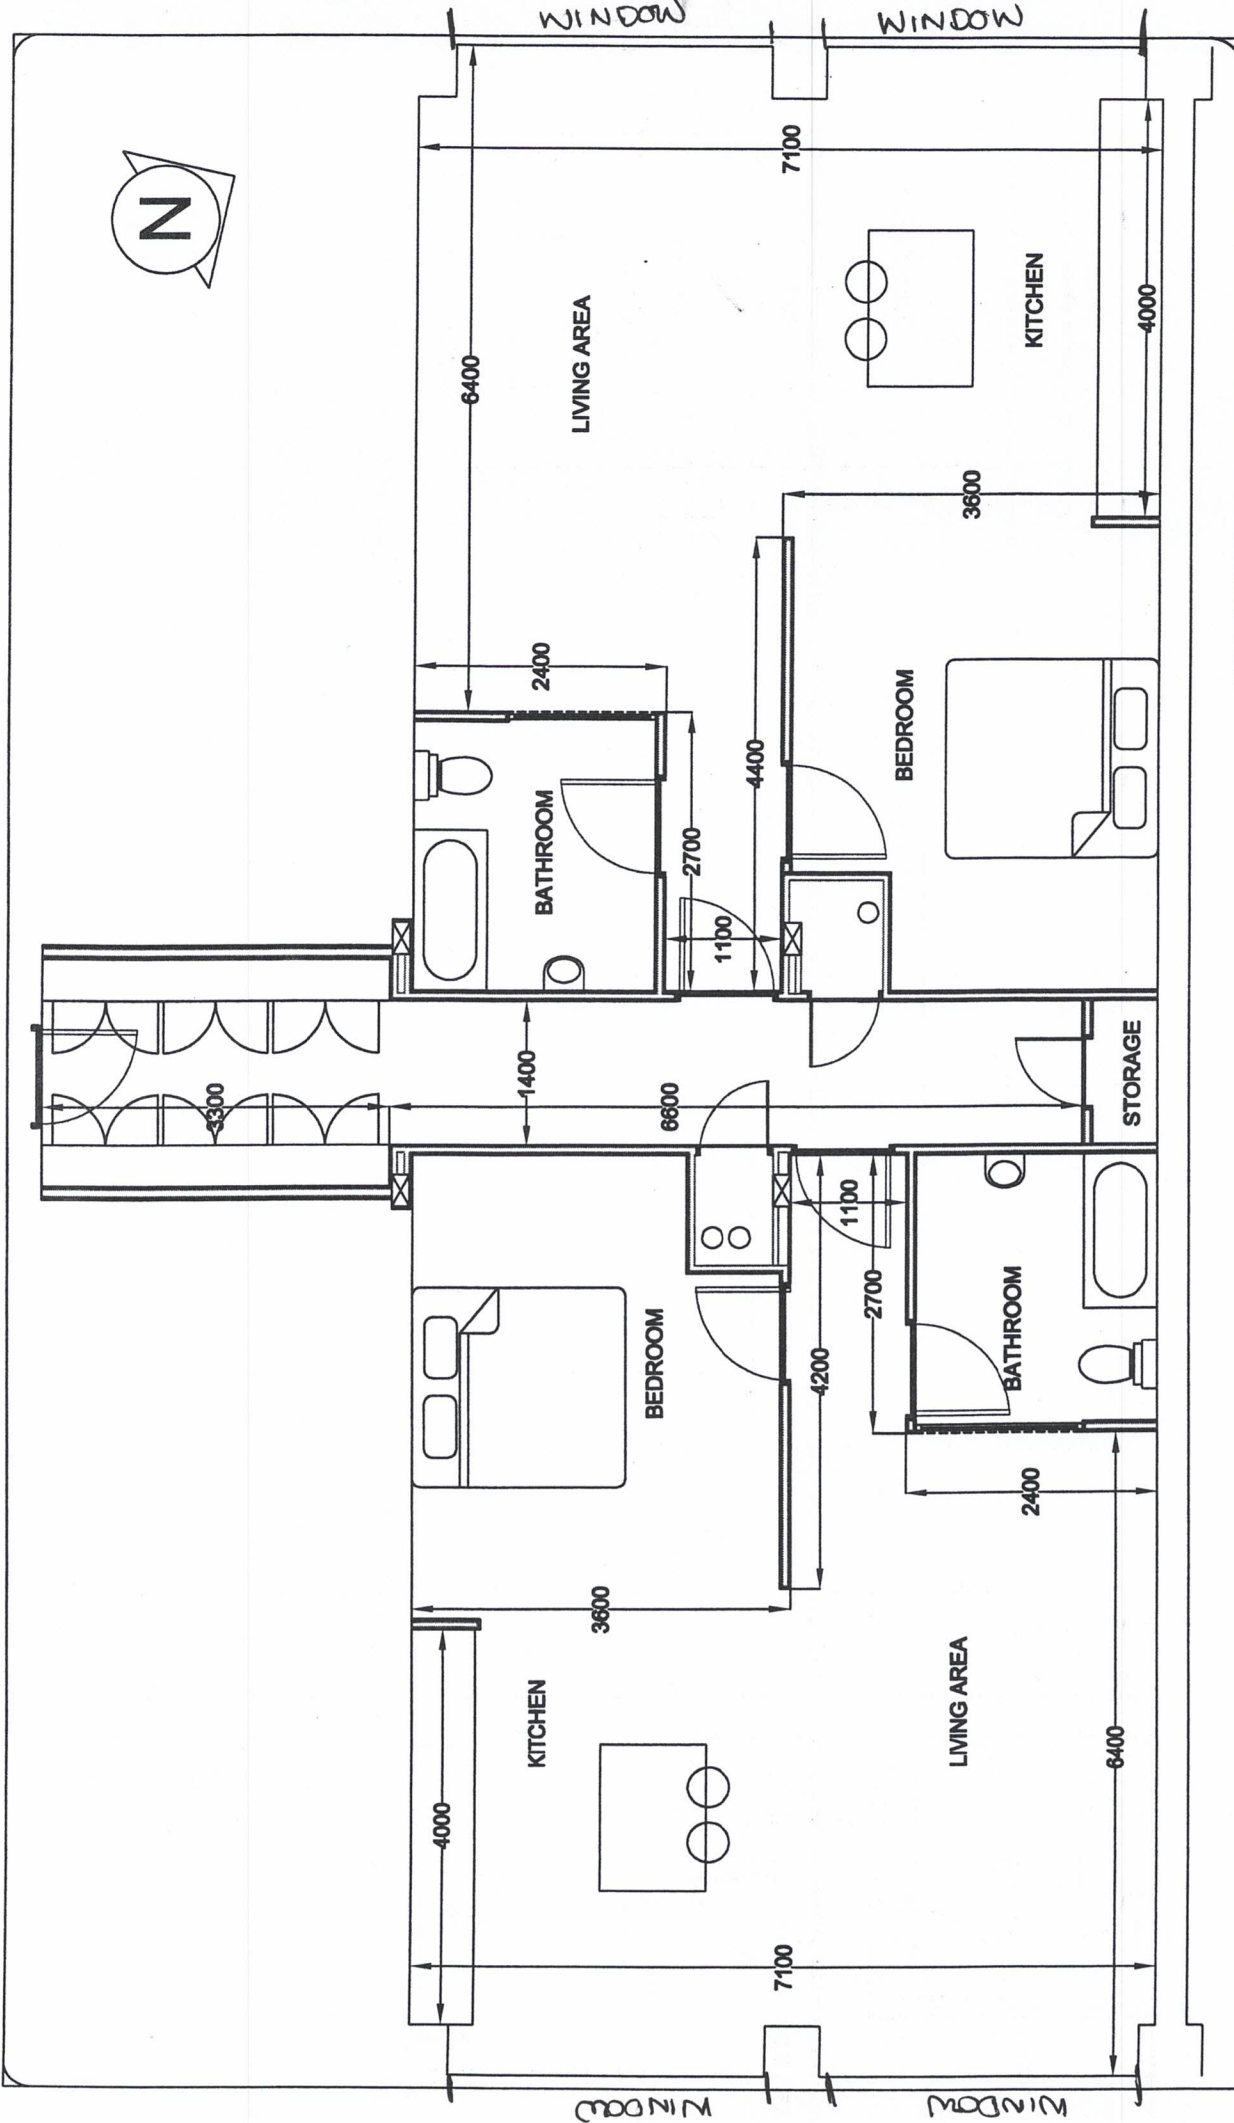

Client: N J Group			
Project	Left Bank Apartment Manchester		
Title	As-built layout		
Drawn	CA	Checked by	—
Date	Feb 2019	Scale (at A3)	1:50
Revision No.	Apartment 10.53 - complete		
	B		

Drawing History			
A	10/04/19	Class wall removed between kitchen and bedroom	CA
B	23/05/19	Adjustments made to match drawing to site	CA
Rev	Date	Details Of Issue	Issue

