



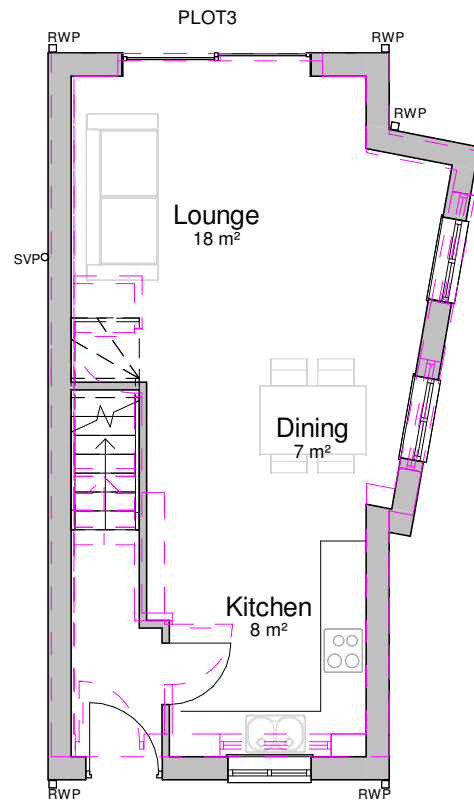

1

As-built Ground Floor Plan


1 : 100

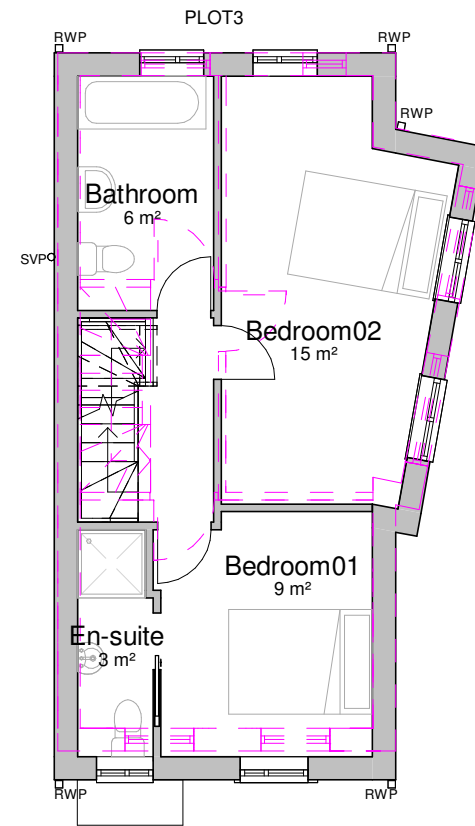

2

As-built First Floor Plan


1 : 100

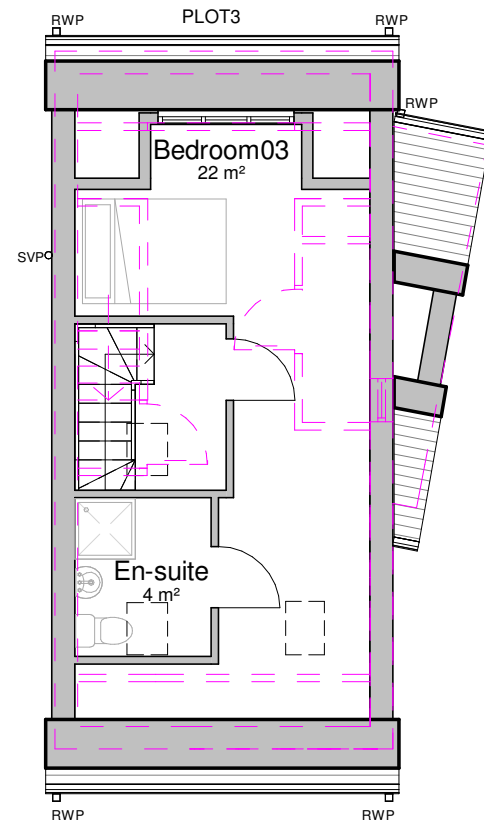

3

As-built Loft Plan


1 : 100

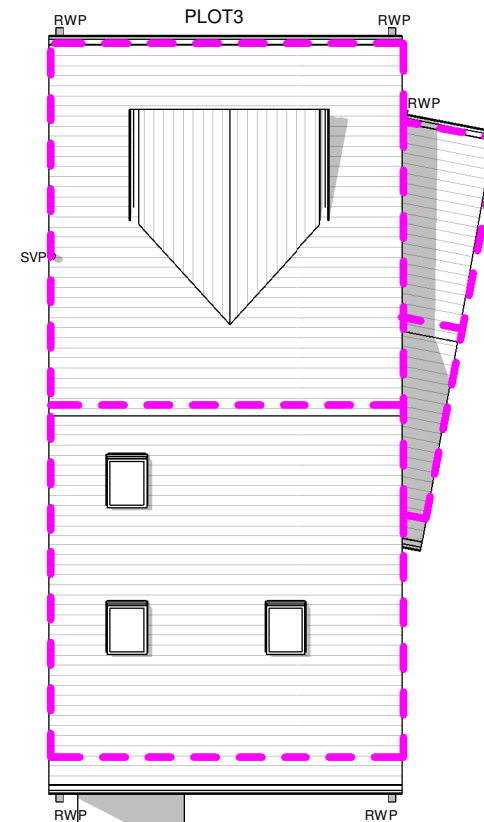

4

As-built Roof Plan

1 : 100

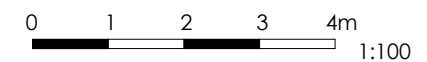

General Notes

The Architect shall have no responsibility for any use made of this document other than for that which it was prepared and issued.
All dimensions should be checked on site. Do not scale from this drawing. To be read in conjunction with all other Consultant's drawings. The Architect to be immediately notified of any discrepancies.

Copyright on this drawing retained by the Architect.

LEGEND

Approved Application: 120891/FO/2018

C	24/10/22	AK	SH	Added Flat Canopy
B	03/08/21	SA	SH	Added Drainage
A	17/05/21	SA	SH	Amended Roof Height
-	09/04/21	SA	SH	Initial Issue
No.	Date	Dwn	Chk	App
				Revision or reason for issue

Client

R&S Builders

create it studios
Architects & Designers

Create It Studios (NW) Ltd
Universal Square
Devonshire Street North
Manchester M12 6JH
0161 974 6165
www.createitstudios.co.uk
info@createitstudios.co.uk

Project Title

492-494 Claremont Road,
Manchester M14 5WA

Scale / North Point

1 : 100

Drawing Title

As-built Floor Plans - Plot3

Drawing Number
A1344(02)004

Drawing Status
Preliminary

Revision
C