

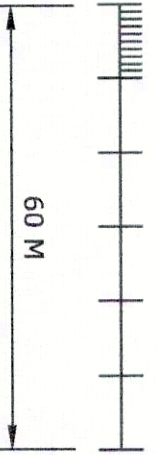


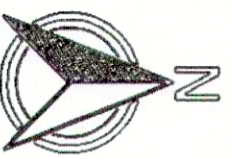

Land Parcel to be enclosed

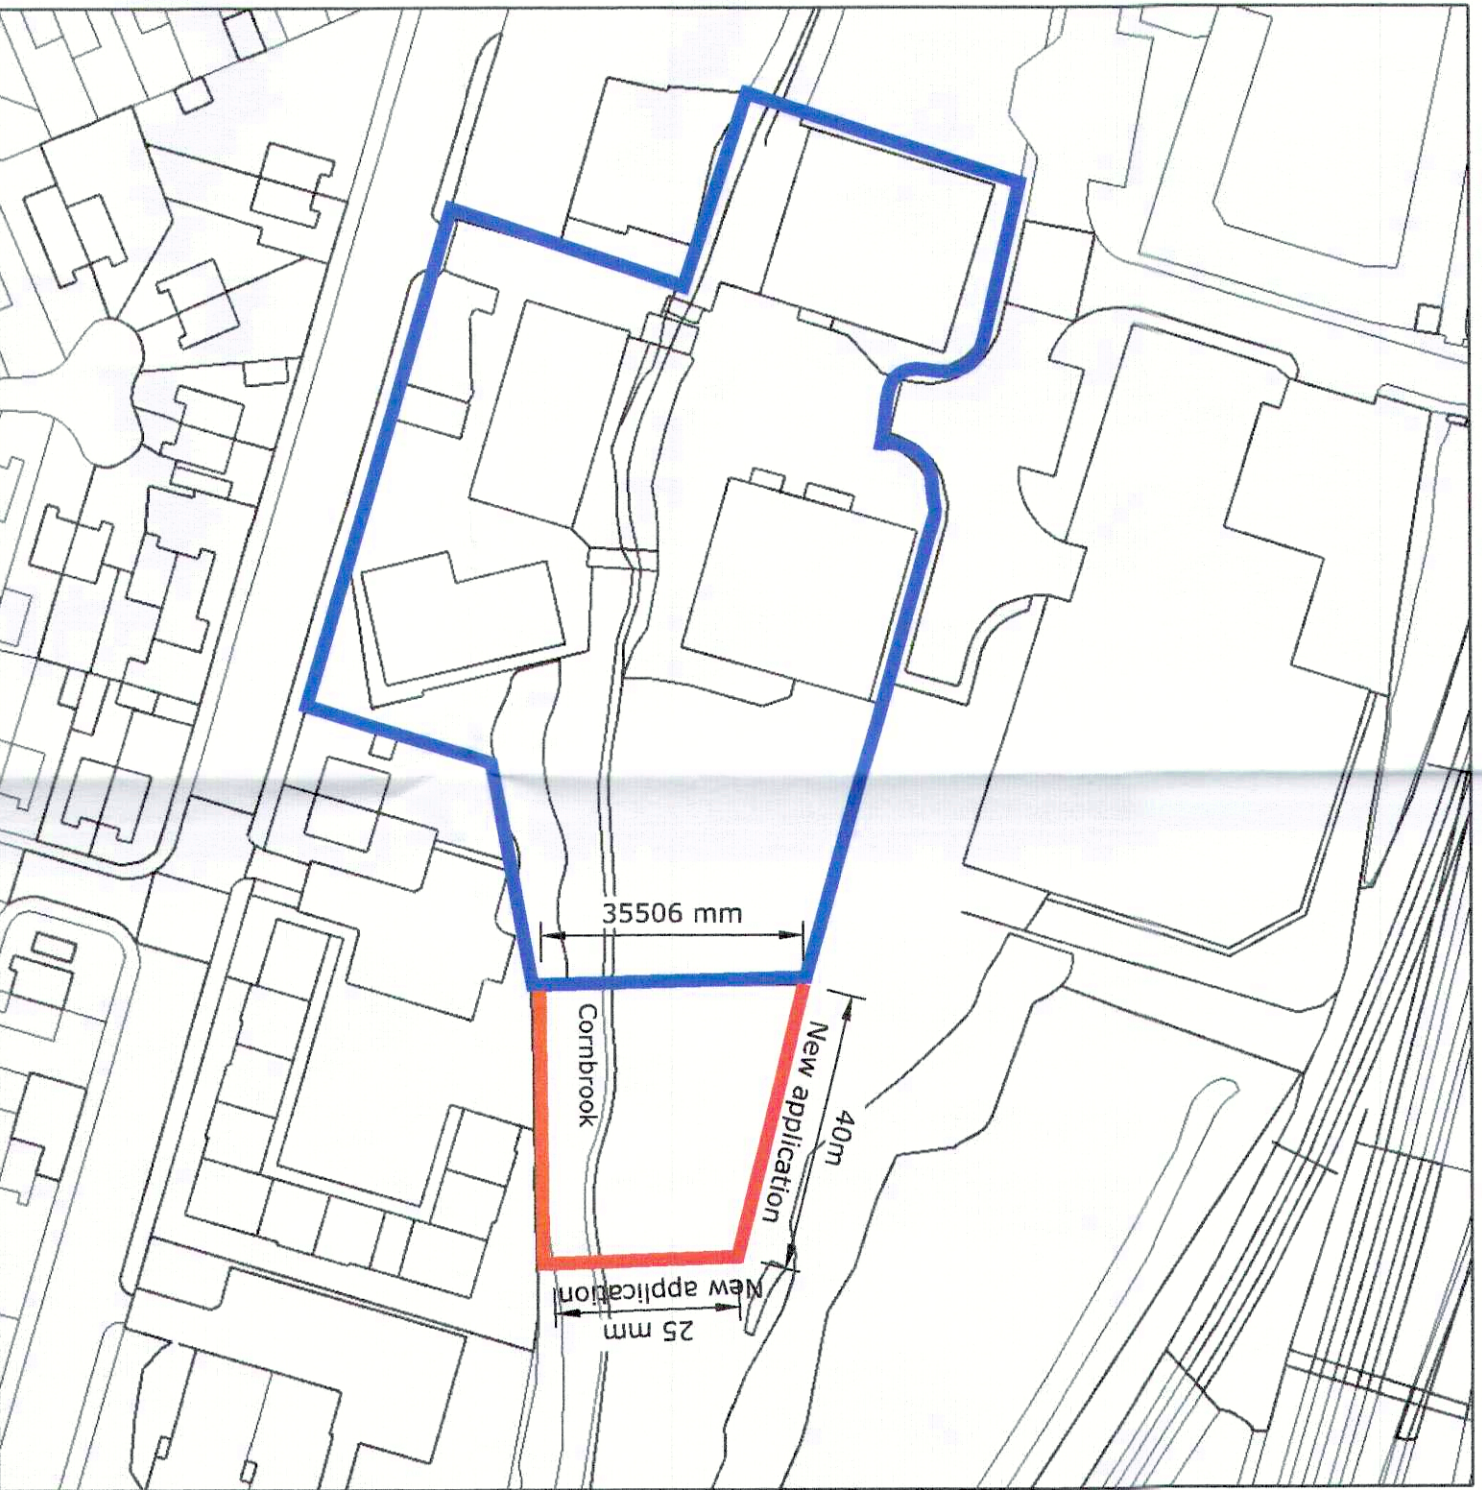

Revised boundary from former application
Now extends across the Cornbrook

Existing Boundary Of J Allcock and Sons

REVISIONS	
MM/DD/YY	REMARKS
15/10/2022	Colour coding and bounding correction display
1	— / —
2	— / —
3	— / —
4	— / —
5	— / —


A4	1
----	---






HANDLING & STORAGE PROBLEMS SOLVED

[illegible]

Scale	As stated	Status			
Title	Adjusted fence boundary	Design ☐	Production ☐	Other ☒	
Dwg No.	010622.1	Estimating ☐	As Built ☐	DRN	PRC
Issue No.	A.01	Approval ☐	Records ☐	Date	15.10.2022

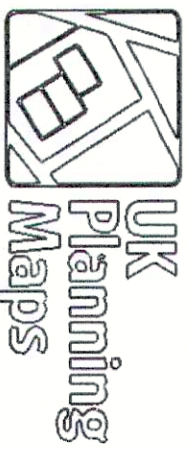

Palisade enclosure new and existing

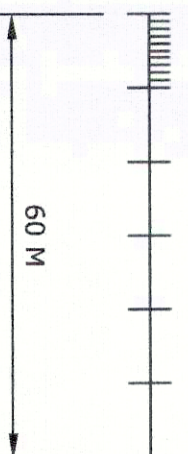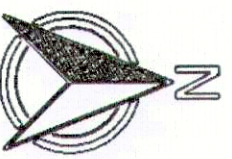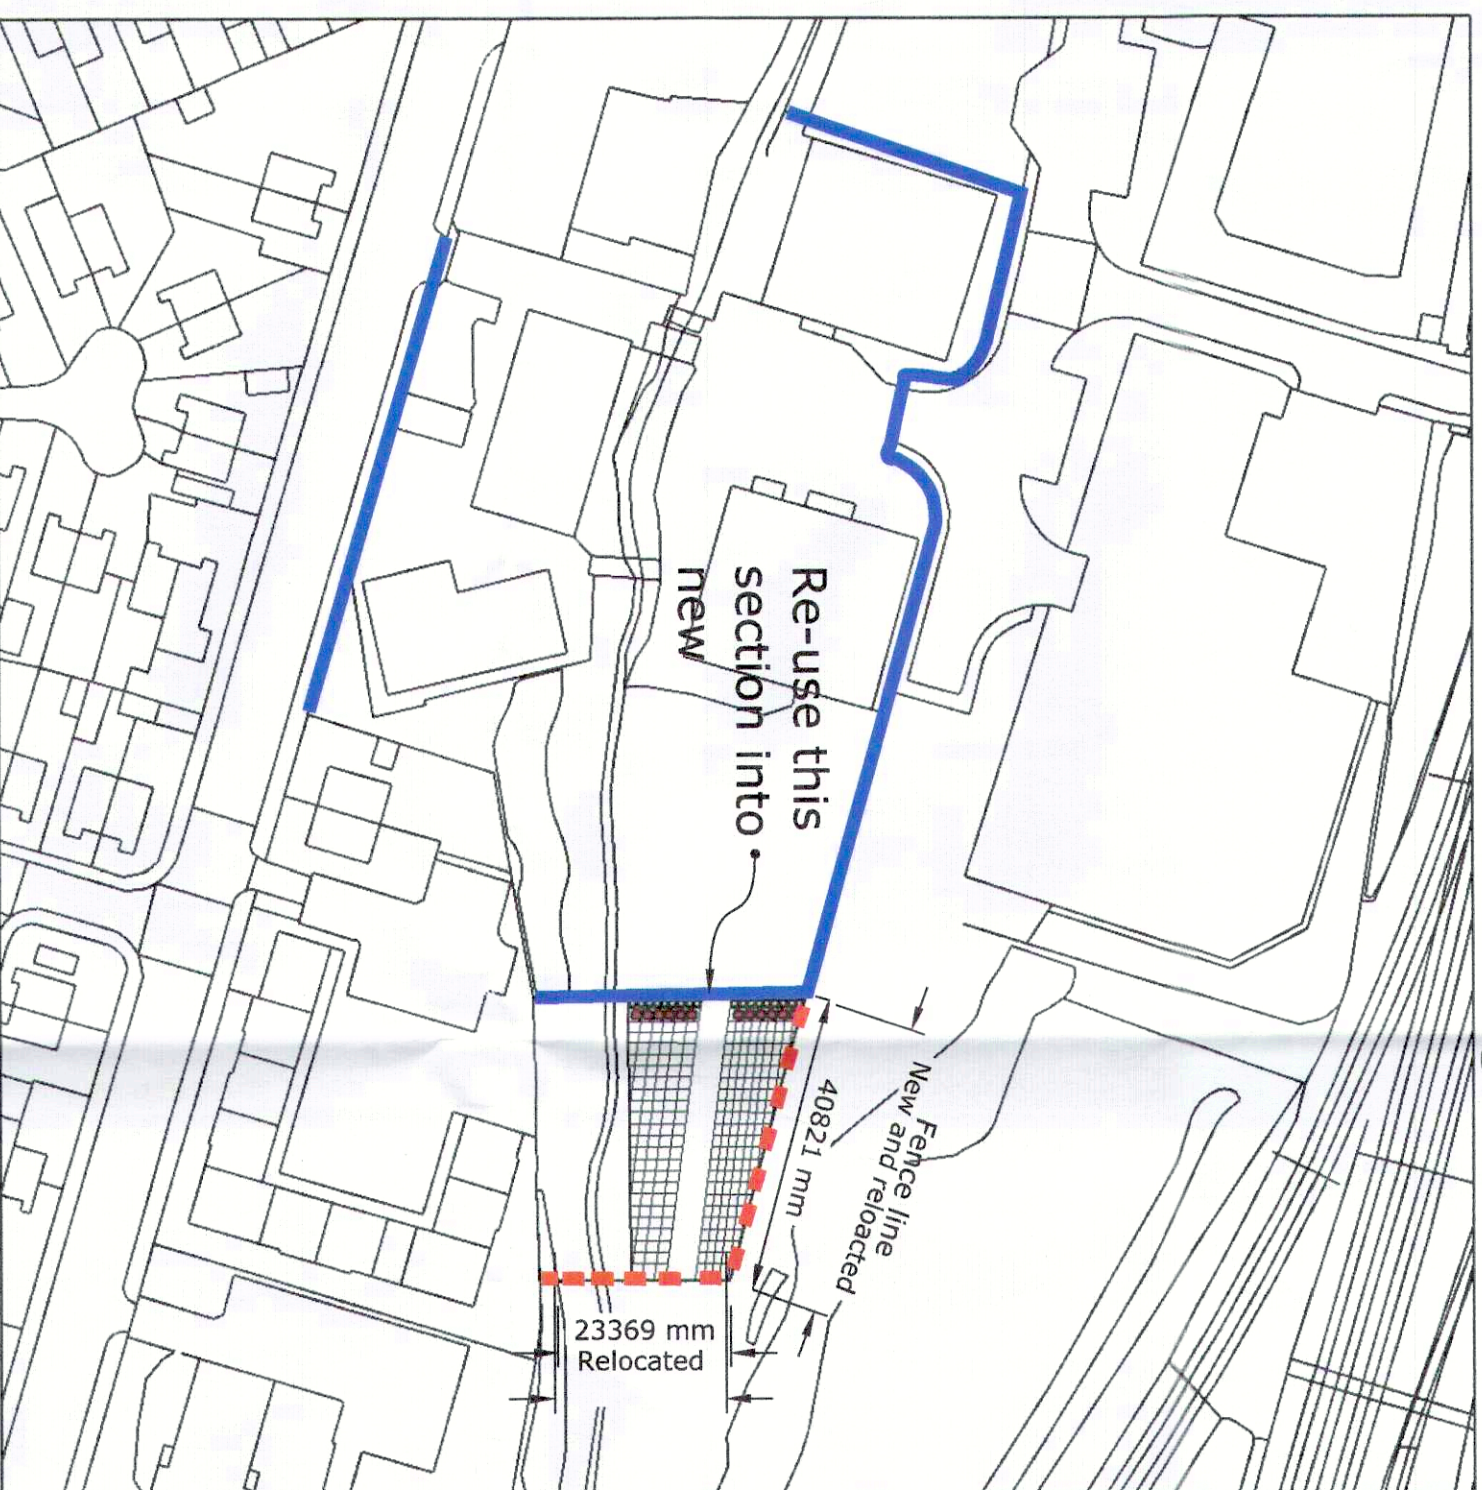

Proposed palisade Fencing
with 65m approx Palisade fencing
of which 35.5m is re-useable (54%)

Existing boundary Fencing with 250m Palisade

[illegible]

Scale	As stated	Status			
Title	Adjusted fence boundary	Design ☐	Production ☐	Other ☒	
Dwg No.	010622.1	Estimating ☐	As Built ☐	DRN	PRC
Issue No.	A.01	Approval ☐	Records ☐	Date	15.10.2022

This drawing represents the design and function of the equipment depicted. The final product may vary in precise detail subject to suitability of component manufacture. Structural performance is not warranted, such information is available by separate warrant only where requested in writing from us and may be subject to charges. We take no responsibility for existing structures, patent infringements or design variations. We reserve the right to modify or change any features which do not fit with our final build programs as we see fit in the reasonable pursuit of best engineering practices and safe design without notice.

PLANNING AND BUILDING CONTROL

18 OCT 2022