


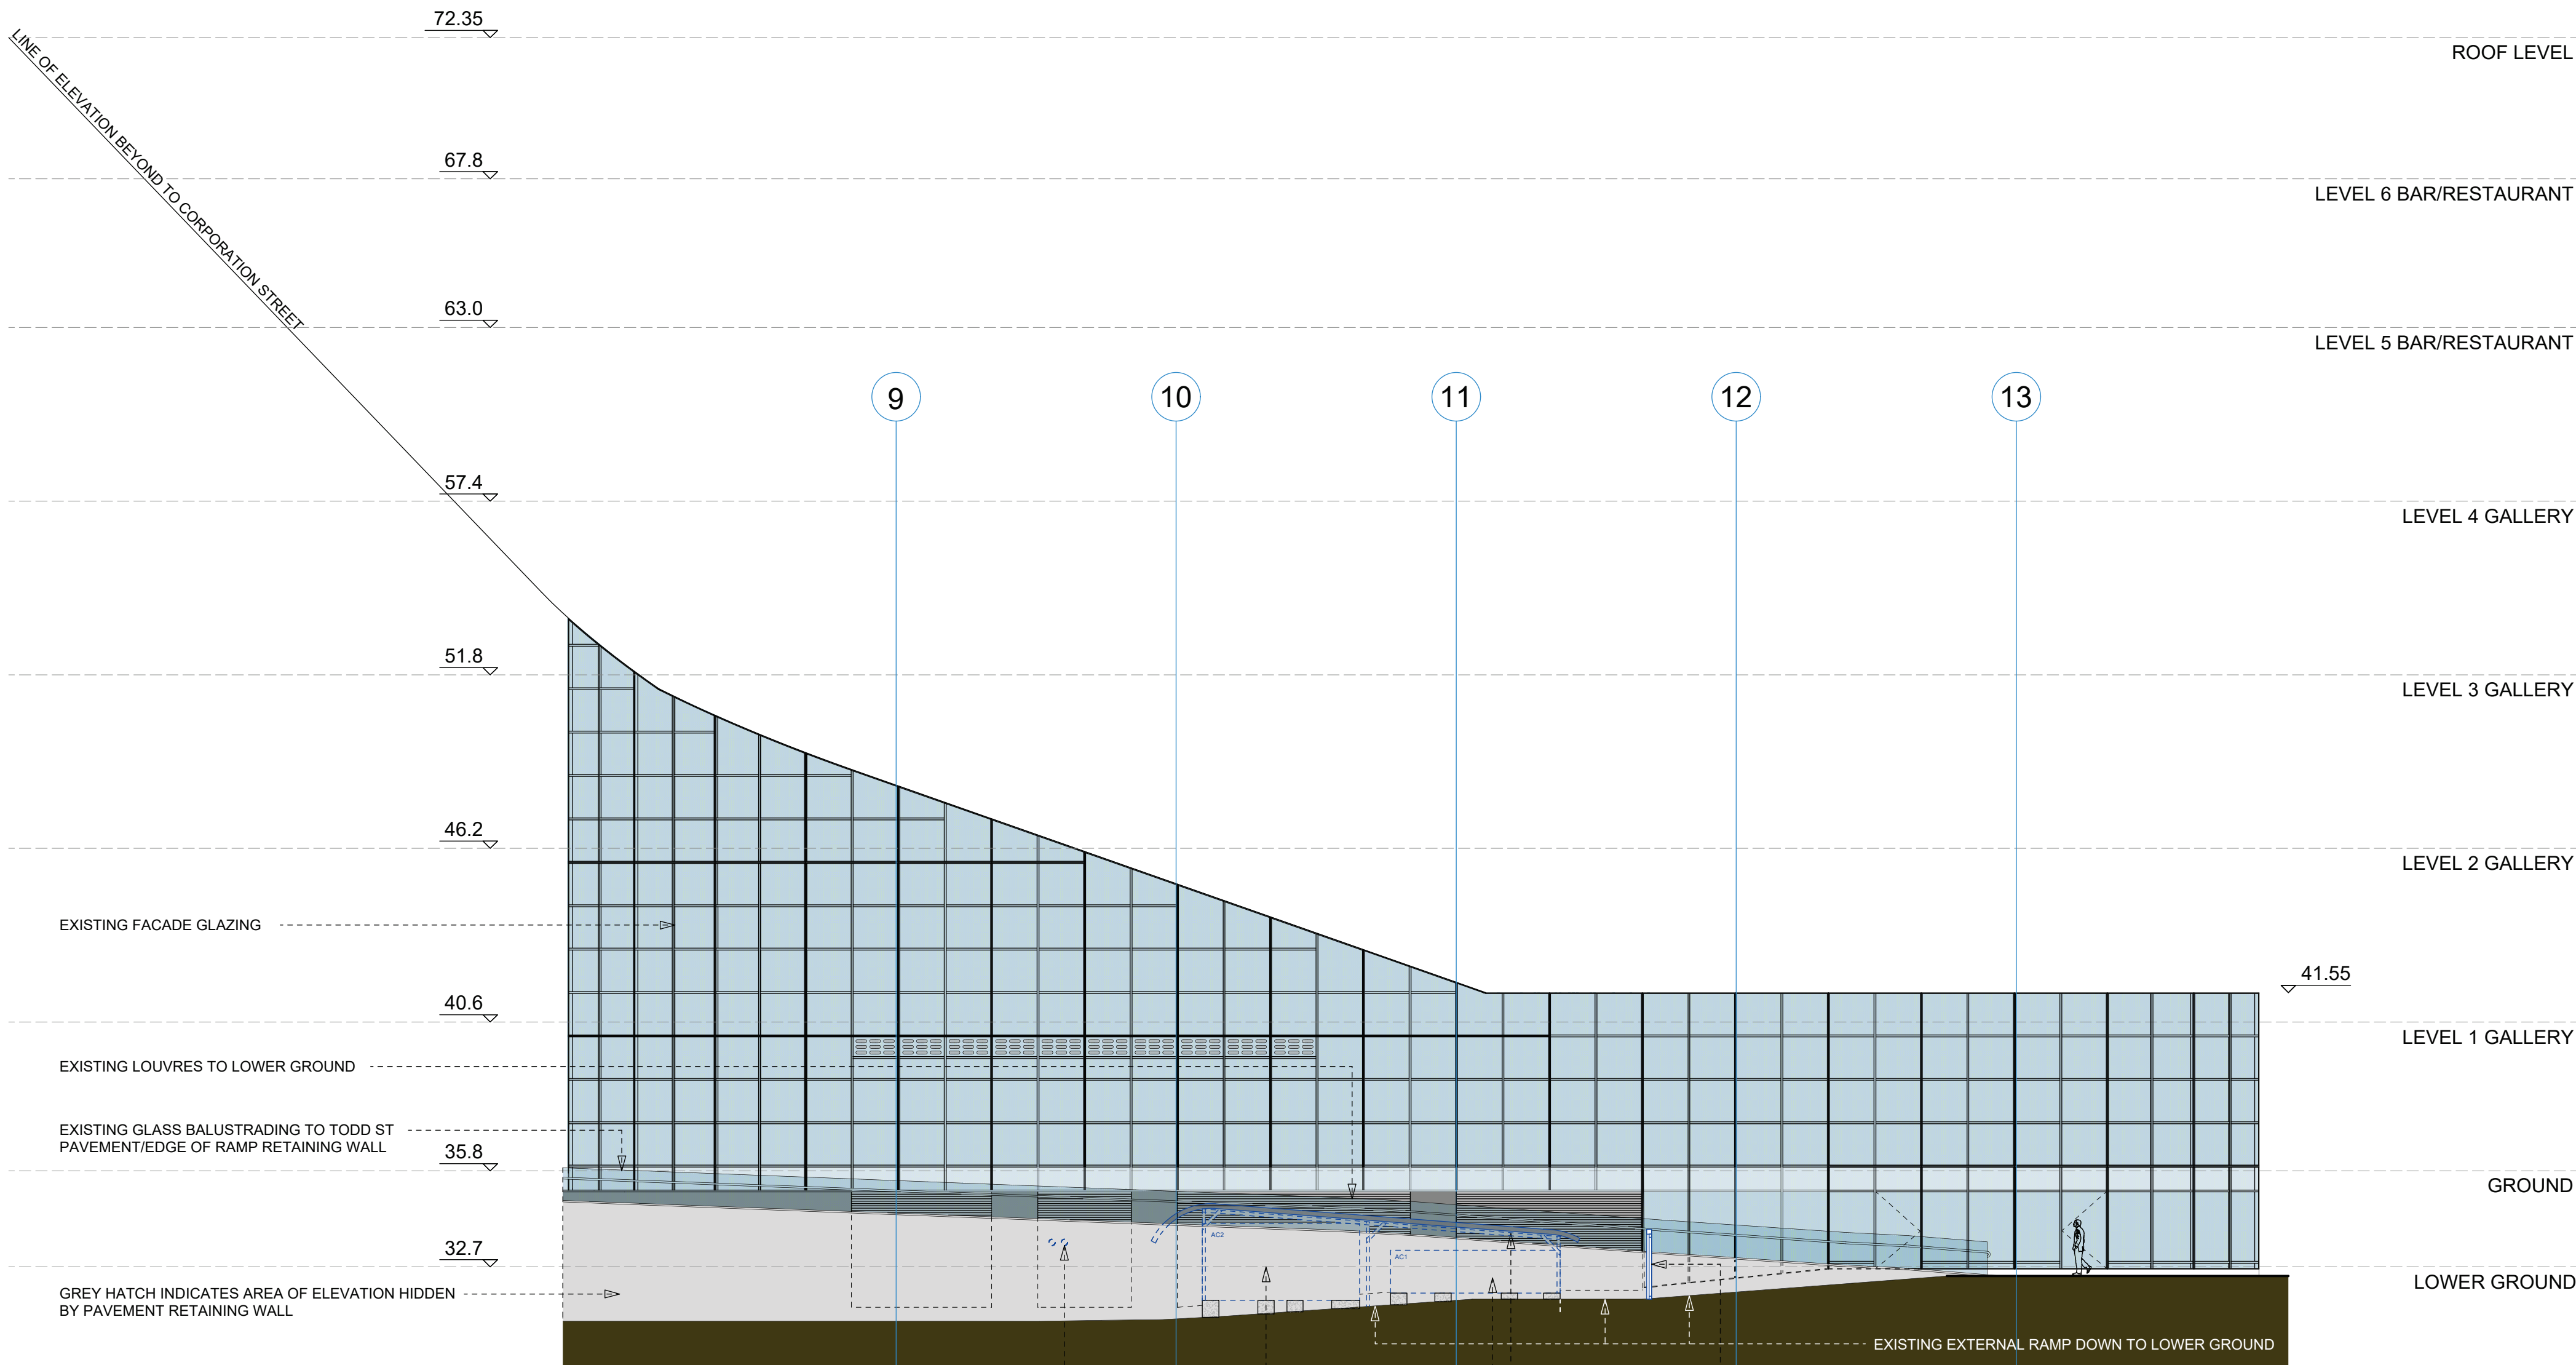


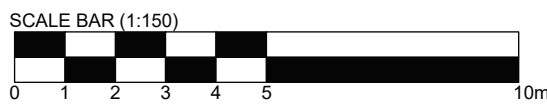


PROPOSED PART-ELEVATION TO TODD STREET - **VIEW 'A'**

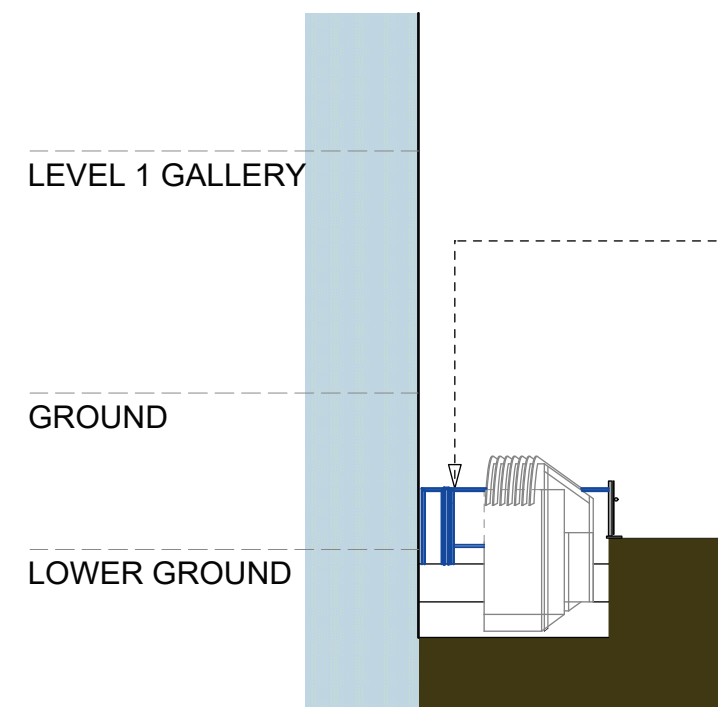


PROPOSED PART-ELEVATION **VIEW 'B'**

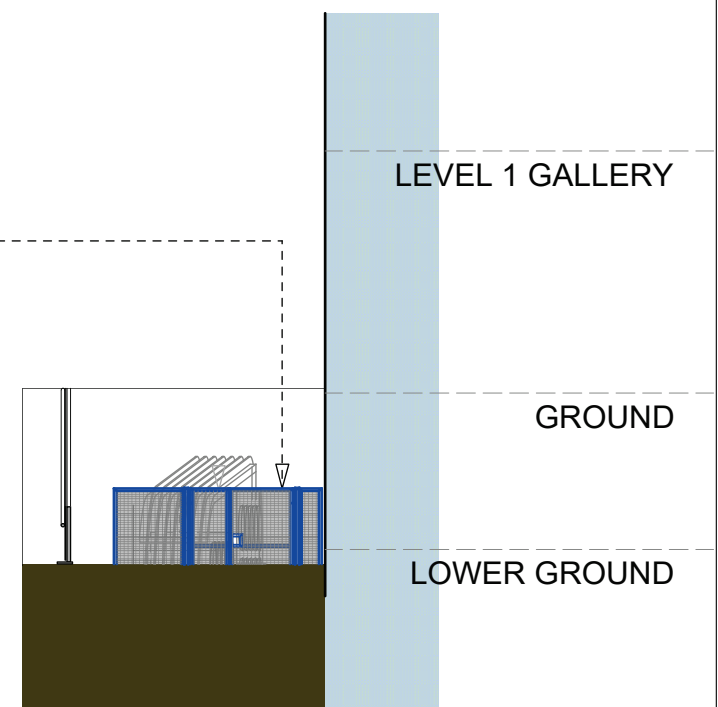



PROPOSED PART-ELEVATION **VIEW 'D'**

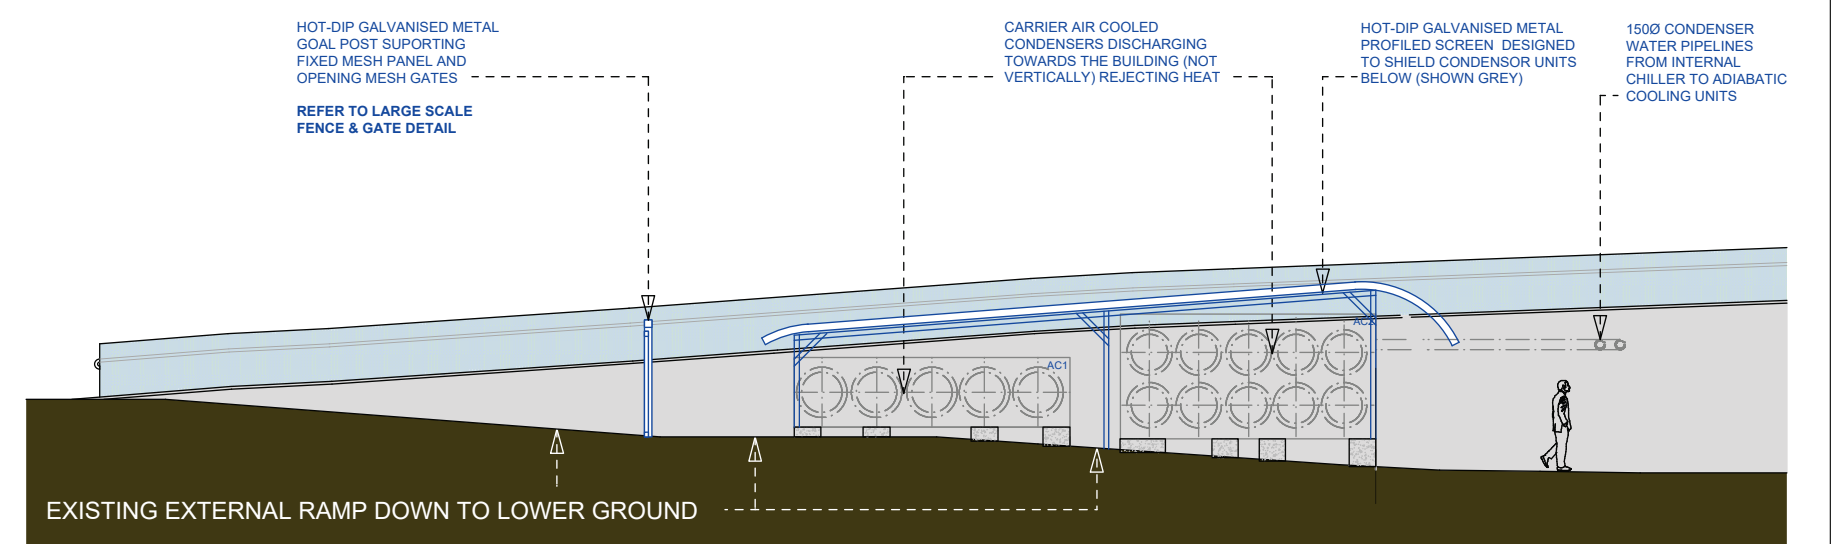

PROPOSED PART-ELEVATION (OPPOSITE VIEW A) - **VIEW 'C'**

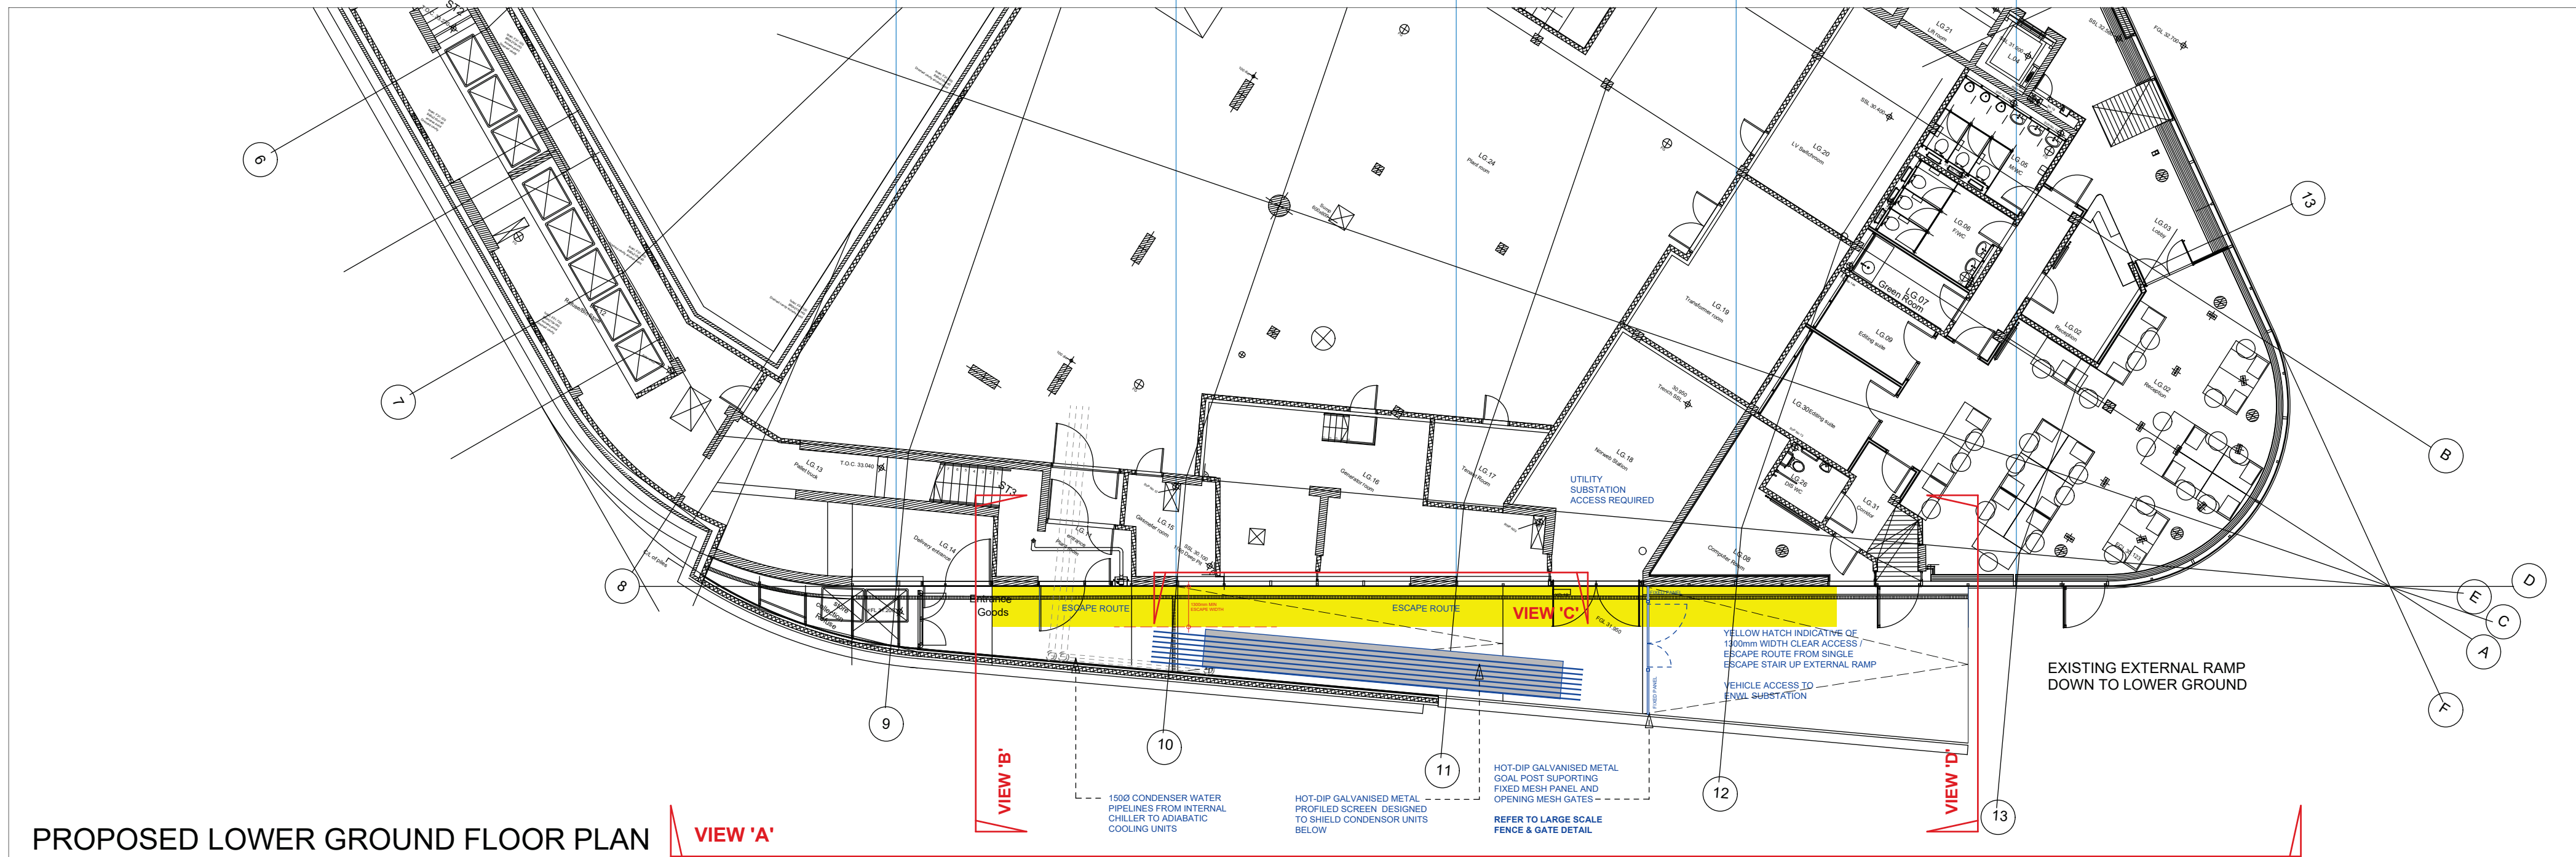

PROPOSED LOWER GROUND FLOOR PLAN **VIEW 'A'**

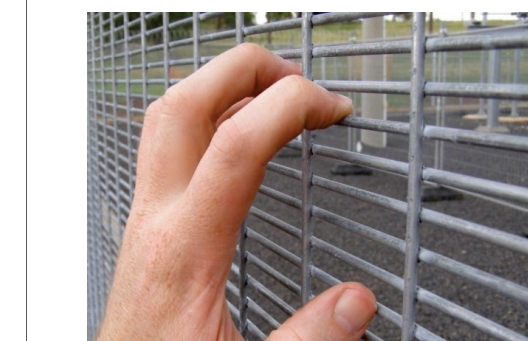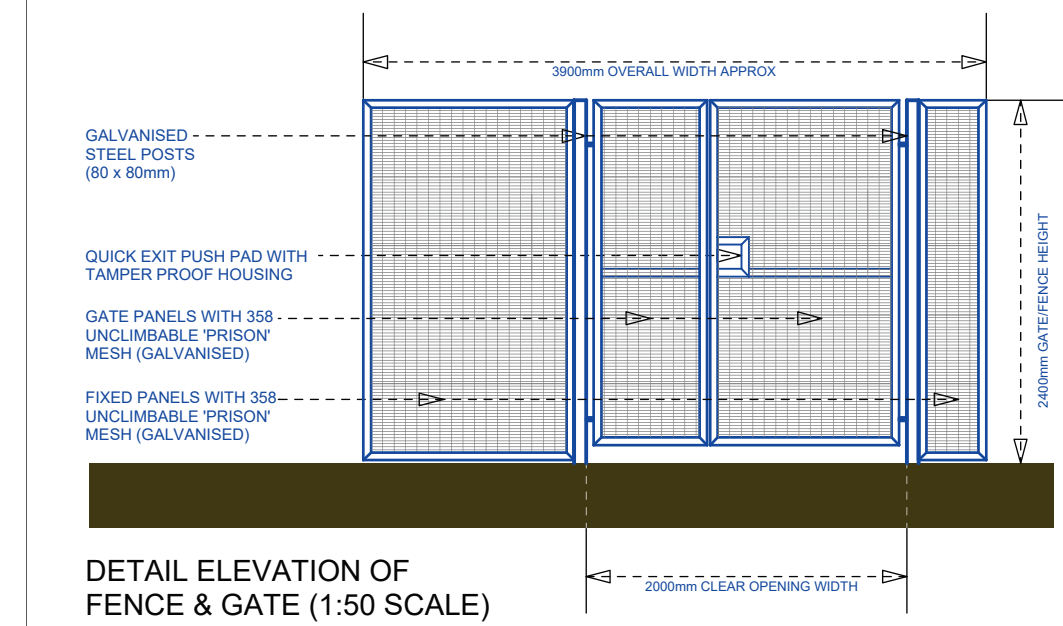

UNCLIMBABLE MESH SAMPLE

DRAWING UPDATED TO AS-BUILT SHOWING REVISED DETAIL TO CANOPY AND GATE AS INSTALLED

NOV 2022 DL AS

REV | DATE | DRN | CHKD

PROJECT

Installation of Heat Rejection Units at the National Football Museum (Urbis), Manchester City Centre

CLIENT

Conlon Construction

DRAWING

Proposed Plan & Elevation to Todd Street Indicating Proposed Gate/Fence

SCALE 1:150 / 1:50

SHEET SIZE @A1

DRAWN DL

CHECKED AS

DATE 11.03.21

BOWKER SADLERARCHITECTURE

A: Hatherlow House, Hatherlow, Romiley, Stockport SK6 3DY

T: 0161 406 7333

E: office@bowker-sadler.co.uk

W: www.bowker-sadler.co.uk

JOB No 21-023

DRAWING No 1006

REVISION A

STATUS As-Built