

PROJECT REF

21067

DRAWING REF

601

SCALE

1:5 @ A1

DATE

JAN '22

CLIENT

MR DANIELS
LAND ADJACENT No.20
CHORLTON VILLAS
HARDY LANE
CHORLTON
M21 8DN


PROJECT

NEW BUILD DETACHED DWELLING
& ASSOCIATED LANDSCAPING


DRAWING TITLE

BAT BOX ELEVATIONS


AS BUILT

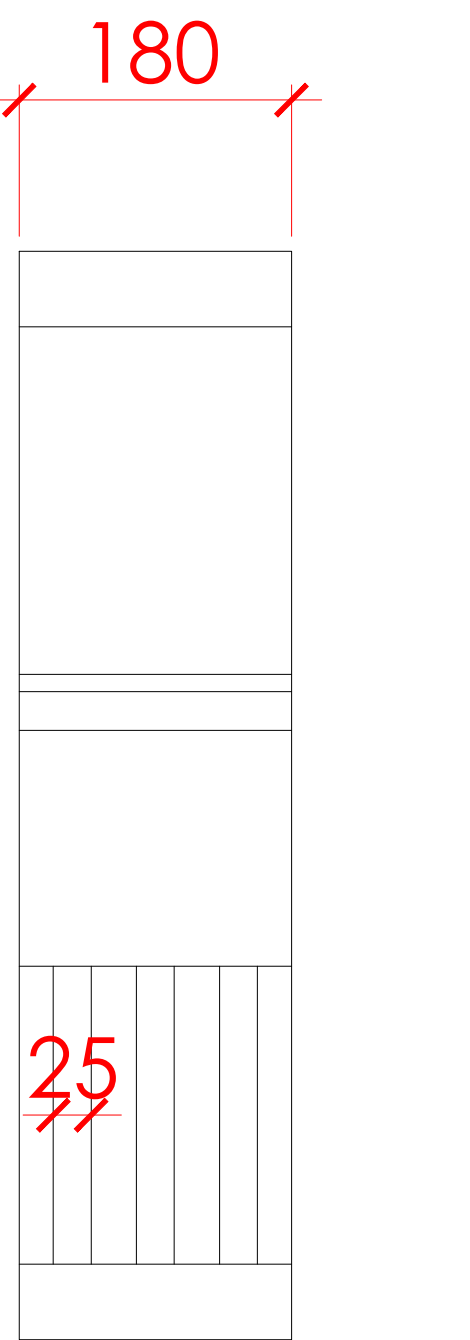


FRONT ELEVATION

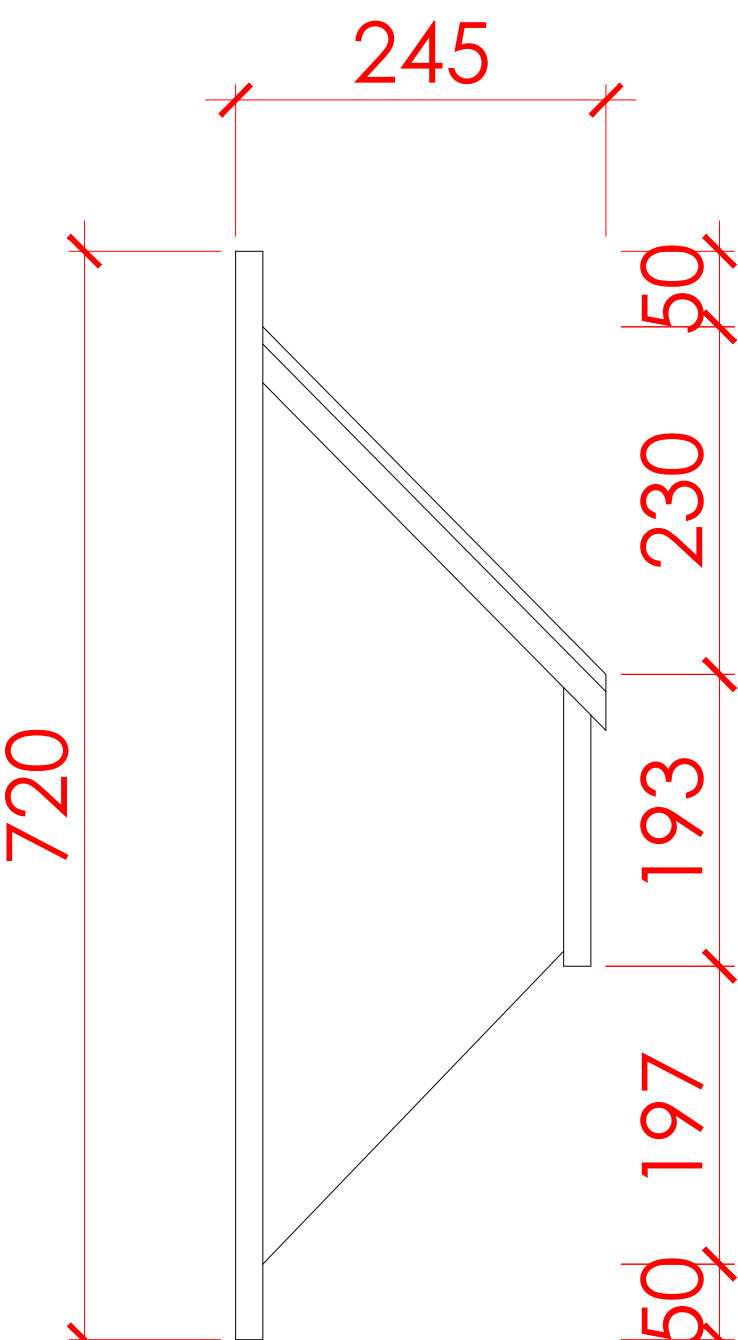

SIDE ELEVATION

 


REAR ELEVATION

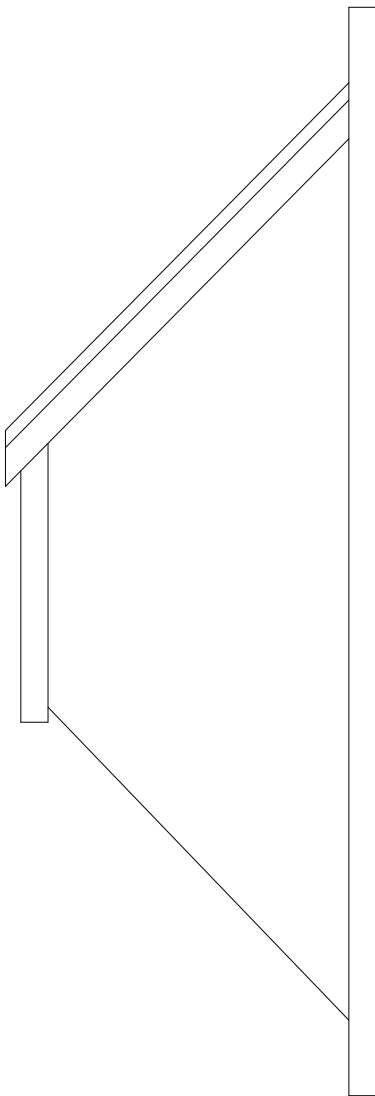

SIDE ELEVATION

ISSUED FOR INFO

03.11.22

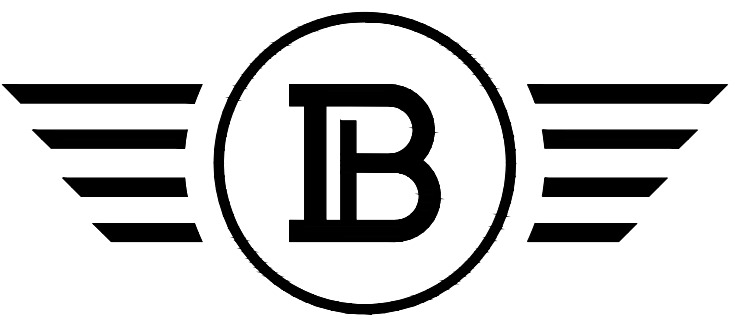

BLUECHIP ARCHITECTS

07999 294 675

DESIGN@BLUECHIP-ARCHITECTURE.CO.UK
WWW.BLUECHIP-ARCHITECTURE.CO.UK

LOWRY MILL | LEES ST. | SWINTON | MANCHESTER | M27 6DB

DO NOT SCALE FROM THIS DRAWING. COPYRIGHT PROTECTED & ISSUED
UNDER LICENCE TO THE CLIENT NAMED BELOW. ALL INFORMATION
CONTAINED WITHIN IS NON-TRANSFERABLE WITHOUT APPROVAL FROM
BLUECHIP ARCHITECTS LTD