




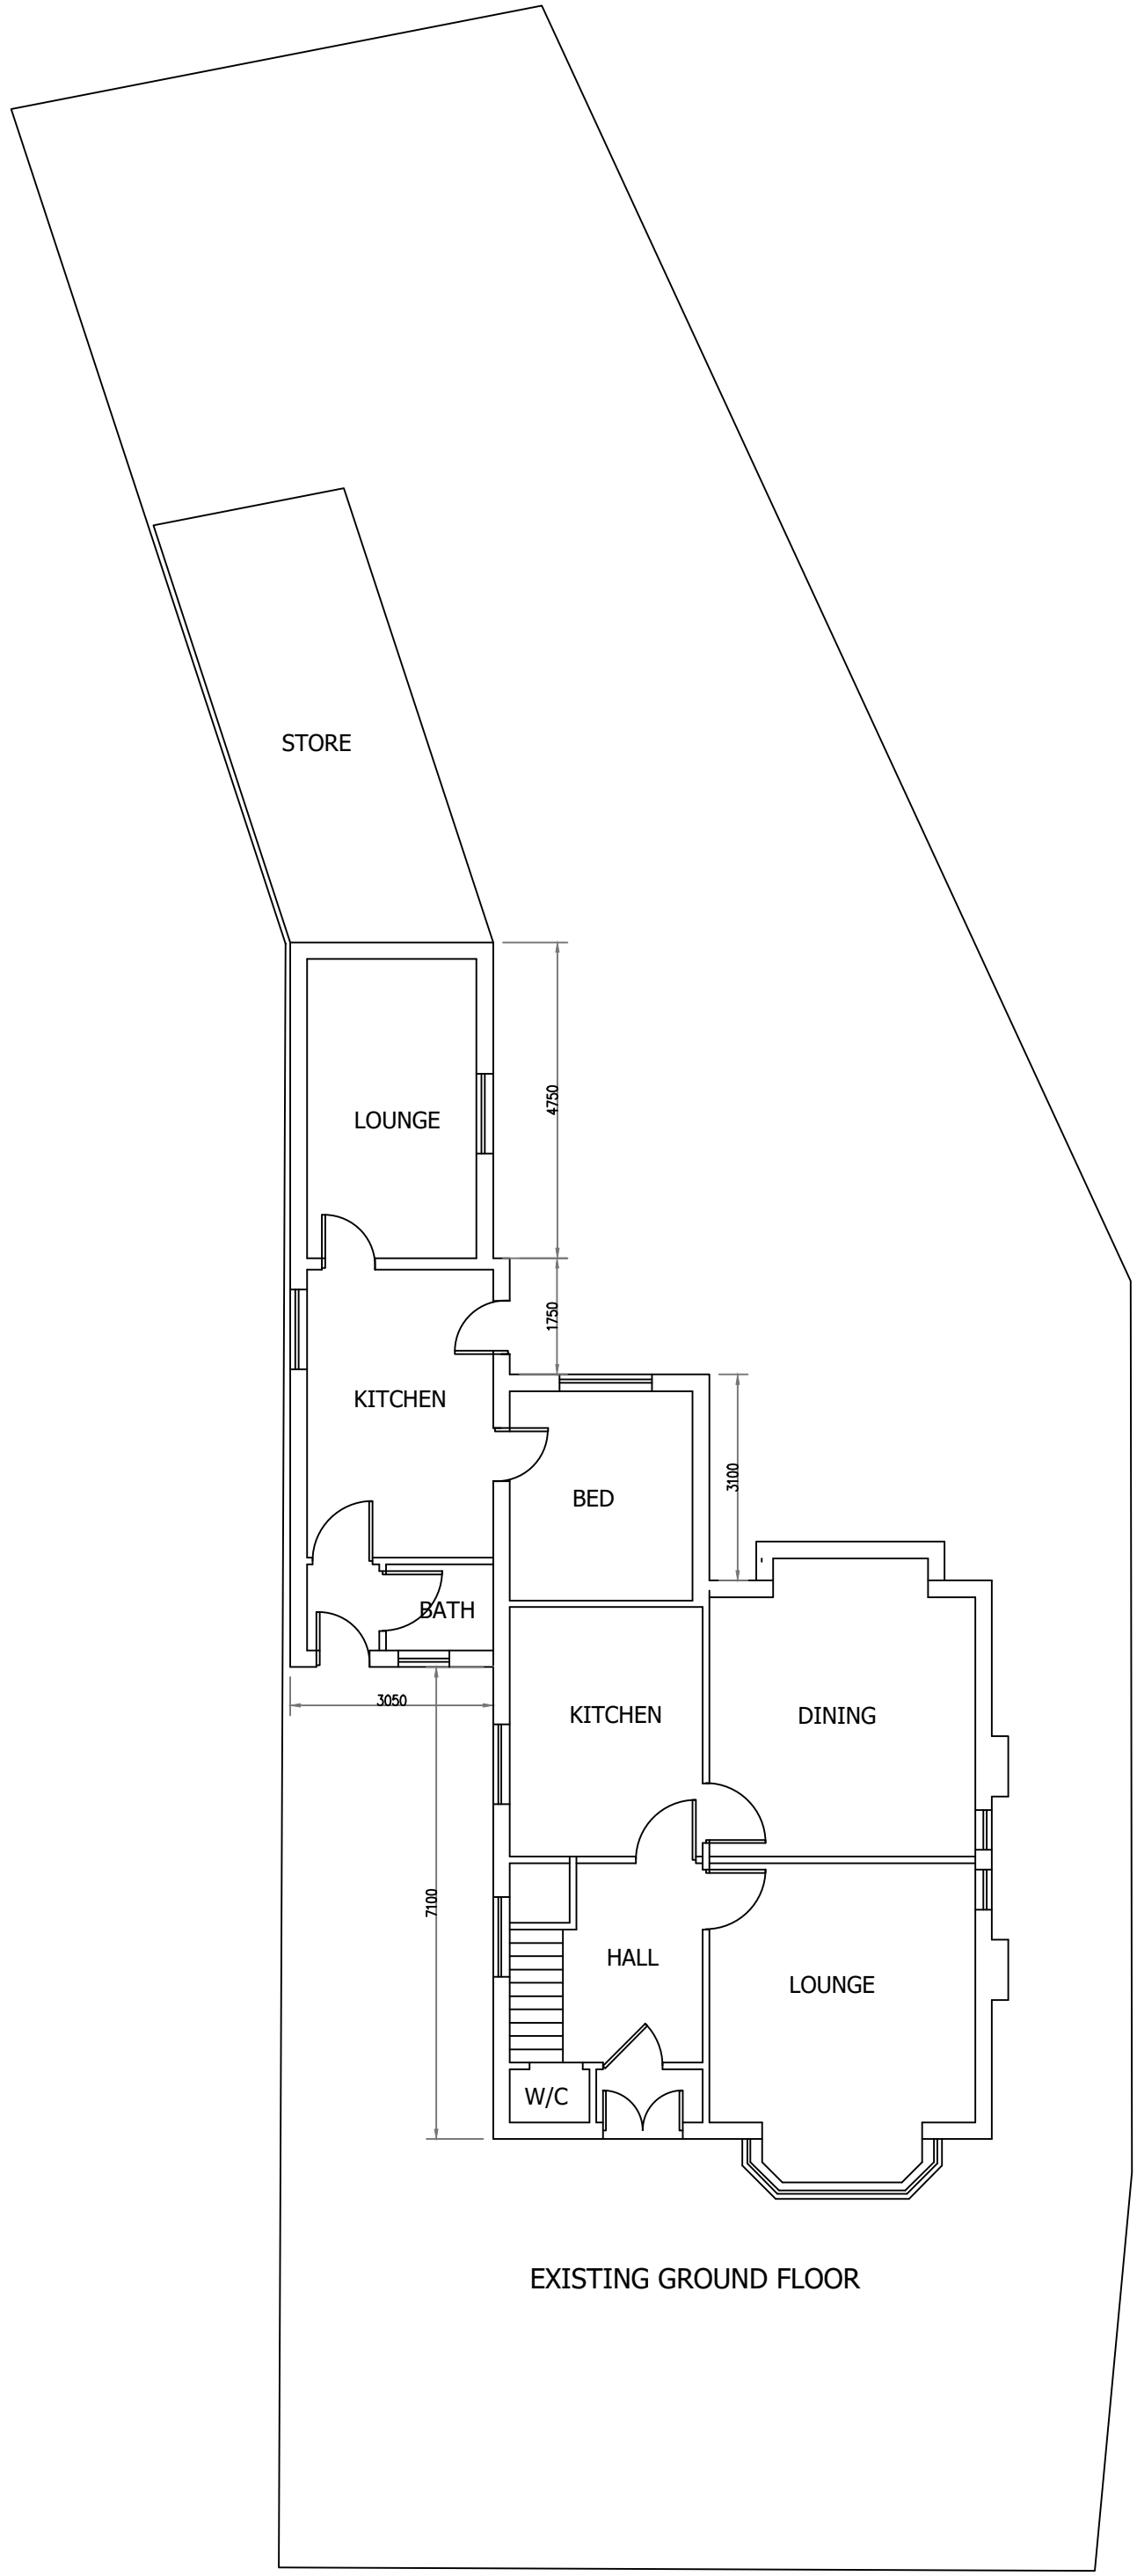


EXISTING GROUND FLOOR

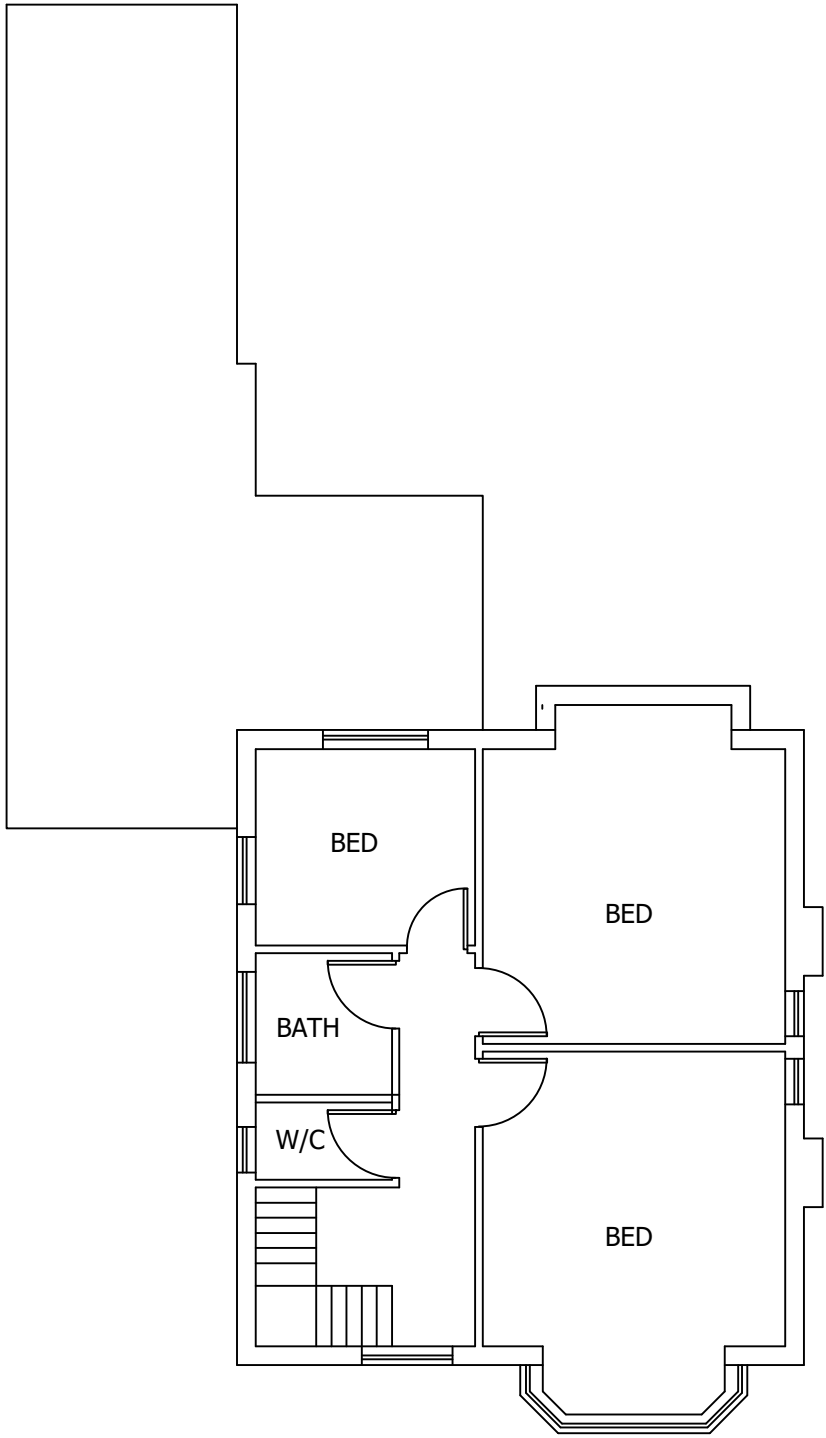


EXISTING FIRST FLOOR

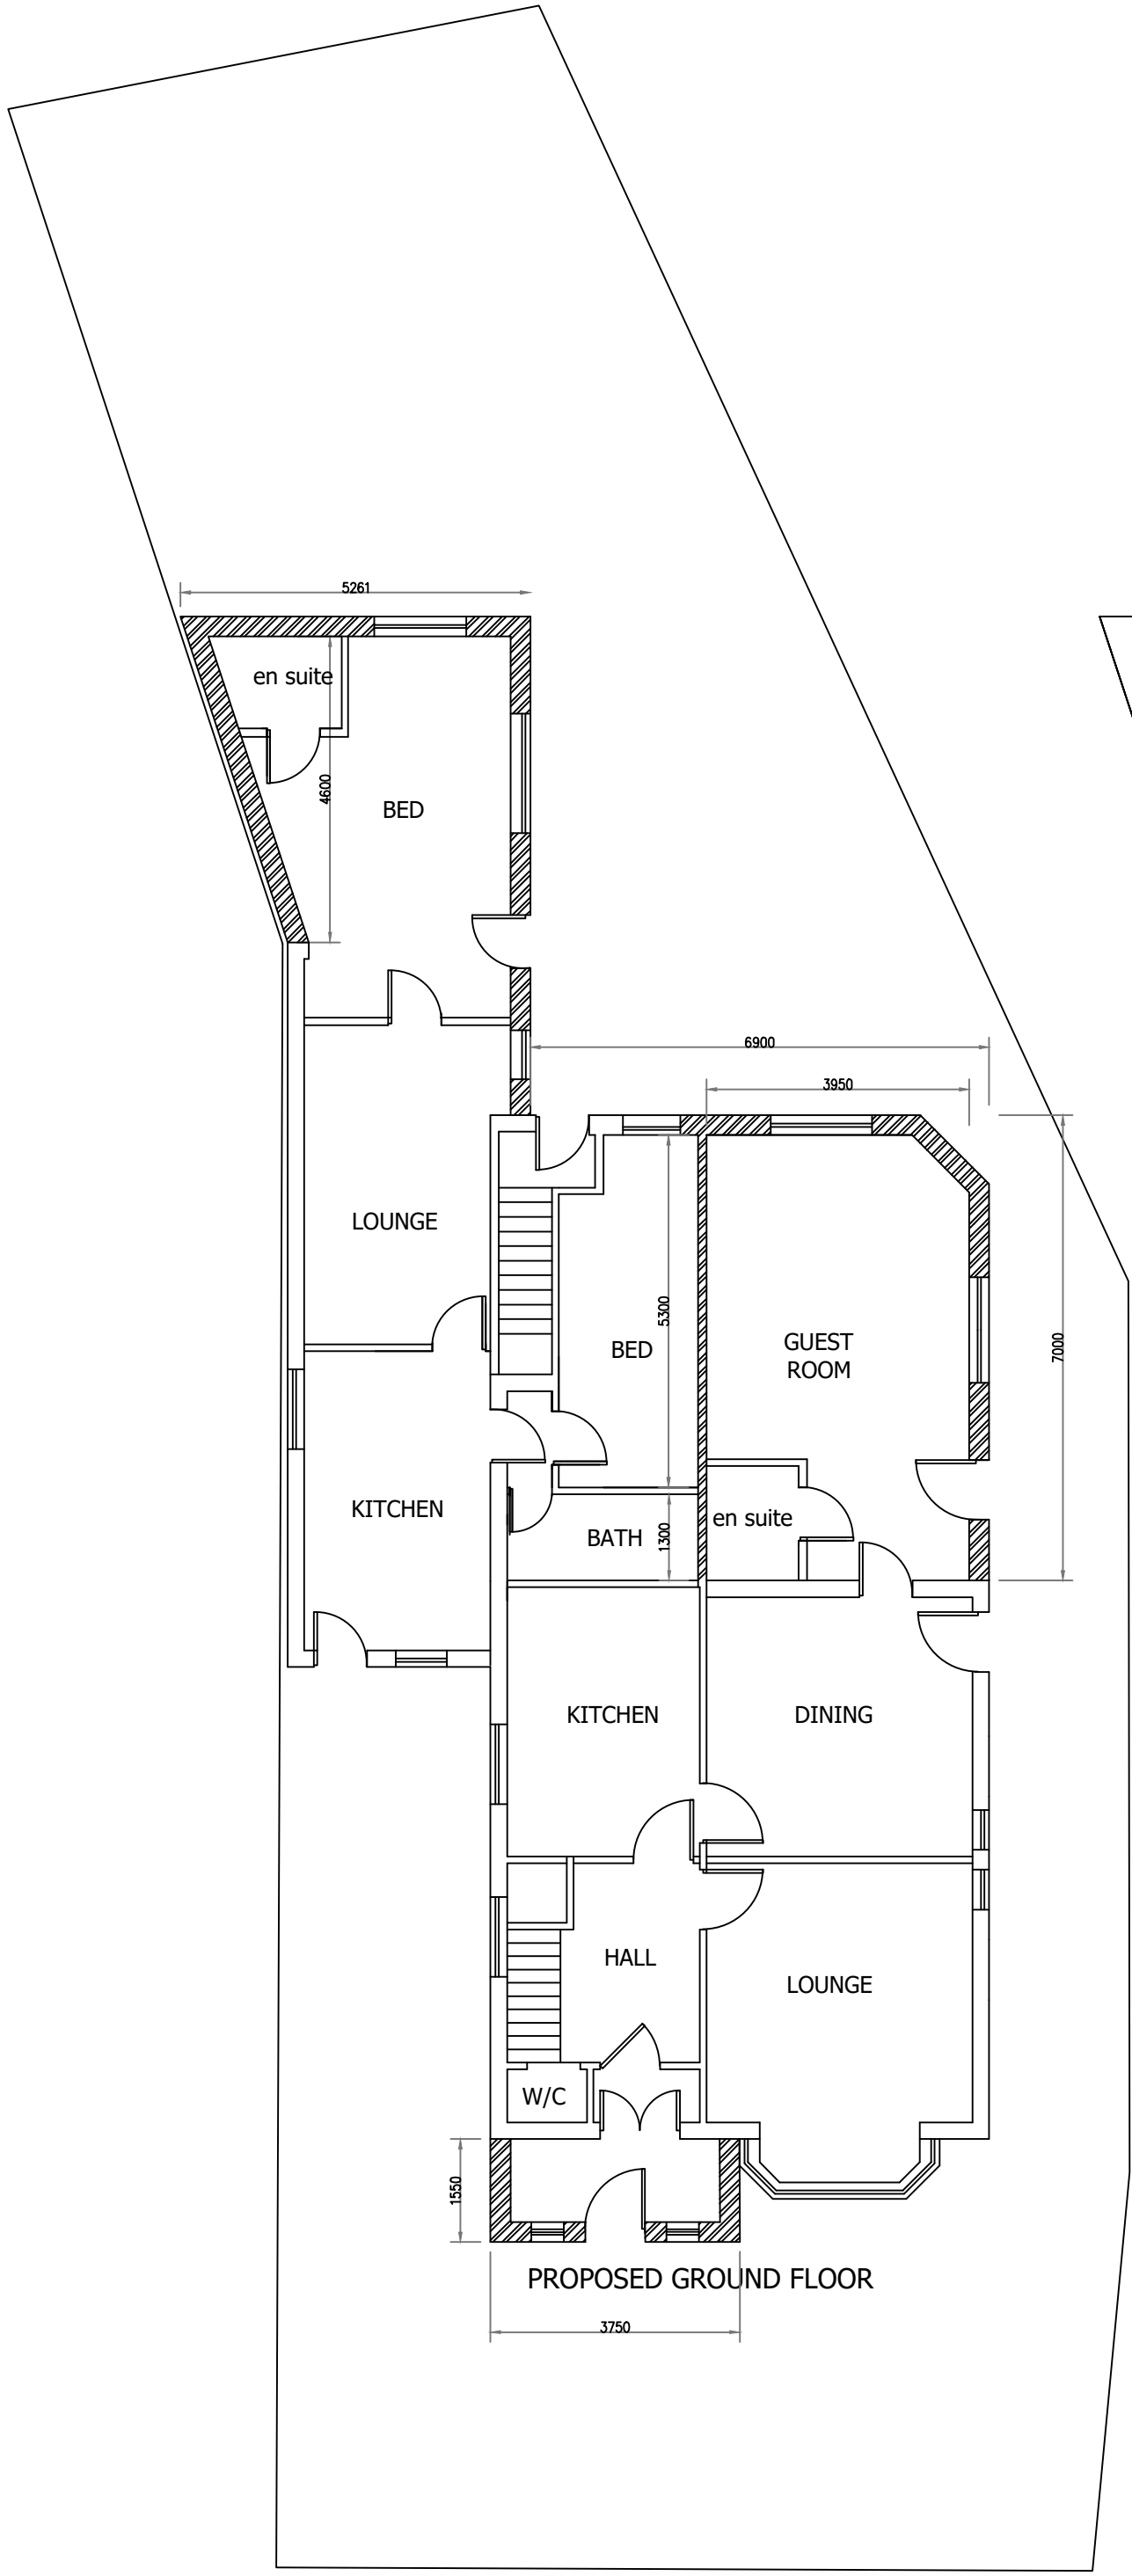

PROPOSED GROUND FLOOR

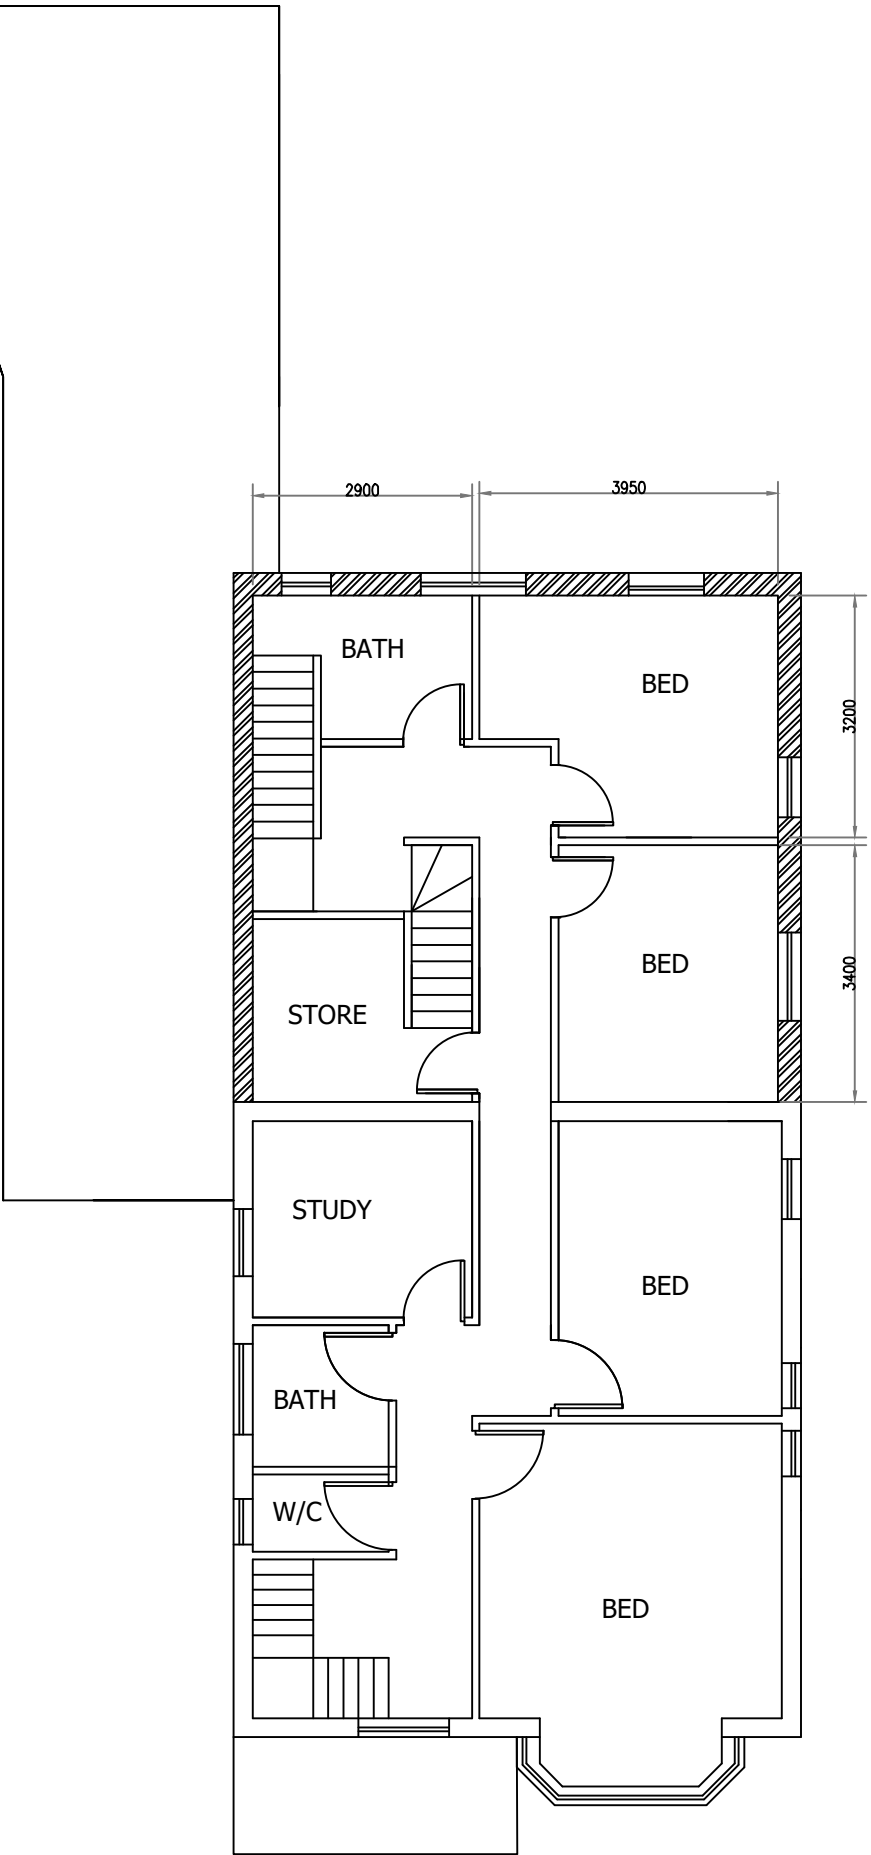

PROPOSED FIRST FLOOR

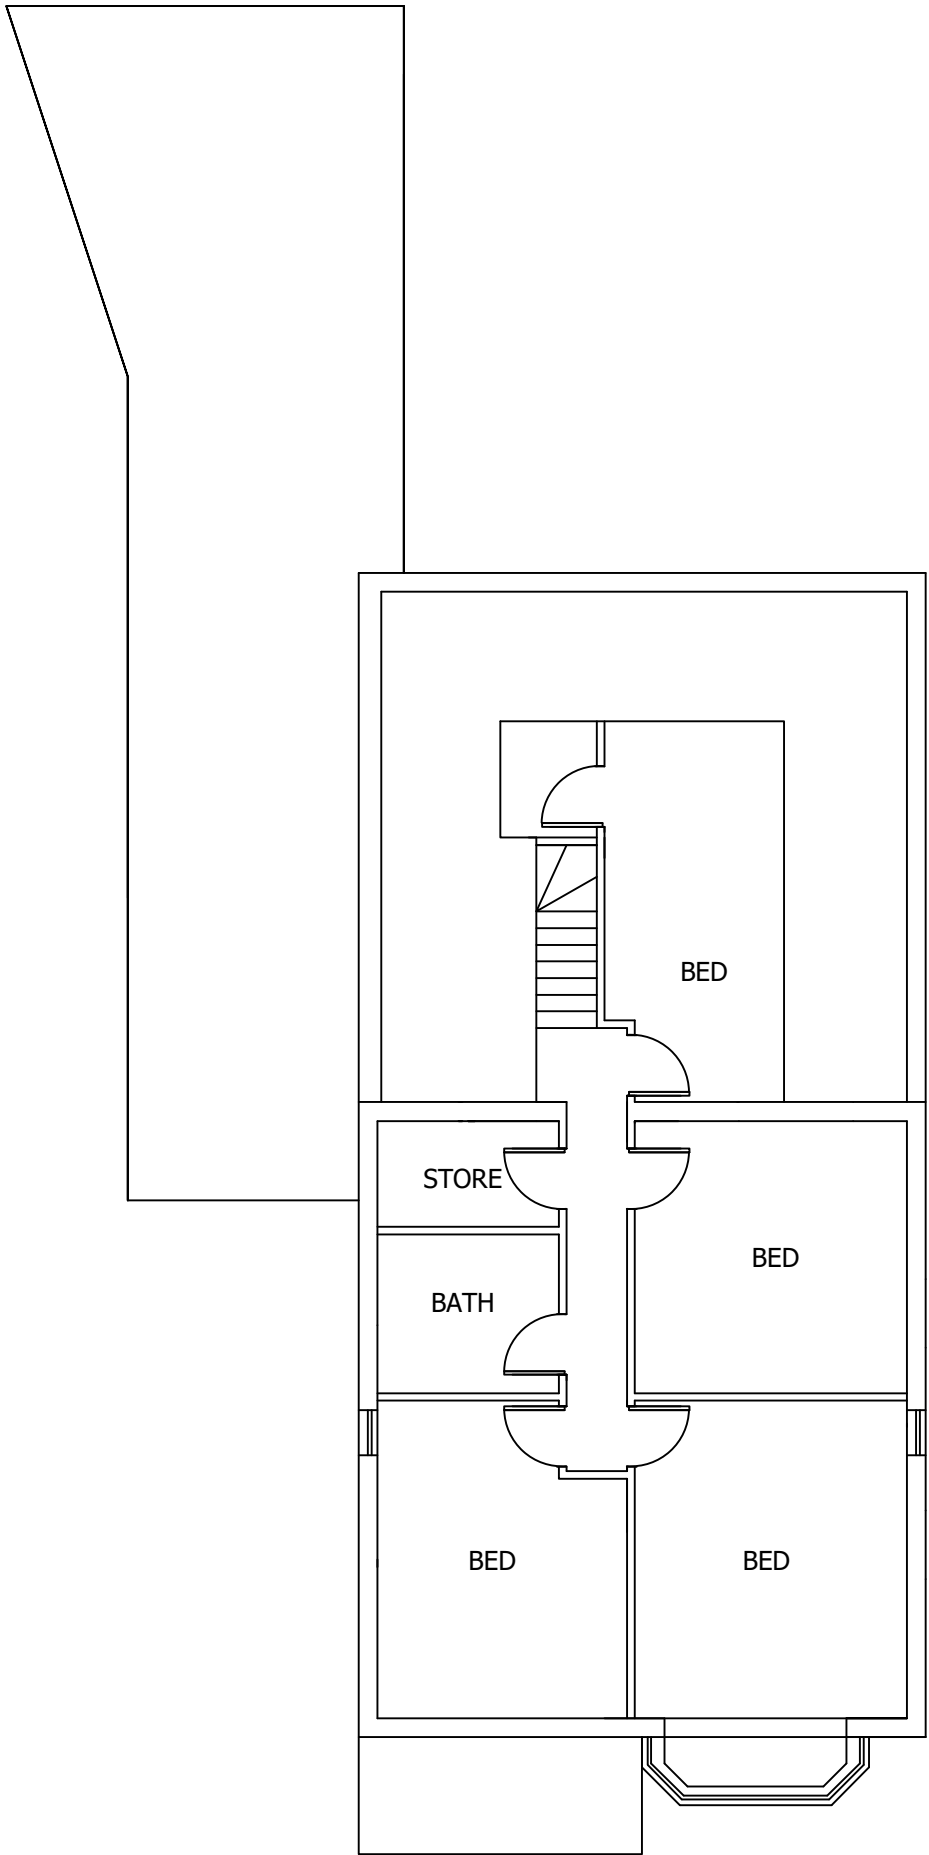

PROPOSED SECOND FLOOR

Date	Rev.		Initials	
11/11/21	A.	Amended first and second floor plans	RA	
13/10/22	B.	Amended first and second floor plans	RA	
3/11/22	C.	As built plans	RA	

This drawing is subject to copyright and is not to be reproduced in part or whole without approval.
Figured dimensions take precedence over scaled measurements from the drawing. All dimensions and drawings to be checked by Client and Contractor and discrepancies clarified with the Client prior to commencement.
The whole of the works to comply with Planning Approval & Conditions and current Building Regulations. No work to commence without Planning & Building Regulations approval.
The client must ensure the project complies with the Construction Design and Management Regulations 2015
The Client should ensure consent from any landowner or interested party is obtained, as well as compliance with Party Wall Act 1996

Notes

RAD

The White House,
42-44 Chorley New Road,
Bolton
BL1 4AP
Tel : 01204 322196
Fax : 01204 214110
Mob: 07790 361104
Email: rahatanwar@hotmail.com

Project
142 MANCHESTER ROAD,
CHORLTON
MANCHESTER
M16 0DZ

Title
EXISTING & PROPOSED FLOOR PLANS

Client

Drawn
RA

Date
OCTOBER 2021

Scale
1:100 @ A1 / 1:200 @ A3

Drawing Number
RAD/2513/21/2/RevC