
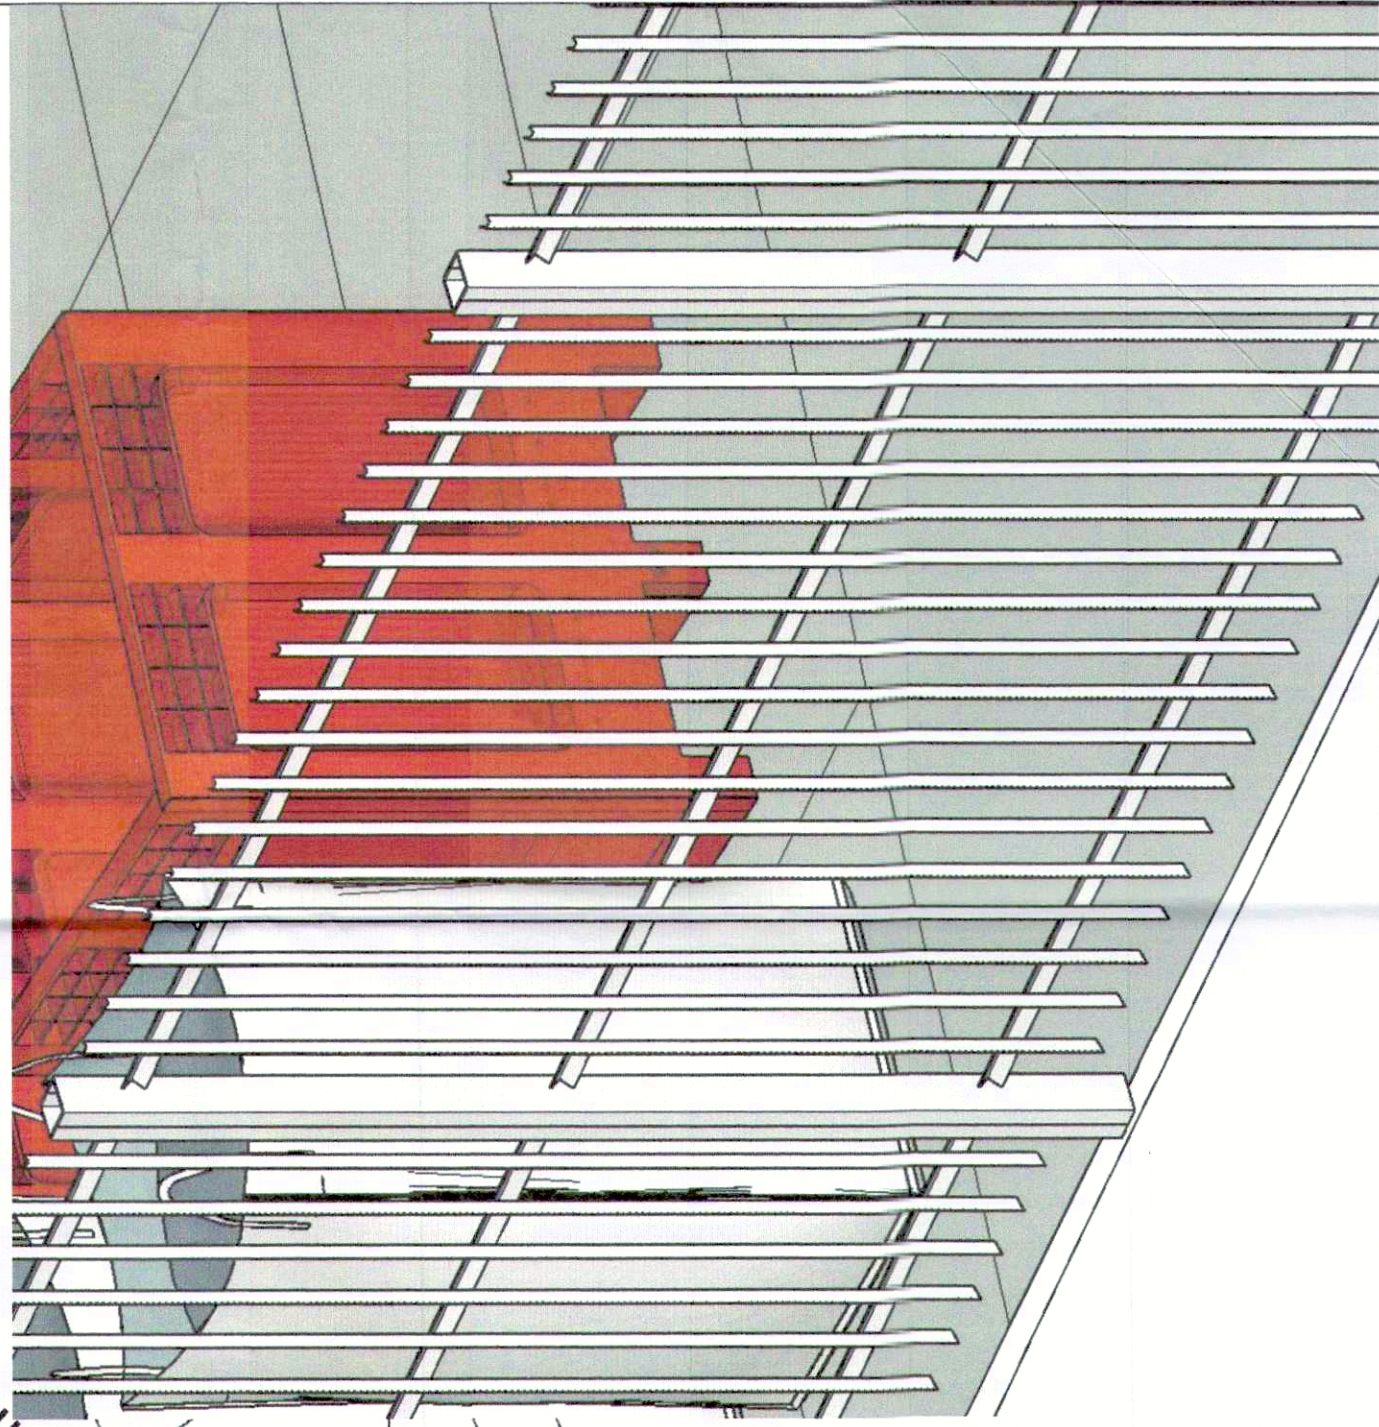


New site

Landlord permission granted to extend fence boundary straight across Cornbrook at this location, in place of parallel to Corn Brook

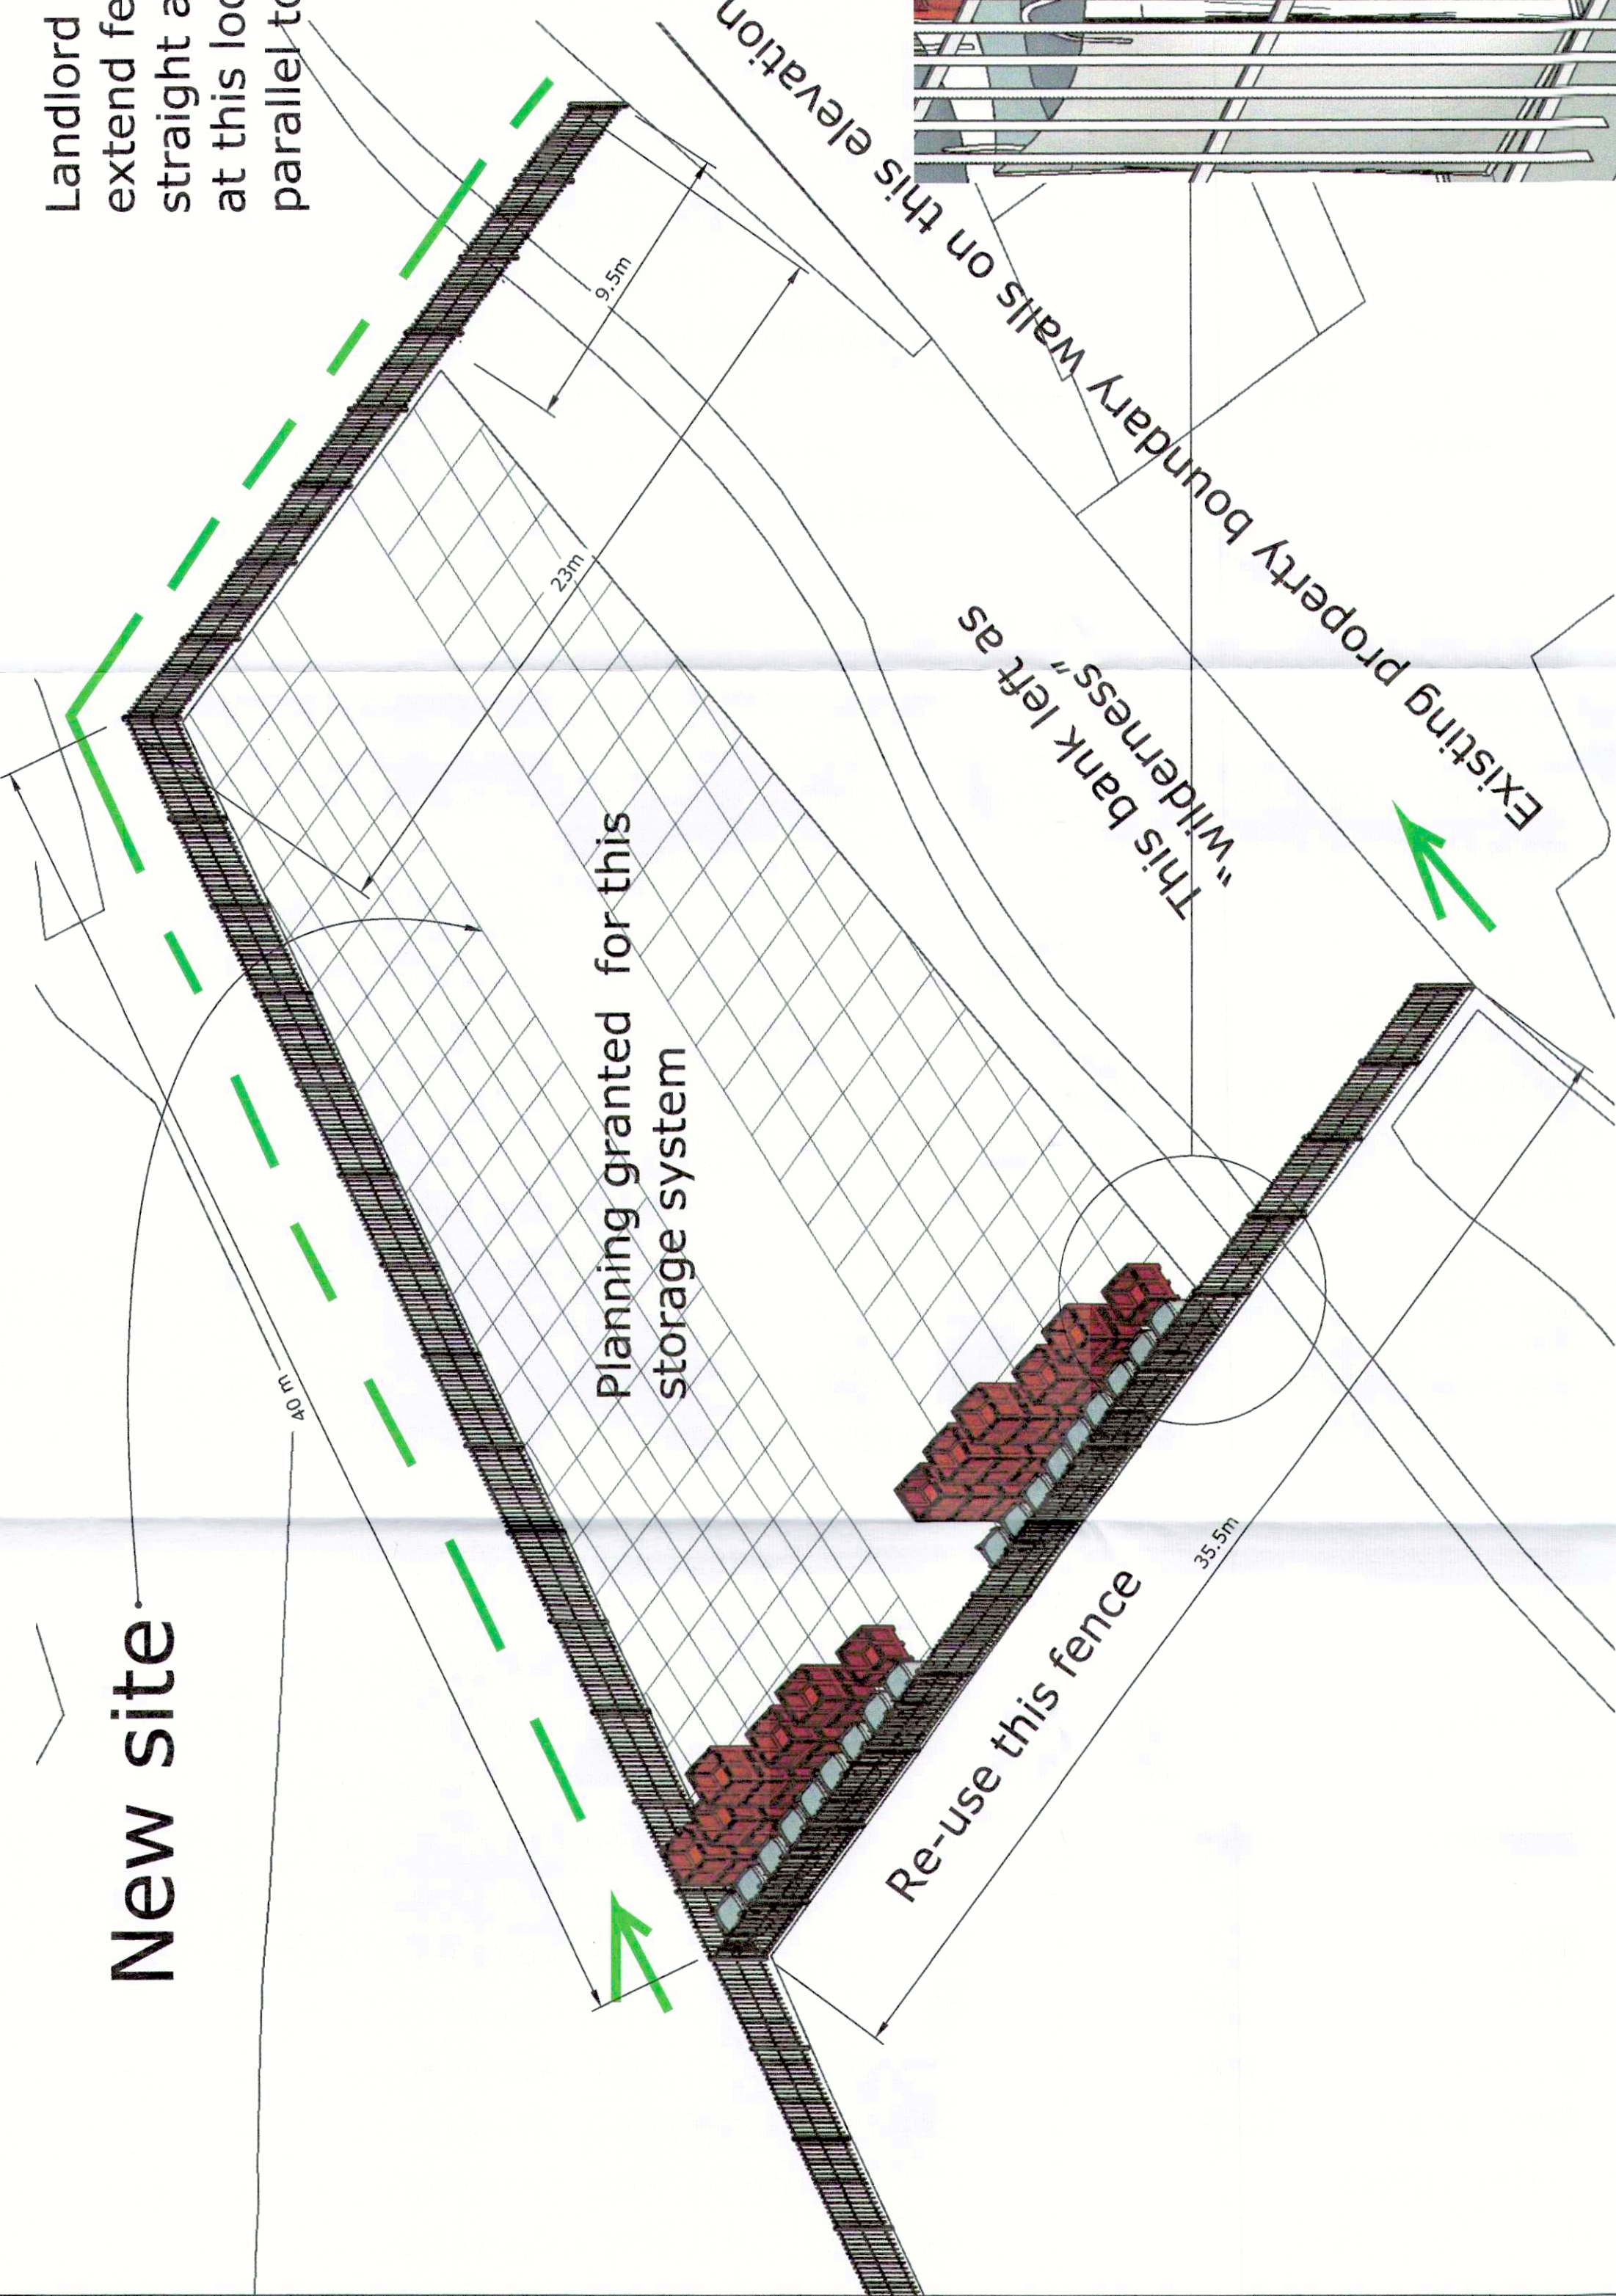

Existing Palisade system

PLANNING AND
BUILDING CONTROL
18 OCT 2022

This drawing represents the design and function of the equipment depicted. The final product may vary in precise detail subject to suitability of component manufacture. Structural performance is not warranted, such information is available by separate warrant only where requested in writing from us and may be subject to charges. We take no responsibility for existing structures, patent infringements or design variations. We reserve the right to modify or change any features which do not fit with our final build programs as we see fit in the reasonable pursuit of best engineering practices and safe design without notice.	REVISIONS	REMARKS		2	 ENGINEERED SOLUTIONS HANDLING & STORAGE PROBLEMS SOLVED	© MXXII IP	Scale	As stated	Status						
		Title							Adjusted fence boundary	Design	☐	Production	☐	Other	☐
		Drg No.							010622.1	Estimating	☐	As Built	☐	PRC	☐
		Issue No.							A	Approval	☐	Records	☐	28.07.22	☐
PROPERTY OF ENGINEERED SOLUTIONS (PROJECTS) LTD.		Date		Other		Date									
This drawing represents the design and function of the equipment depicted. The final product may vary in precise detail subject to suitability of component manufacture. Structural performance is not warranted, such information is available by separate warrant only where requested in writing from us and may be subject to charges. We take no responsibility for existing structures, patent infringements or design variations. We reserve the right to modify or change any features which do not fit with our final build programs as we see fit in the reasonable pursuit of best engineering practices and safe design without notice.		28.07.22		PRC		28.07.22									