

General Notes
The Architect shall have no responsibility for any use made of this document other than for that which it was prepared and issued.
All dimensions should be checked on site. Do not scale from this drawing. To be read in conjunction with all other Consultant's drawings. The Architect to be immediately notified of any discrepancies.

Copyright on this drawing retained by the Architect.

LEGEND

 Approved Application: 120891/FO/2018

C	24/10/22	AK	SH	Added Flat Canopy	
B	03/08/21	SA	SH	Added Drainage	
A	17/05/21	SA	SH	Amended Roof Height	
-	09/04/21	SA	SH	Initial Issue	
No.	Date	Dwn	Chk	App	Revision or reason for issue

Client

R&S Builders

createit studios
Architects & Designers

Create It Studios (NW) Ltd
Universal Square
Devonshire Street North
Manchester M12 6JH
0161 974 6165
www.createitstudios.co.uk
info@createitstudios.co.uk

Project Title
492-494 Claremont Road,
Manchester M14 5WA


Scale / North Point
1 : 100

Drawing Title
As-built Elevations - Plot 1&2

Drawing Number A1344(02)004	Revision C
Drawing Status Preliminary	




1 As-built Front Elevation
1 : 100

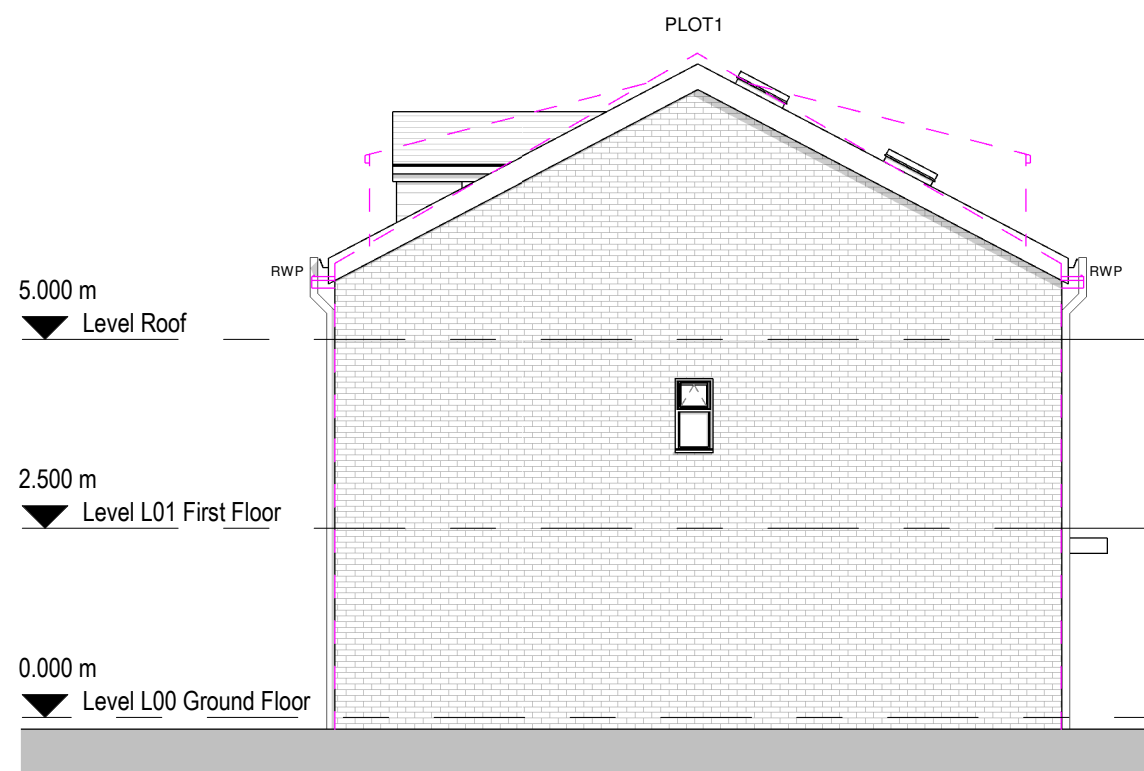

2 As-built Side01 Elevation
1 : 100



3 As-built Rear Elevation
1 : 100

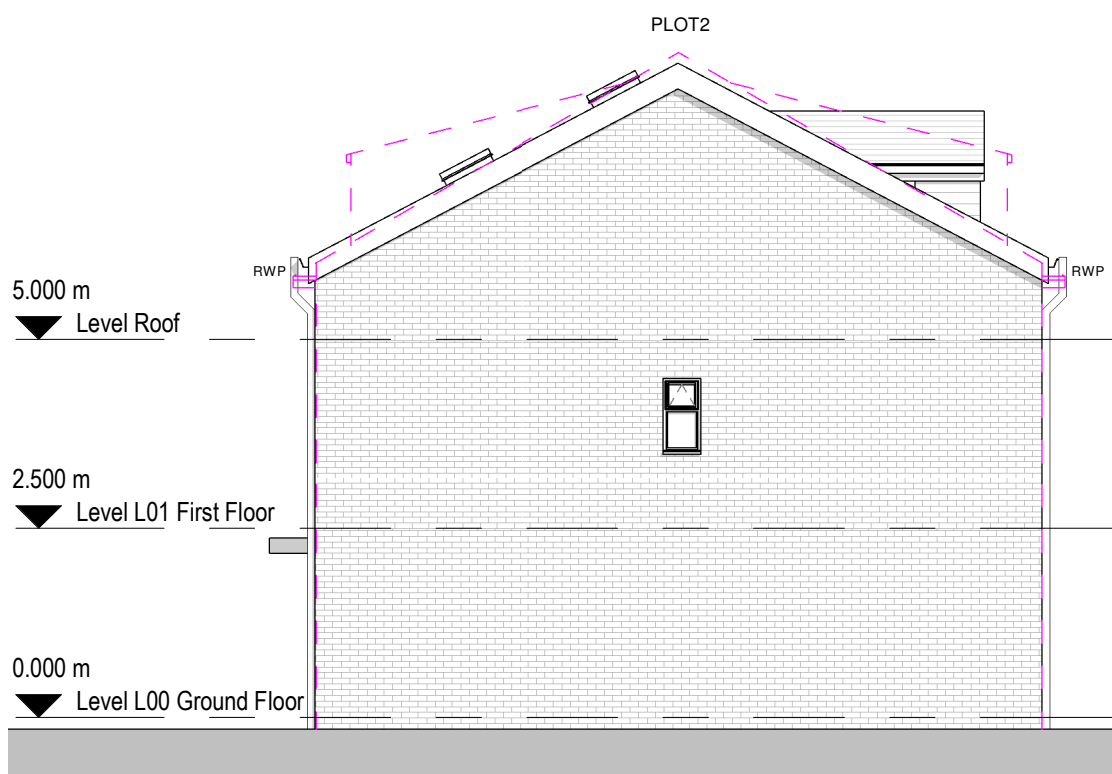

4 As-built Side02 Elevation
1 : 100

0 1 2 3 4m
1:100