



430 Levenshulme

ARCHITECTURAL EMPORIUM Ltd
EMAIL: mail@architectural-emporium.co.uk
WEB: www.architectural-emporium.co.uk
ADDRESS: 13 Hope St, Liverpool, L1 9BQ
PHONE: +44 (0)151 363 0000

0 0.5 1 2 5

- North Point

- Application Site Edge in red

Mature trees to site boundary.

Redline indicates size & Width of previously submitted design.

New slate roof to house.

Conservation Rooflight

Mature trees to site boundary.

Redline indicates size & Width of previously submitted design.

Rev B: 23.03.21

Exsiting two storey extension to be reduced in size as indocated.

FOR: APPROVAL

CHECKED BY: AJ | DRAWN BY: AK

SCALE: 1:100


PAPER SIZE: A3

JOB: 430 Levenshulme


2.101_Rev B

FIRST ISSUE: 07.10.20

PROPOSED PLANS

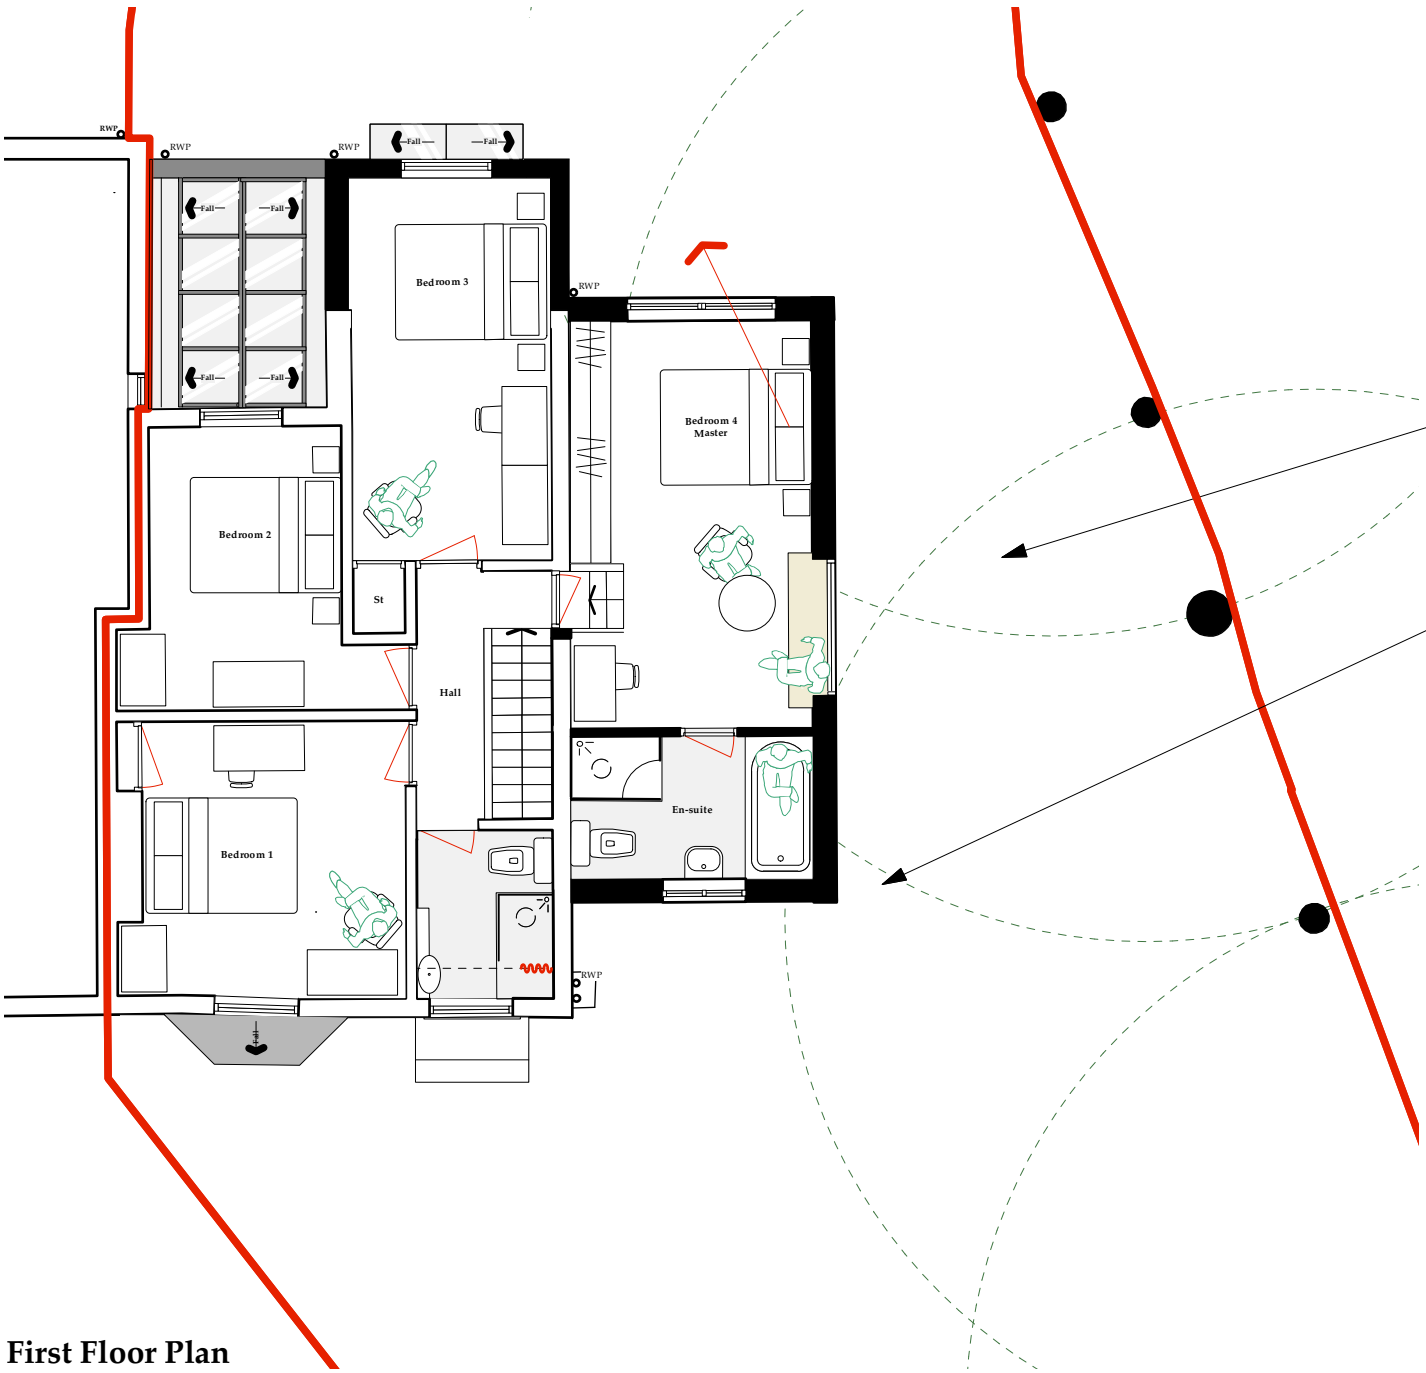

First Floor Plan

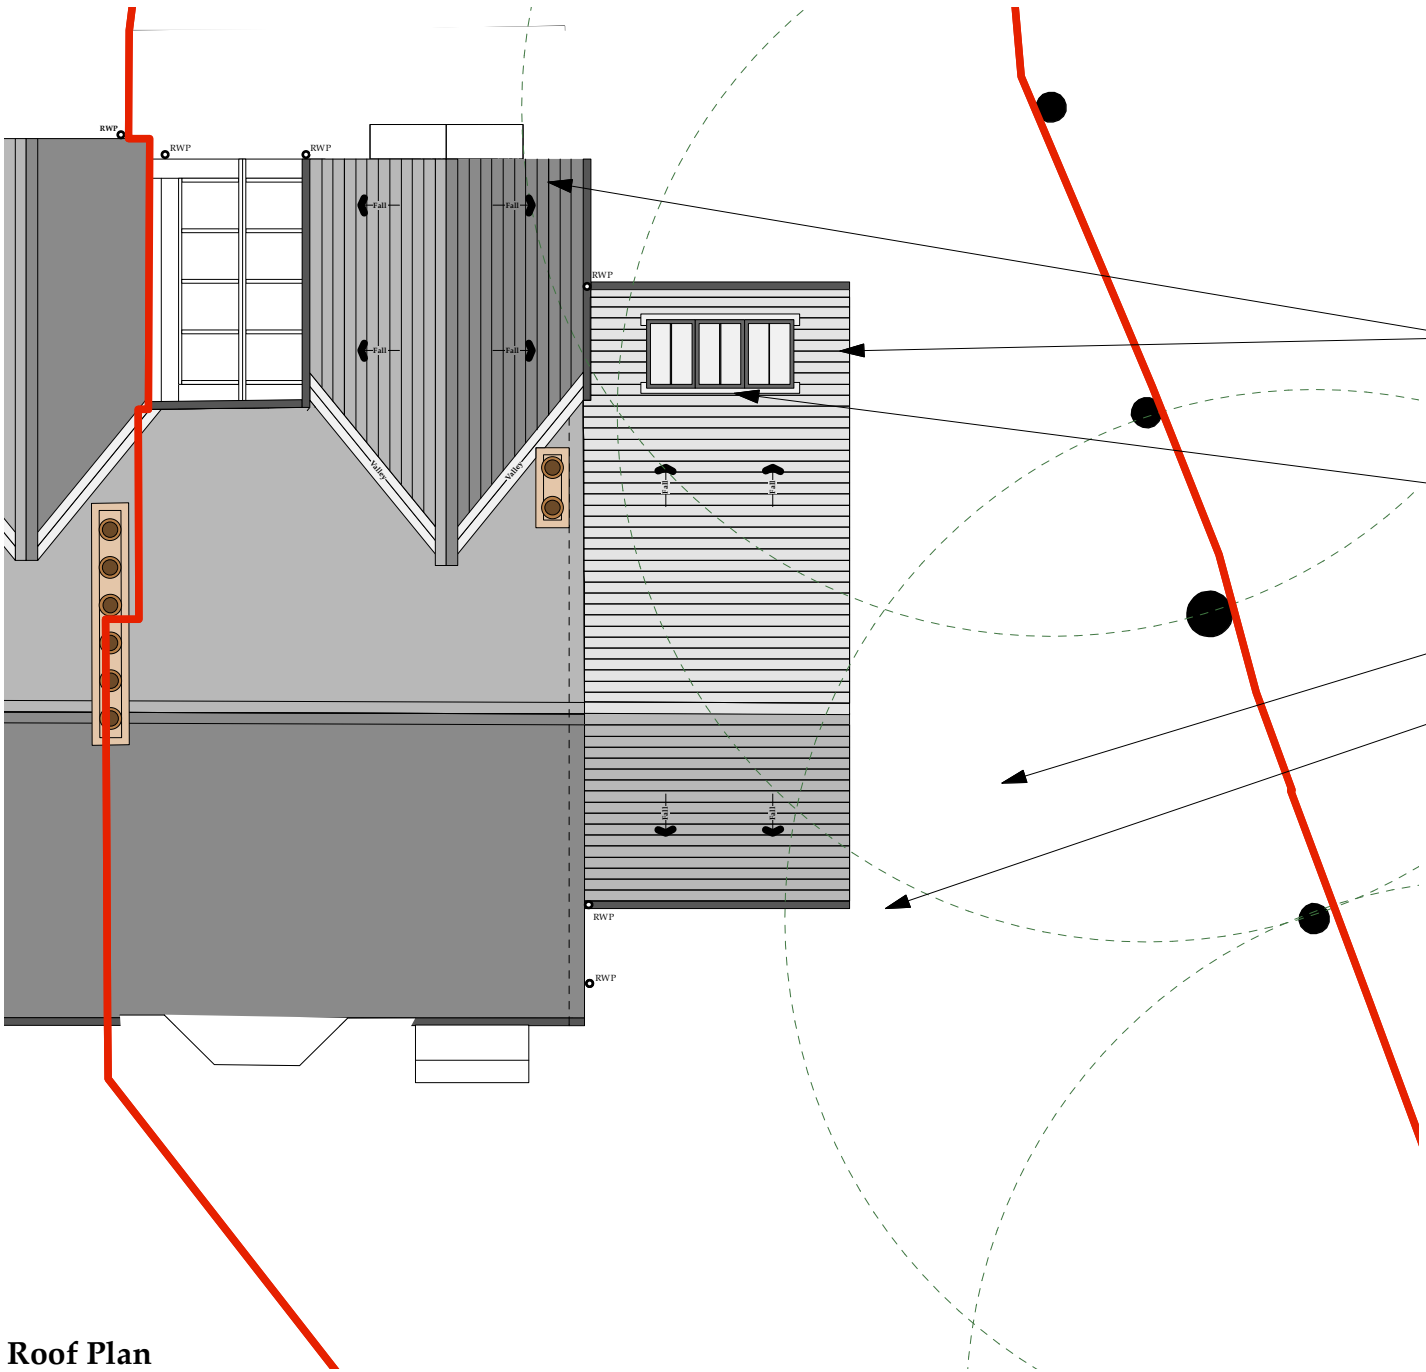

Roof Plan