


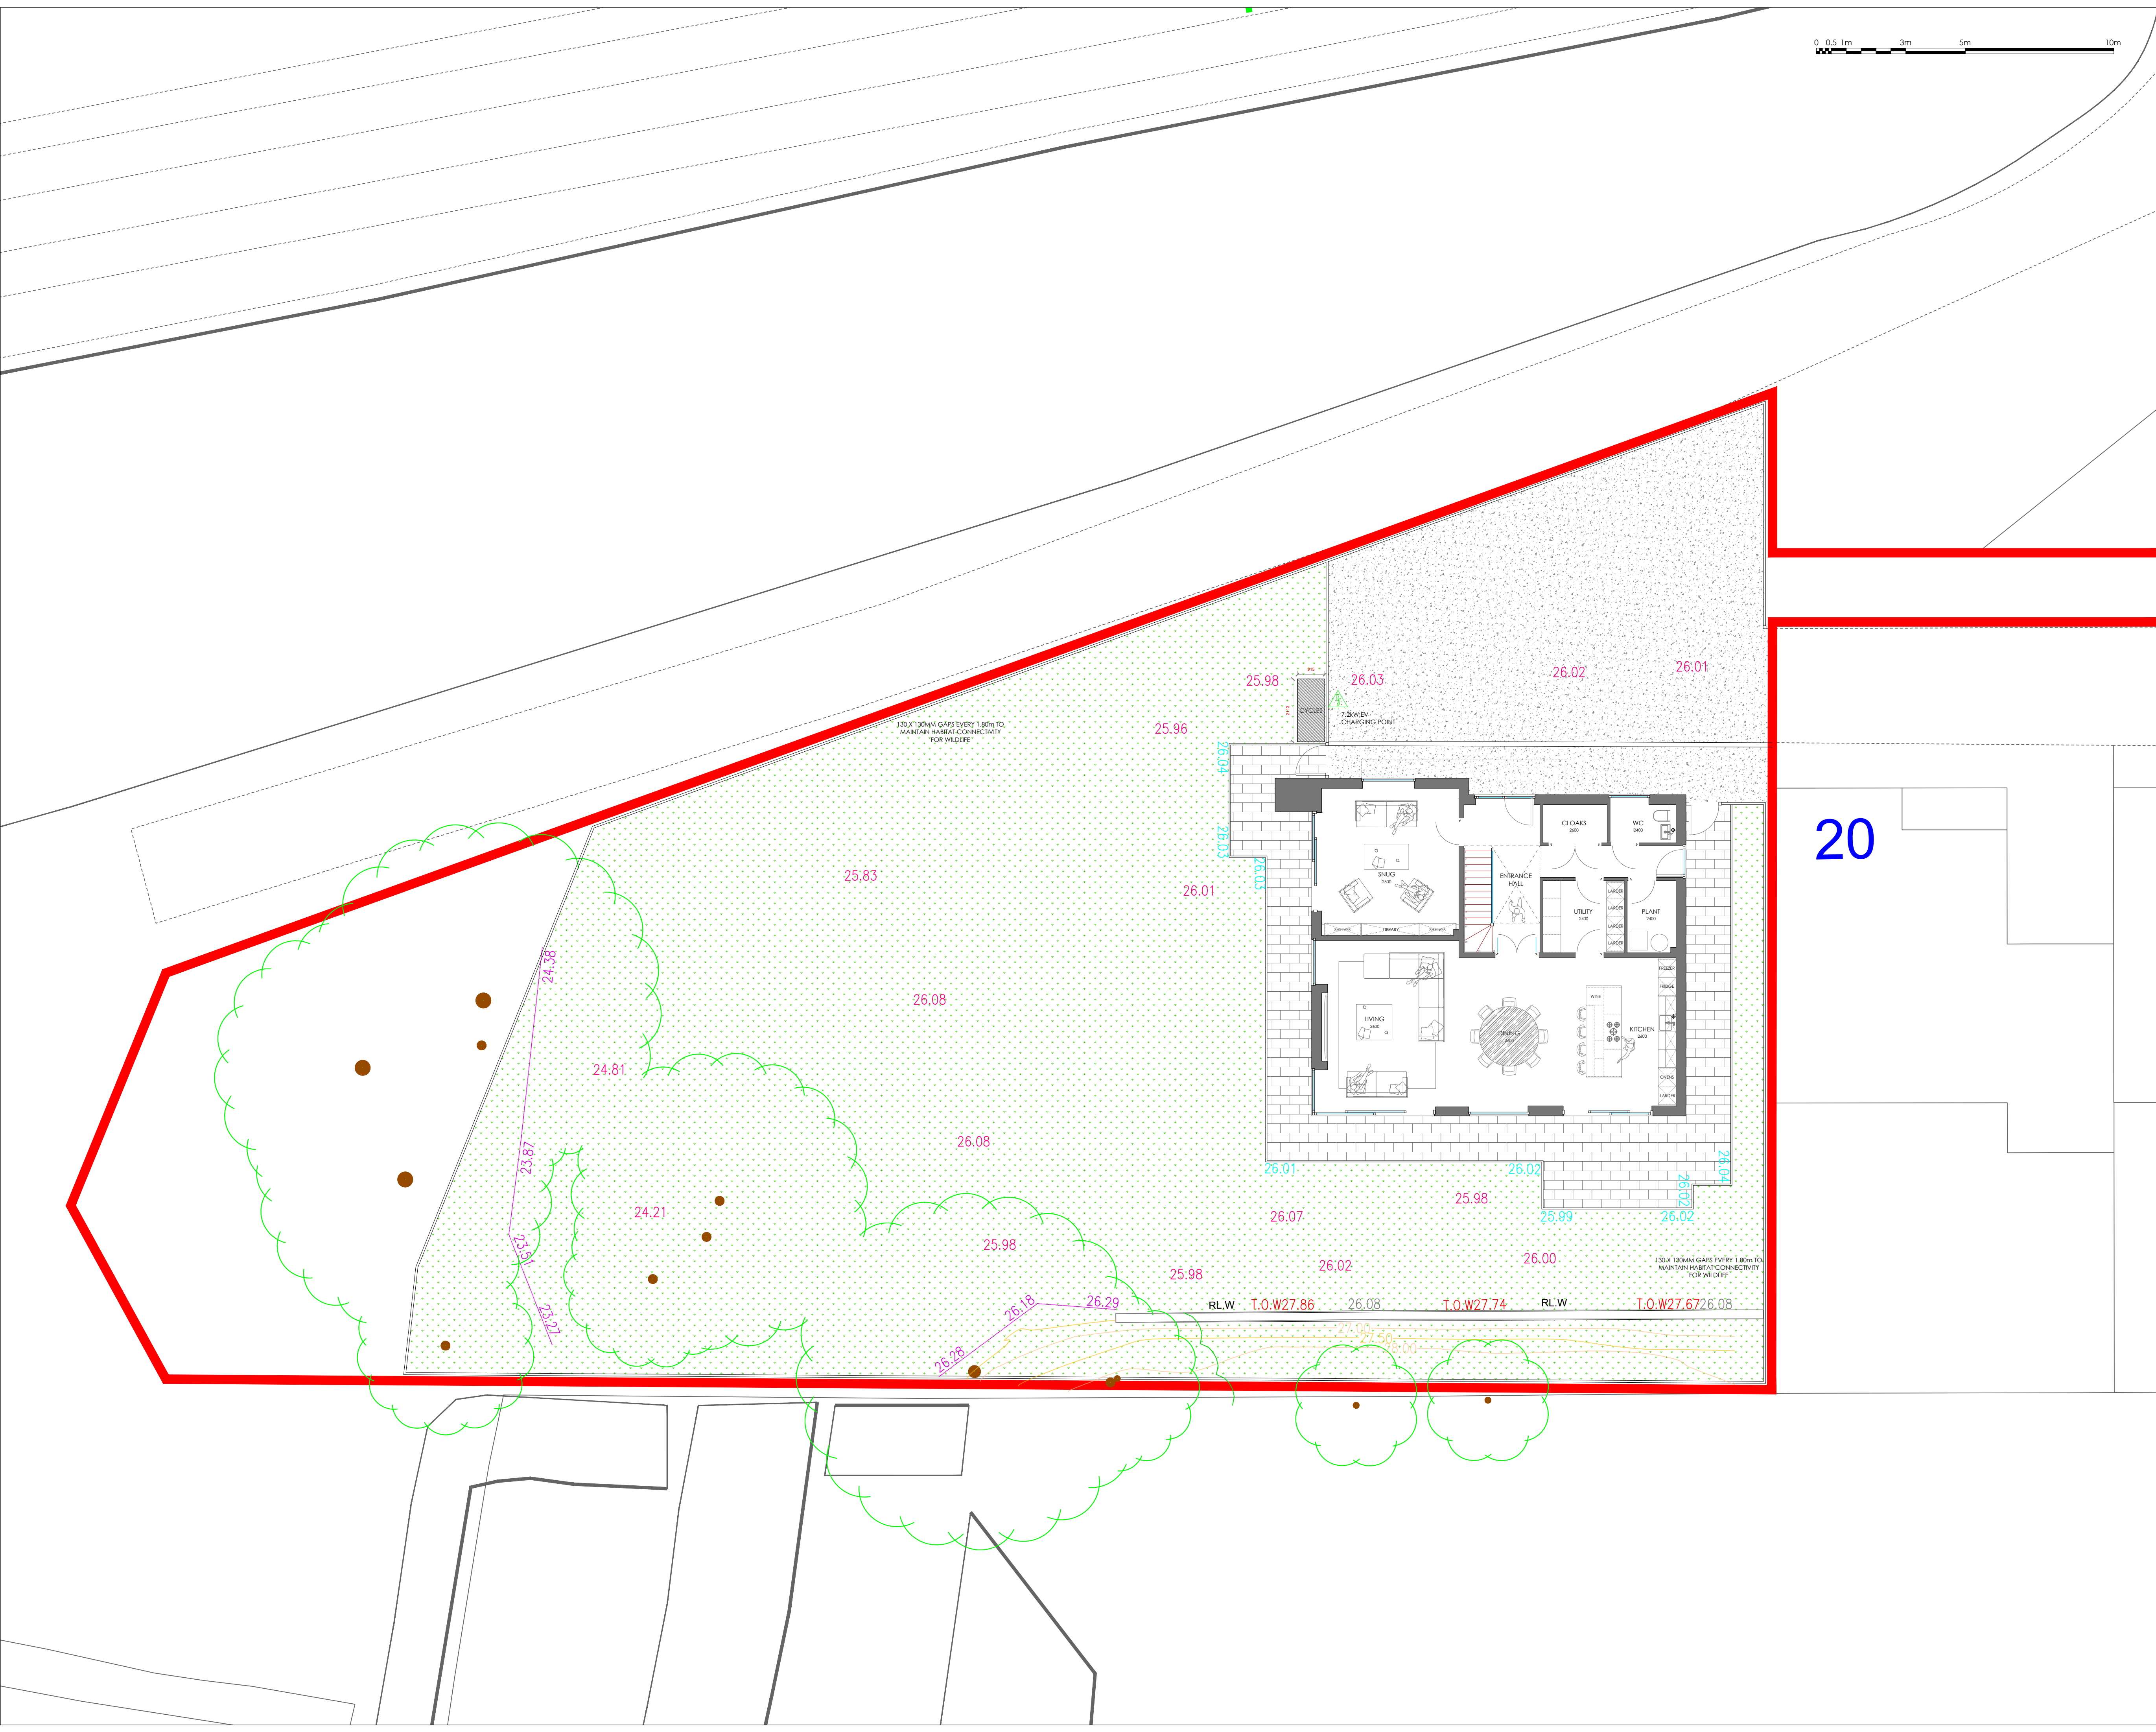

PROJECT REF  
21067

DRAWING REF  
600

SCALE  
1:50 @ A1

DATE  
JAN '22

CLIENT

MR DANIELS  
LAND ADJACENT No.20  
CHORLTON VILLAS  
HARDY LANE  
CHORLTON  
M21 8DN

PROJECT

NEW BUILD DETACHED DWELLING  
& ASSOCIATED LANDSCAPING

DRAWING TITLE

PROPOSED LANDSCAPING PLAN

AS BUILT

NATURAL GRASSED  
LAWN

TOBERMORE TEGULA IN  
SLATE

TARMAC

1.8m BOUNDARY  
FENCING

1.8m TIMBER GATE  
INTERNAL TO SITE

FOREST PENT GARDEN STORE

SAND FELT ROOF COVERING  
DOUBLE LOCKABLE SWING GATE  
CLAD IN CLEAR SEALED PINE  
DIM.: 1830mm (w) x 870mm (d) x 1450mm (h)

ISSUED FOR INFO

03.11.22

BLUECHIP ARCHITECTS

07999 294 675

DESIGN@BLUECHIP-ARCHITECTURE.CO.UK  
WWW.BLUECHIP-ARCHITECTURE.CO.UK

LOWRY MILL | LEES ST. | SWINTON | MANCHESTER | M27 6DB

DO NOT SCALE FROM THIS DRAWING. COPYRIGHT PROTECTED & ISSUED  
UNDER LICENCE TO THE CLIENT NAMED BELOW. ALL INFORMATION  
CONTAINED WITHIN IS NON-TRANSFERABLE WITHOUT APPROVAL FROM  
BLUECHIP ARCHITECTS LTD