




NOTE TO ALL CONTRACTORS: DO NOT SCALE FROM THIS DRAWING

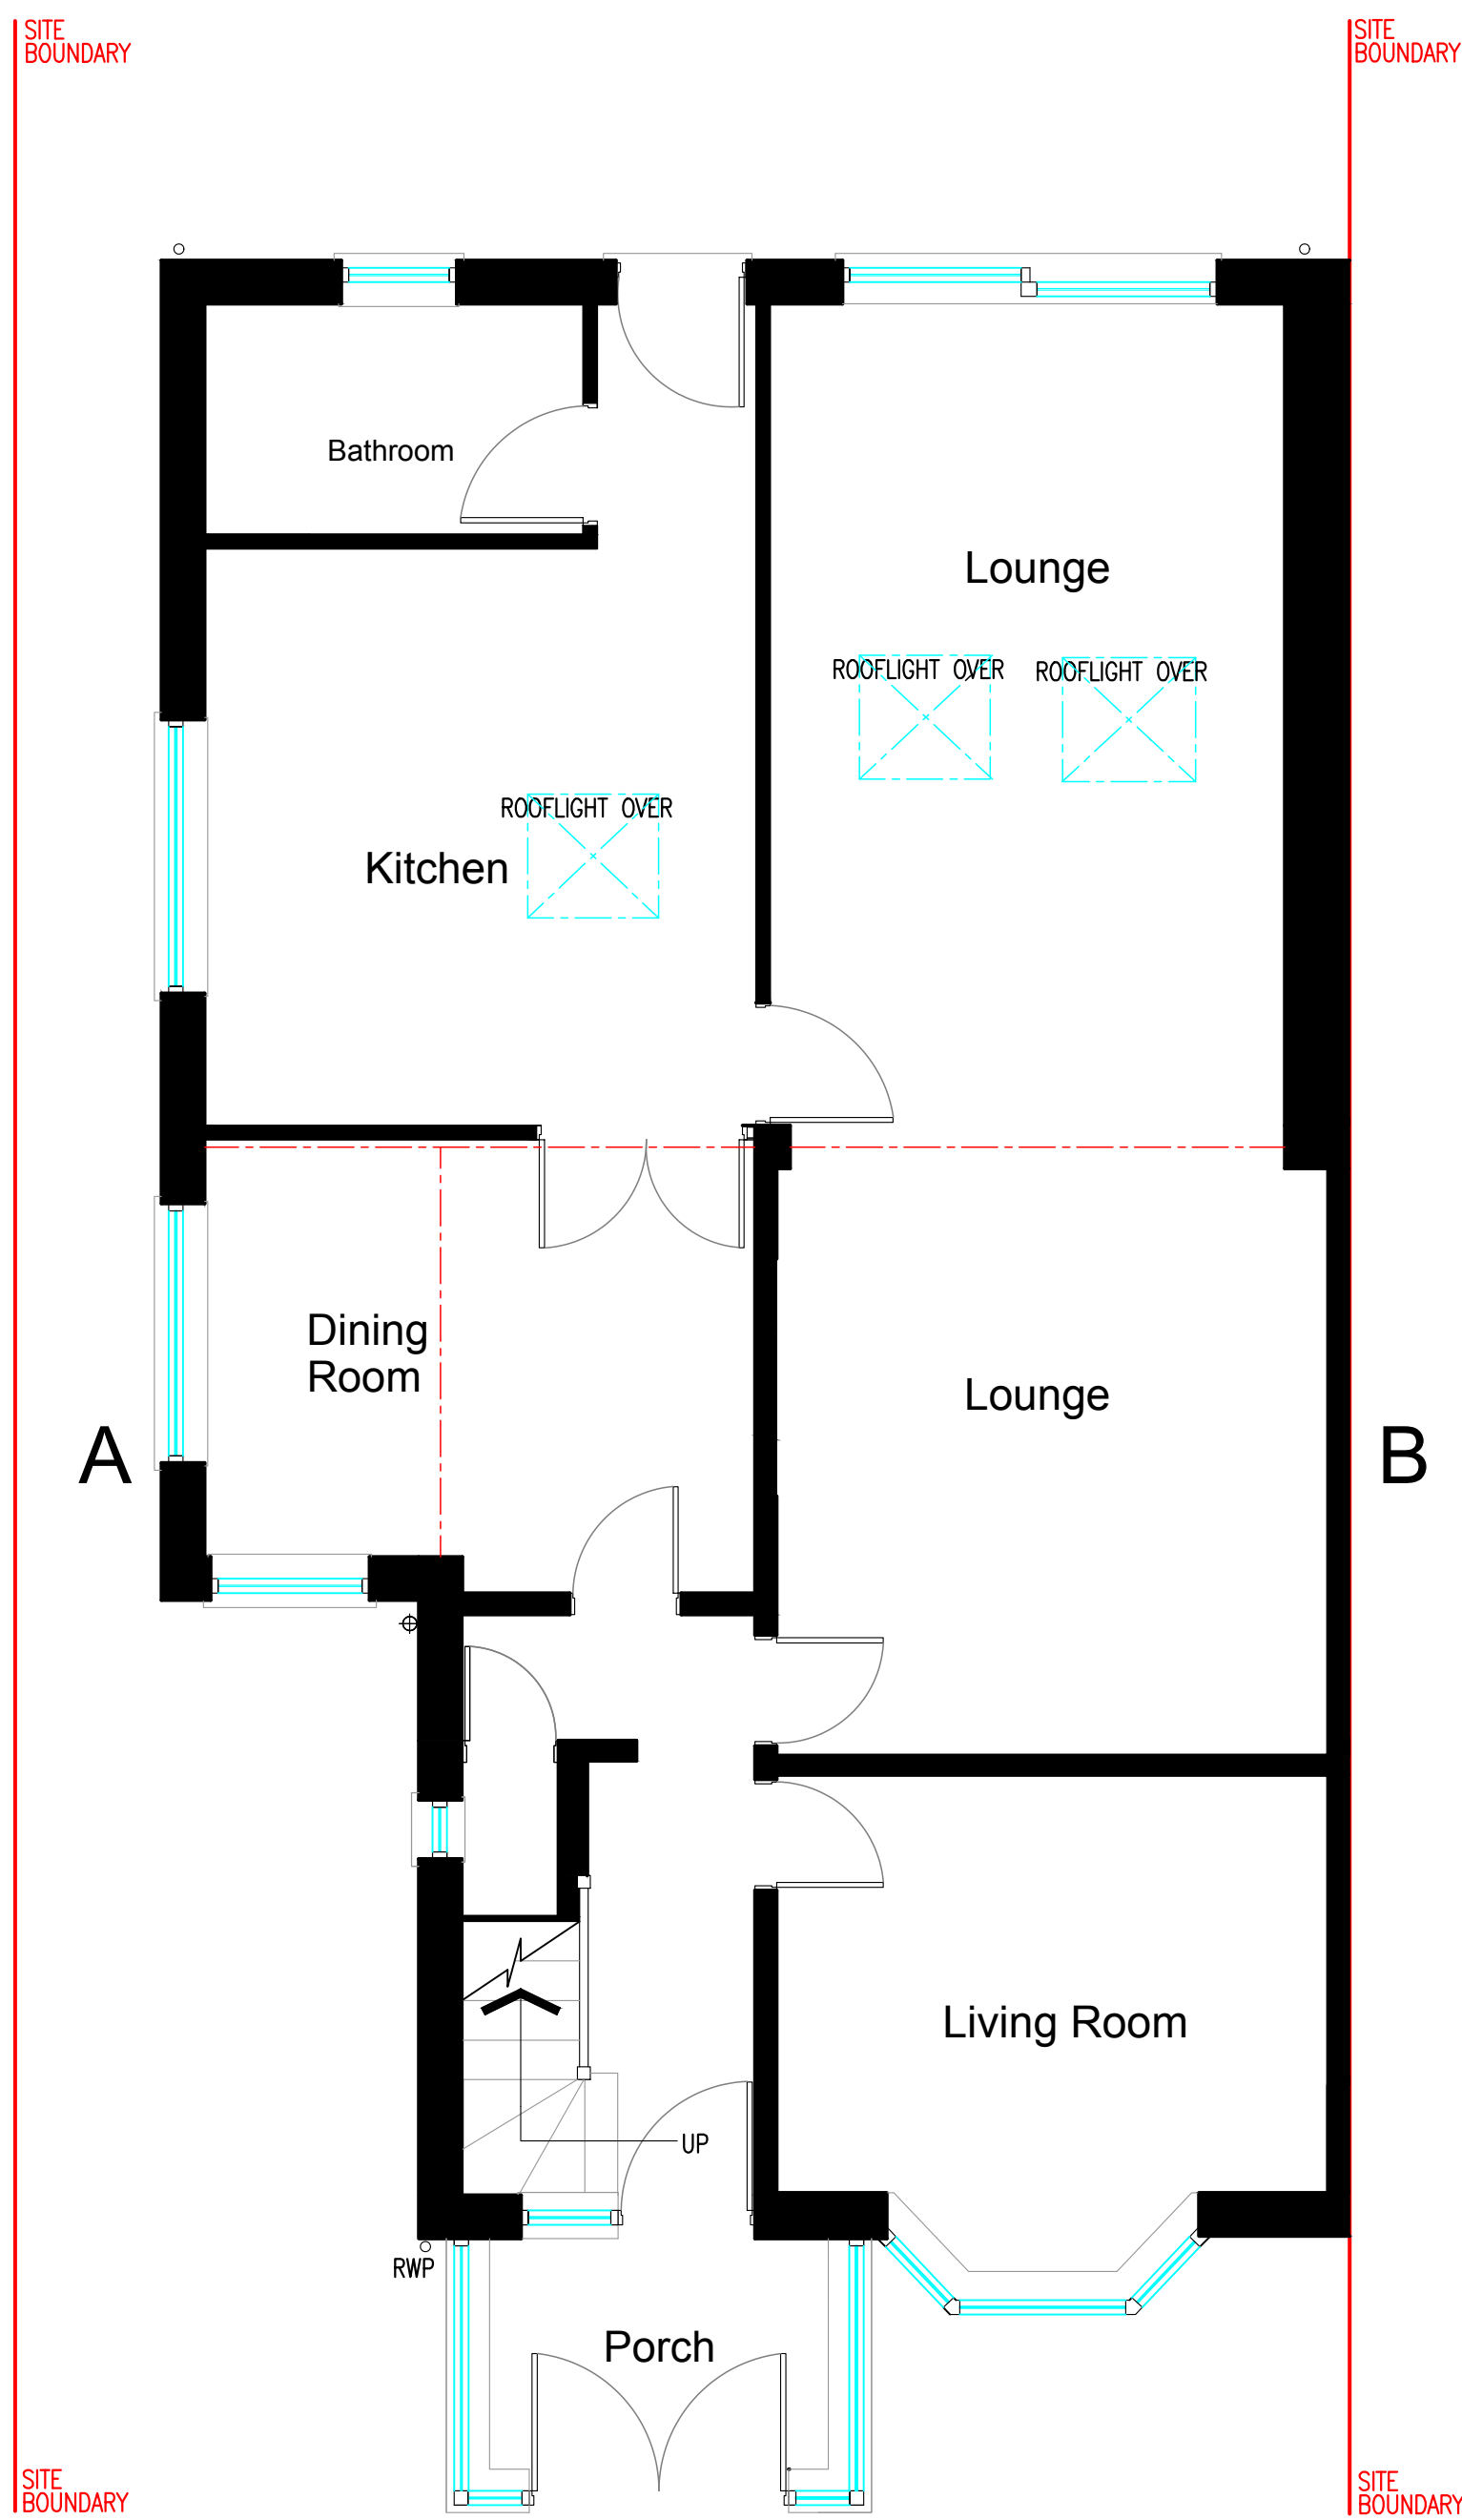

Ground Floor Plan 1:50 @ A1
(as built)

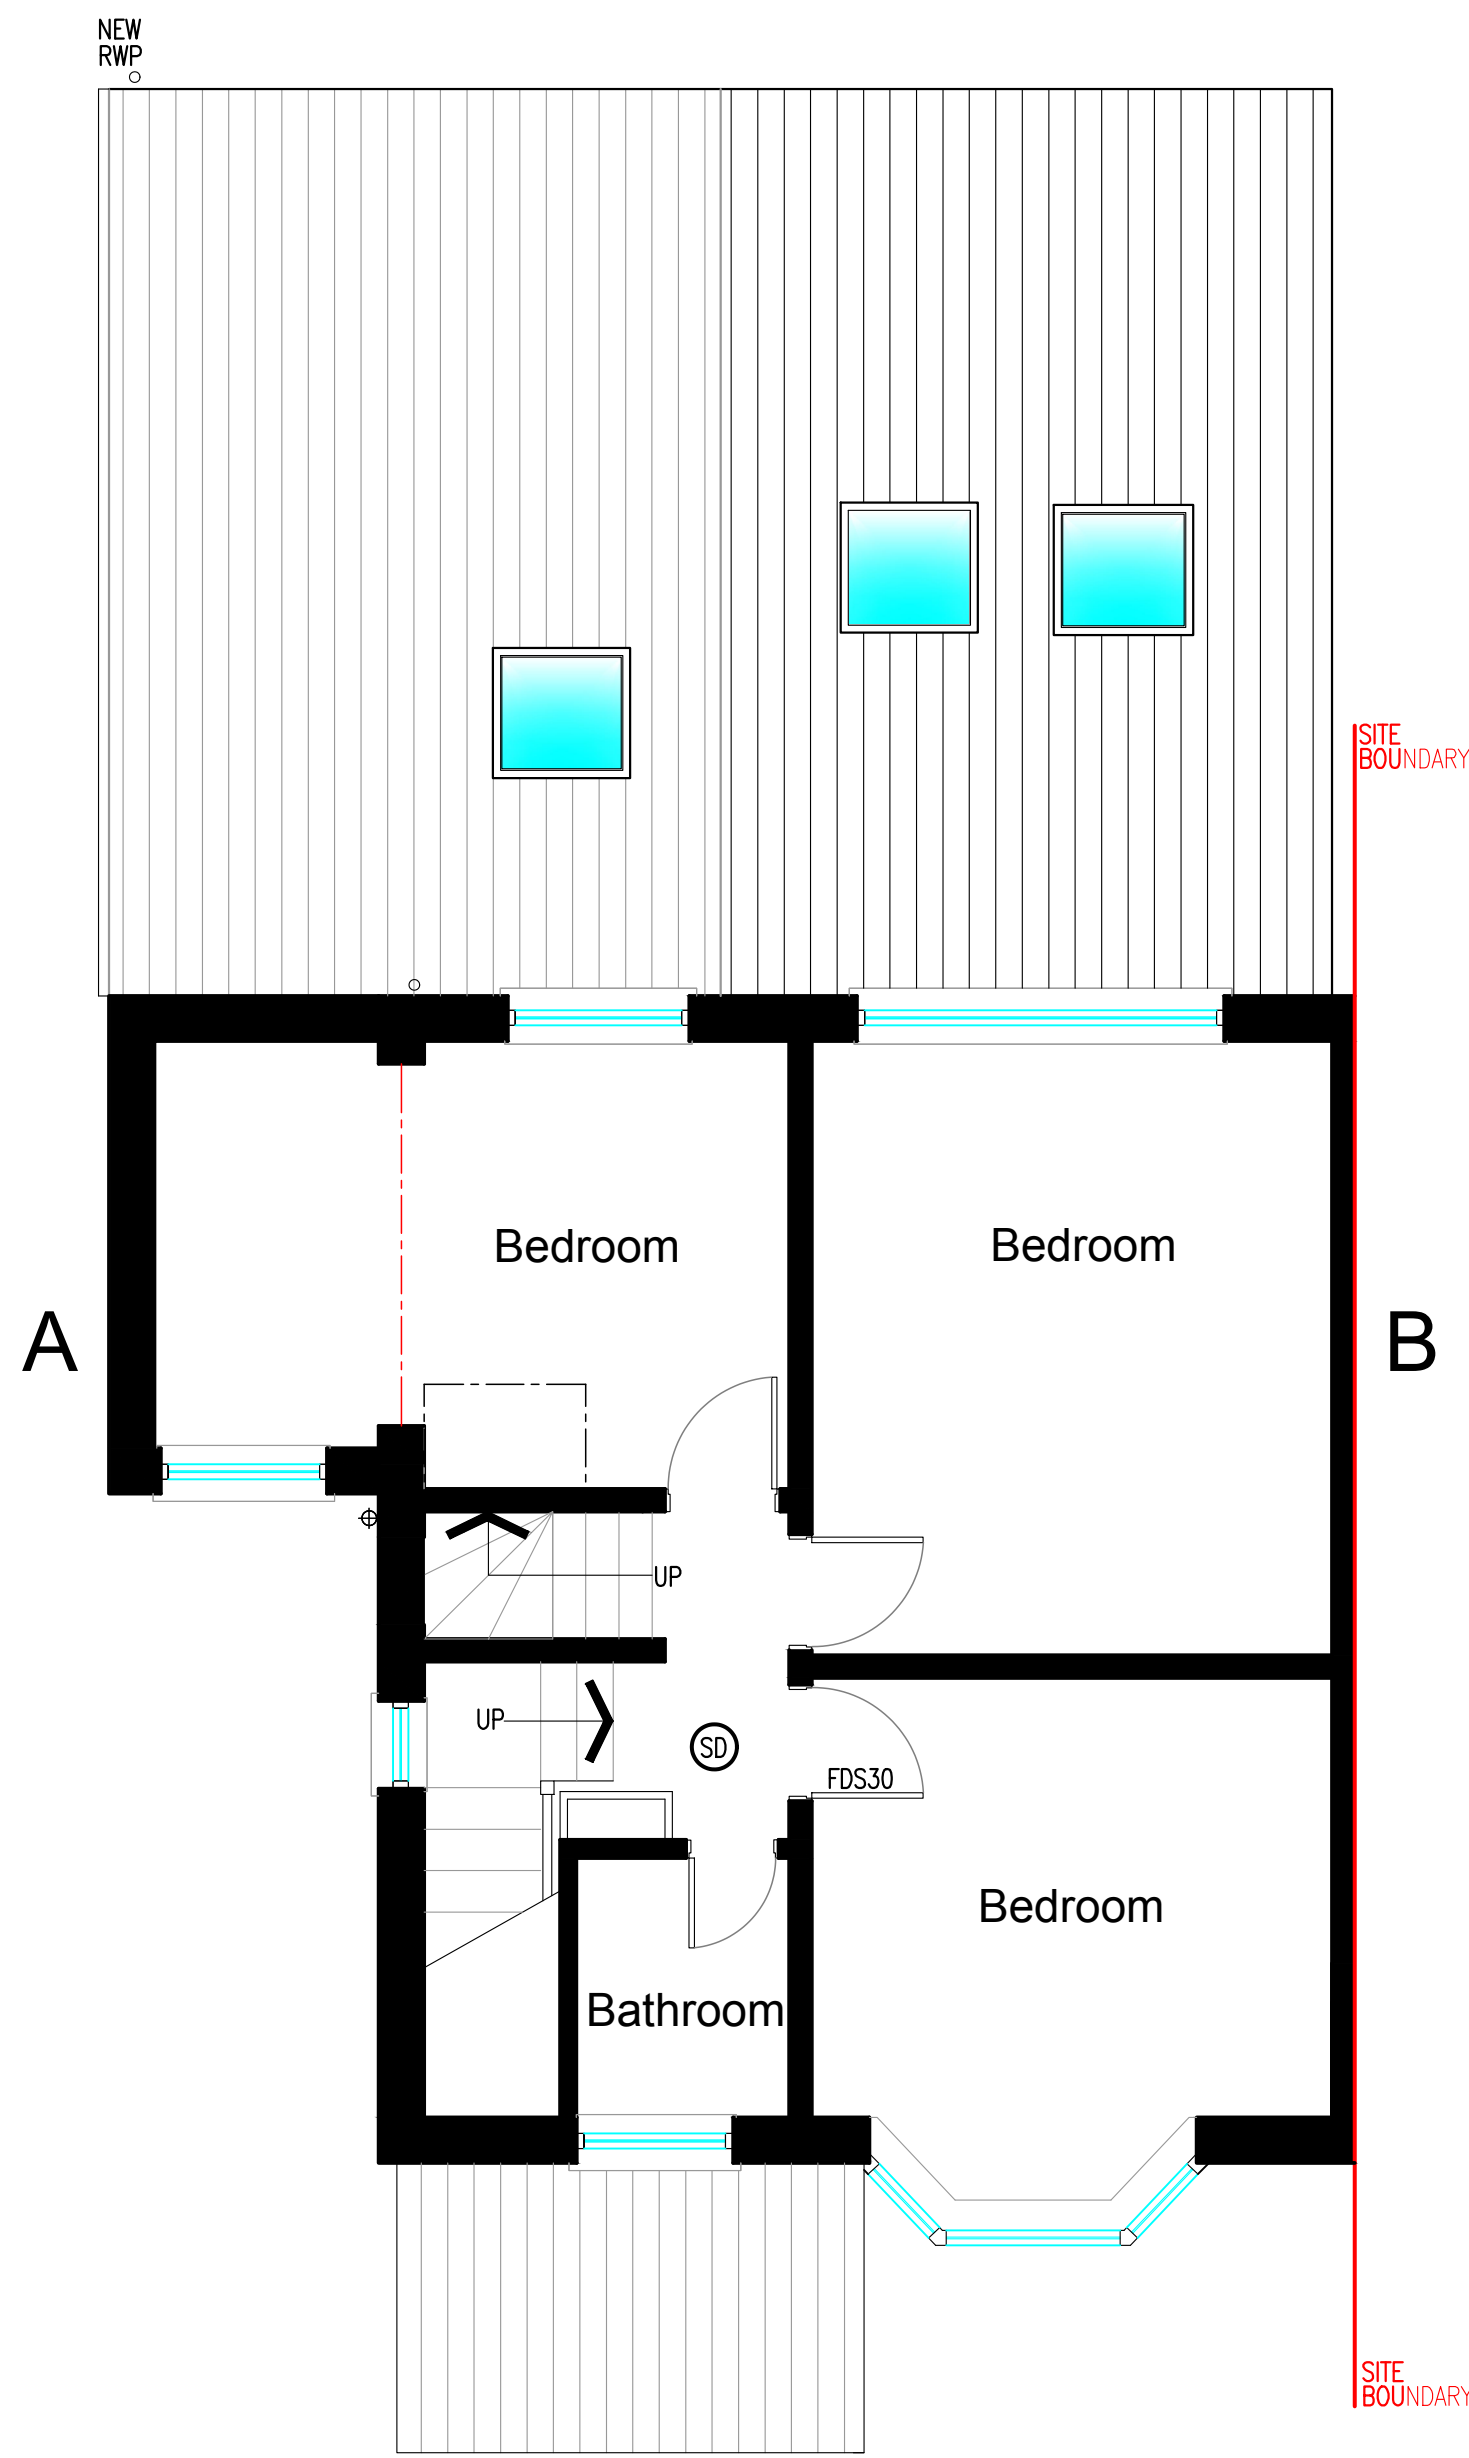

First Floor Plan 1:50 @ A1
(as built)

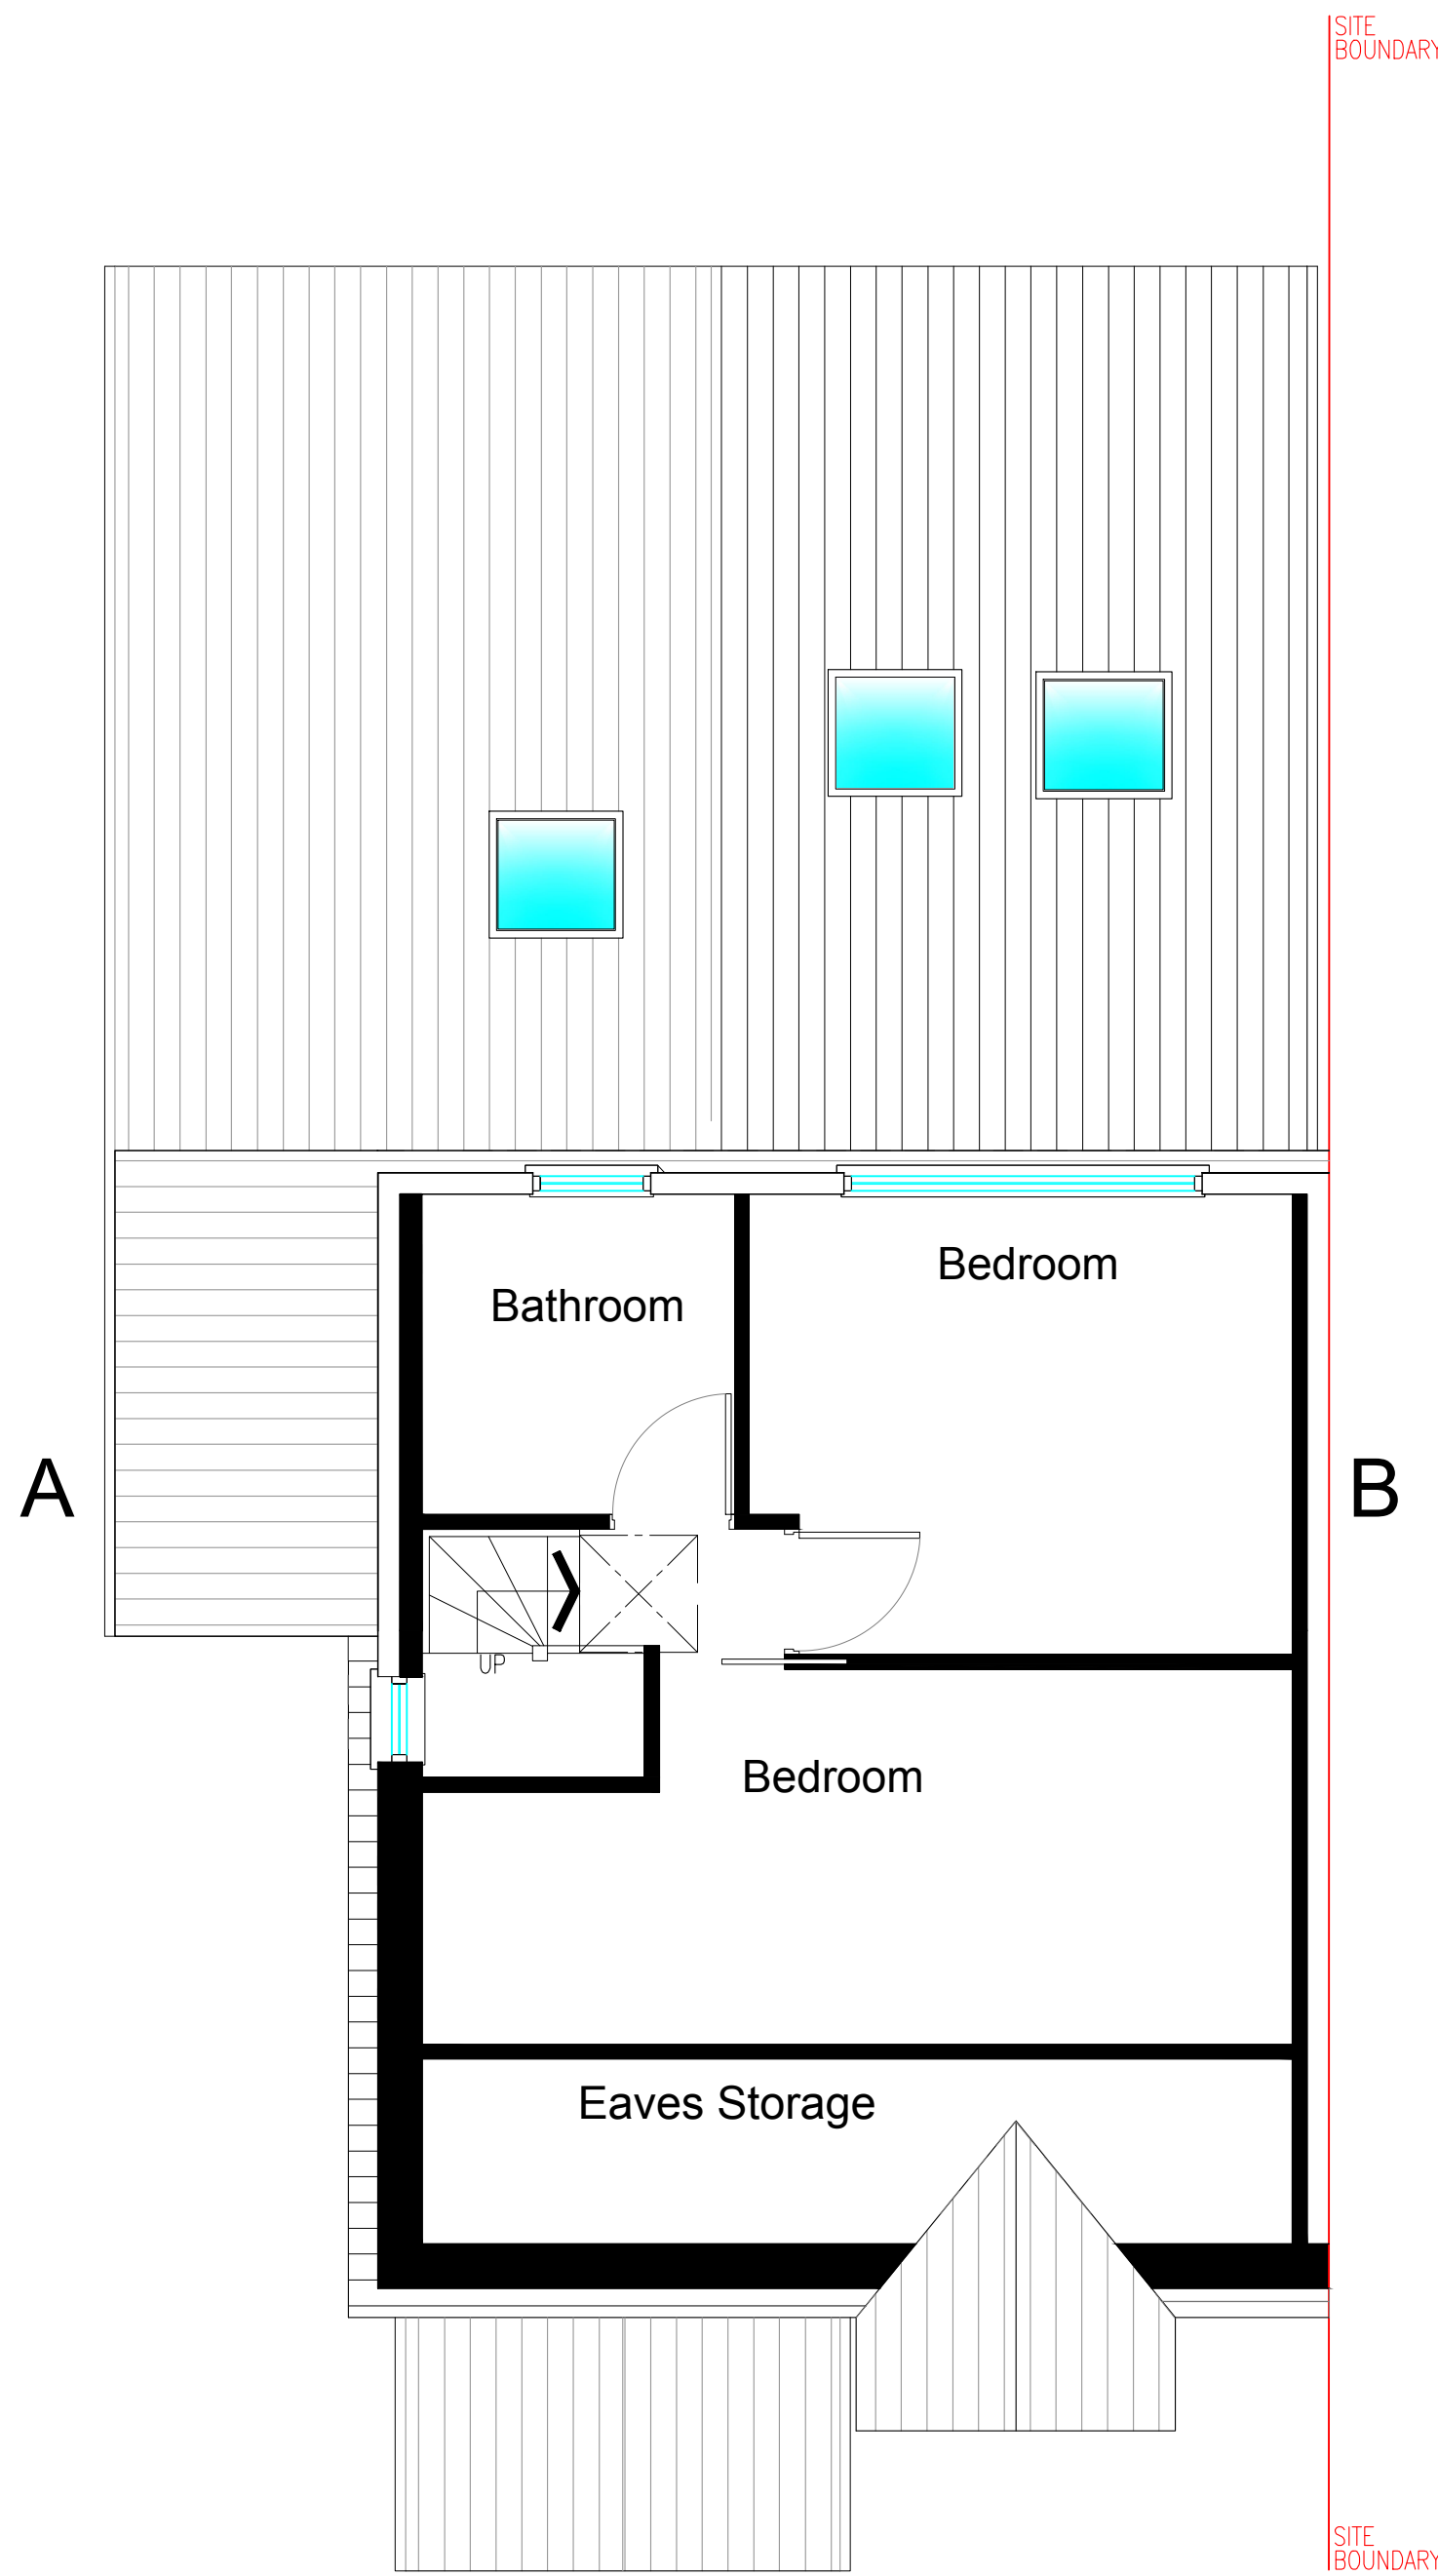

Second Floor Plan 1:50 @ A1
(as built)