


General Notes

The Architect shall have no responsibility for any use made of this document other than for that which it was prepared and issued.
All dimensions should be checked on site. Do not scale from this drawing. To be read in conjunction with all other Consultant's drawings. The Architect to be immediately notified of any discrepancies.


Copyright on this drawing retained by the Architect.

LEGEND

Approved
Application:
120891/FO/2018

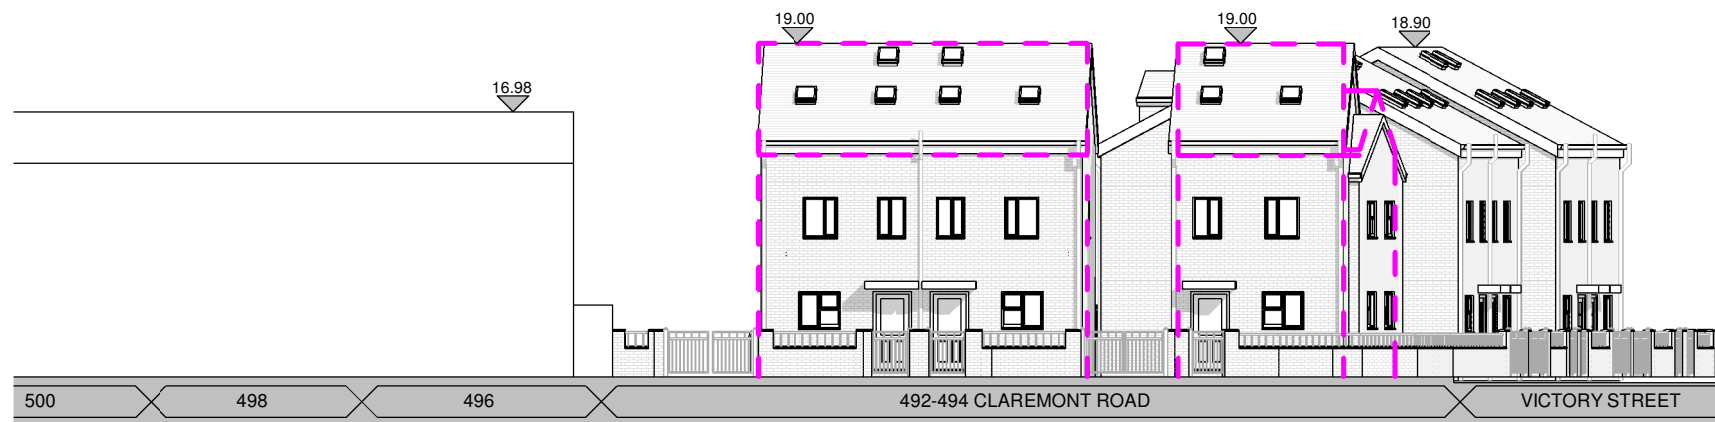

1 Claremont Road
1 : 200

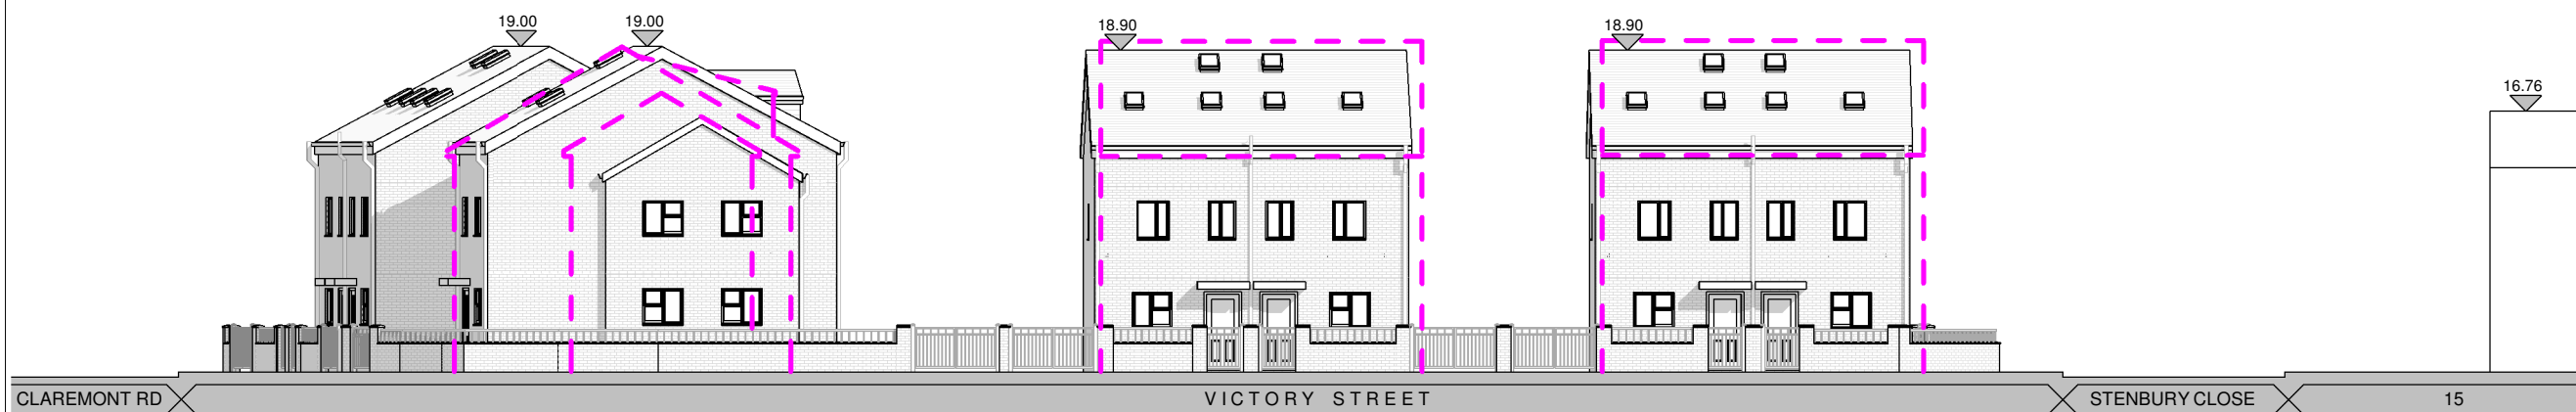

2 Victory Street
1 : 200

0 2 4 6 8m
1:200

C	24/10/22	AK	SH	Added Flat Canopy	
B	02/08/21	SA	SH	Added Drainage	
A	17/05/21	SA	SH	Amended Project	
-	27/04/21	SA	SH	Initial Issue	
No.	Date	Dwn	Chk	App	Revision or reason for issue

Client

R&S Builders

createitstudios
Architects & Designers

Create It Studios (NW) Ltd
Universal Square
Devonshire Street North
Manchester M12 6JH
0161 974 6165
www.createitstudios.co.uk
info@createitstudios.co.uk

Project Title
492-494 Claremont Road,
Manchester M14 5WA

Scale / North Point
1 : 200

Drawing Title
As-built Street Elevations

Drawing Number	Revision
A1344(02)002	C
Drawing Status	
Preliminary	