
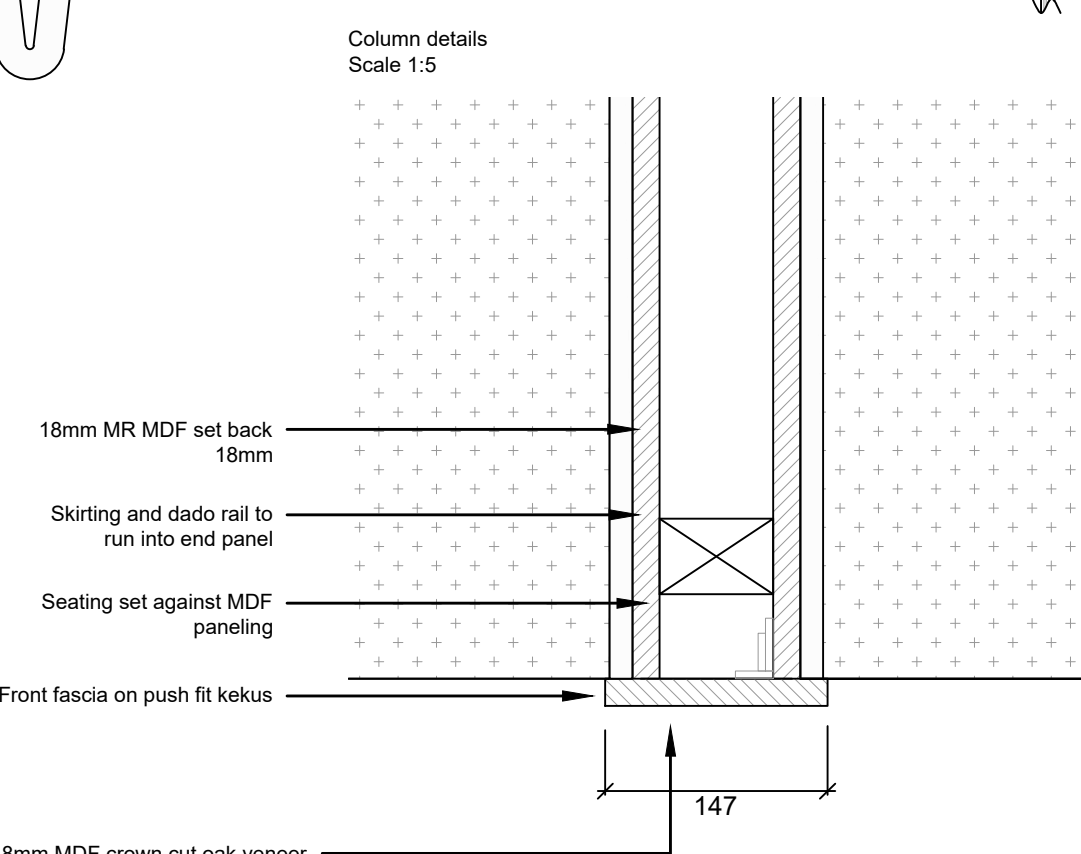
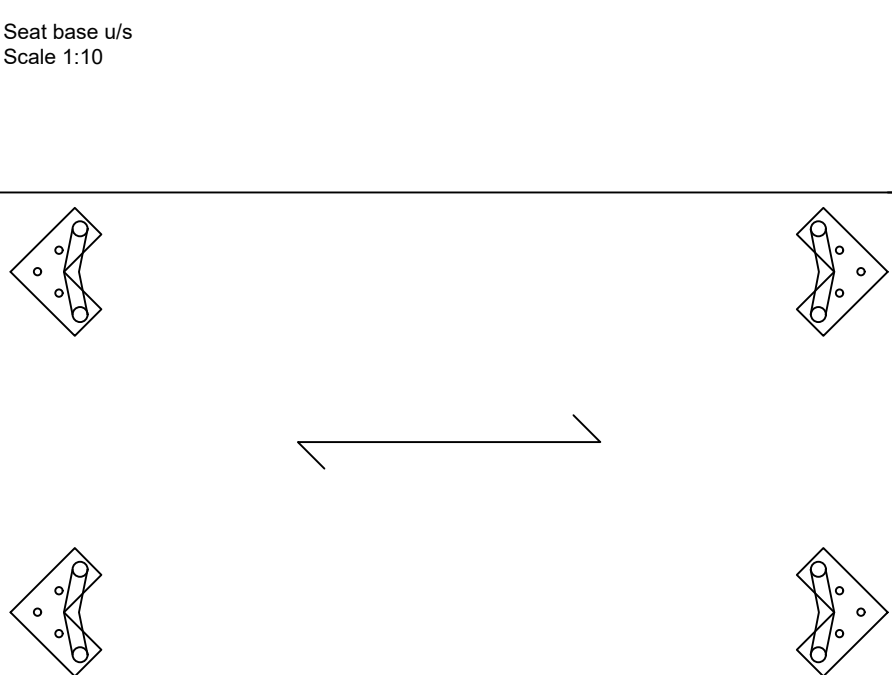
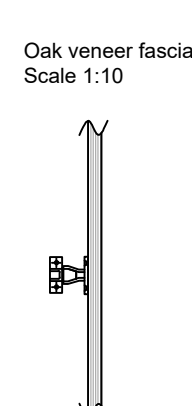
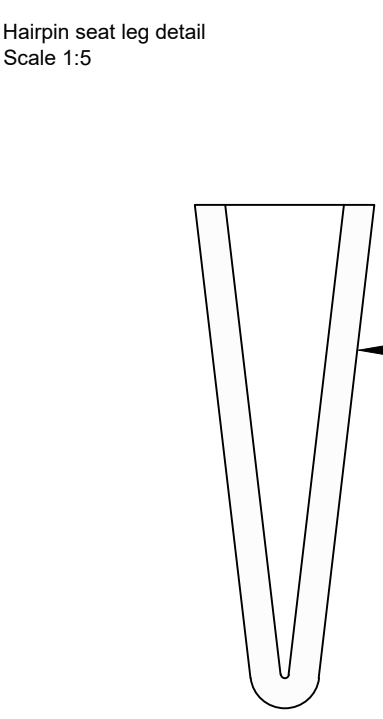
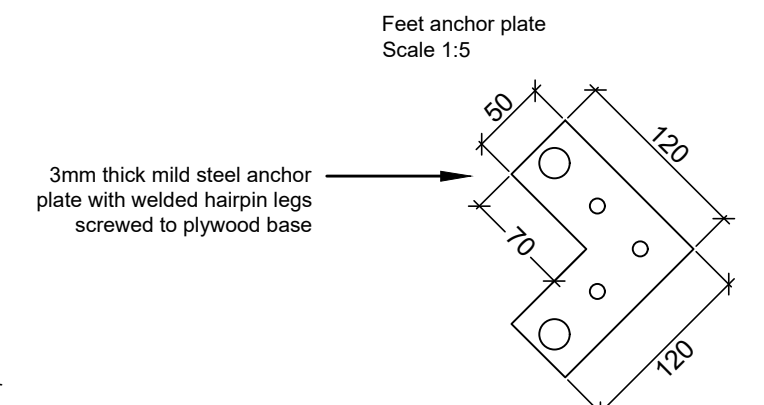
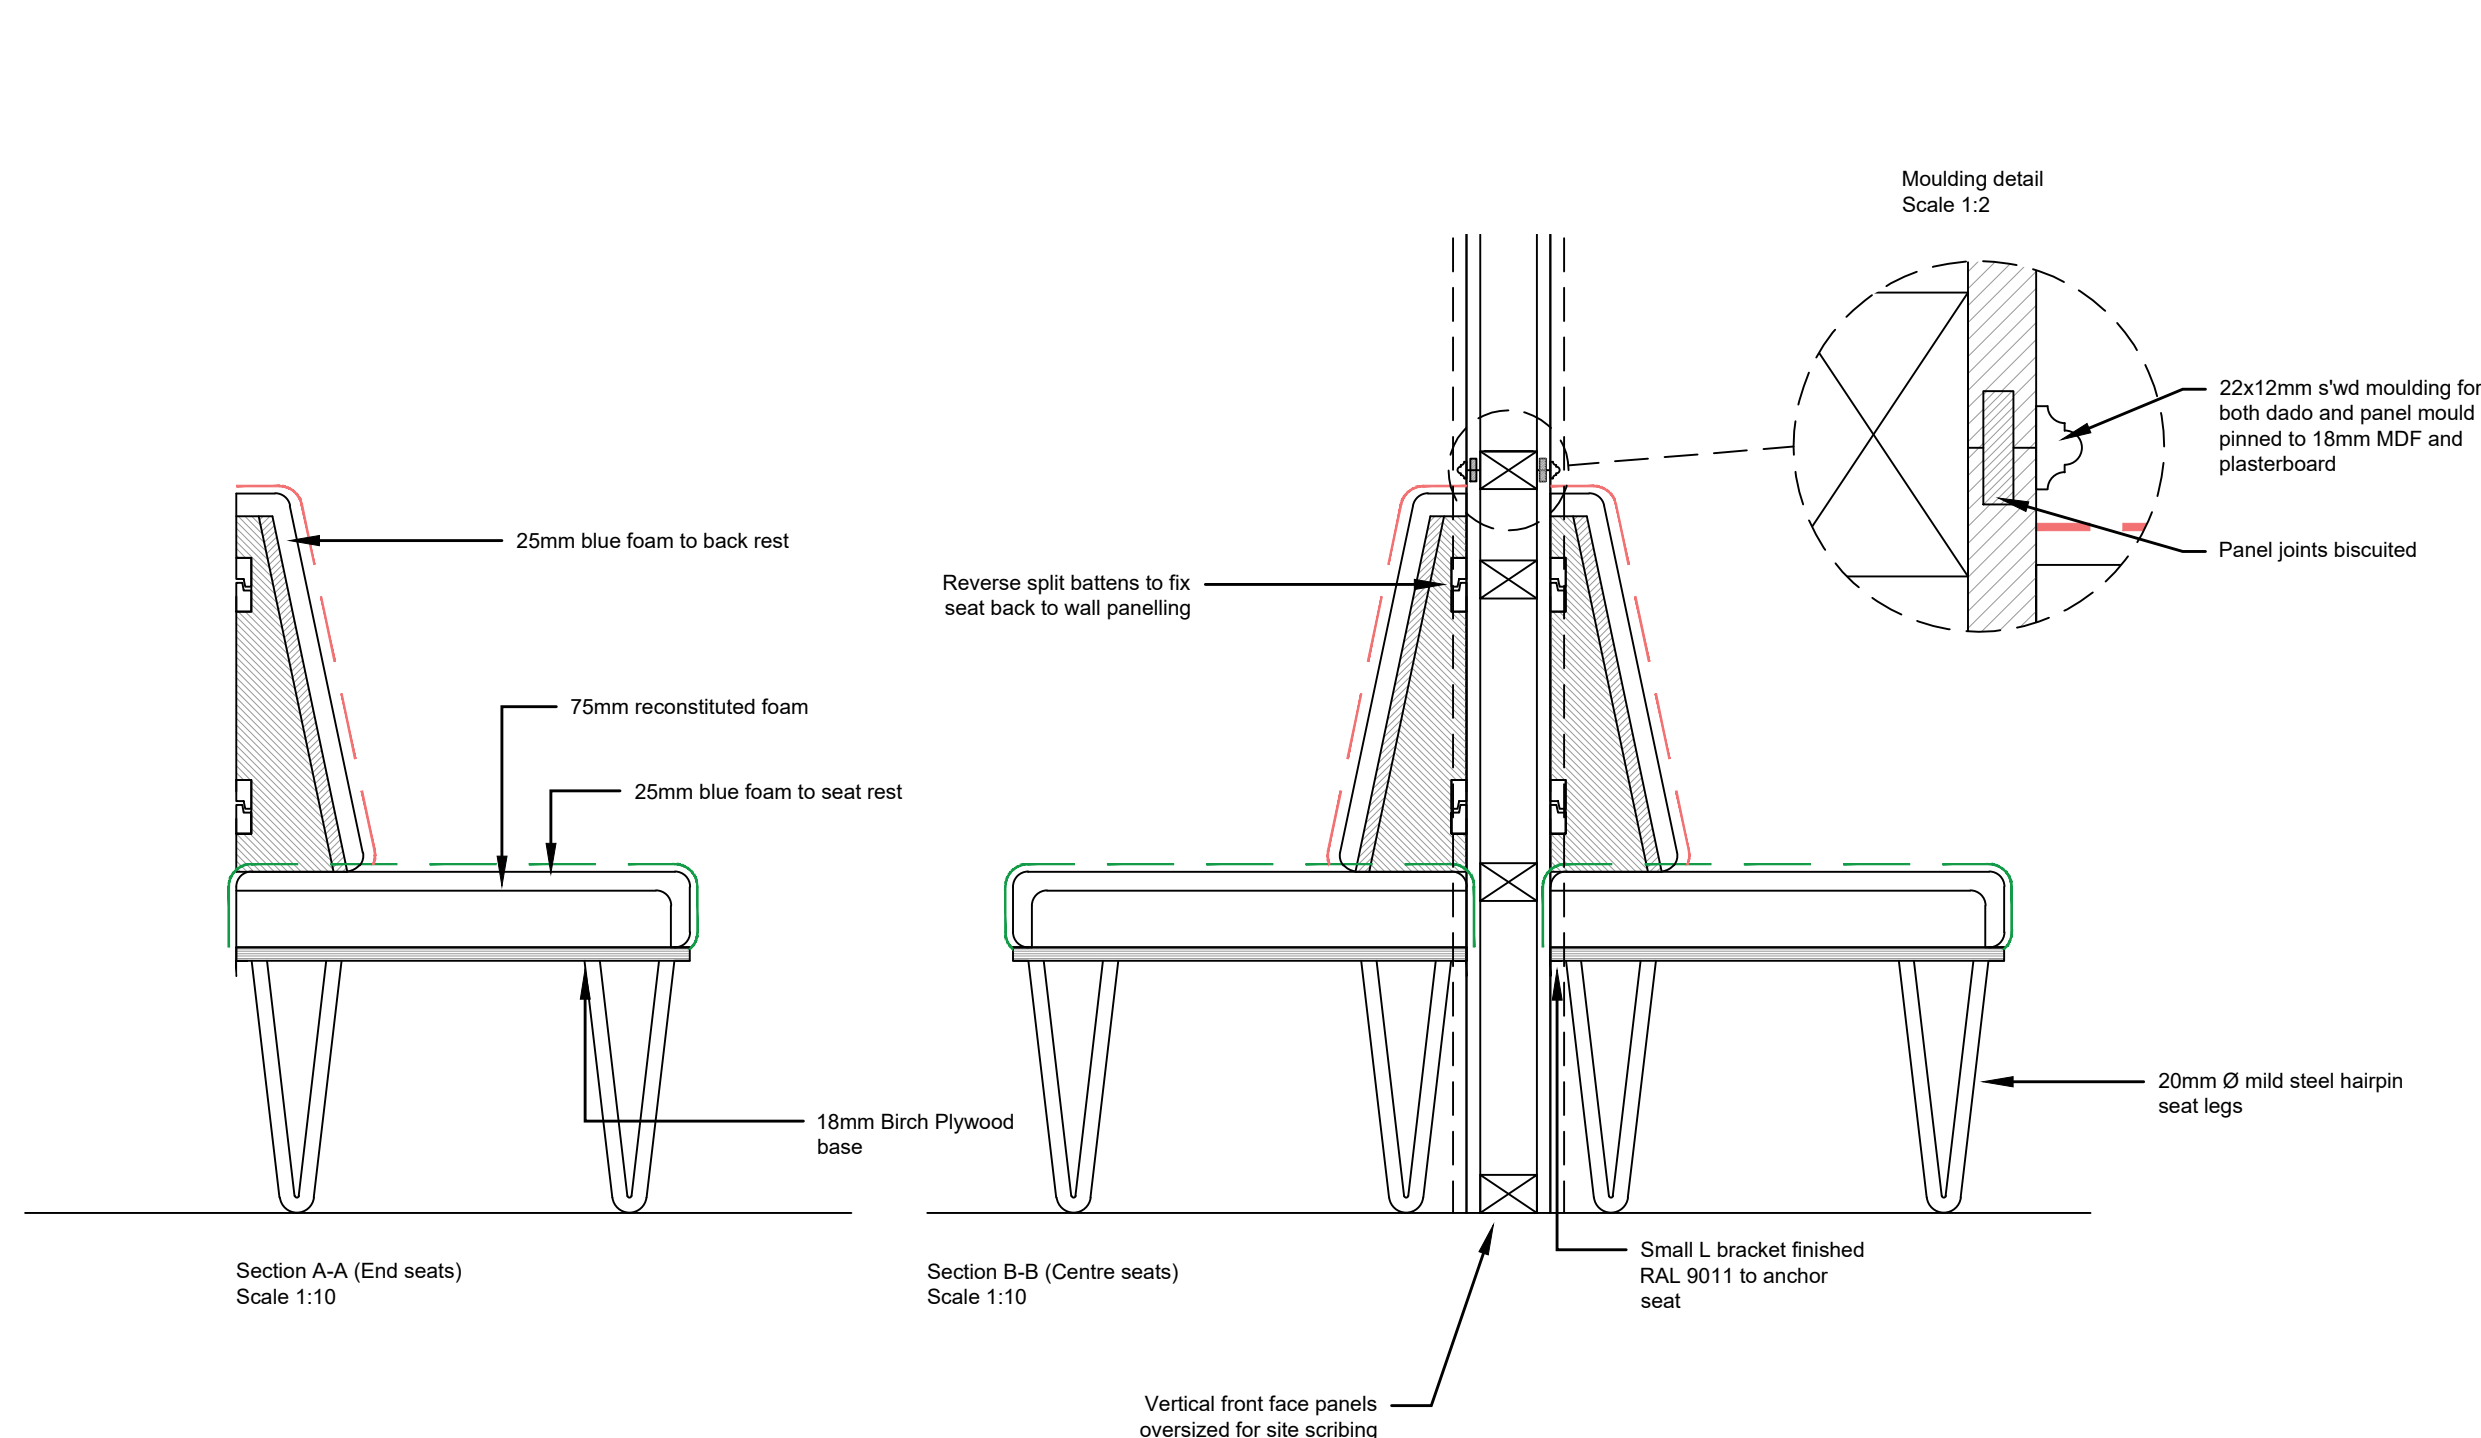
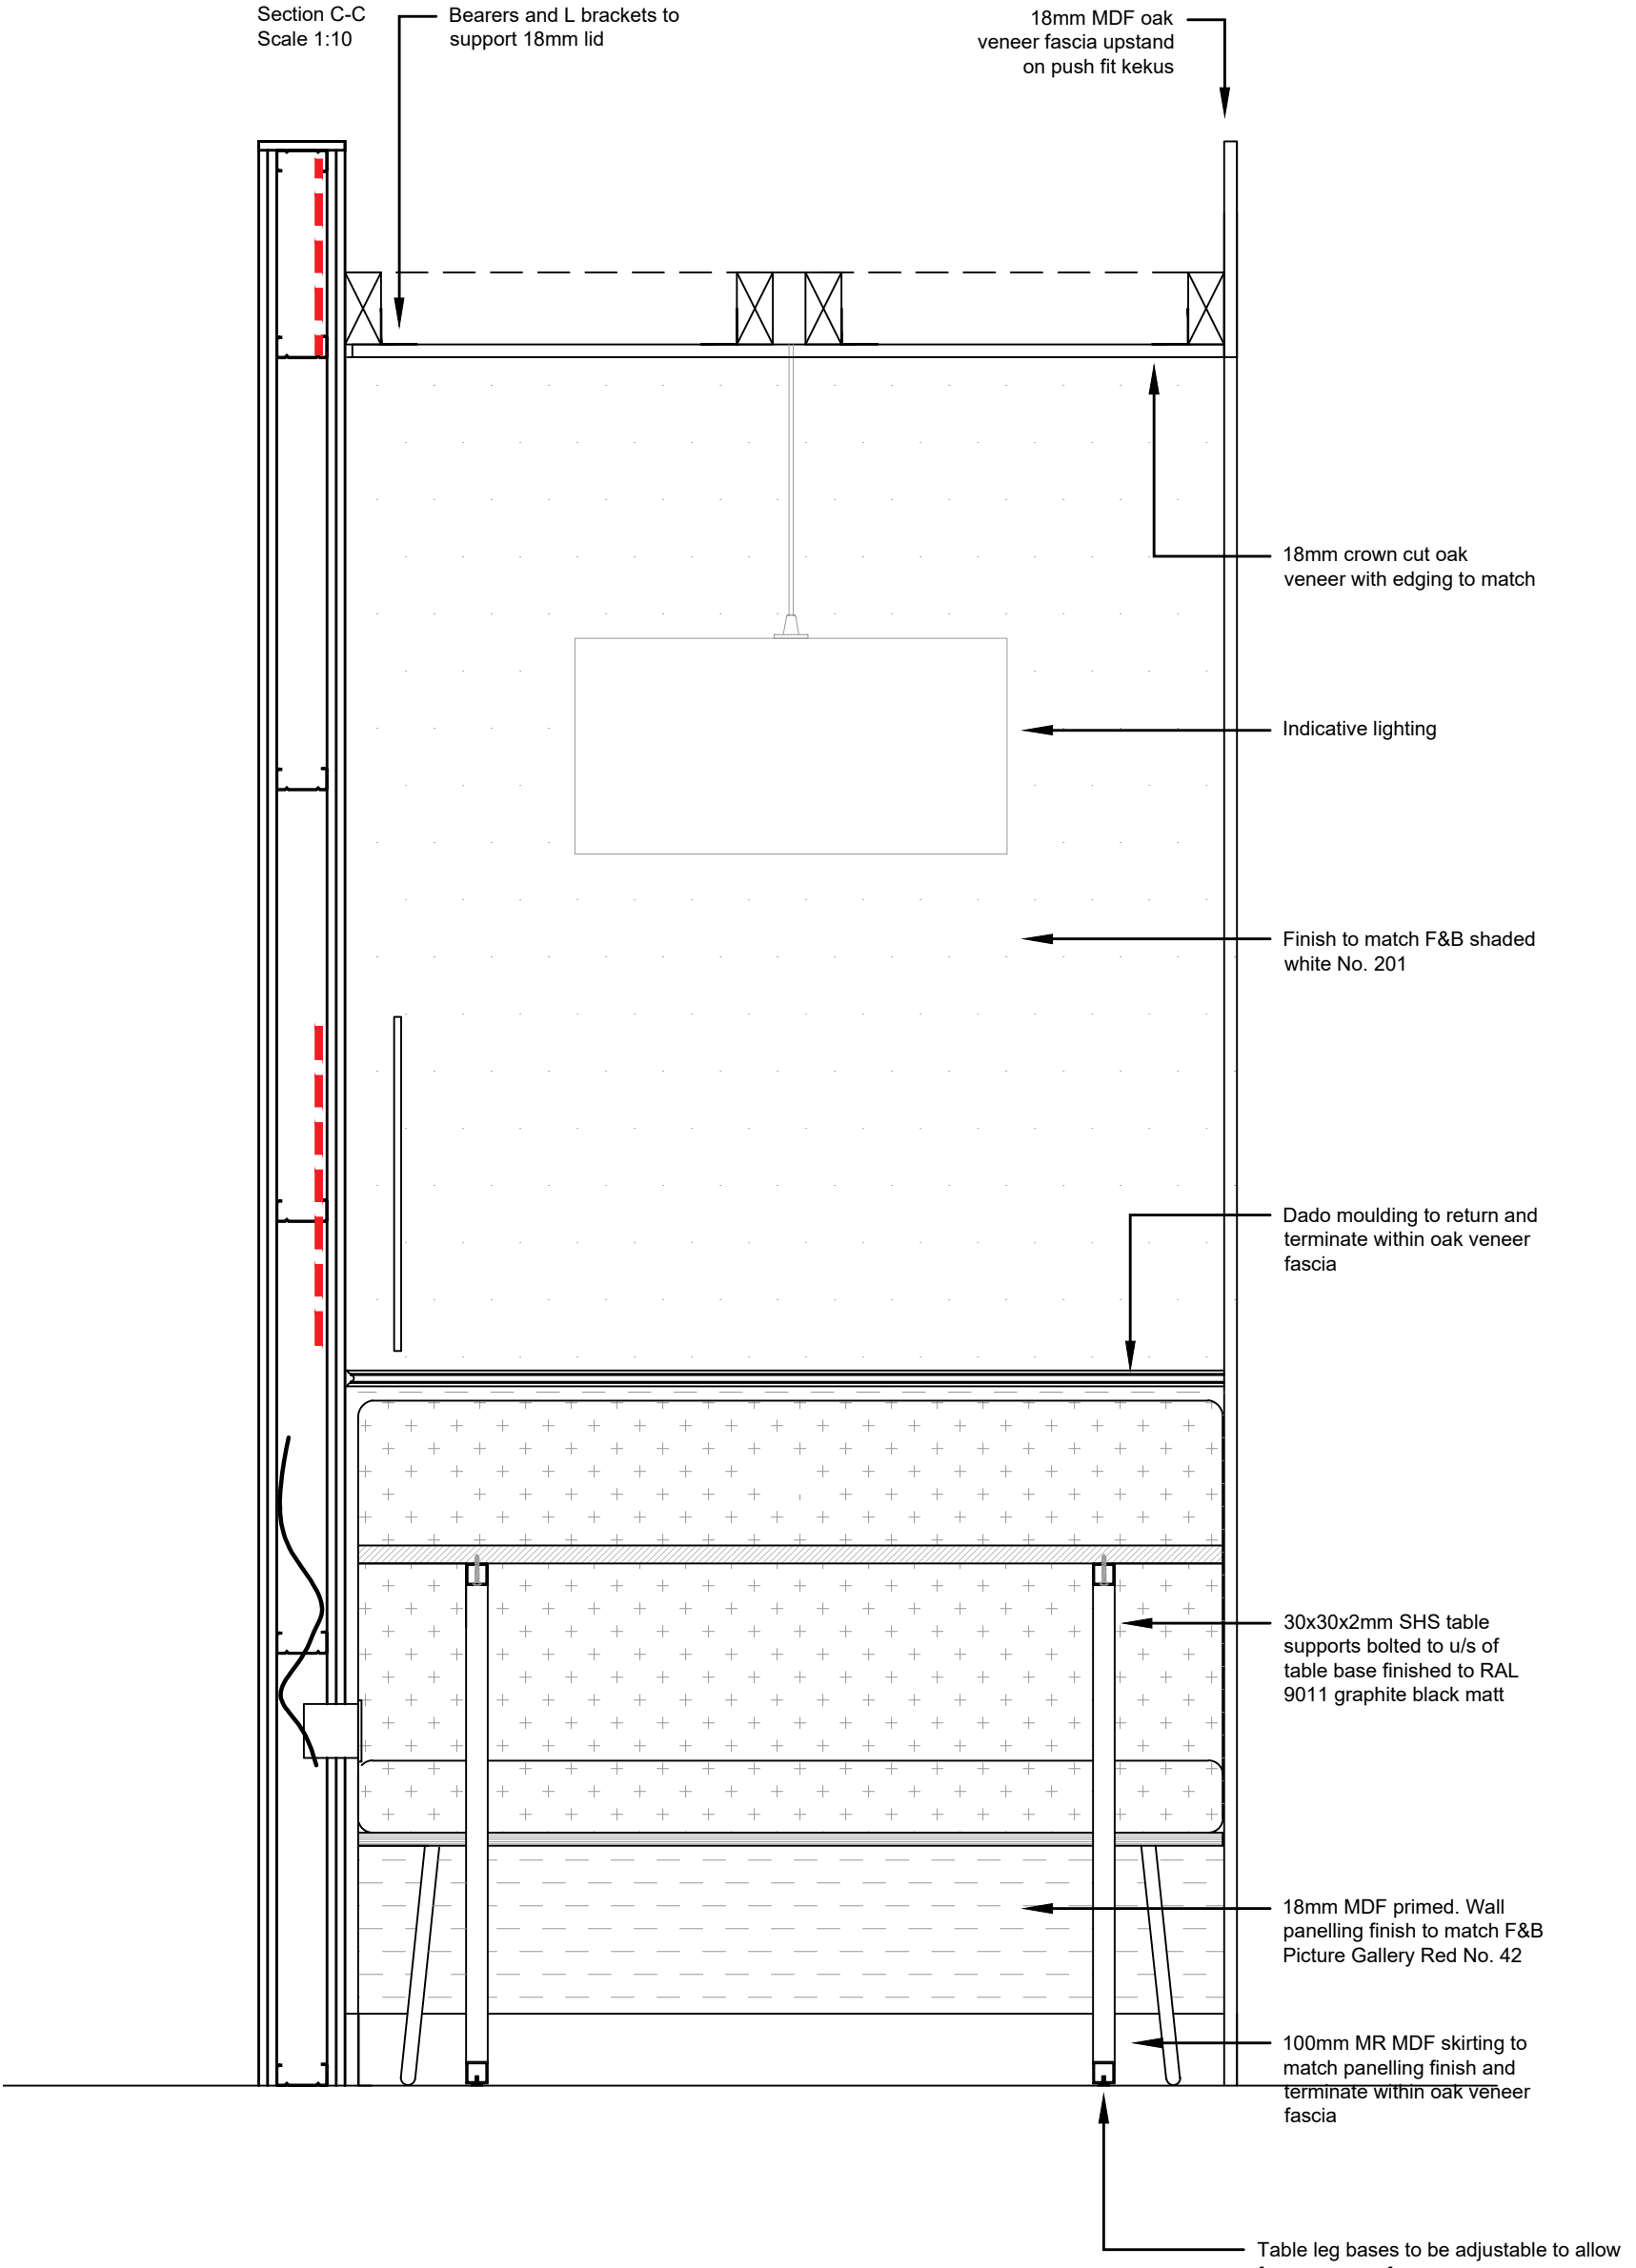
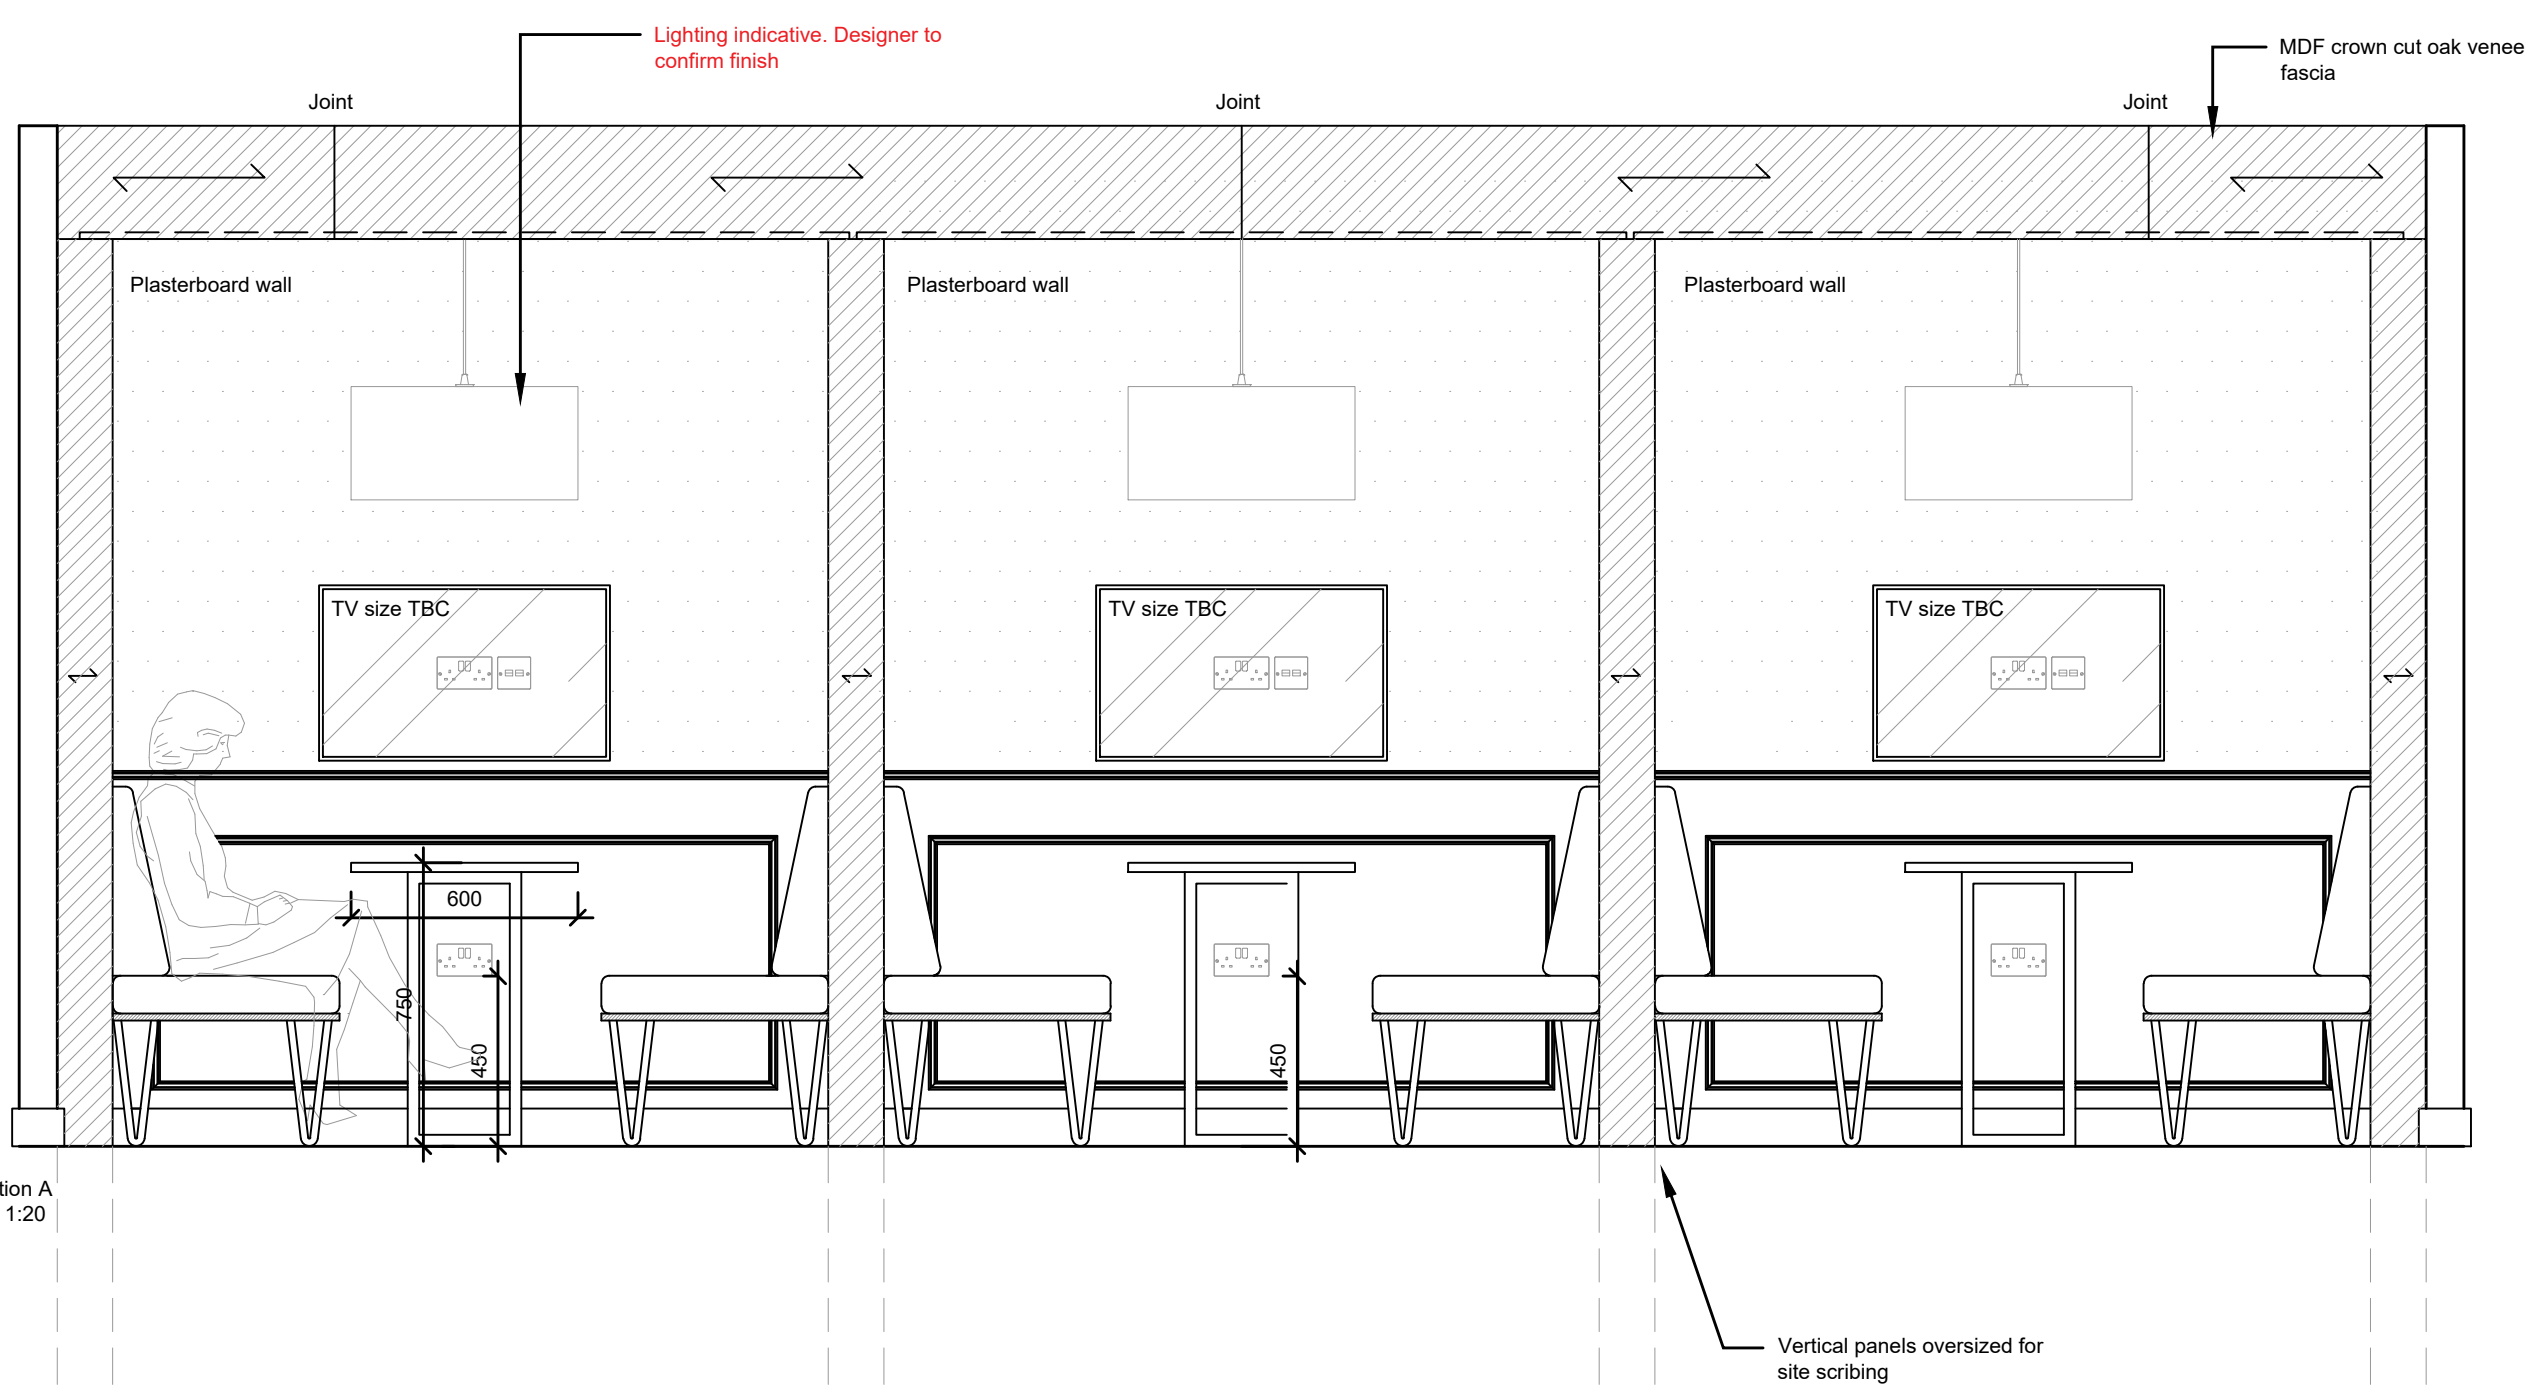


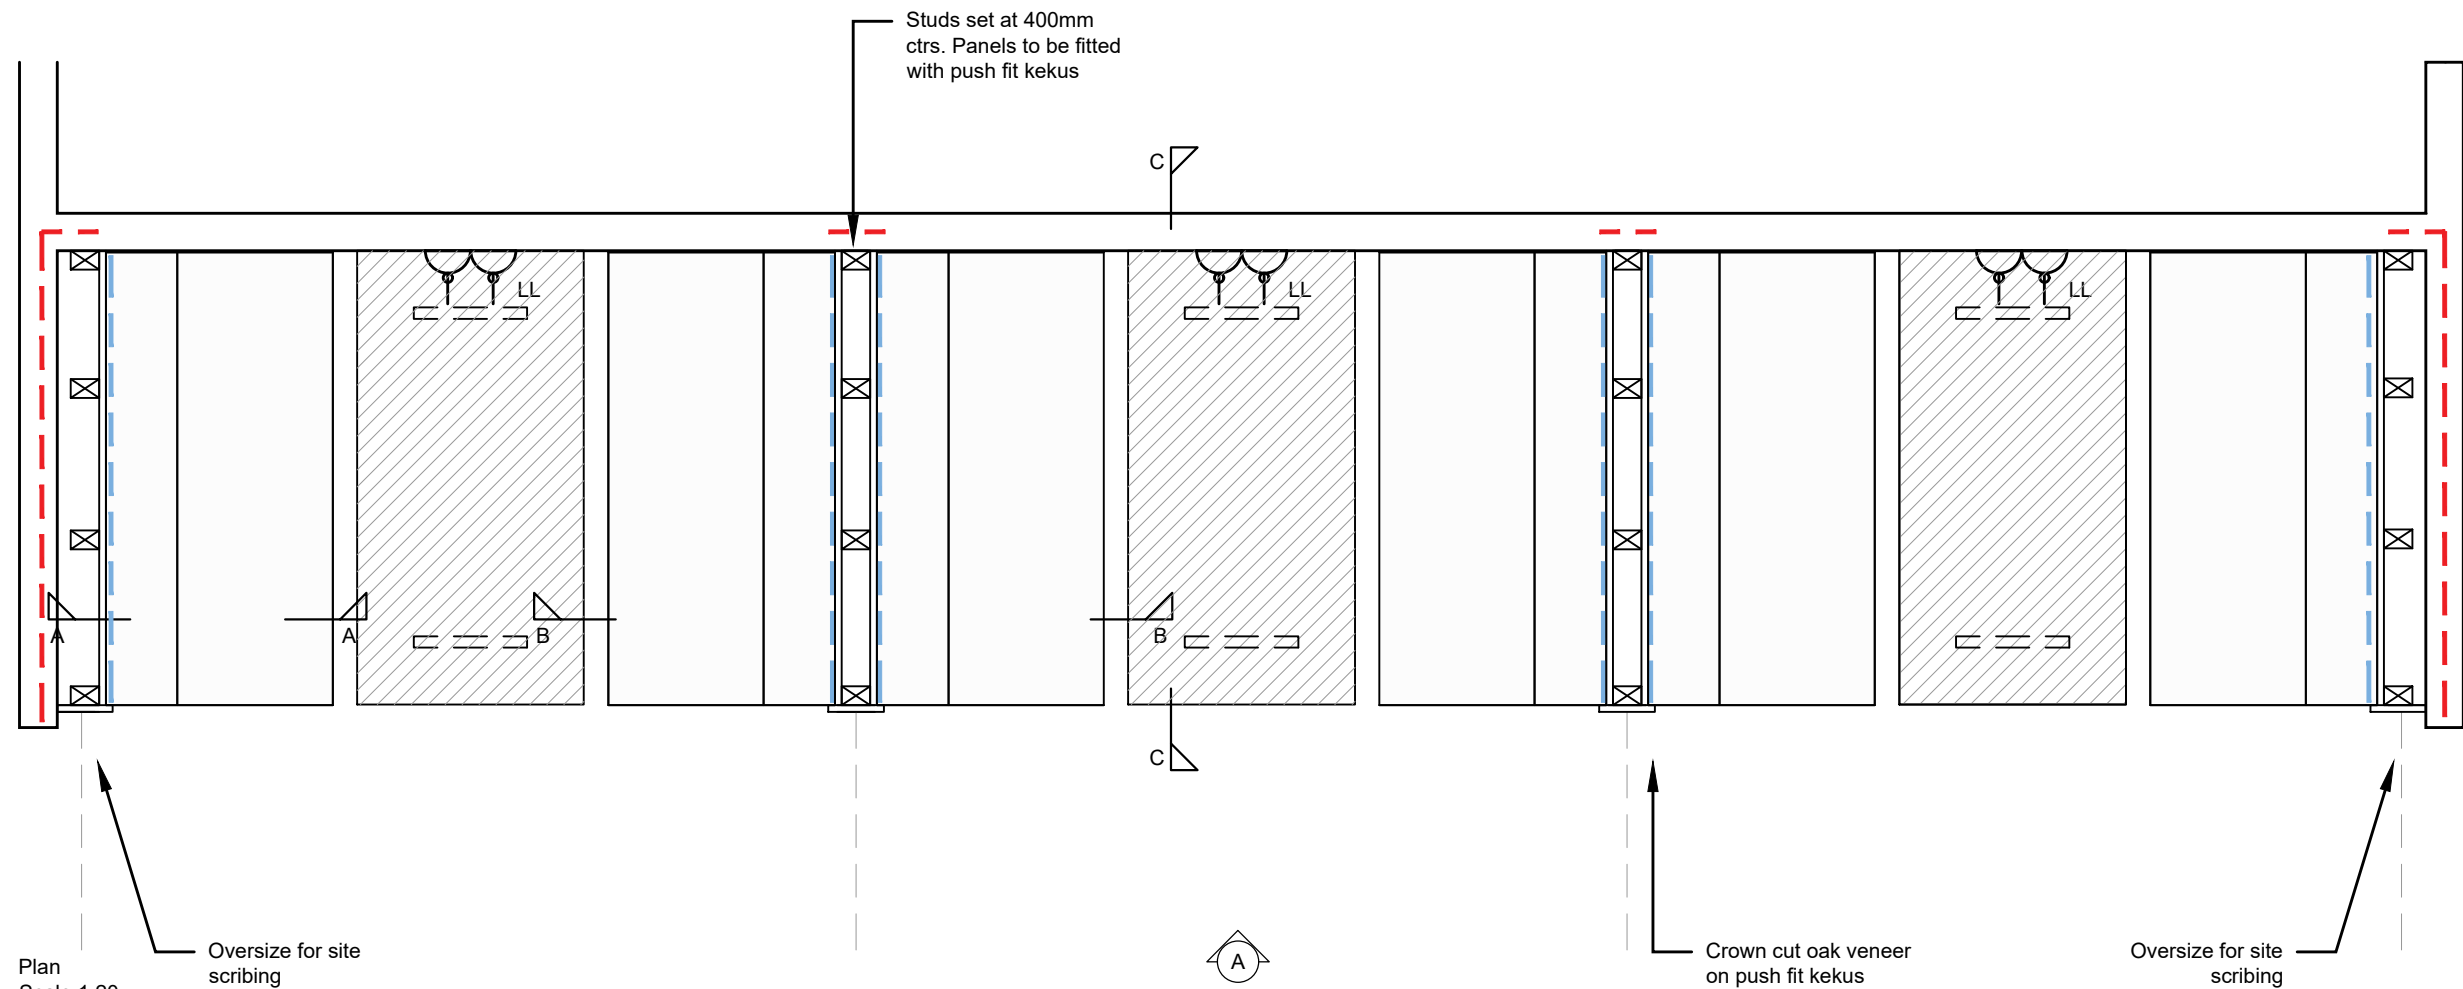

Notes:

Do not scale from this drawing. All dimensions to be checked on-site by contractor to ensure accuracy prior to any installation. All design work produced by Amspec Ltd is for indicative purposes only. It is the client and contractors responsibility to ensure that building control and fire officer approval have been met prior to commencement of site work.

Materials	Description
Seat fabric:	Camira Blazer Lite Haven LTH40
Back rest:	Kvadrat Safire by Sacho 001
Seat legs:	20mm Ø mild steel hairpin legs welded to base plate all ppc to RAL 9011 graphite black matt finish
Seat base:	18mm MDF Crown cut oak veneer with edging to match
Low wall panels:	18mm MR MDF primed and finished to match F&B Picture Gallery Red No. 42
Moulding:	22x12mm softwood moulding for dado and panels finished to match F&B Picture Gallery Red No. 42
Front face cladding:	18mm MDF Crown cut oak veneer with edging to match
Table tops:	1200 x 600 x 25mm Egger U727 Stone Grey with 2mm ABS edging to match
Table support:	30x30x2mm SHS table supports bolted to u/s of table base finished to RAL 9011 graphite black matt
High wall finish:	To match F&B shaded white No. 201

Dimensions to be confirmed on-site

Contracts manager to check and confirm all measures on-site. Any discrepancies to be reported to the designer

Quiet Booths 02 Location Plan
Scale @ 1:100

Fabric finishes

Back rest: Kvadrat Safire by Sacho 001

Seat pad: Camira Blazer Lite Haven LTH40

Patress locations

Panelling locations

Workshop to request level survey from site

REV:	DESCRIPTION:	BY:	DATE:
STATUS: AS BUILT			
amspec DESIGN & BUILD SOLUTIONS t : 01942 621342 f : 01942 226552 www.amspec.co.uk			
CLIENT:	OBI 80 MOSLEY STREET MANCHESTER M2 3FX		
ARCHITECT:			
SITE:	18 LOWER BYROM STREET MANCHESTER		
TITLE:	LEVEL 6 QUIET BOOTHS 2		
SCALE: AT A1:	DATE:	DRAWN:	CHECKED:
1:20	13.11.19	CR	MS
PROJECT NO:	DRAWING NO:	REVISION:	
1683	06(71)516		