

SERVICES
DRAWING
AS BUILT.


SCALE 1/100

DATE APRIL 1990

SAML TAYLOR, SON & PLATT
CHARTERED ARCHITECTS
60, MANCHESTER ROAD
BURNLEY
TEL. 21961

1390.5.

AMENDMENTS

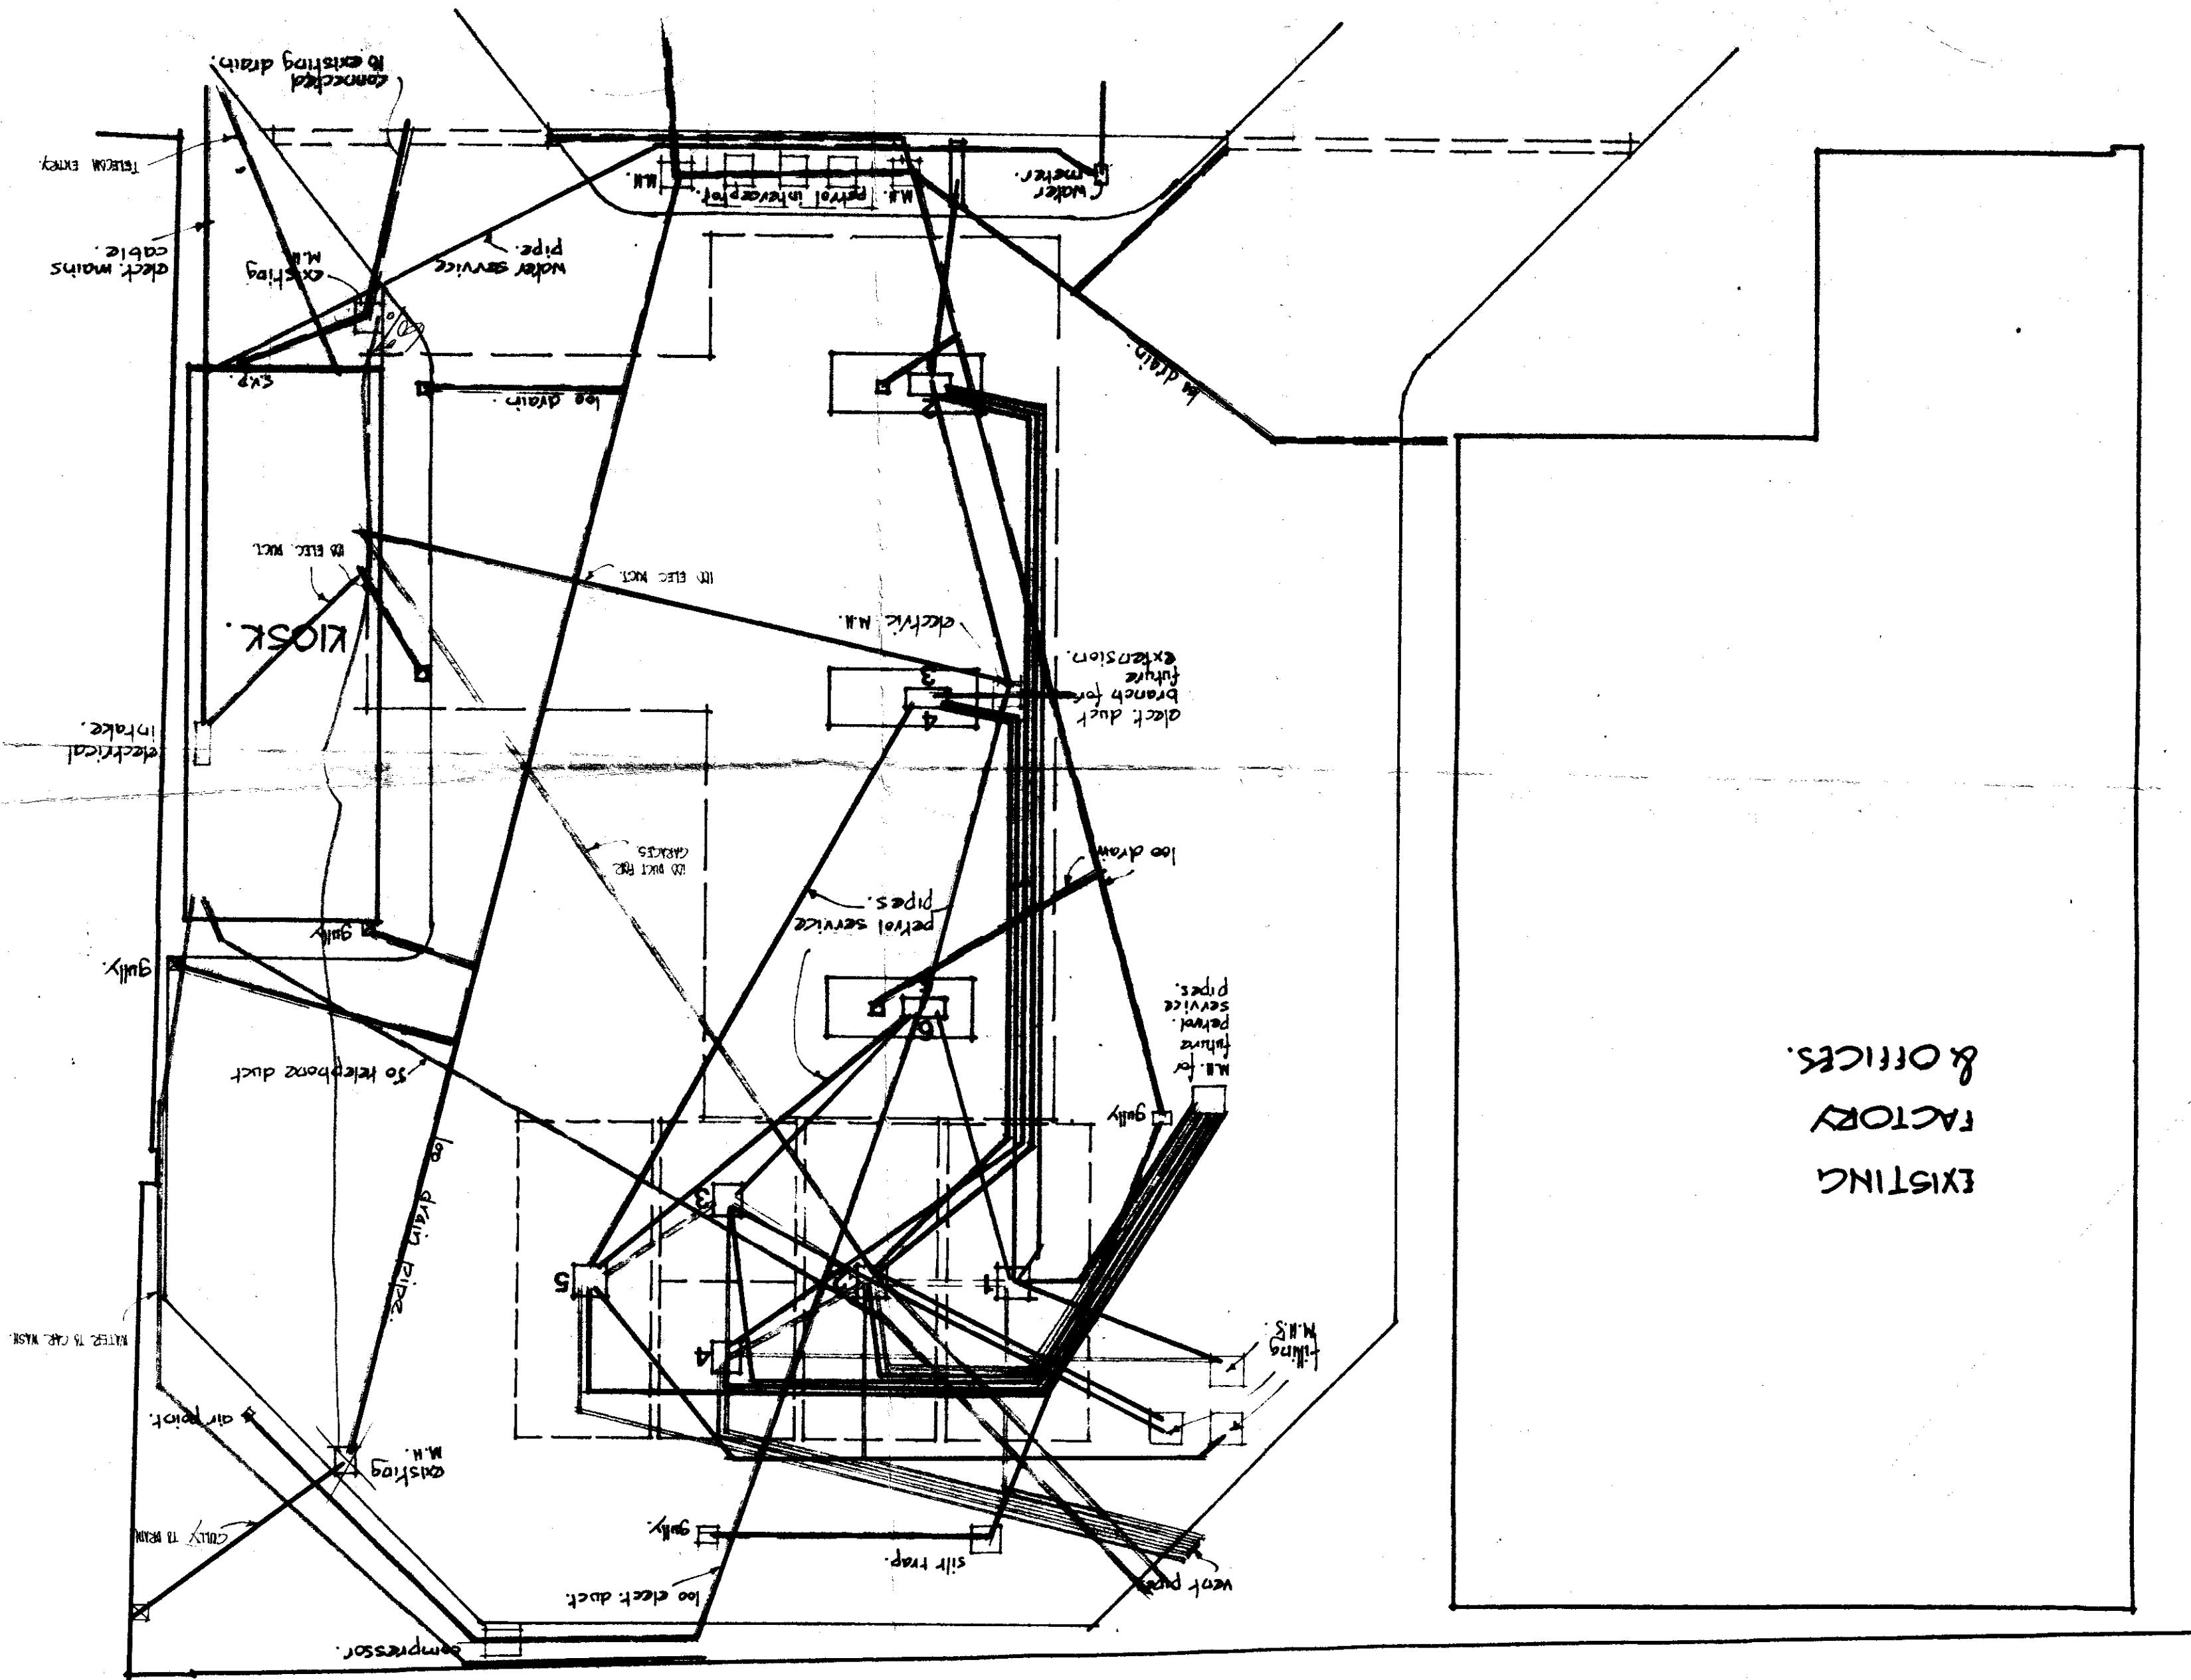

EXISTING
FACTORY
& OFFICES.

All work to be carried out in accordance with the requirements of the Building Regulations, all relevant B.S. Specifications, Codes of Practice, Local and Service Authority Byelaws, and in compliance with the Local Authority approvals.

Contractors must verify all dimensions on site before commencing any work or making any shop drawings.

Written dimensions should be taken in preference to scaled-off dimensions.

Tanks
1 unleaded
2 four star.
3 four star.
4 super unleaded.
5 Derv.

ELECTRIC
WIRE
BRNAGE
TELEPHONE
TUBES
FOUR STAR
DERV.
UNLADED
SUPER UNLADED