




NOTE TO ALL CONTRACTORS: DO NOT SCALE FROM THIS DRAWING

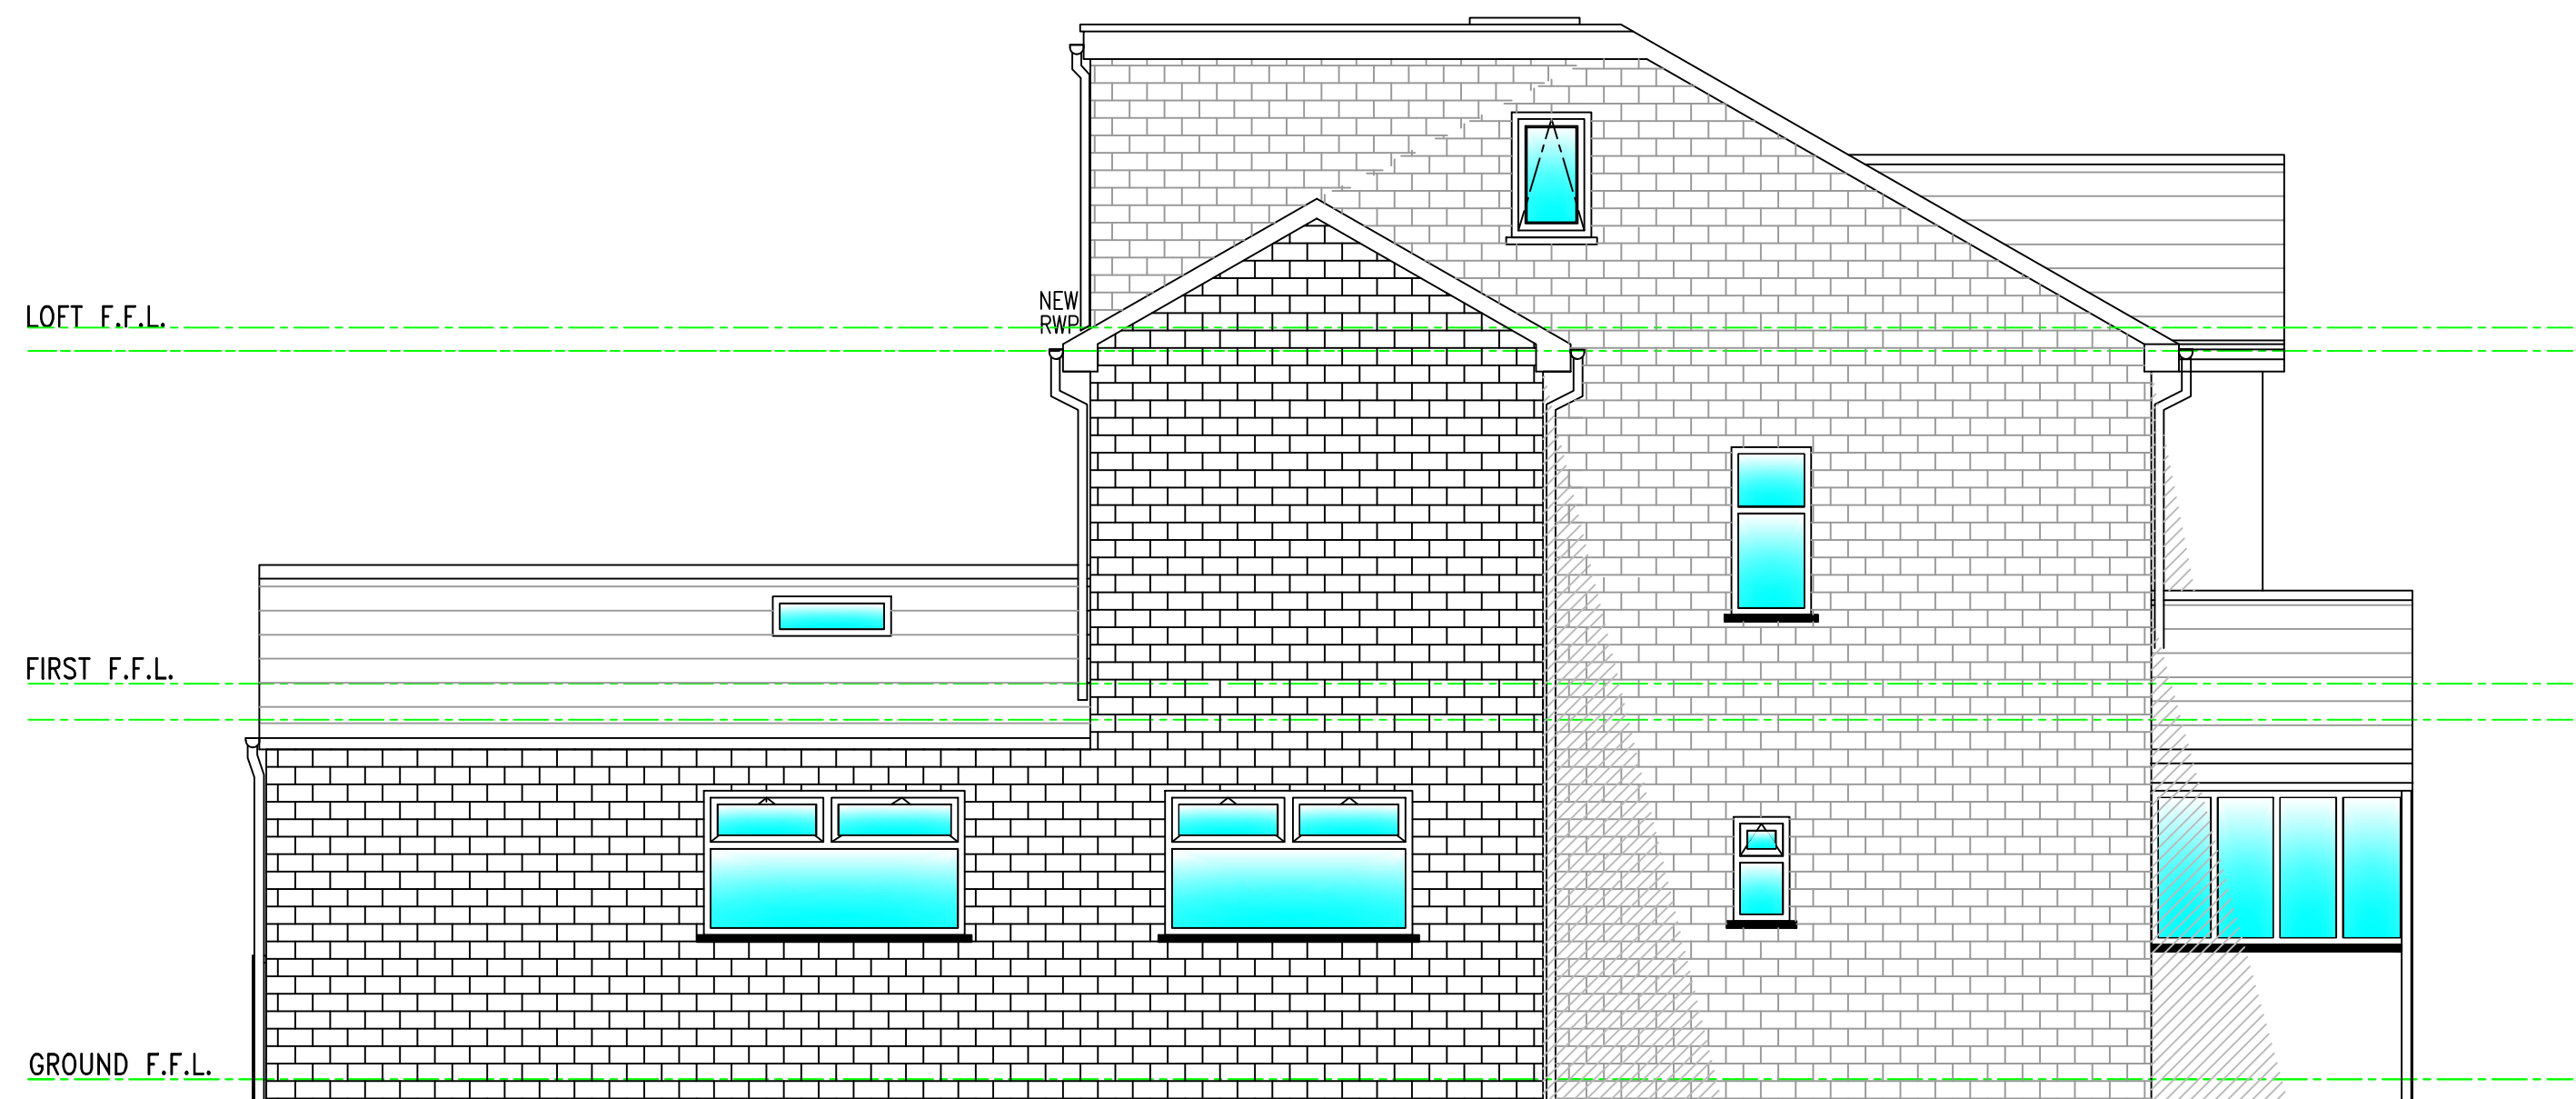


As Built Side Elevation A 1:50 @ A1
(post approved)

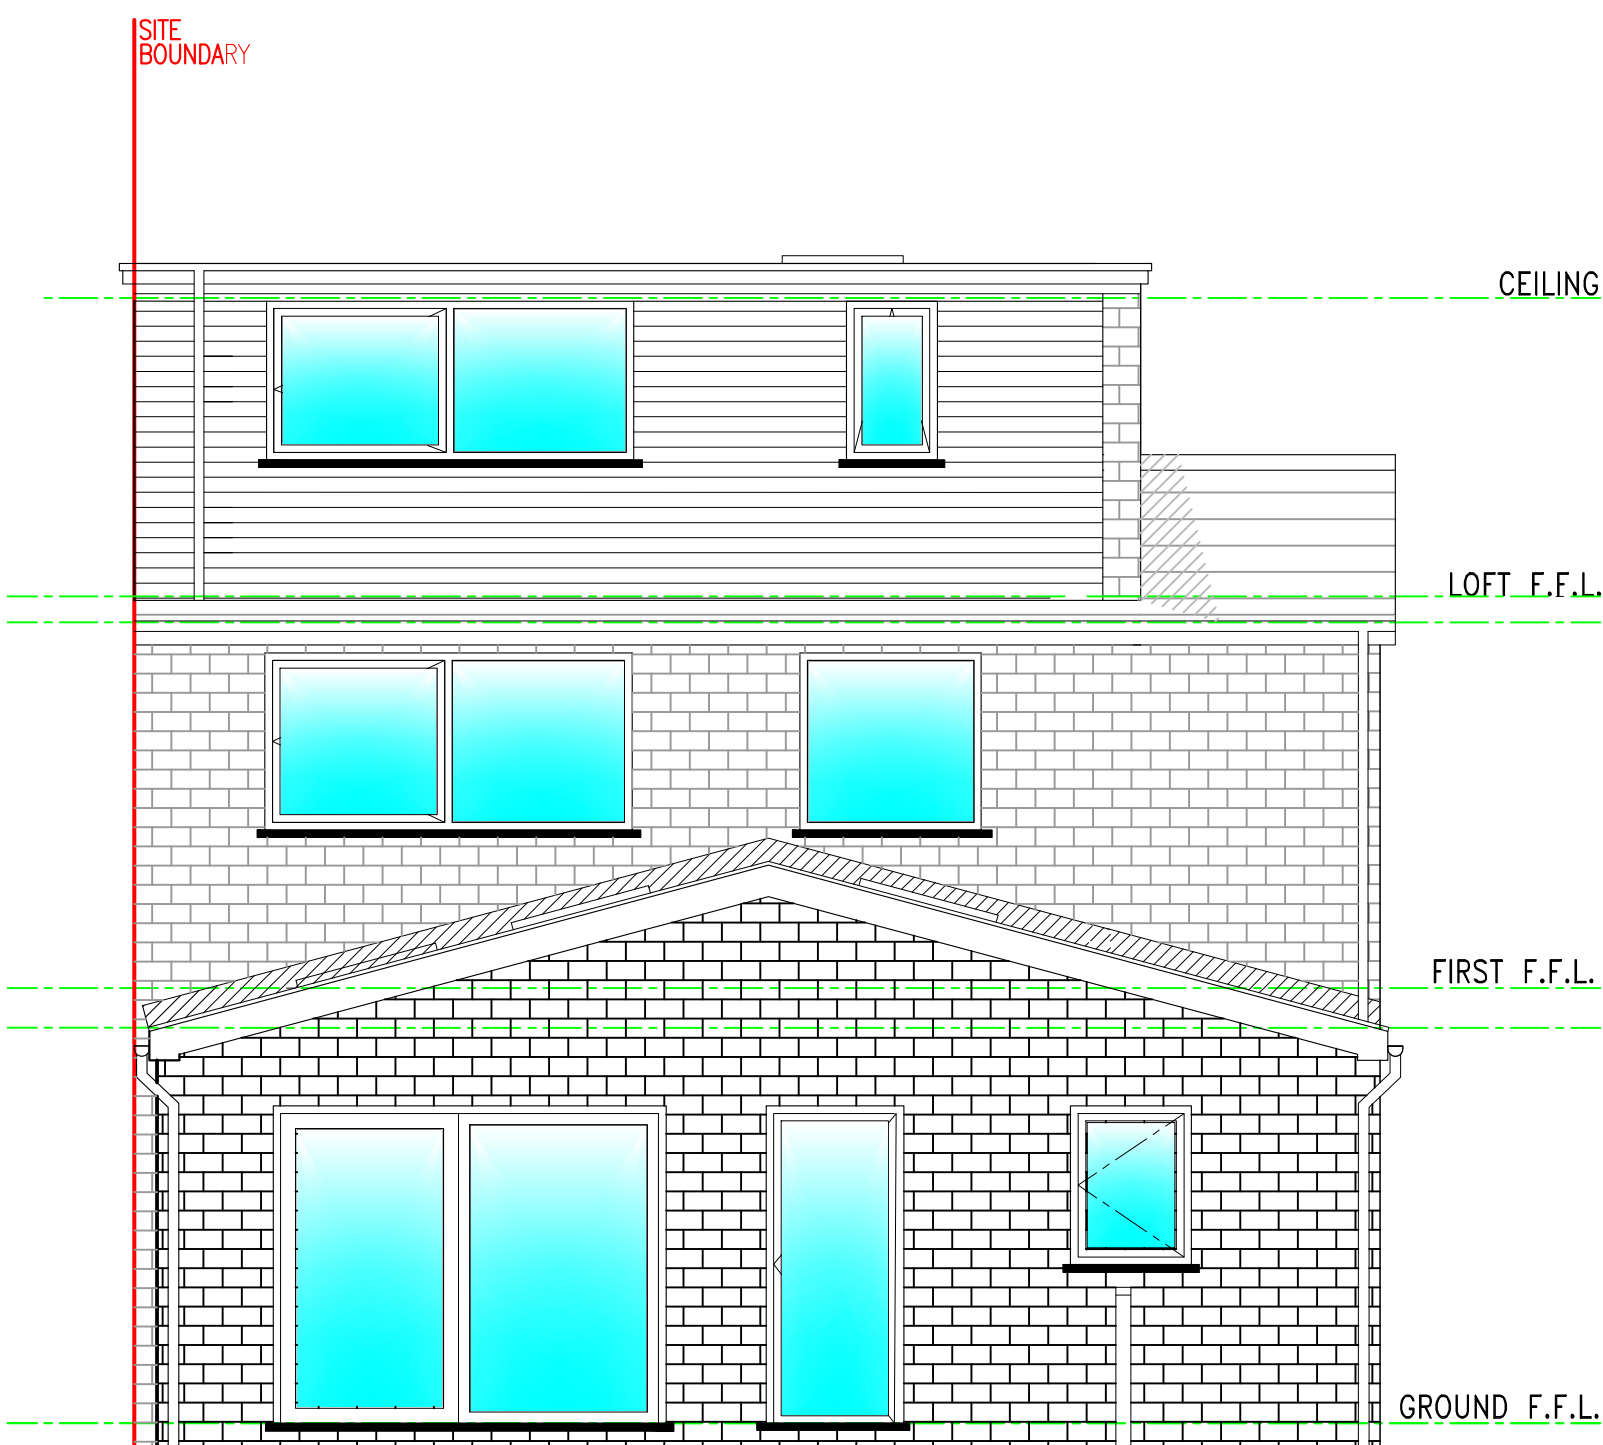

As Built Rear Elevation 1:50 @ A1
(post approved)

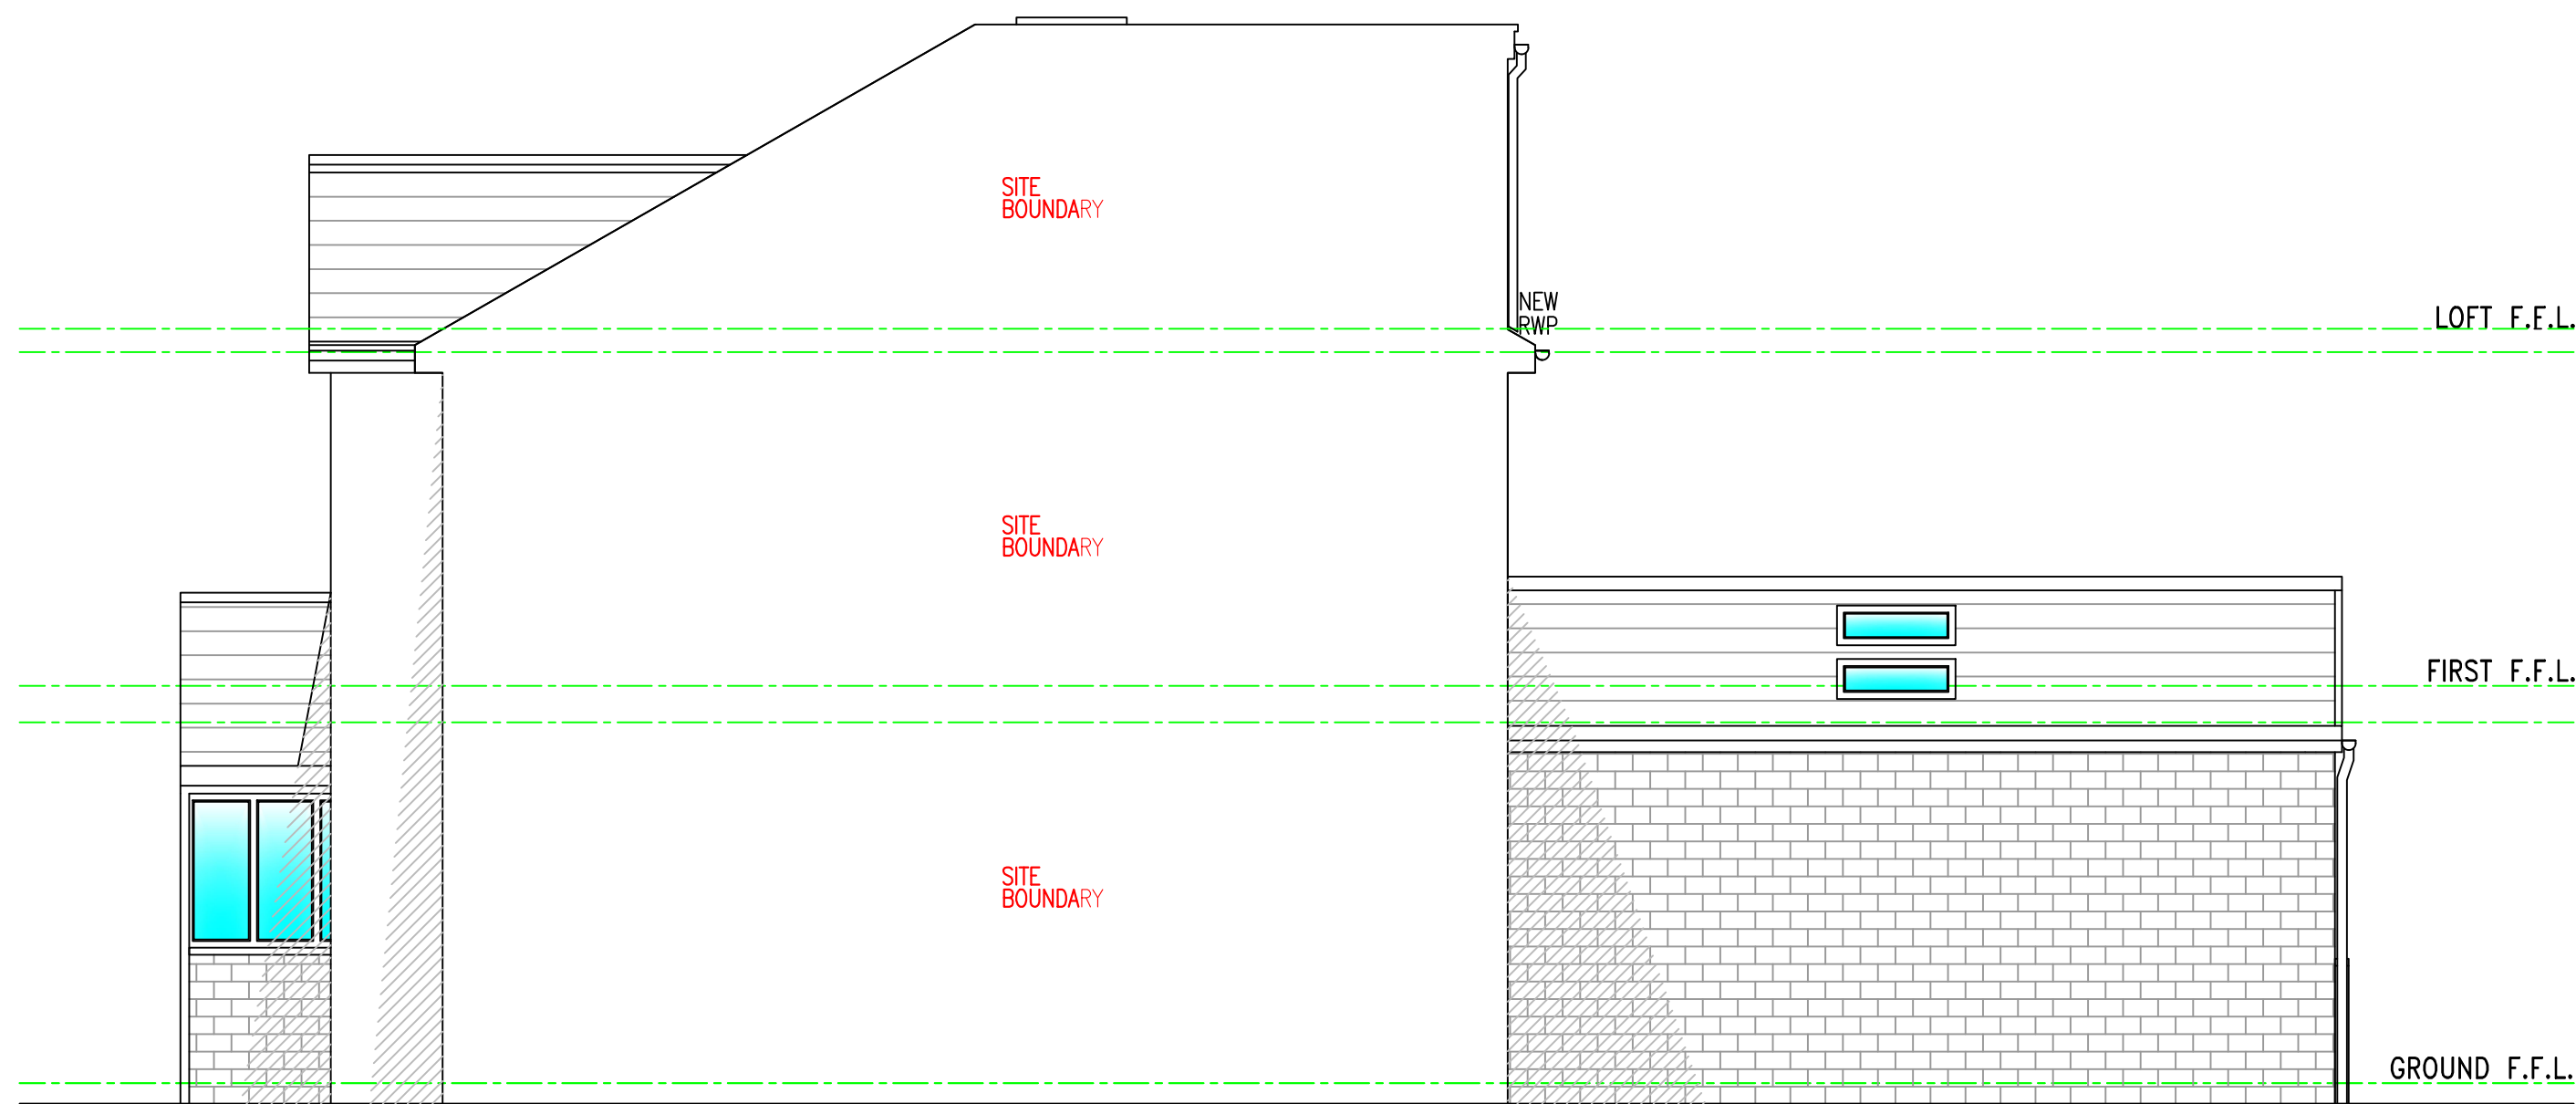

As Built Side Elevation A 1:50 @ A1
(post approved)

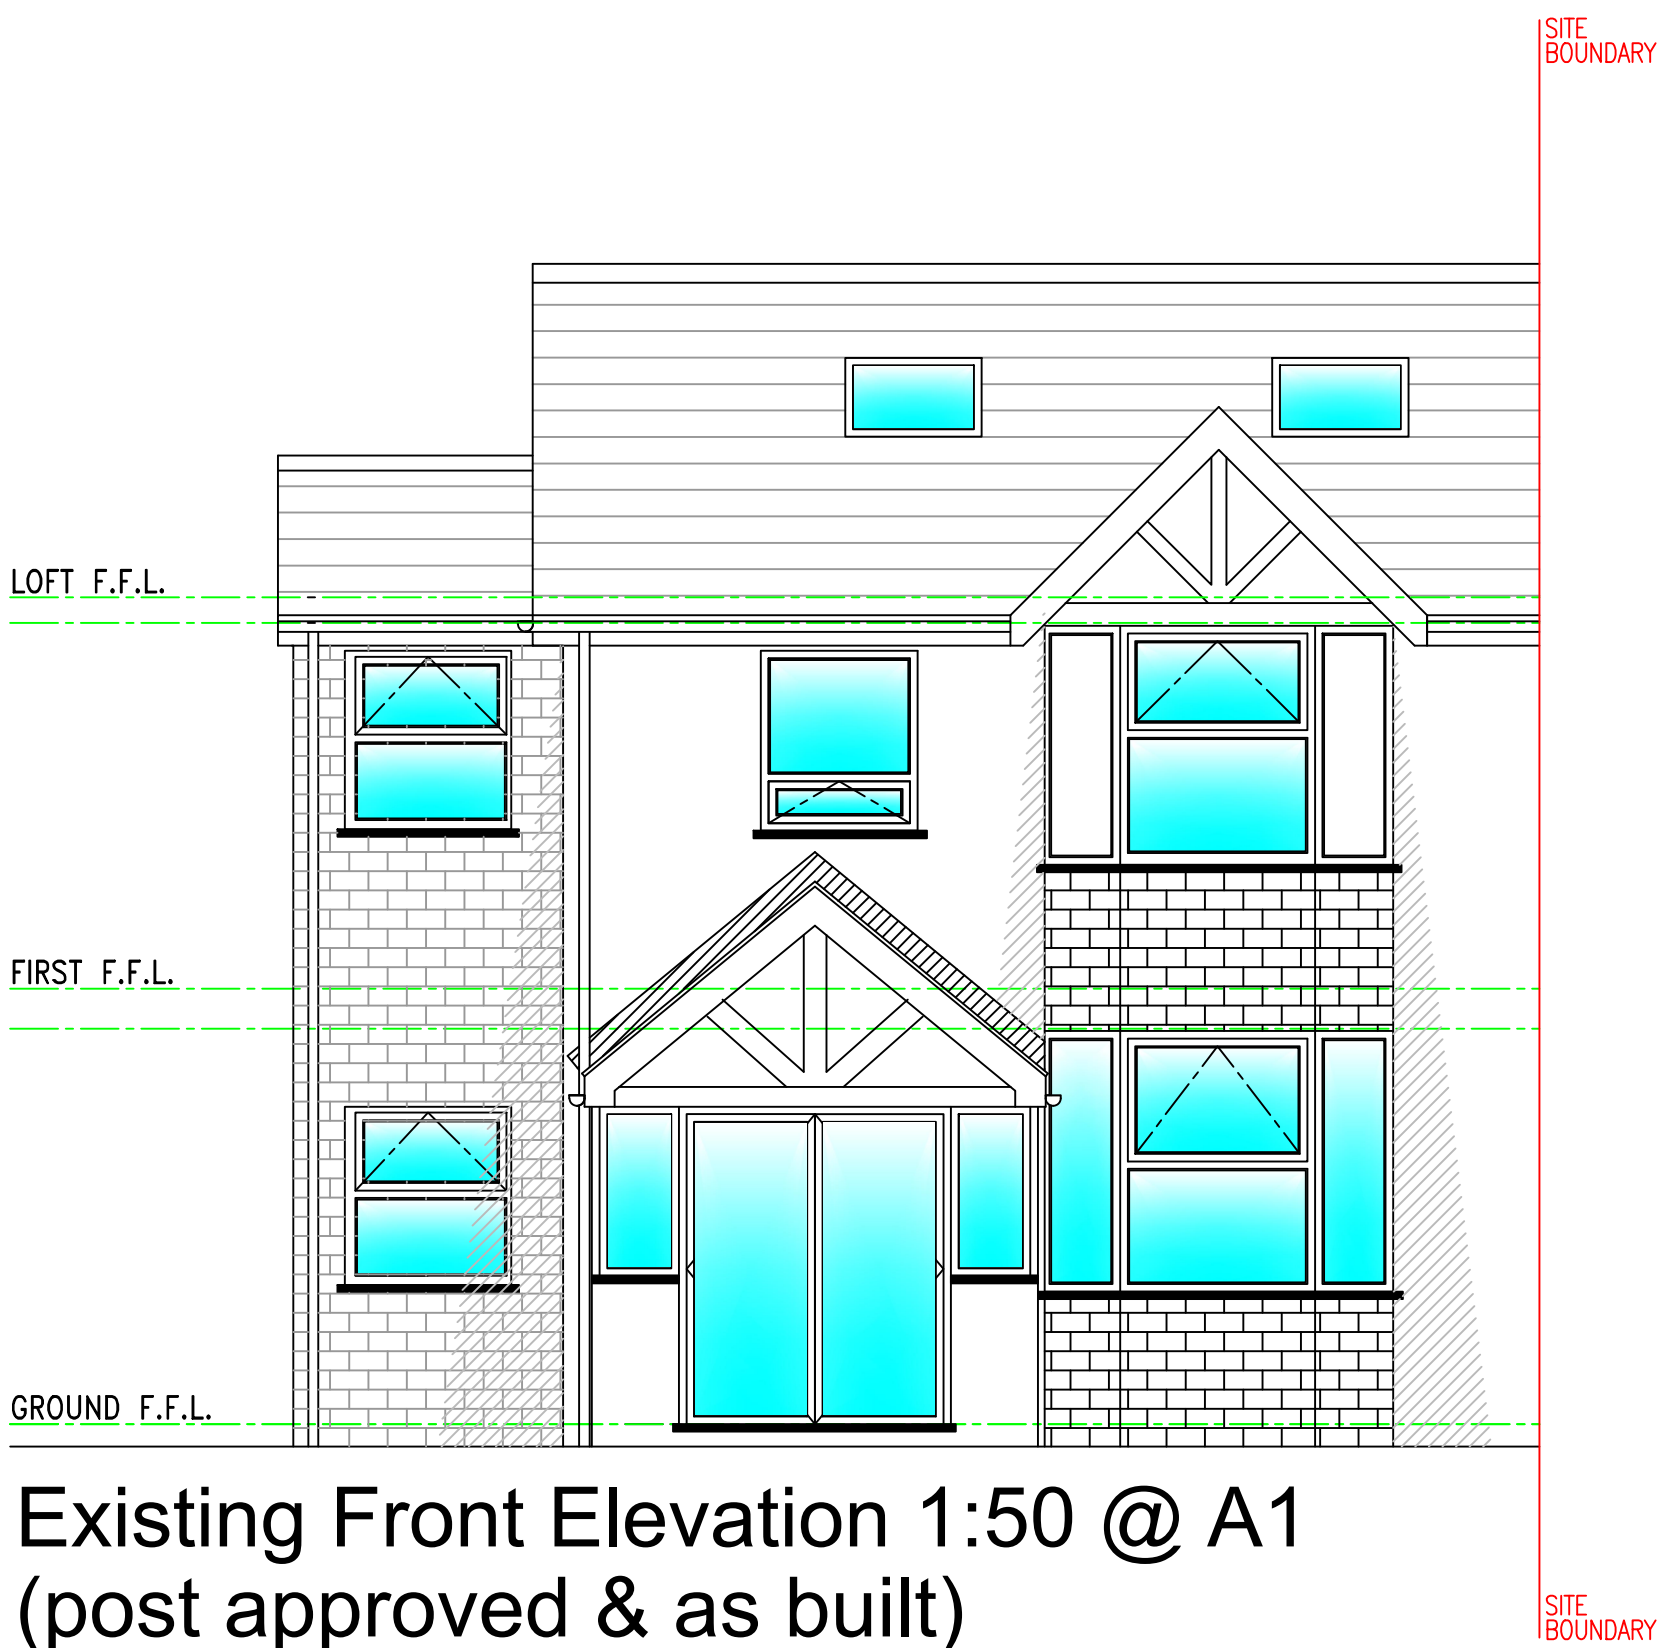

Existing Front Elevation 1:50 @ A1
(post approved & as built)

www.nufitdesign.com

ADDRESS

37 old hall lane, manchester

PROJECT

proposed dormer changes

REV.

REVISION DETAILS