





1:100 - NE View of Extents of Elevation

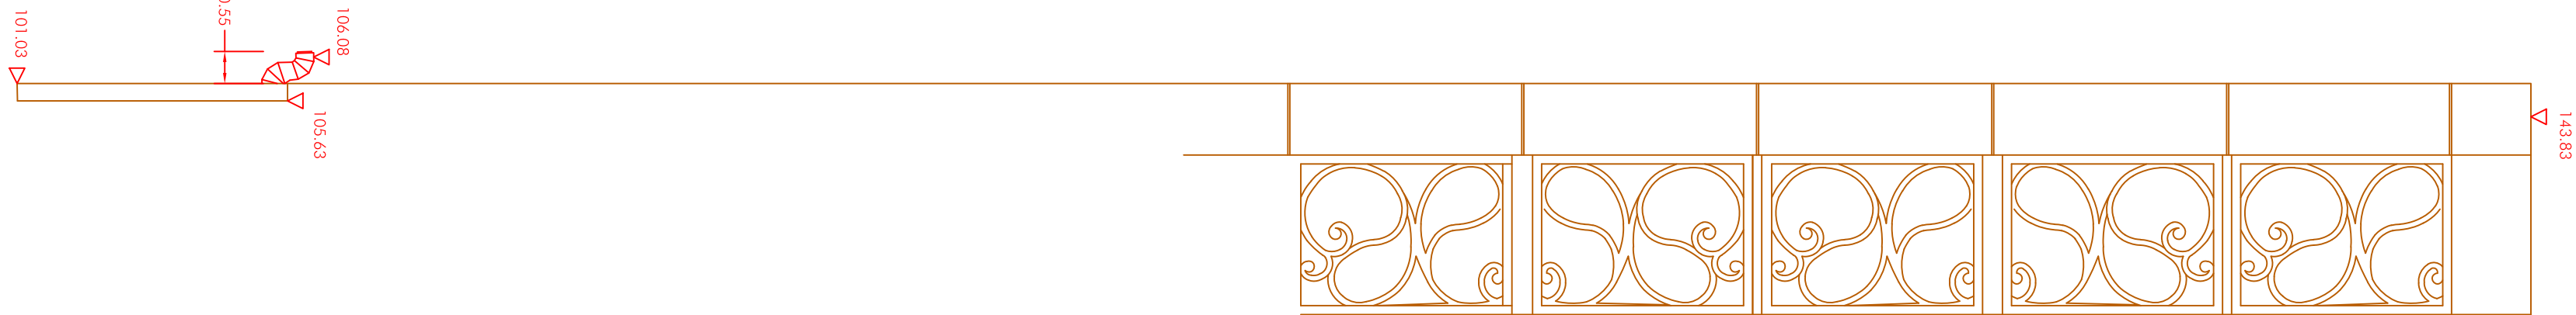

Arbitrary Datum 95.00 m



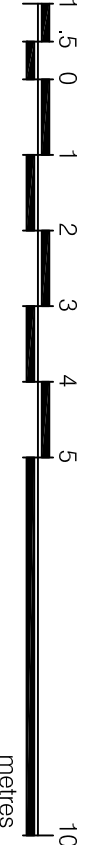


1:50 - NE View of Flue as installed

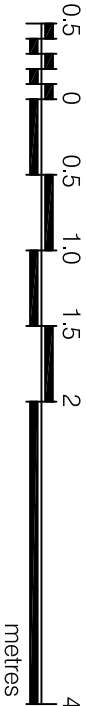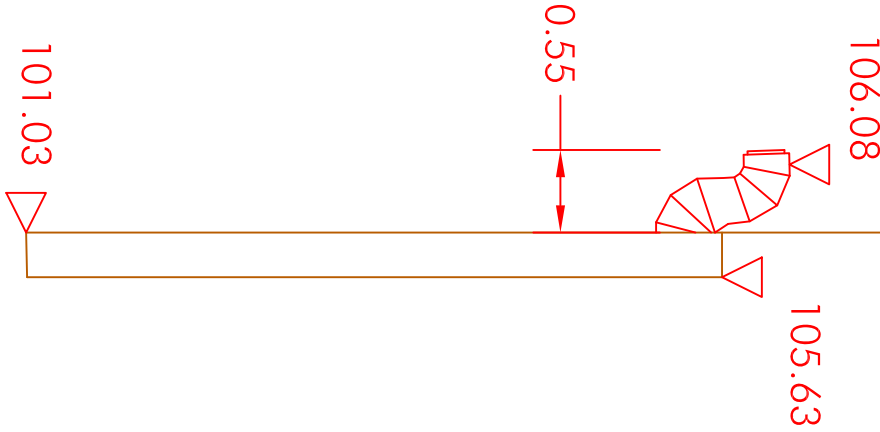

1:50 - NE View of Top of Elevation

143.83

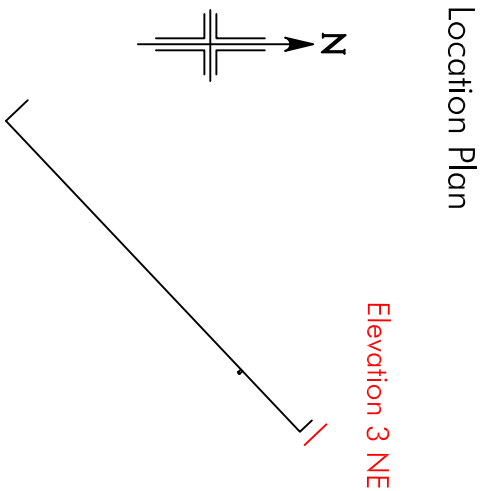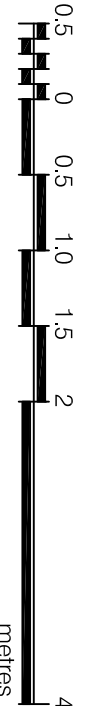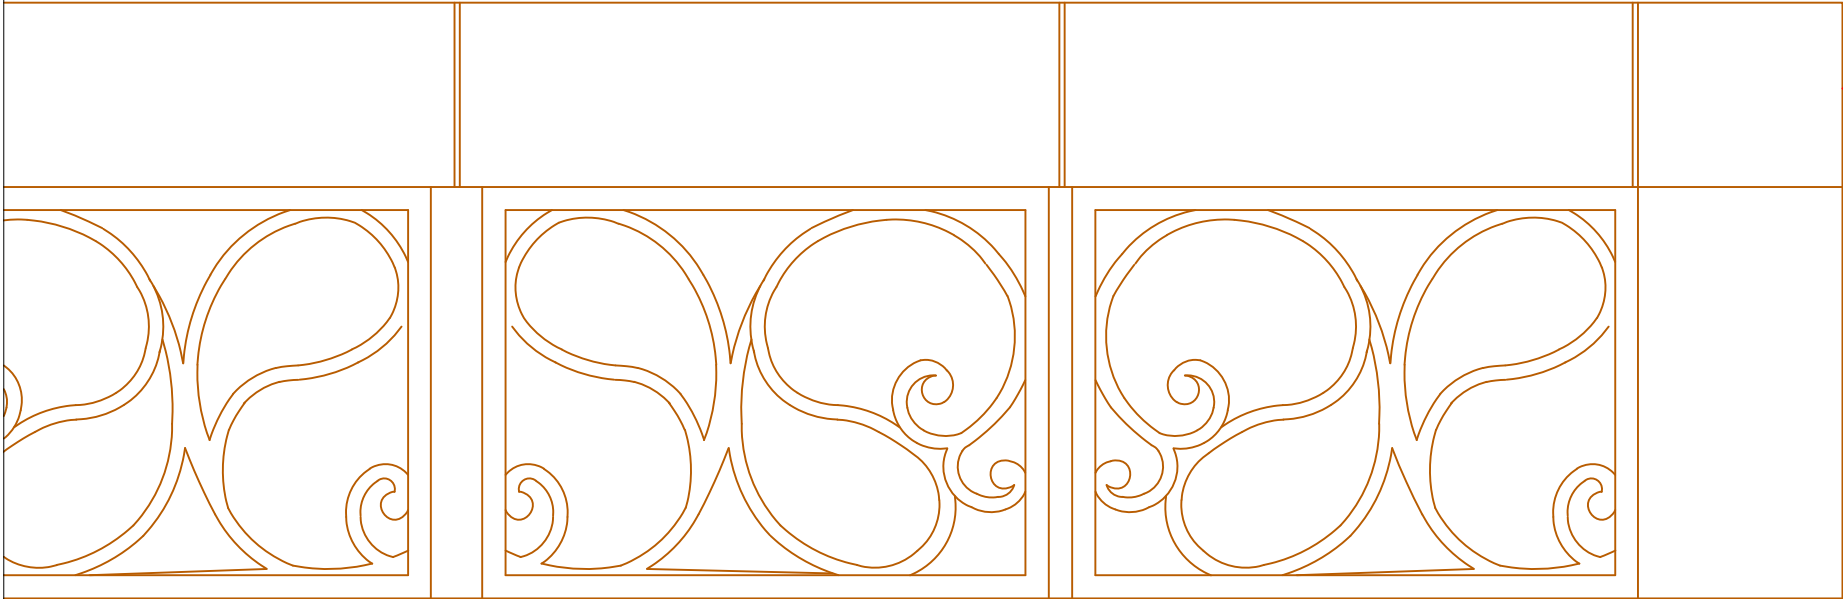

CBRE

CBRE Limited, 5 Market Court, 10 Deansgate, New, London EC4A 3DF

Southbound (2007) 182 2000 Fax: (2007) 182 3007 Web: www.cbre.com

Project: 2 St Peters Square

Address: 2 St Peters Square

Manchester

M2 3AA

Drawing: NE - Elevation 3

As Existing

Date: 21-07-2022 Project No: 0476041

Scale: 1:100@A1 All Scale: 1:50@A1

Drawn: MS Checked: JCS

Drawn No: 0476041-E3-NE

Project Status: FINAL