

NOTES:

DO NOT SCALE. USE FIGURED DIMENSIONS ONLY.
All dimensions to be checked on site.
Drawing to be read with all relevant Architectural, Interiors, Structural, M&E, Drainage/Public Health, Landscape, Civils and Interiors drawings and specifications. Any discrepancies between consultant's drawings to be reported to the Architect before any work commences.
The Contractor's attention is drawn to the Health & Safety matters identified in the Health & Safety plan as being potentially hazardous.
These items should not be considered as a full and final list.
The Work Package Contractor's normal Health & Safety obligations still apply when undertaking constructional operations both on and off site.
Define Architects take no responsibility for the location of legal boundaries indicated on this drawing and advise a separate drawing be completed by a specialist surveyor in order to establish exact boundaries.
DWG files provided for information only. Refer to PDF record.
The copyright of this drawing is held by Define Architects Ltd.
Not to be used for any purpose without consent.

Note

Correspondence regarding the permitted development rights was undertaken on 02/06/21 between Define Architects and case officer, Constance Phillips, Planning Technician South Manchester City Council

DEFINEARCHITECTS.CO.UK

Suite 1, Ground Floor
65-67 Lever Street
Manchester
M1 1FL

+44 (0)161 237 1133
mail@definearchitects.co.uk

define /

PROJECT

2 Walsingham Avenue
Didsbury

DRAWING TITLE

Permitted Development
Existing & Proposed Elevations

REV
A

DATE
09/11/2021

NOTES
Issued for Permitted
Development

DRAWN BY
AT


CHECKED BY
GW

JOB NO.
033

STATUS
PERMITTED
DEVELOPMENT

DRAWING NO.
033_PLN_300


REV
A

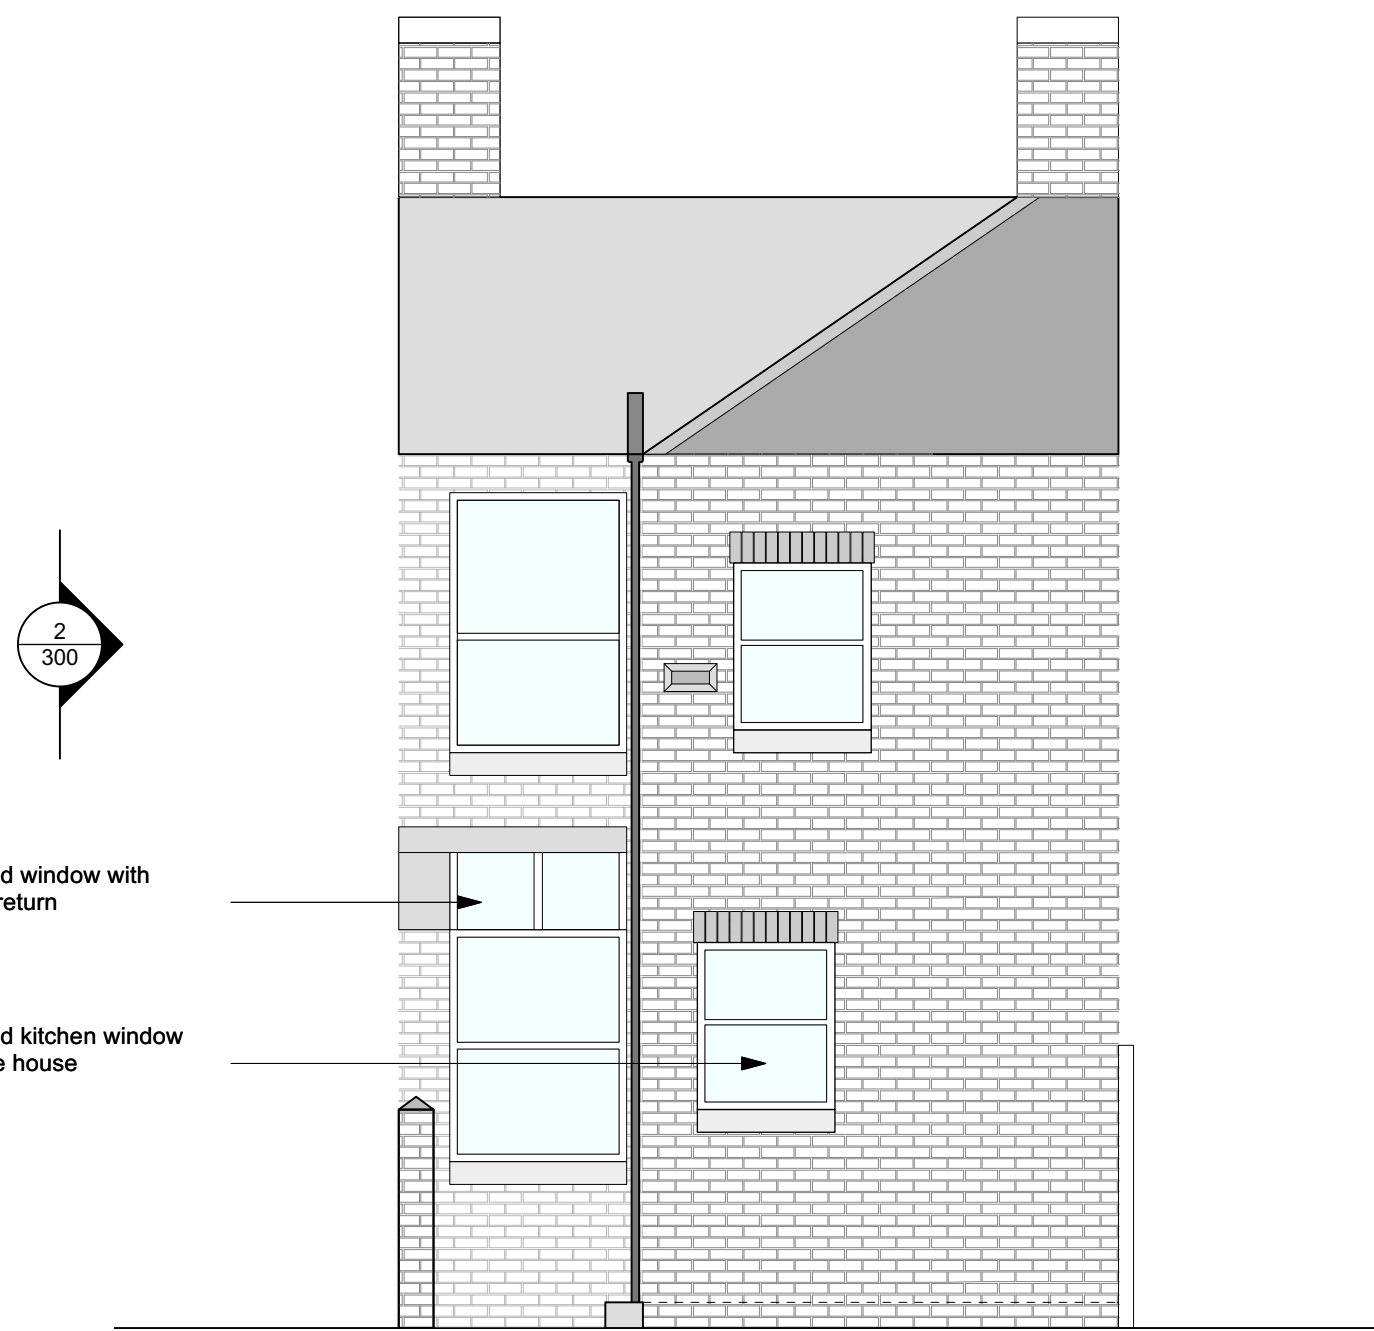

1 Existing South West Elevations



2 Existing North West Elevations

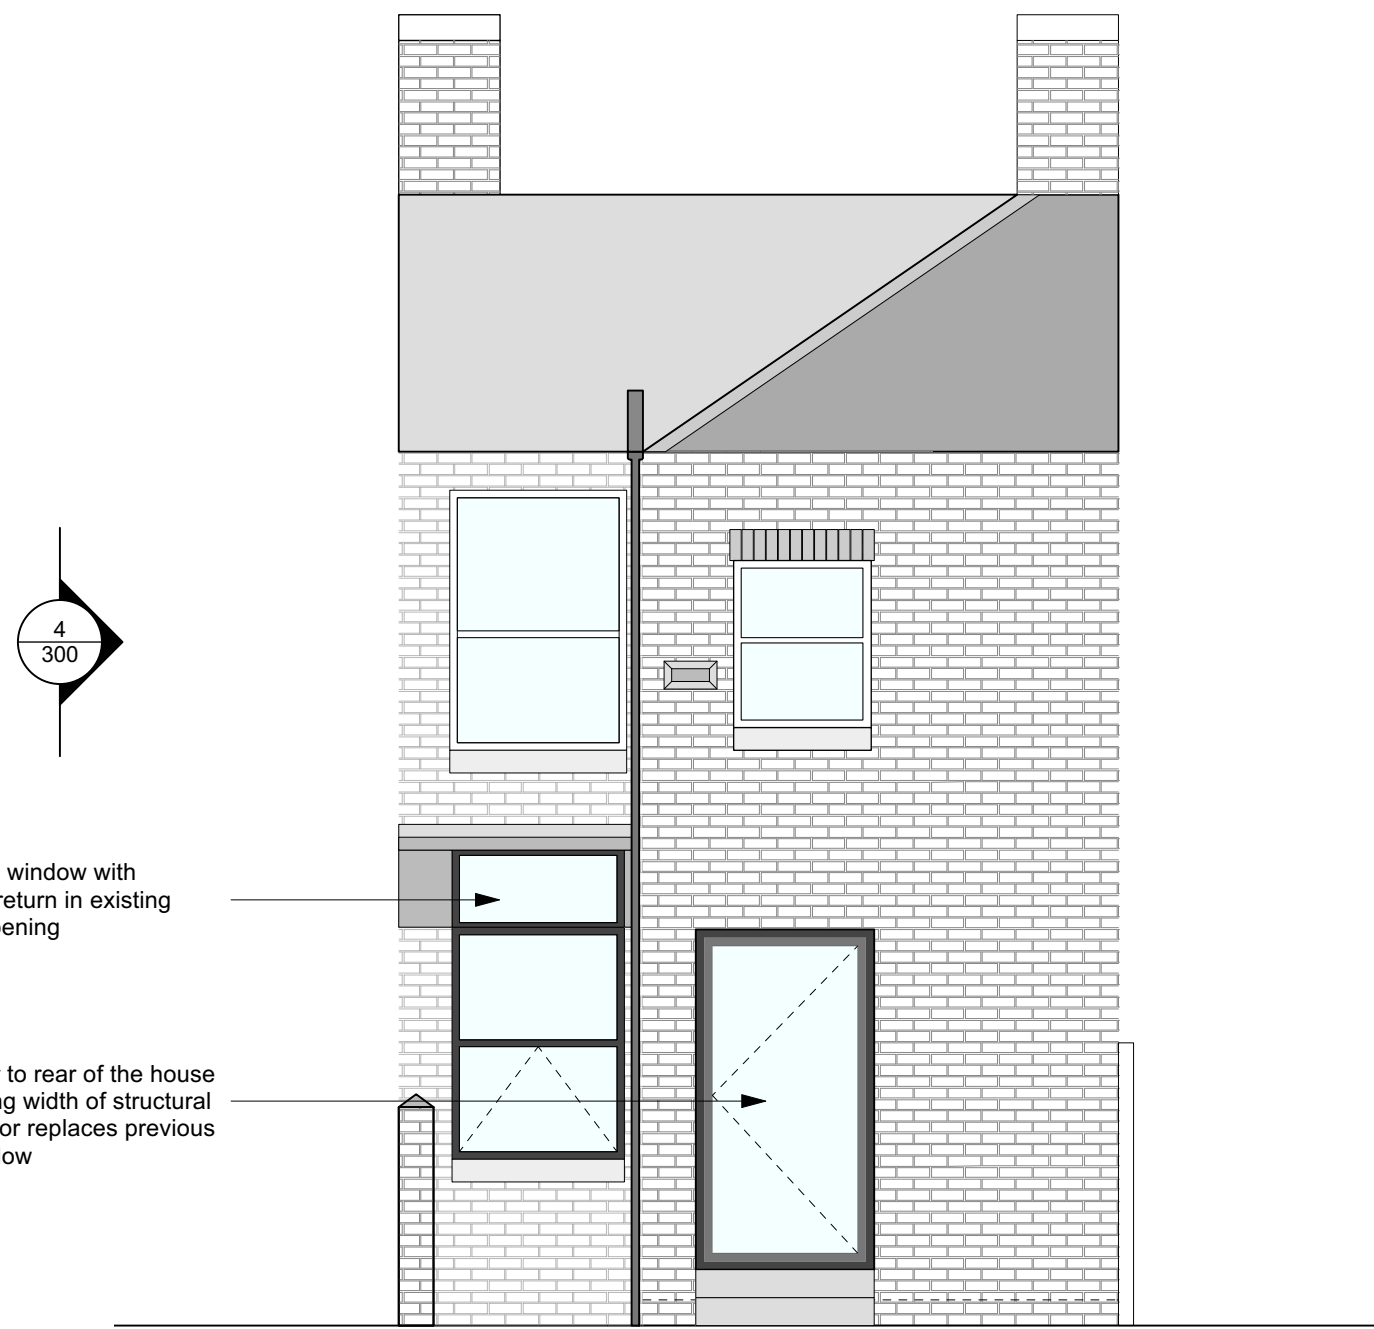

3 As-Built South West Elevations



4 As-Built North West Elevations