





PROPOSED FRONT ELEVATION



PROPOSED GABLE ELEVATION

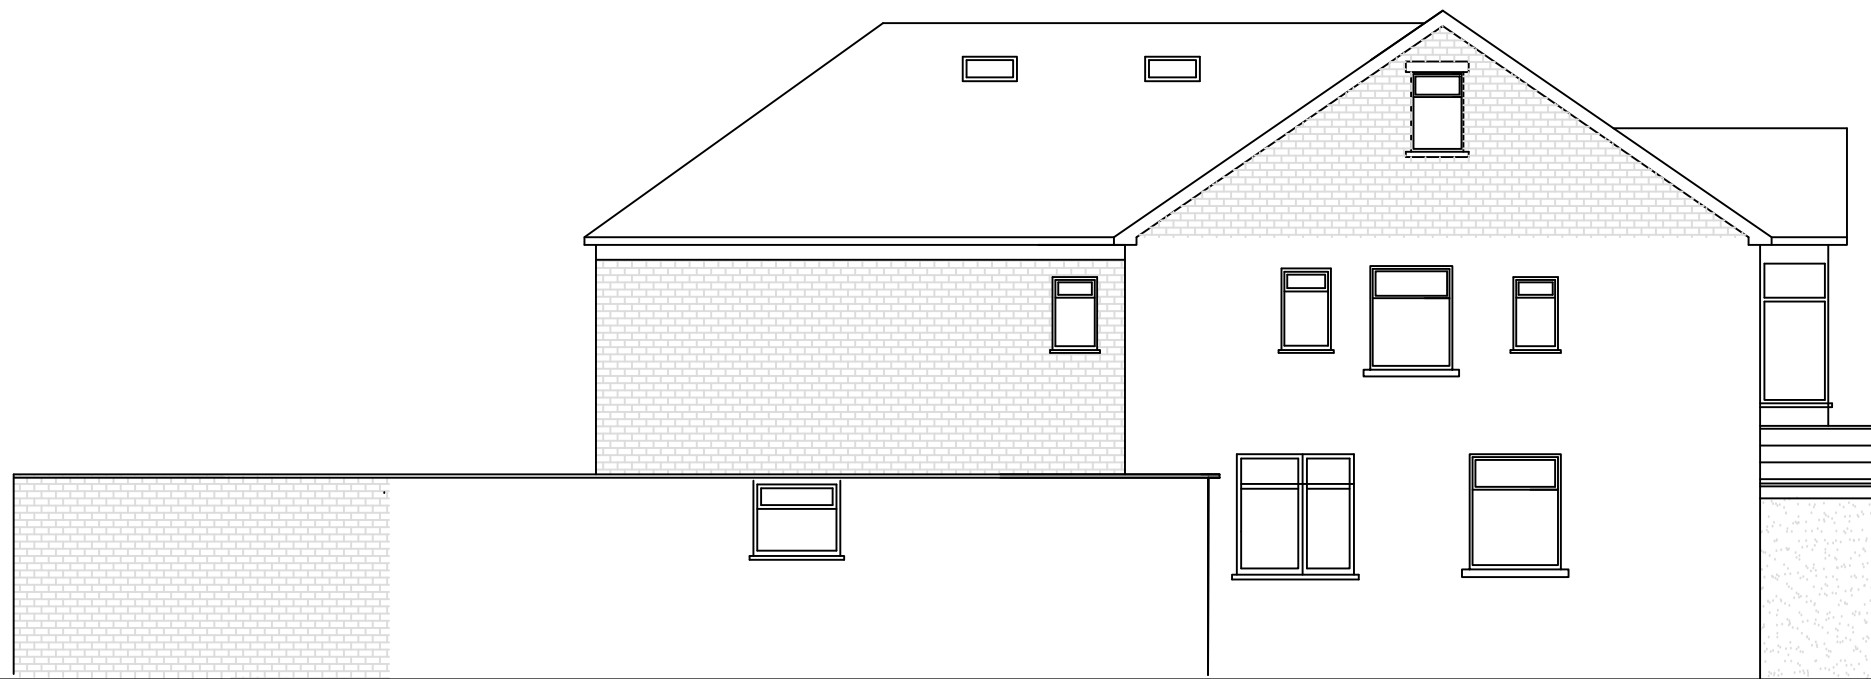

PROPOSED REAR ELEVATION

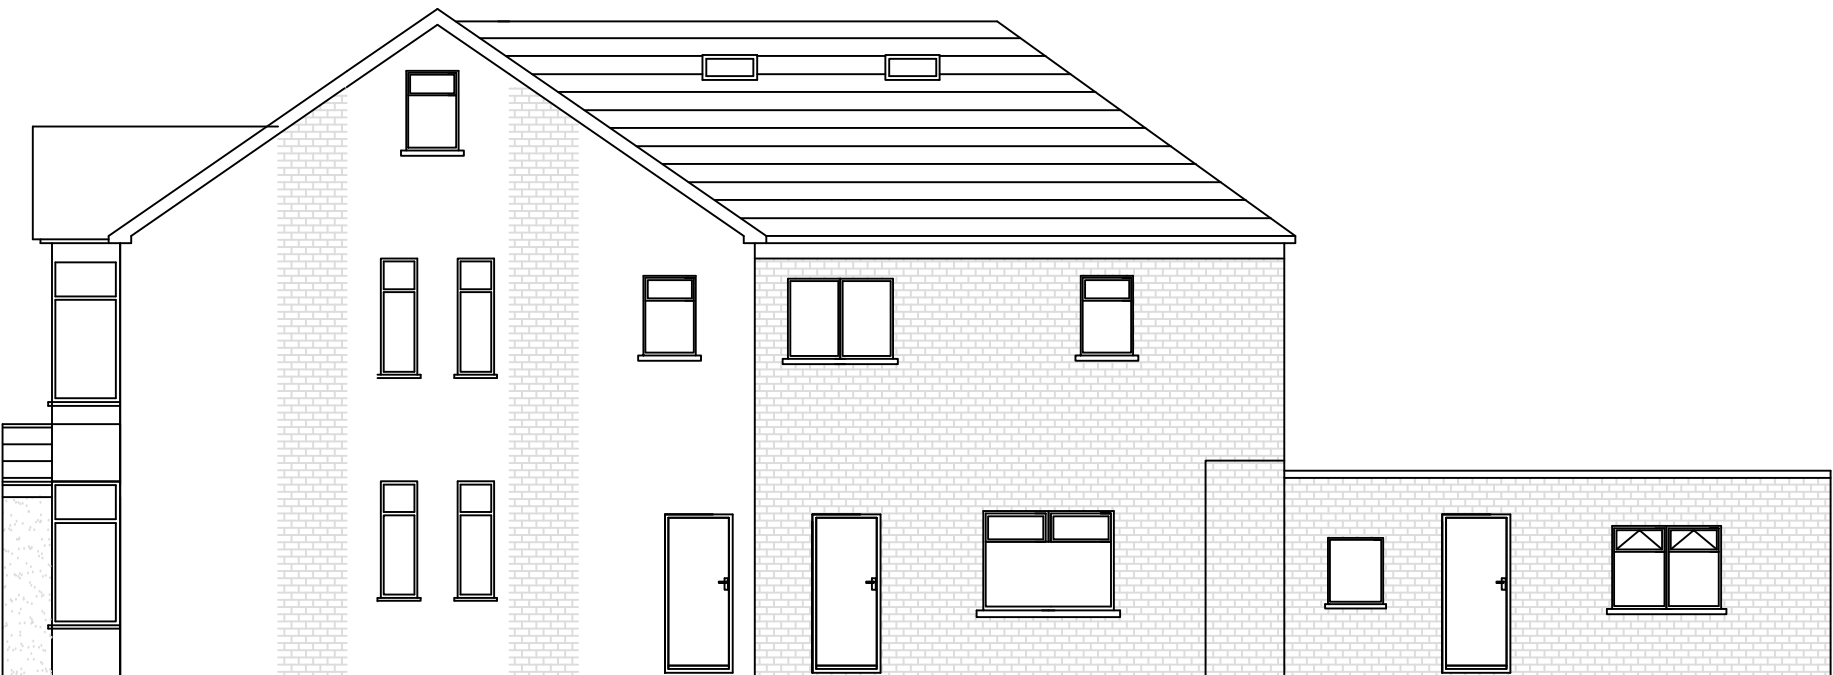

PROPOSED SIDE ELEVATION

Date	Rev.		Initials	
11/11/21	A.	Amended first and second floor plans	RA	
10/1/22	B.	Porch added	RA	
15/3/22	C.	Amendments to openings on side facing No.140	RA	
15/10/22	D.	As built drawings	RA	
3/11/22	E.	As built amended	RA	

This drawing is subject to copyright and is not to be reproduced in part or whole without approval.
Figured dimensions take precedence over scaled measurements from the drawing. All dimensions and drawings to be checked by Client and Contractor and discrepancies clarified with the Client prior to commencement.
The whole of the works to comply with Planning Approval & Conditions and current Building Regulations. No work to commence without Planning & Building Regulations approval.
The client must ensure the project complies with the Construction Design and Management Regulations 2015
The Client should ensure consent from any landowner or interested party is obtained, as well as compliance with Party Wall Act 1996

Notes

RAD

The White House,
42-44 Chorley New Road,
Bolton
BL1 4AP

Tel : 01204 322196
Fax : 01204 214110
Mob: 07790 361104
Email: rahatanwar@hotmail.com

Project	142 MANCHESTER ROAD, CHORLTON MANCHESTER M16 0DZ	Client	
		Drawn	RA
		Date	OCTOBER 2021
		Scale	1:100 @ A1 / 1:200 @ A3
Title	PROPOSED ELEVATIONS	Drawing Number	RAD/2513/21/3/RevE