




This plan is issued by Electricity North West Limited. Unless otherwise indicated Electricity North West Limited cables are laid at depths in accordance with NJUG 1 (typically 450mm for Low Voltage & 600mm for 11kV cables in footpaths). 33kV/132kV cables are laid at depths as marked. The depths and positions of Electricity North West Limited equipment was accurate as shown when the equipment was installed. However, third parties may have altered the surface level & other reference data. Therefore Electricity North West Limited accepts no responsibility for the position of Electricity North West Limited equipment being different from that shown. No person, body or company, shall be relieved from liability for damage caused to Electricity North West Limited equipment by reason of being located differently to the indications on this drawing. Service cables are not necessarily shown but must be assumed to exist to all premises, streetlights and signs. There may be other Electricity North West Limited apparatus in the vicinity which is not indicated in the cable records. Other apparatus may also be present which is owned by a third party other than Electricity North West Limited. Reference should be made to HSE guidance HS (G) 47 "Avoiding Danger from Underground Services" and GS6 "Avoidance of Danger from Overhead Power Lines." Electricity North West Limited, registered number 2366949, registered office: 304 Bridgewater Place, Birchwood Park, Warrington, WA3 6XG. Based upon Ordnance Survey Digital Data with the permission of the controller of H.M.S.O. Crown Copyright Reserved Licence No. WU 100017892

Printed By: n397162
Date: 29-Apr-2020
X: 388518
Y: 397132
Scale: 1:1000

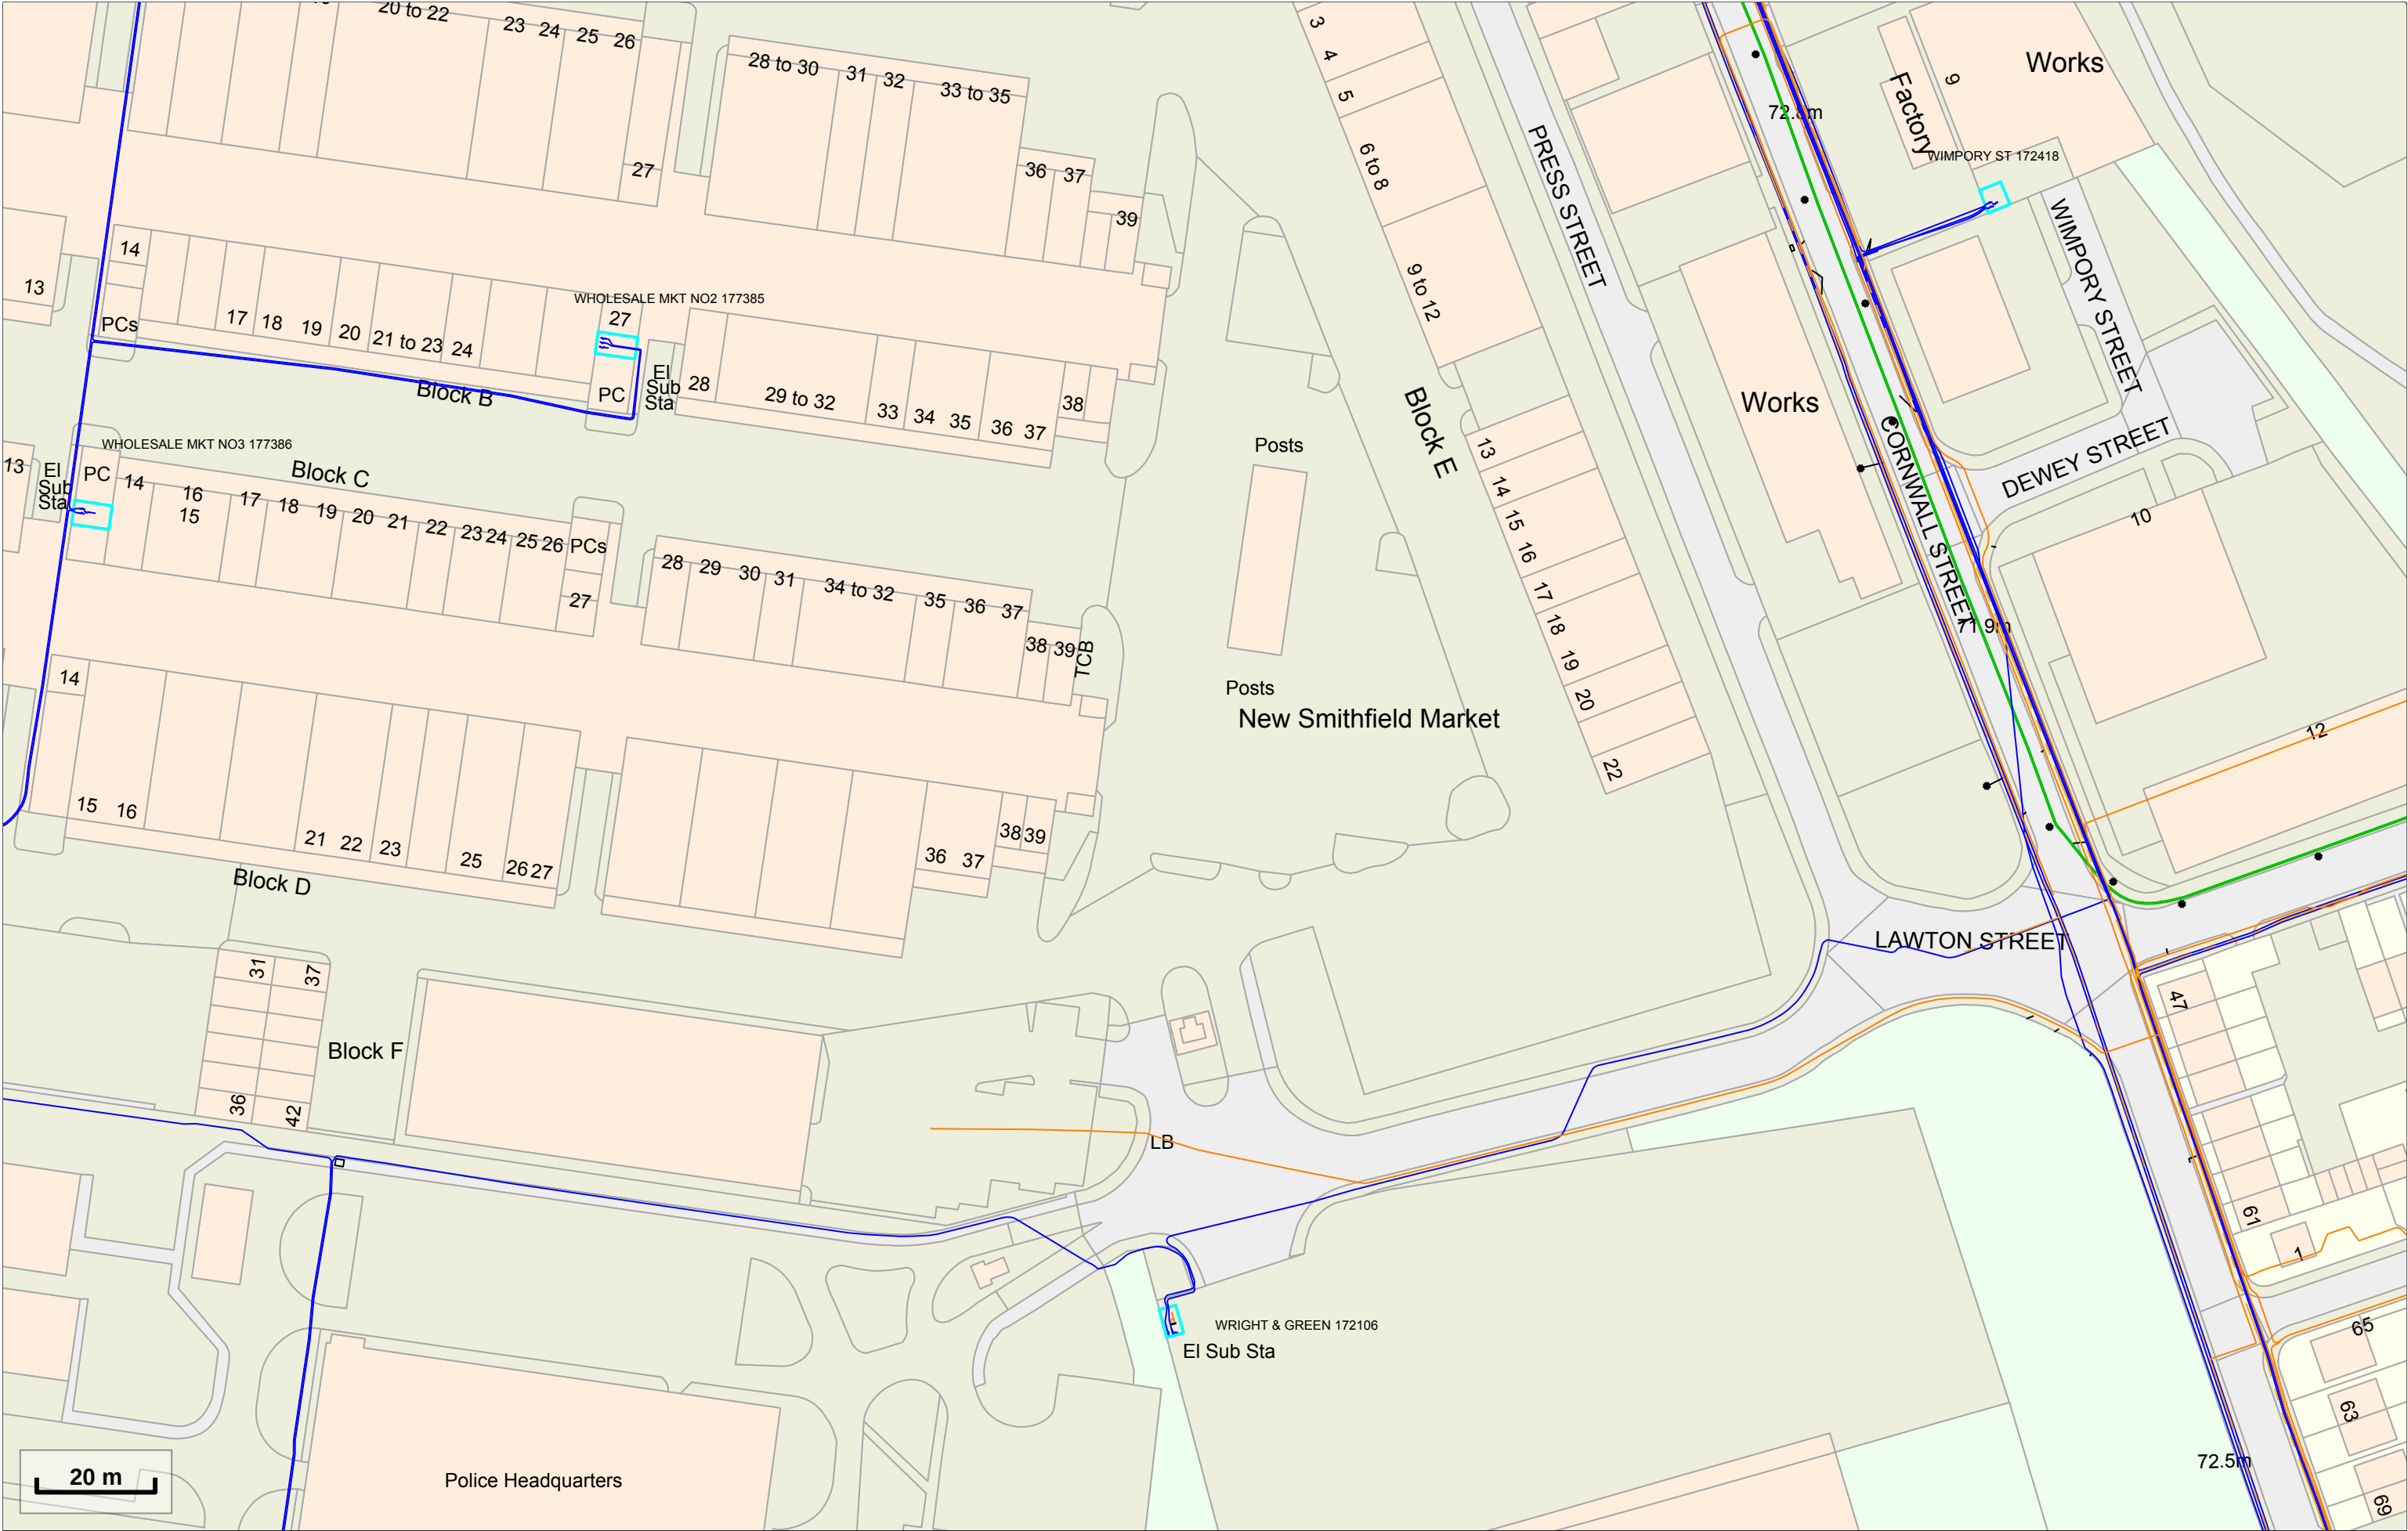