



GROUND FLOOR PRIOR TO EXISTING EXTENSION

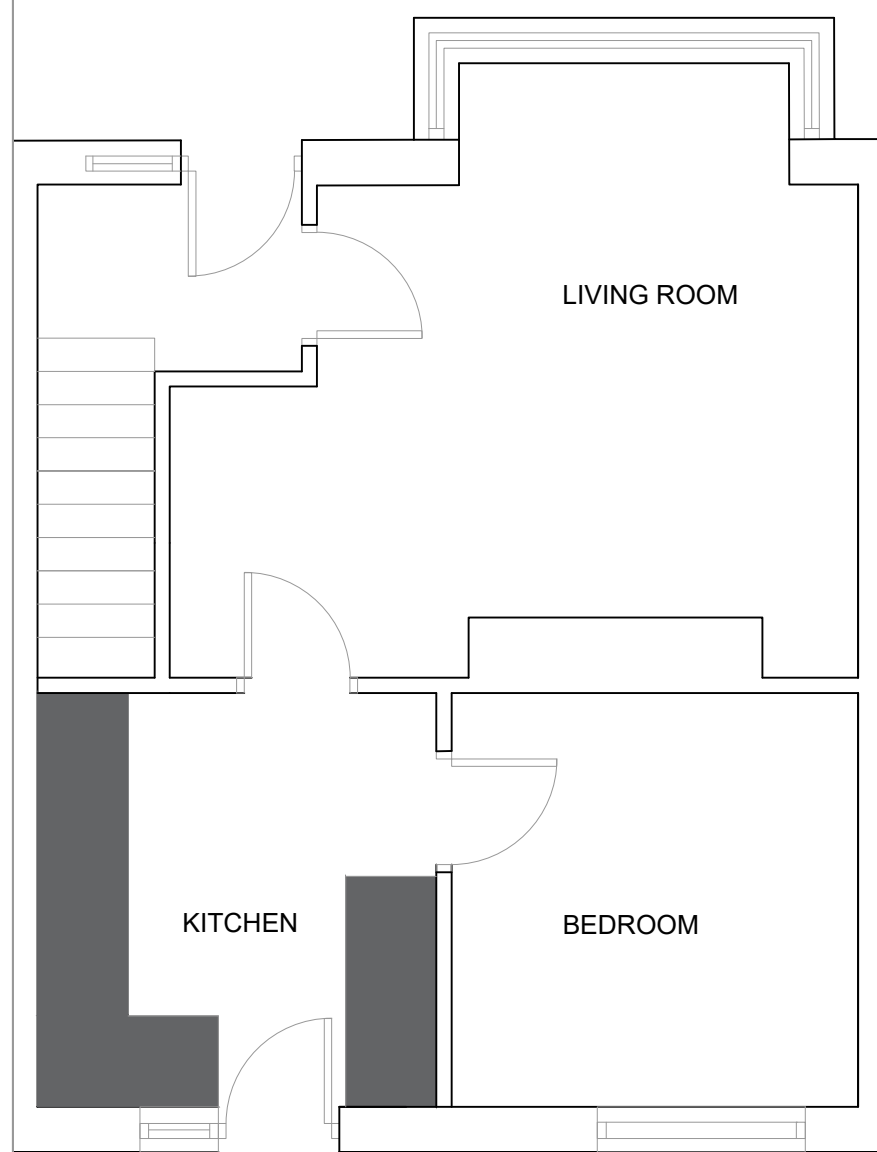

GROUND FLOOR EXTENSION AS BUILT

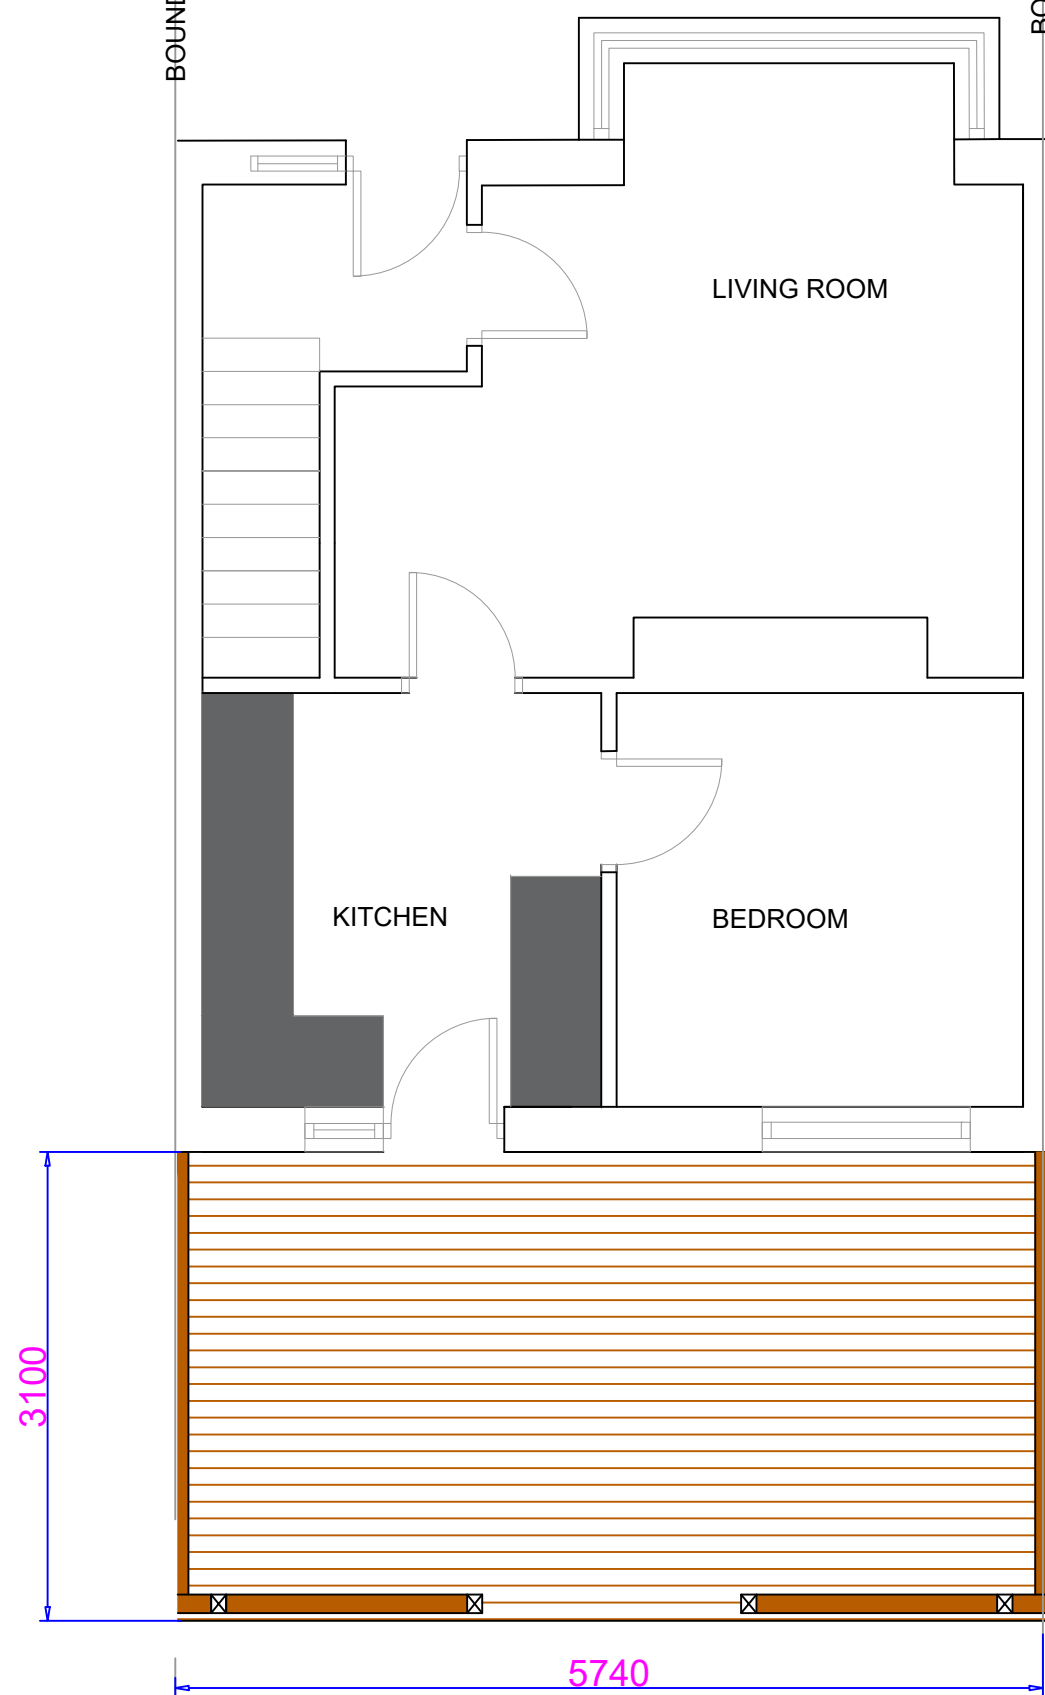


REAR ELEVATION PRIOR TO EXISTING EXTENSION



REAR EXTENSION AS BUILT




Wooden lattice climber to boundary both sides

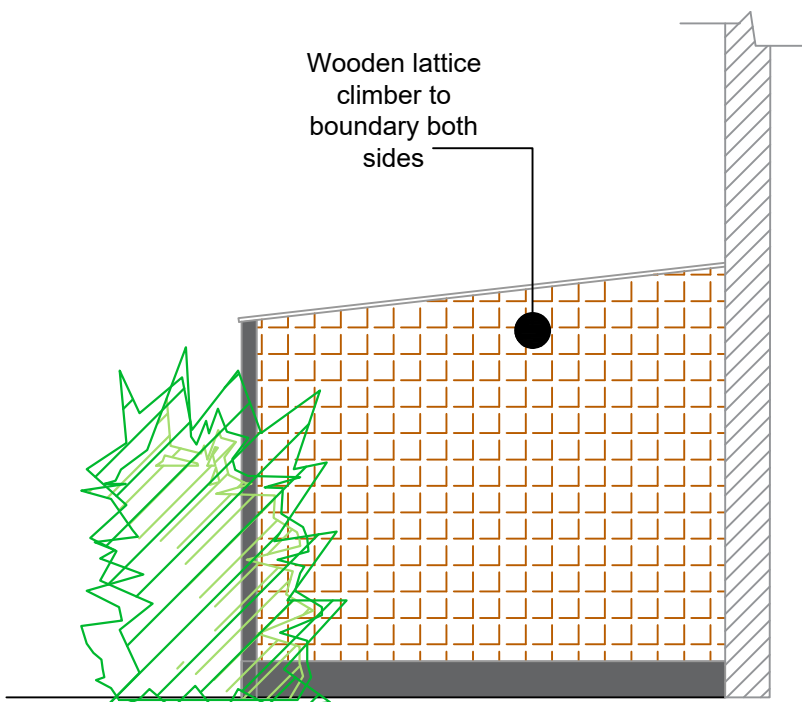

EXTENSION AS BUILT SIDE VIEW 1 LHS

Glass roof

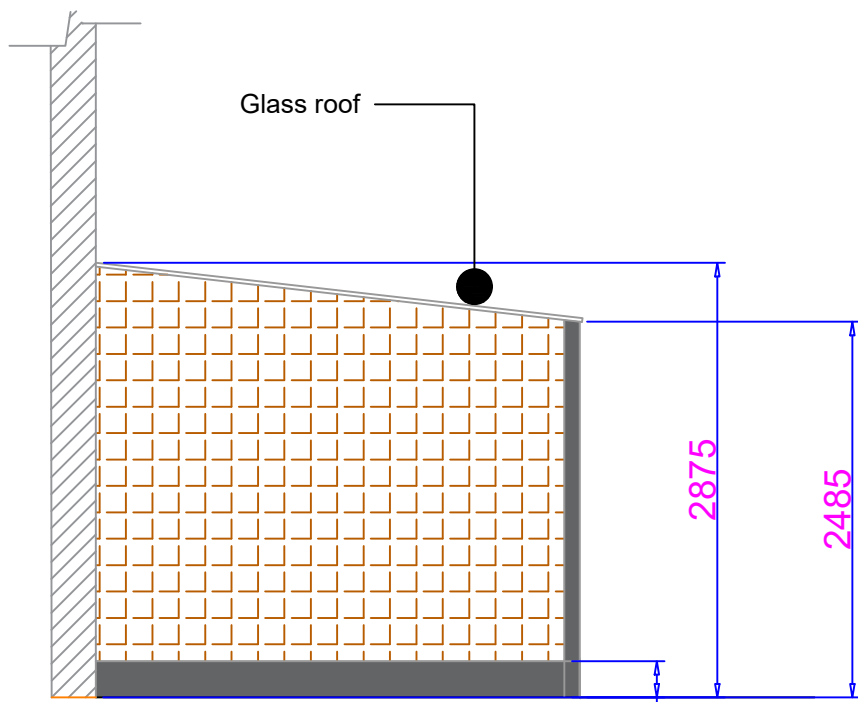

EXTENSION AS BUILT SIDE VIEW 2 RHS

NOTES

REVISIONS

REFERENCE NO: 1323 PLANS & ELEVATIONS rev 26.8.2022
annotation ref roof

PROJECT: REAR EXTENSION TO 39 WITHEWAY STREET M9 5PN

CLIENT: SERGE FOTSING

SCALE: 1:100

REFERENCE NO: 1323 PLANS & ELEVATIONS rev 1

BARRY CULLEN
ARCHITECTURE
email: barrycullen_bc@yahoo.co.uk
mob: 07851262695

