



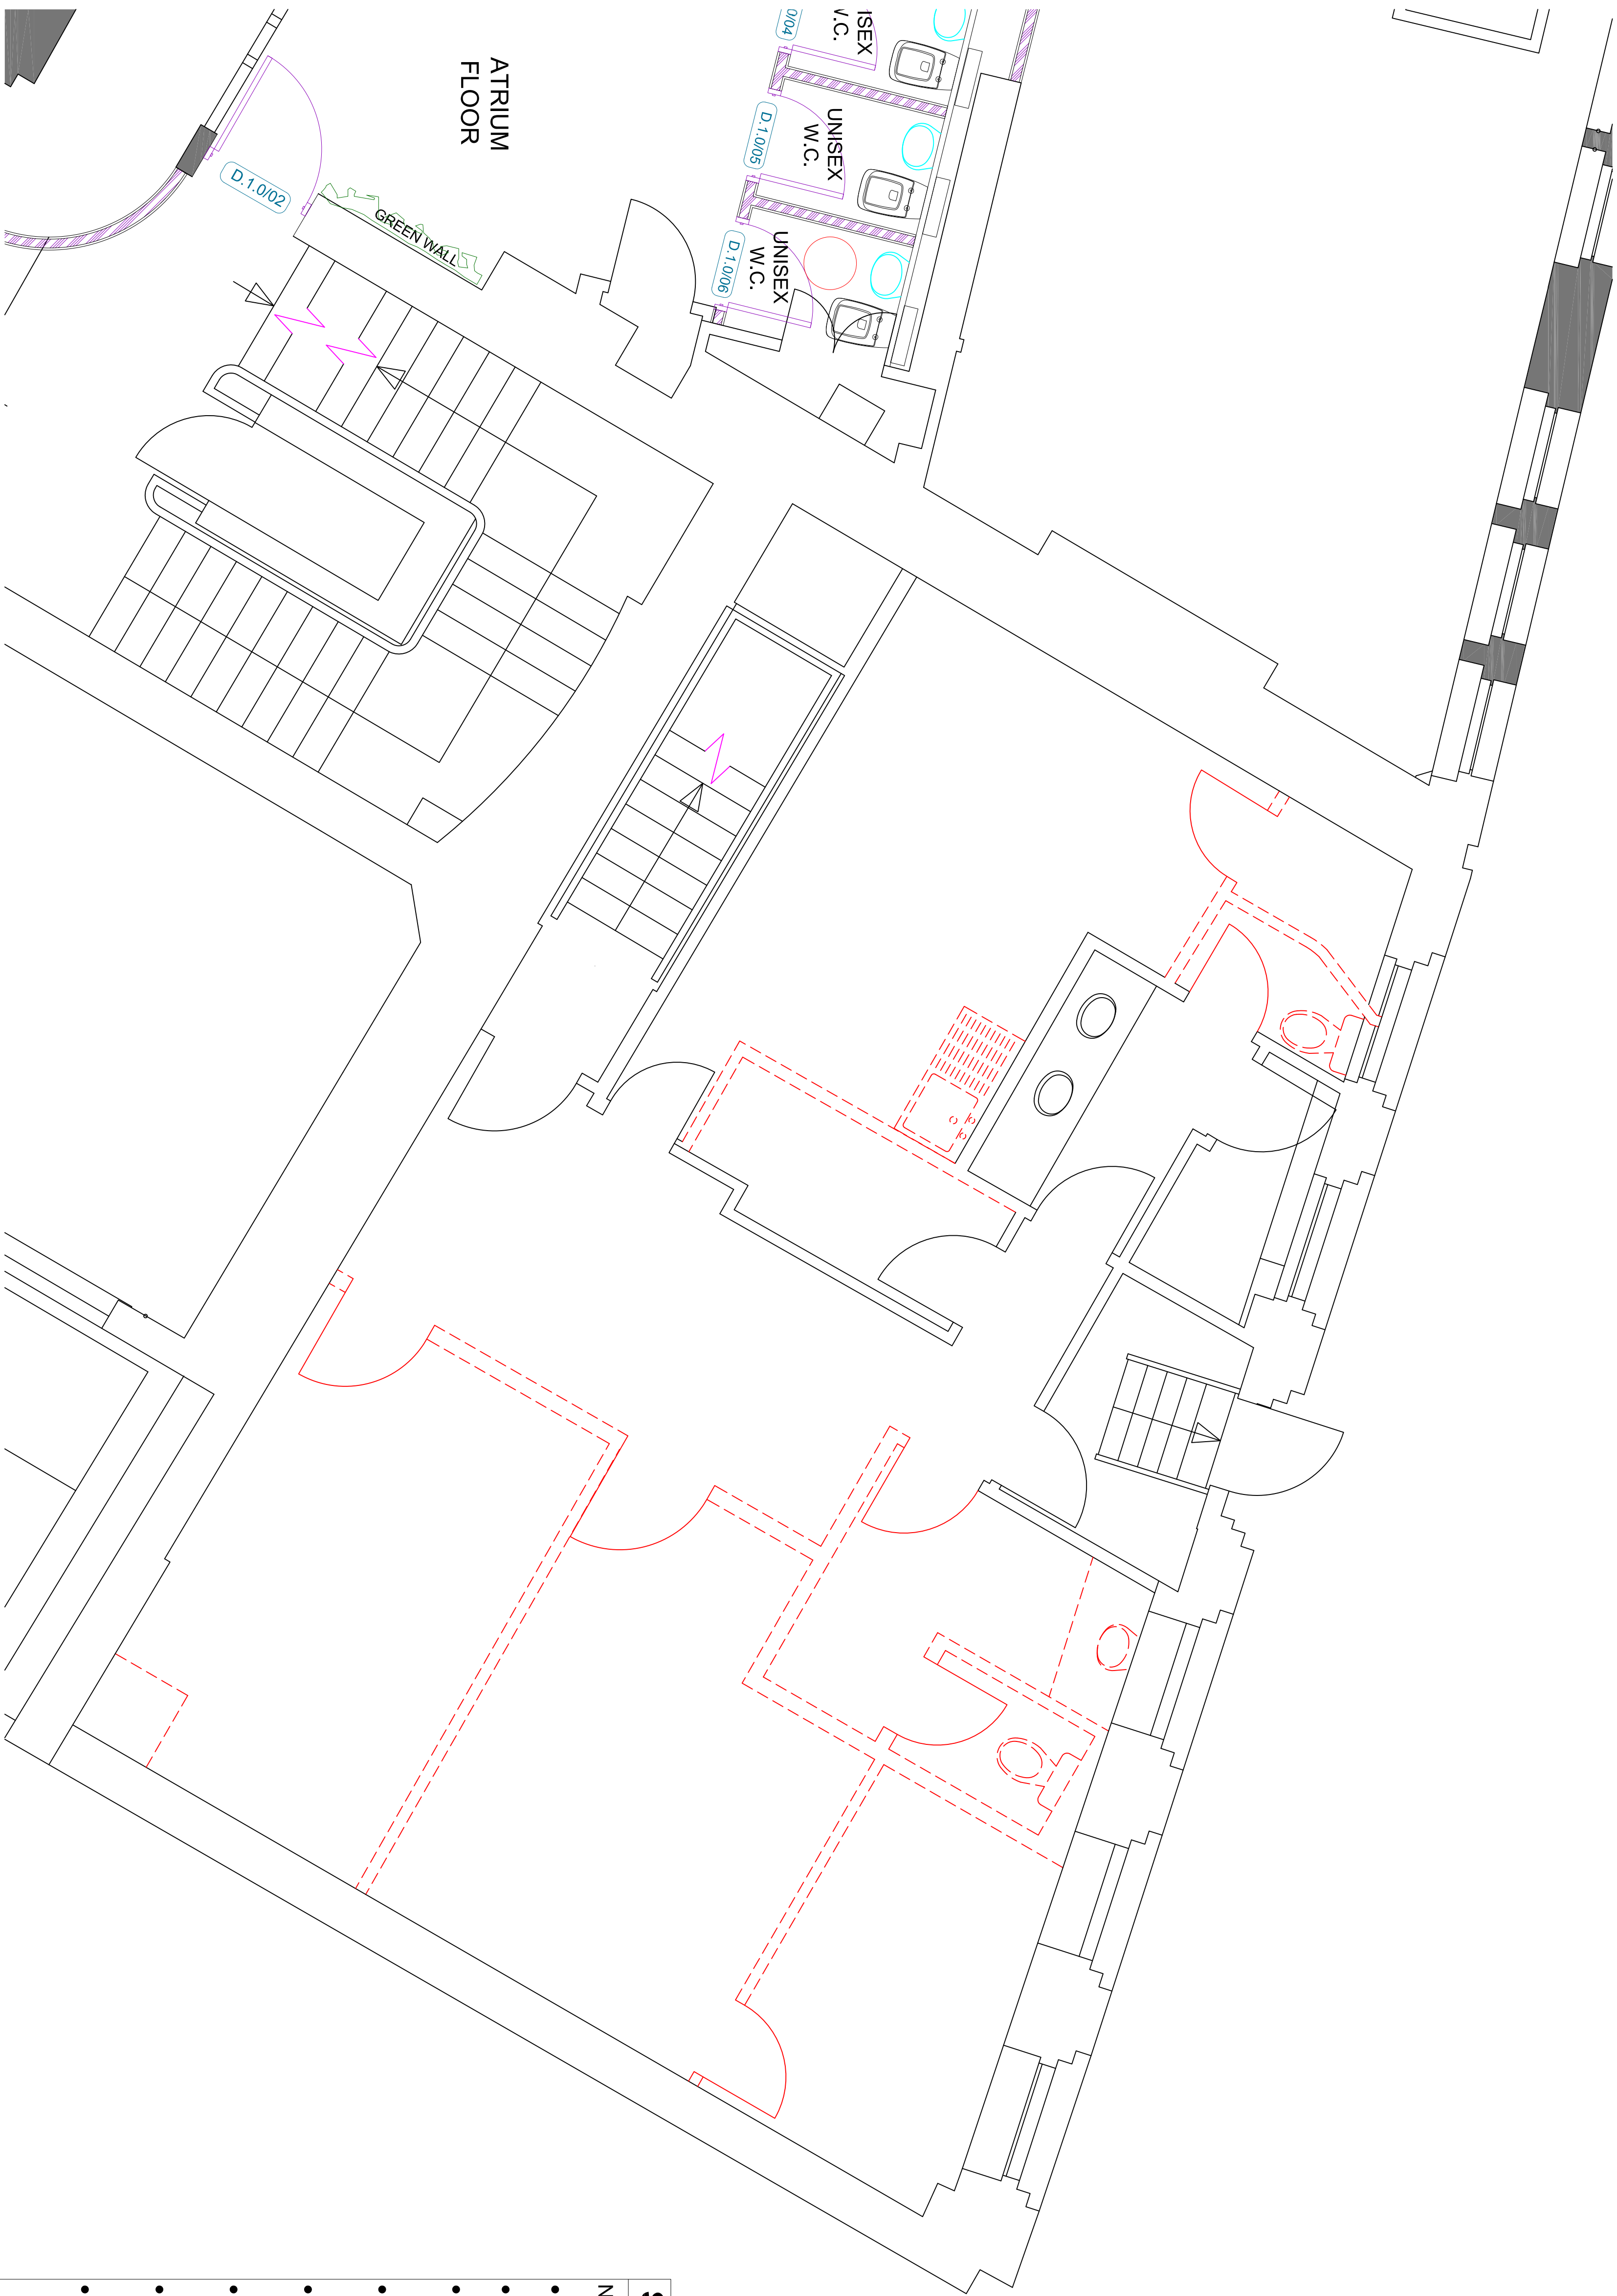

Demolition Plan

First Floor Victoria Building scale 1:50

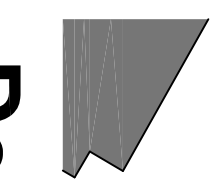

ATRILIUM
FLOOR

GREEN WALL

D.1.002

ISEX
V.C.
UNISEX
W.C.
UNISEX
W.C.
D.1.005
D.1.006

6
5
4
3
2
1

6
5
4
3
2
1

SRIP-OUT & DEMOLITION

Notes:

- Remove all partitions and doors indicated in red.
- Remove all floor coverings.
- Remove all Sanitary-ware and kitchens as indicated on the drawing.
- Remove all suspended ceiling and MF to expose original ceiling height.
- Remove all compact florescent lights and make cable safe.
- Any fire alarm fittings are to securely taped up and made safe.
- All interior existing solid walls are to be stripped back to original finish.
- Any original fittings, walls, joinery, flooring and ceiling features to be left. The building is grade 11 listed. An inspection will need to done to ascertain what's listed once strip out is completed.

Cube 8 Studio are to be contacted if you are unsure whether to the strip-out items are original or add on's.