


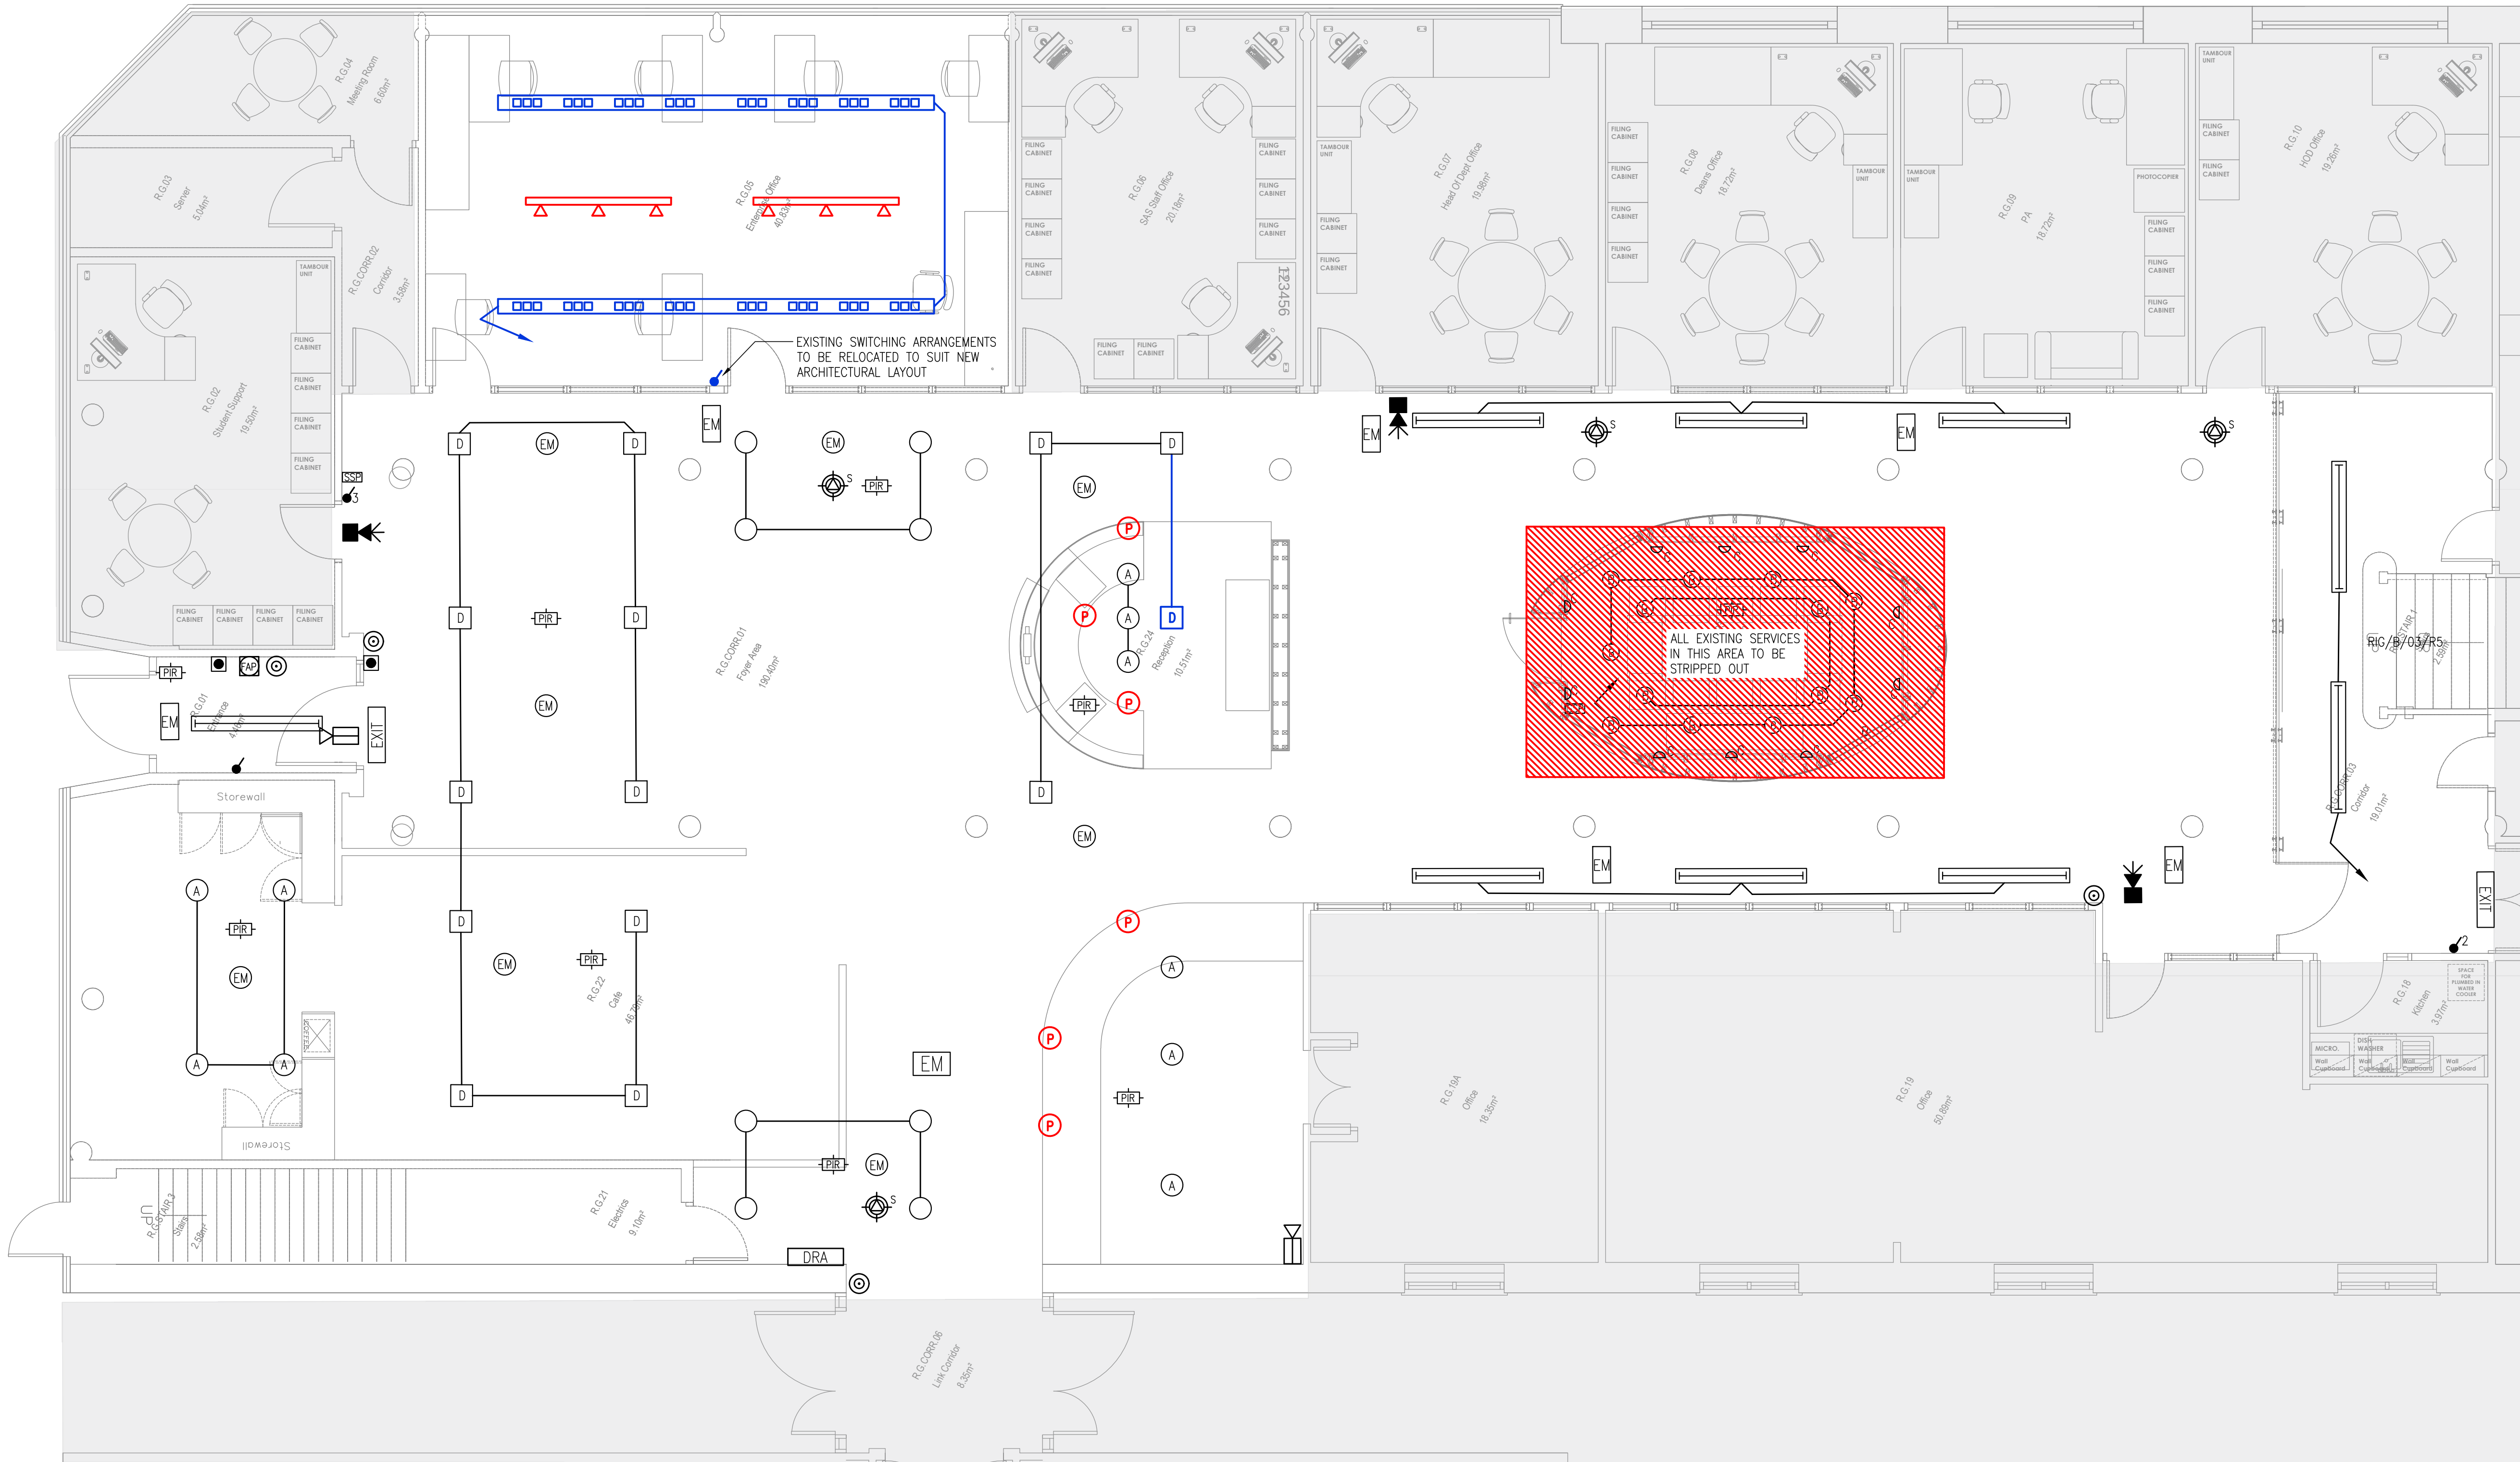

- NOTES:
- THIS DRAWING SHALL BE READ IN CONJUNCTION WITH ALL OTHER PROJECT DOCUMENTATION.
 - ALL ELECTRICAL INSTALLATION WORKS SHALL BE INSTALLED IN ACCORDANCE WITH BS 7671 INCORPORATING ALL AMENDMENTS.
 - ALL EXISTING CONTAINMENT WITHIN THIS AREA SHALL BE RETAINED AND RE-UTILISED WHERE POSSIBLE.
 - CONTRACTORS SHALL ALLOW FOR DISJOINTED WORKS INVOLVED WITH THE PROJECT IN REGARDS TO THE CO-ORDINATION WITH ALL OTHER TRADES.
 - ALL EXISTING SERVICES TO BE RETAINED UNLESS STATED OTHERWISE.
 - THE CONTRACTOR SHALL MAINTAIN THE SUPPLY OF ALL EXISTING SERVICES WITHIN ALL ADJACENT AREAS UNAFFECTED BY THESE PROPOSED WORKS.
 - PERMITS TO WORK SHALL BE OBTAINED FROM MANCHESTER METROPOLITAN UNIVERSITY PRIOR TO ANY WORK BEING CARRIED OUT ON THE EXISTING INSTALLATIONS.
 - THE CONTRACTOR SHALL TAKE COGNISANCE OF EXISTING AND NEW CIRCUITS BEING ROUTED THROUGH THE BASEMENT AND IN TURN SHALL REFER TO THE ASBESTOS REGISTER PRIOR TO CARRYING OUT ANY WORKS

- LEGEND
- LINEAR LUMINAIRE
 - CIRCULAR SPOTLIGHT
 - LOW LEVEL WALL SPOTLIGHTS
 - SQUARE DOWNLIGHT
 - CIRCULAR DOWNLIGHT
 - PENDANT
 - EMERGENCY RECESSED LUMINAIRE
 - EMERGENCY SURFACE BULKHEAD
 - EMERGENCY EXIT SIGN
 - SWITCH
 - SCENE SET PLATE
 - PRESENCE DETECTOR
 - SMOKE DETECTOR
 - FIRE ALARM PANEL
 - MANUAL CALL POINT
 - SOUNDER
 - CCTV CAMERA
 - DISABLED REFUGE ALARM
 - ALL EXISTING RETAINED SERVICES OUTWITH THIS SCOPE

- NOTE:
- RED PEN DENOTES EXISTING SERVICES TO BE STRIPPED OUT
 - BLUE PEN DENOTES EXISTING SERVICES TO BE RELOCATED/MODIFIED
 - BLACK PEN DENOTES SERVICES TO BE RETAINED

27.05.22	UPDATED TO STAGE 4 TENDER	A	DF
Date	Description	Rev	By
Revision Description			



consulting engineers

Manchester Office

2 Commercial Street
Castlefield
Manchester
M15 4RQ

Tel No: 0161 832 2030
E: hk.manchester@hulley.co.uk

...Making Buildings Work

Project:
MMU- Estates Projects
Righton

Drawing Title:
Electrical Engineering Services
Existing Lighting & Fire Alarm &
Strip Out Layout

Drawing Number:
50953(60)RIG-002

Revision: A

Date: 06/04/2022

Scale: 1:50

Drawn By: D. Farrimond

CAD Dwg File: 50953(60)RIG-002.dwg

Arch. Base Dwg:

Issue Status:
Tender

DRAWING TO BE READ IN COLOUR