


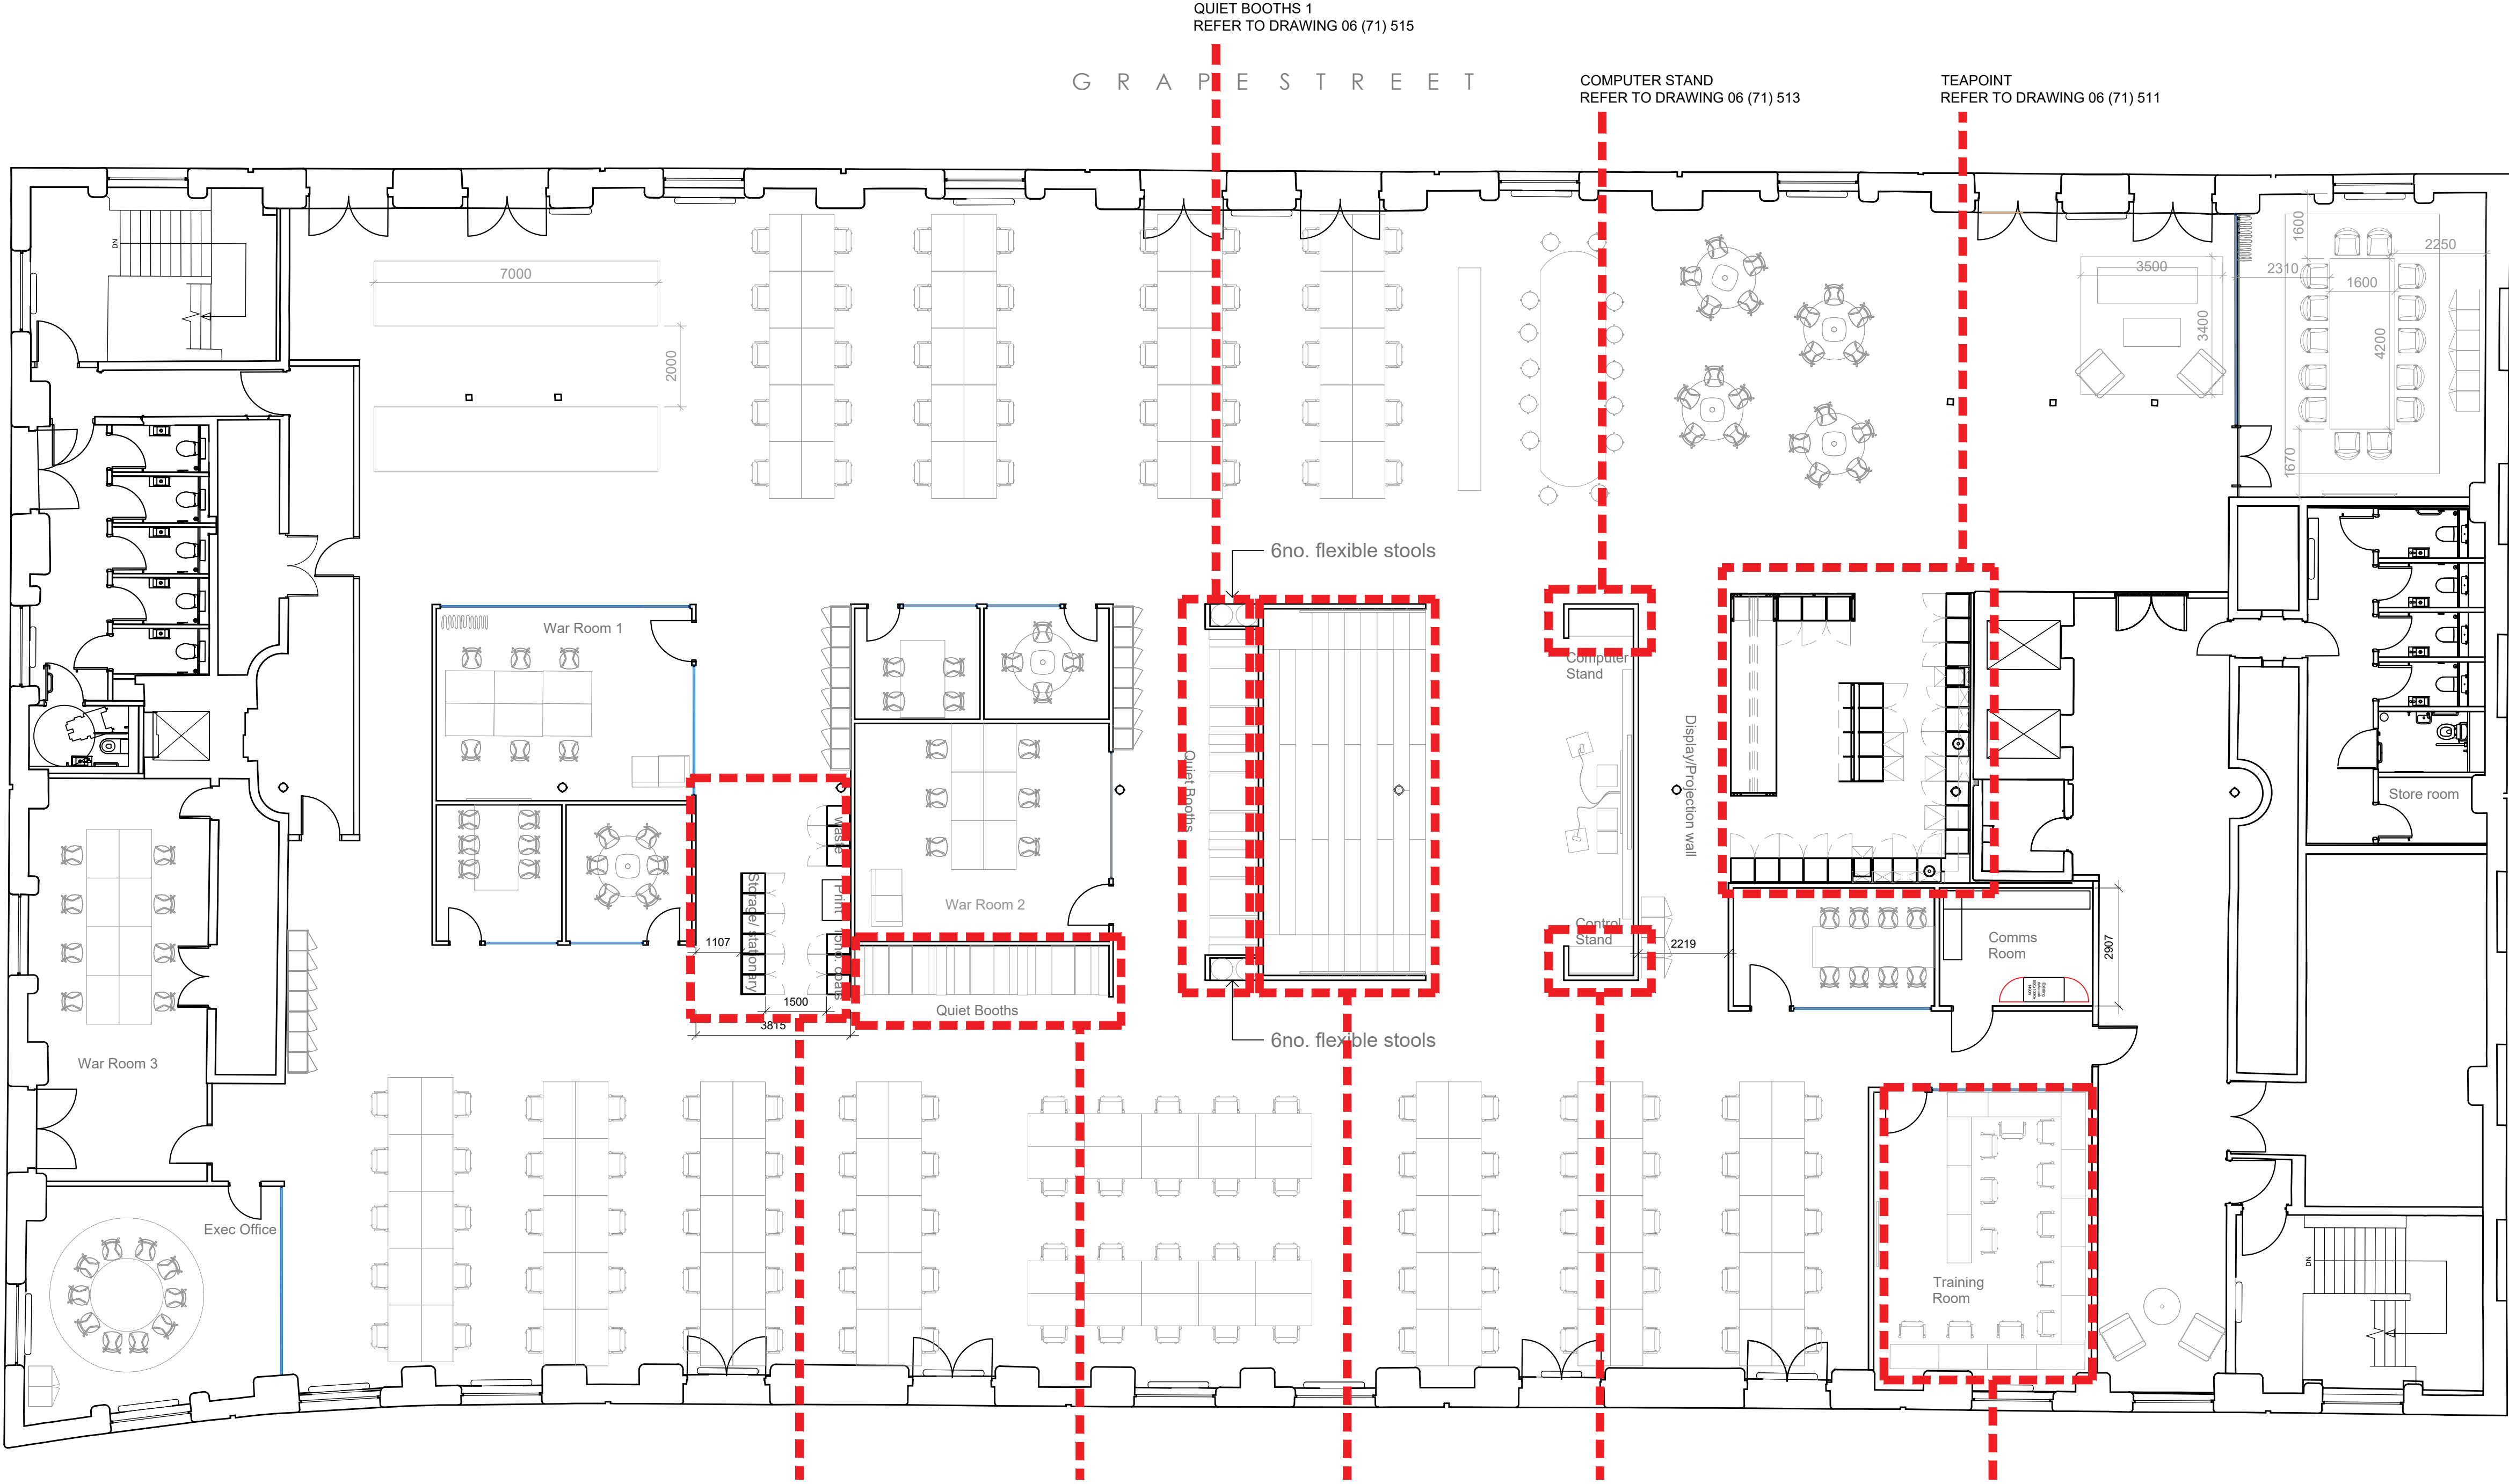

QUIET BOOTHS 1  
REFER TO DRAWING 06 (71) 515

COMPUTER STAND  
REFER TO DRAWING 06 (71) 513

TEAPOINT  
REFER TO DRAWING 06 (71) 511

PRINT & WASTE STATION  
REFER TO DRAWING 06 (71) 517

QUIET BOOTHS 2  
REFER TO DRAWING 06 (71) 516

BLEACHER SEATING  
REFER TO DRAWING 06 (71) 514

CONTROL STAND  
REFER TO DRAWING 06 (71) 513

FURNITURE TABLES

Notes:

Do not scale from this drawing. All dimensions to be checked on-site by contractor to ensure accuracy prior to any installation. All design work produced by Amspec Ltd is for indicative purposes only. It is the client and contractors responsibility to ensure that building control and fire officer approval have been met prior to commencement of site work.

|                  |              |     |       |
|------------------|--------------|-----|-------|
| REV:             | DESCRIPTION: | BY: | DATE: |
| STATUS: AS BUILT |              |     |       |

**amspec** 

DESIGN & BUILD SOLUTIONS

t : 01942 621342 f : 01942 226552  
www.amspec.co.uk

CLIENT: OBI  
80 MOSLEY STREET  
MANCHESTER  
M2 3FX

ARCHITECT:

SITE: 18 LOWER BYROM STREET  
MANCHESTER

TITLE: LEVEL 6  
JOINERY LOCATION PLAN

|                       |                          |              |                |
|-----------------------|--------------------------|--------------|----------------|
| SCALE AT A1:<br>1:100 | DATE:<br>29.10.19        | DRAWN:<br>CR | CHECKED:<br>IC |
| PROJECT NO:<br>1683   | DRAWING NO:<br>06(71)100 | REVISION:    |                |