


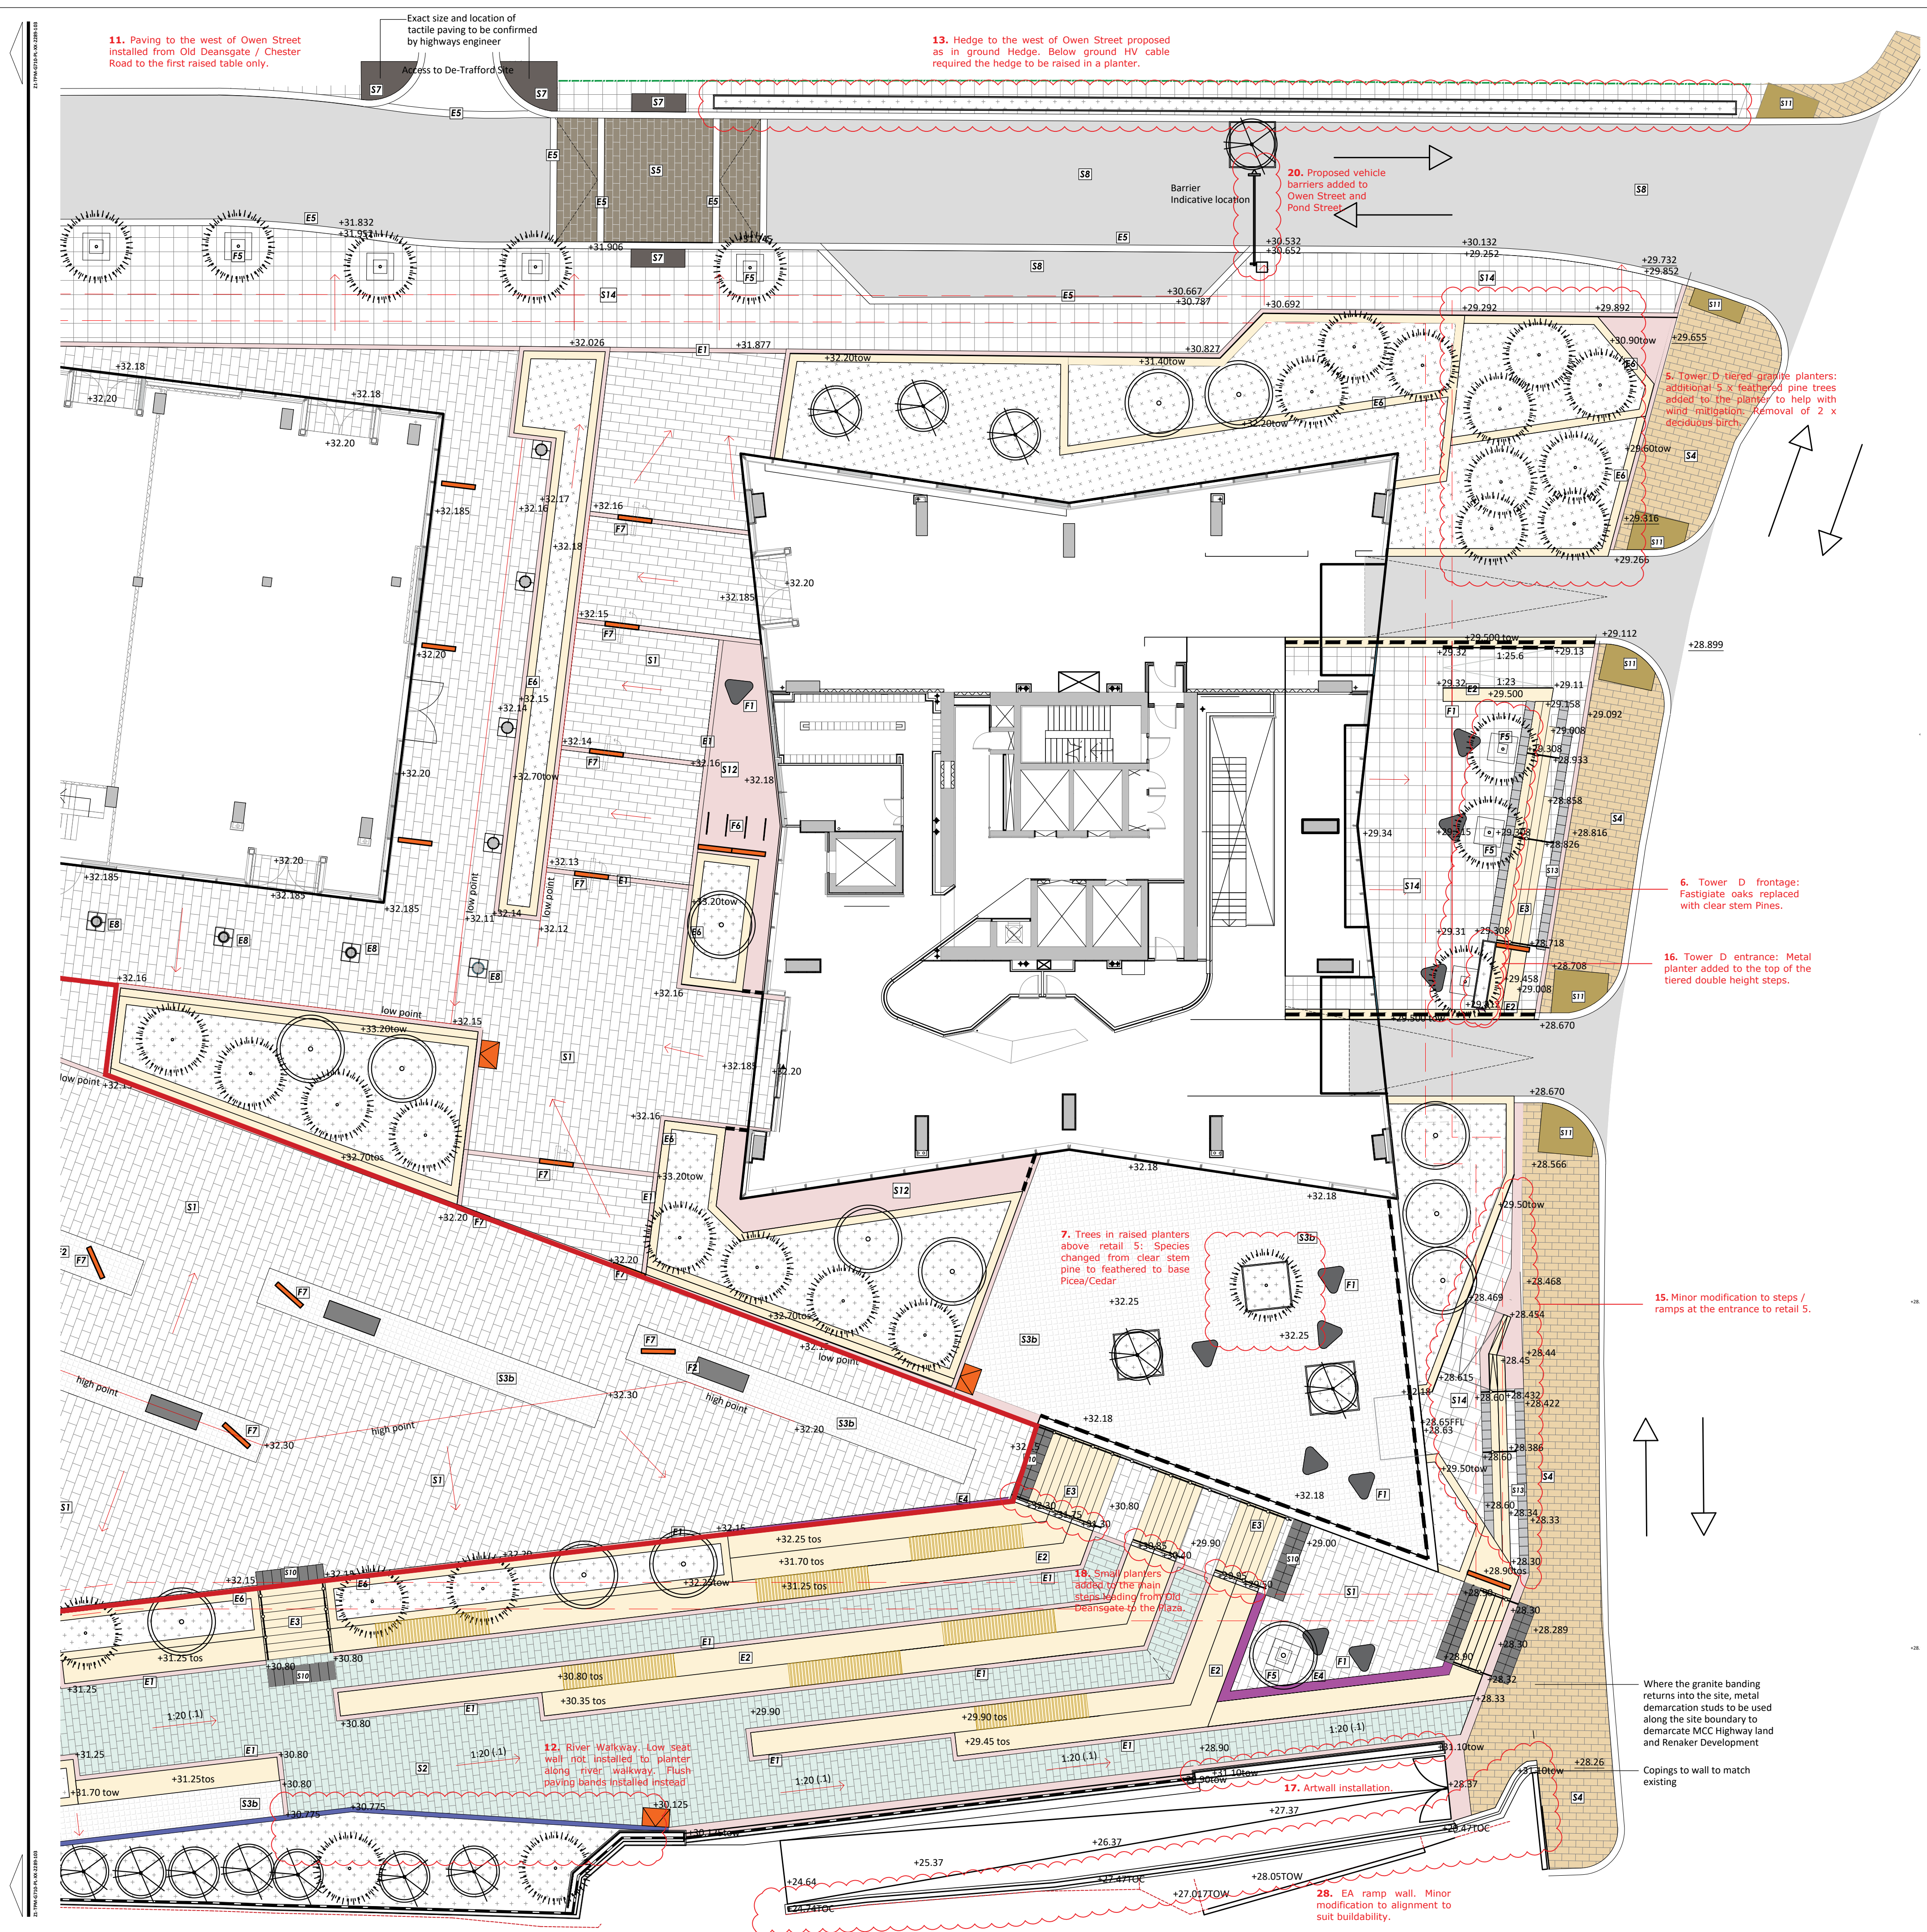


KEY	DESCRIPTION	DWG
[S1]	Proposed Natural Stone Material: Granite Type: Royal White Grout: Colour tbc Size: W200 x L200/400/600 x D85mm Finish: Flamed Pattern: Random (see 10mm over)lay Supplier: Hardscape or similar approved	...
[S2]	Proposed Natural Stone Material: Granite Type: Kobra Green Grout: Natural Colour Size: W200 x L200 x D60mm Finish: Flamed Pattern: Stretcher Bond Supplier: Hardscape or similar approved	...
[S3a]	Proposed Natural Stone Material: Granite Type: Royal White Grout: Colour tbc Size: W200 x L200 x D60mm Finish: Flamed Pattern: Stack Bond Supplier: Hardscape or similar approved	...
[S3b]	Proposed Natural Stone Material: Granite Type: 40% Royal White (Flamed), 40% Kobra Green (Fine Picked), 20% Kobra (Flamed) Grout: Natural Colour Size: W200 x L200 x D60mm Pattern: Stack Bond Supplier: Hardscape or similar approved	...
[S4]	Proposed Flags Typical Product: Pennant Stone Typical Size: 450/600/750 x Lvaries x 50 (min 100 over)lay Supplier: Hardscape or similar approved 14. Raising upgraded to local natural stone instead of Pennant in liaison with NCC.	...
[S5]	Proposed Natural Stone Material: Granite Type: 40% Royal White (Flamed), 40% Kobra Green (Fine Picked), 20% Kobra (Flamed) Grout: Natural Colour Size: W100 x L300 x D85mm Pattern: Stretcher Bond Supplier: Hardscape or similar approved	...
[S6]	Proposed Block Paving Material: Clay Type: Natural Clay (Lolo UWF) Grout: Colour tbc Size: W60 x L200 x D60mm Finish: Tumbled Pattern: Herringbone (45 degree) Supplier: Hardscape or similar approved	...
[S7]	Proposed Tactile Paving Material: Granite Colour: Crystal Black Size: W400 x L400 x D50mm Supplier: Hardscape or similar approved Type: Timpole	...
[S8]	Proposed Asphalt To engineers specification.	...
[S9]	Proposed Metal Grating Heat safe metal grating. Specification tbc. Cantilevered over the river edge. Width: 2200mm	...
[S10]	Proposed Tactile Paving Material: Granite Colour: Royal White Size: W400 x Lvaries to align with steps x D60mm Supplier: Hardscape or similar approved Type: Corduroy	...
[S11]	Proposed Tactile Paving Spec: To Highway Authority Specification Supplier: Marshalls or similar approved 14. Raising upgraded to local natural stone instead of Pennant in liaison with NCC.	...

[S12]	Proposed Granite Setts Type: Granite Size: W97 x L97 x D60mm Colour: Royal White Grout: Colour tbc Finish: Fine Picked Laying: Stack Bond Supplier: Hardscape or similar approved	...
[S13]	Proposed Tactile Paving Material: Granite Type: Royal White Size: W400 x Lvaries to align with steps x D60mm Finish: Fine Picked Laying: Stack Bond Supplier: Hardscape or similar approved Type: Corduroy	...
[S14]	Proposed Natural Stone Material: Granite Type: Royal White Grout: Colour tbc Size: W450/600/750 x Lvaries (min 350, max 900mm x D50mm) Finish: Flamed Pattern: (50% each course) (min 10mm over)lay Supplier: Hardscape or similar approved	...
[B3]	Proposed Natural Stone - B3 Material: Granite Type: Royal White Size: W95 x L15 x D50 mm Finish: Fine Picked Pattern: Stack Bond Supplier: Hardscape or similar approved	...

KEY	DESCRIPTION	DWG
[E1]	Proposed Granite Setts Trim Type: Granite Size: W97 x L97 x D60mm Sawn 6 sides Colour: Royal White Width: 200mm Finish: Fine Picked Laying: Stack Bond, Double Row Supplier: Hardscape or similar approved	...
[E2]	Proposed Raised Edges (450mm Upstand) Type: Granite Size: W1000 x L1050 x Dvaries (copings 100mm depth) Colour: Royal White Finish: Flamed Laying: Stack Bond Supplier: Hardscape or similar approved	...
[E3]	Proposed Steps (150mm upstand) - Type 1 Type: Granite Size: W950 x Lvaries x D150mm Finish: Flamed Nose Strip: Crystal Black Colour: Royal White Supplier: Hardscape or similar approved	...
[E4]	Proposed Granite Setts Trim Type: Granite Size: W97 x L97 x D60mm Sawn 5 sides, cropped top Colour: Royal White Width: 200 x 400mm Finish: Cropped top Laying: Stack Bond, Double Row Supplier: Hardscape or similar approved	...
[E5]	Proposed Road Kerb (on adopted roads) Type: Granite Size: 300 x 900 x depth varies (120mm upstand) Colour: Royal White Finish: Flamed	...
[E6]	Proposed Planter Edges/Walls Type: Granite Cladding Tiles and Copings Size: General width 750/350mm, height varies Colour: Royal White Finish: Flamed Supplier: Hardscape or similar approved	...
[E8]	Proposed Column Surround Type: Granite Size: W800 x L800 x D60/85mm Colour: Royal White Finish: Flamed Supplier: Hardscape or similar approved	...
[E9]	Proposed Pin Kerb Type: PC Concrete Size: 315 x D150mm x W50mm Supplier: Marshalls or similar approved	...
[E10]	Proposed Substrate / Fall Restraint Height: Total height 1100mm above the paving / edge level	...
[E11]	Proposed Stainless Steel Handrail xx	...
[E12]	Proposed Granite Setts/Coping Trim Type: Granite (downed to concrete to avoid displacement) Size: W950 x L800 x D60/85mm Colour: Royal White Width: coping with fake sett joints Finish: Fine Picked Laying: Stack Bond Supplier: Hardscape or similar approved	...

KEY	DESCRIPTION	DWG
[F1]	Proposed Triangular Seats Type: Kobra Granite Triangular Seats Finish: Free standing Supplier: Hardscape or similar approved Height: 450mm	...
[F2]	Proposed Rectangular Seats Type: Kobra Granite Rectangular Seats Size: W500 x L2500 x H450mm Finish: Free standing Supplier: Hardscape or similar approved	...
[F3]	Proposed Integrated Timber Tops Type: Hardwood timber seat Size: W1050/700 x Lvaries x D50-100mm Finish: Integrated into granite terrace units Supplier: Hardscape or similar approved	...
[F4]	Proposed Raised Planter Type: Kobra Granite Rectangular Size (Max): W2054 x L2054 x H1050mm Size (Reverse): W1000 x Lvaries x H750mm Finish: Free Standing Supplier: Iota Garden or similar approved	...
[F5]	Proposed Tree Grill Type: Roadways - Arborist, Riverside - concealed Size (Roadways): W1200 x L1200 Size (Riverside): W1200 x L1200 Supplier: Jones of Dowsley or similar approved	...
[F6]	Proposed Cycle Stand Name: Fin Type: Roadways Size: 700 above ground, length 975, 48mm dia Material: Stainless Steel Grade 304 Supplier: Bailey Steel Scene or similar approved	...
[F7]	Proposed Wind Baffle Type: Porosity Varies Size: Min. 2m high, Max 5m Material: Powder Coated Steel Supplier: Bespoke Other: Signage and branding to be incorporated	...
[F8]	Proposed Bin Detail tbc	...

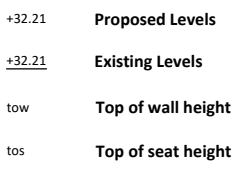

- GENERAL NOTES**
- This drawing is the copyright of tpm landscape Ltd and cannot be reproduced in any form without the consent of the company.
 - This drawing is to be read in conjunction with detail landscape drawings, details and specification.
 - This drawing is to be read in conjunction with all relevant Architects', Engineer's, Specialists, Bills of Quantities and Specifications.
 - The insertion of any firm or proprietary brand on this drawing is an indication of the class or quality required and does not exclude the use of alternative materials that are equal in performance, quality and appearance, provided that they have been approved in writing by the Landscape Architect.
 - The Contractor is responsible for accurately ascertaining the position of underground services and responding to all relevant service easement requirements.
 - All dimensions are in millimetres unless stated otherwise, for the purposes of construction this drawing must not be scaled and only written dimensions used. Written and scaled dimensions to be checked on site, any discrepancies reported prior to work commencing. IF IN DOUBT PLEASE ASK.
 - All Proprietary products are to be used strictly in accordance with the relevant British Standards and Code of Practice.

REVISION NOTES		
Rev	Description	Date
P27 KH	Black dashed line (gate removed : dwg 102)	07.12.21
P25 KH	Pond Street Amends	26.05.21
P24 KH	Amended to suit site requested changes	09.03.21
P23 KH	Amended to suit site requested changes	30.11.20
P22 KH	Concierge planters amended	18.06.20
P21 KH	Pocket park wall amended	17.03.20
P20 KH	EA ramp amends	13.11.19
P19 EG	DeTrafford entrance kerbs	16.10.19
P18 EG	Road alignment amended	04.10.19
P17 KH	Owen Street Raised Table amended	11.09.19
P16 KH	EA ramp interface amended	14.08.19
P15 KH	Owen Street Kerb Alignment Amended	25.07.19
P14 KH	Tower B levels amended and river walkway	26.06.19
P13 KH	Steps amended	17.01.19

Client
CQ Investments Ltd

Project
Owen Street, Manchester

Description
Landscape Hardworks (3 of 3)

Status
AS BUILT AMENDMENTS: ISSUED 07-12-2021

Scale @ A1
1:150

Drawn
DC

Checked
DC

Date
June '17

Drawing number
Z1-TPM-G710-PL-XX-2289 104

Revision
P27

address: 4th Floor Studio 10 Little Lever St Manchester M1 1HR
tel: 0161 235 0600 fax 0601 email info@tpmlandscape.co.uk