

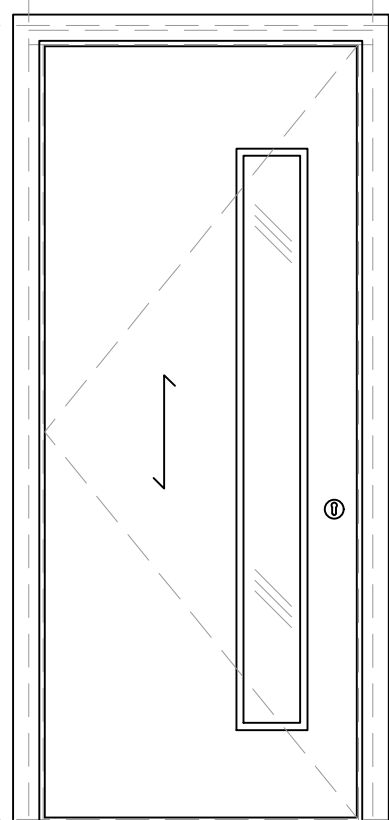


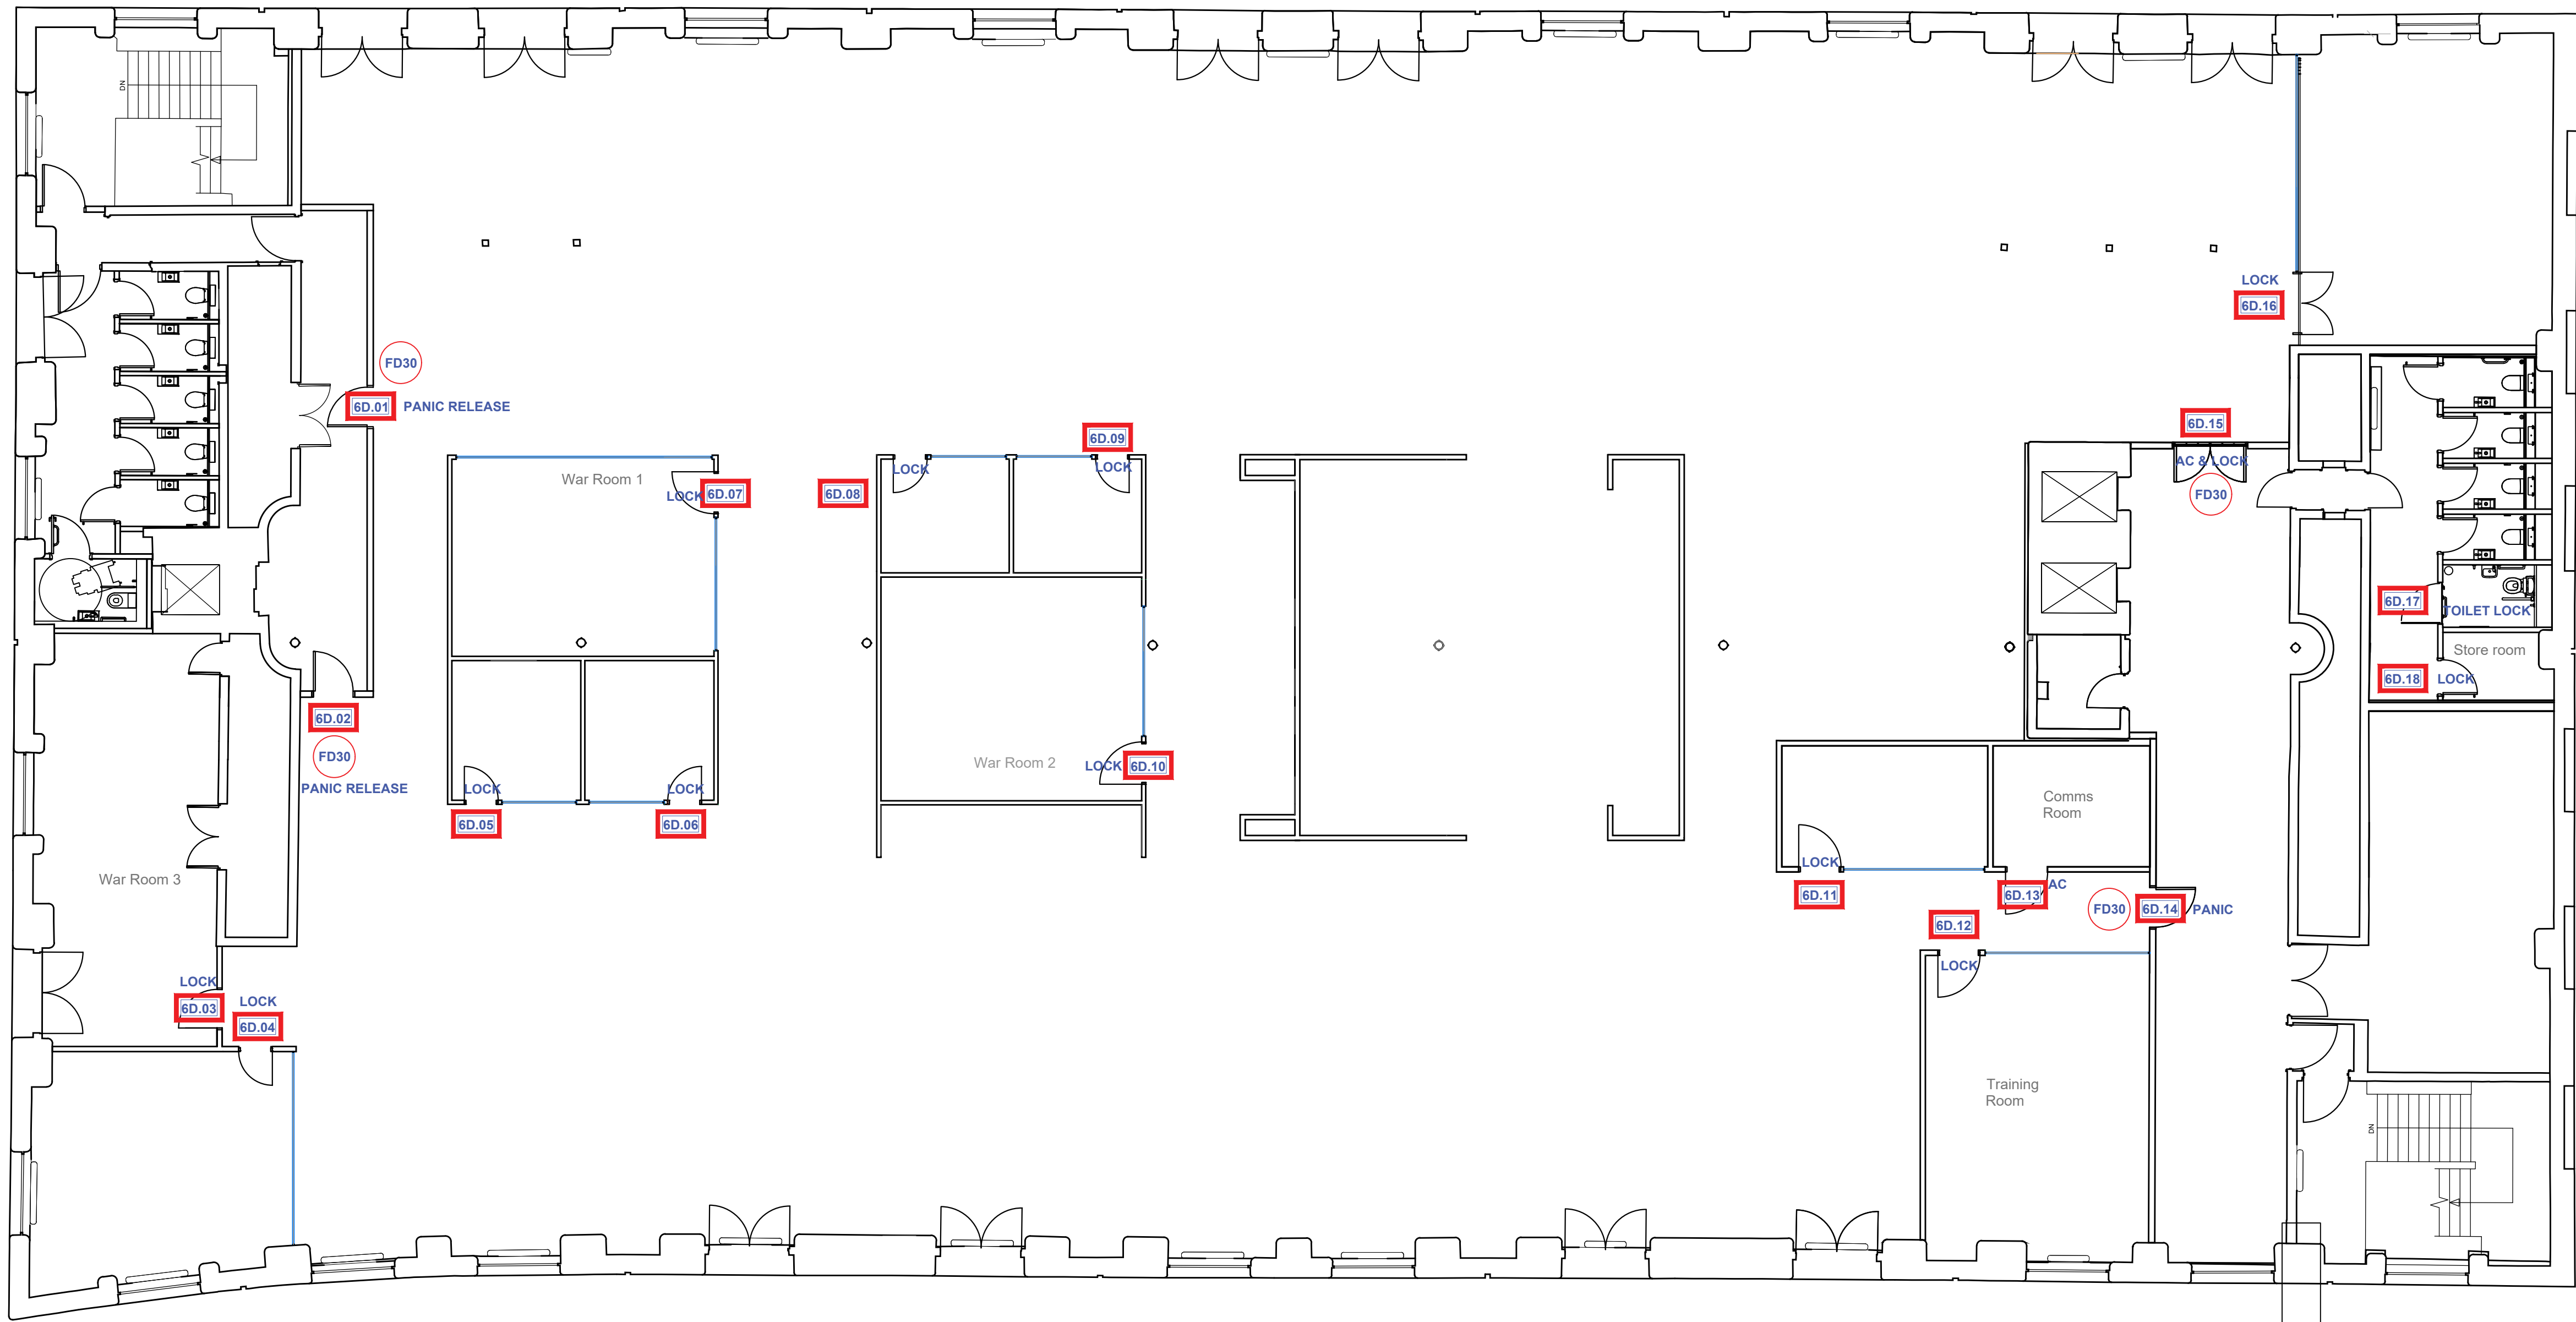

TYPE 1 DOORS: 6D.01, 6D.02, 6D.03 & 6D.04

LAMINATED SINGLE DOOR WITH VISION PANEL
FRAME OPENING: 910 X 2100MM
DOOR SIZE: 826 X 2040MM X 44M
S'WD CASING: 38MM
ARCHITRAVE: 70MM

SATIN STAINLESS STEEL IRONMONGERY
EURO CYLINDER WITH THUMB TURN (6D.03)
EURO ESCUTCHEON (6D.03)

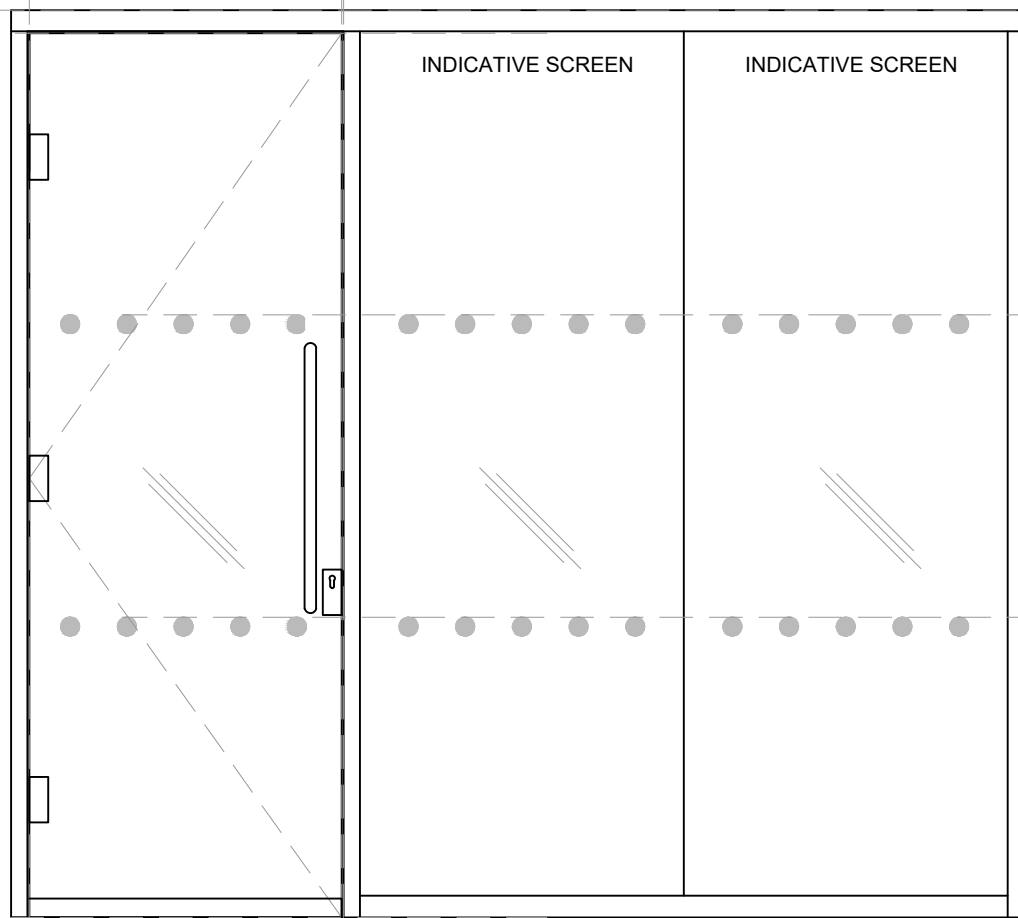


TYPE 2 DOORS: 6D.05, 6D.06, 6D.07, 6D.08, 6D.09, 6D.10, 6D.11, *6D.12 (DWARF WALL)*

12MM TOUGHENED SINGLE GLAZED, SINGLE DOOR TO ACHIEVE 34dB WITH SCREEN
FRAMING & TRACKS FINISHED TO RAL 9005 JET BLACK (TO MATCH EXISTING)
MANIFESTATION DOTS AS ILLUSTRATED

REFER TO PLAN FOR LEAF HANDING


SATIN STAINLESS STEEL IRONMONGERY
EURO CYLINDER WITH THUMB TURN
EURO ESCUTCHEON

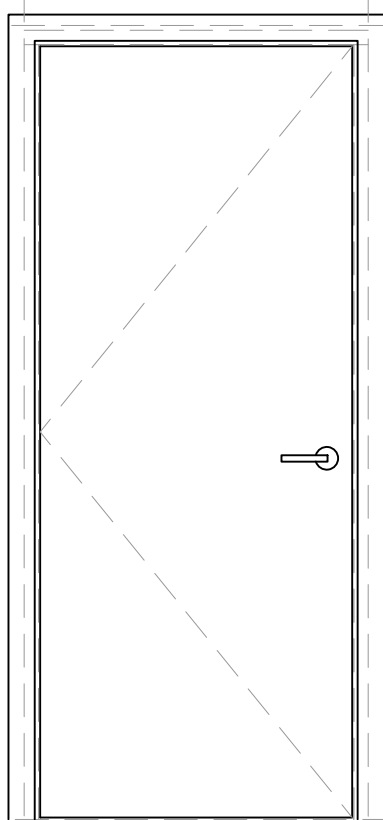

TYPE 3 DOORS: 6D.13 (COMMS ROOM)

PAINT GRADE SINGLE DOOR
FRAME OPENING: 910 X 2100MM
DOOR SIZE: 826 X 2040MM X 40M
S'WD CASING: 38MM
ARCHITRAVE: 70MM


SATIN STAINLESS STEEL IRONMONGERY
ACCESS CONTROL CARD READER REQUIRED

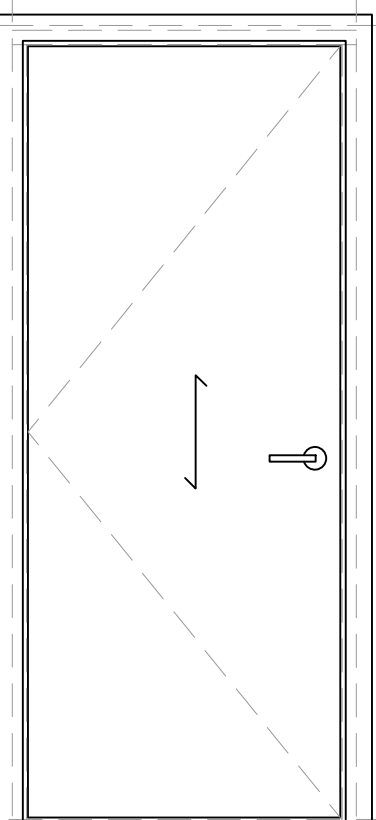

TYPE 4 DOORS: 6D.14

LAMINATED SINGLE DOOR
FRAME OPENING: 910 X 2100MM
DOOR SIZE: 826 X 2040MM X 44M
S'WD CASING: 38MM
ARCHITRAVE: 70MM


SATIN STAINLESS STEEL IRONMONGERY

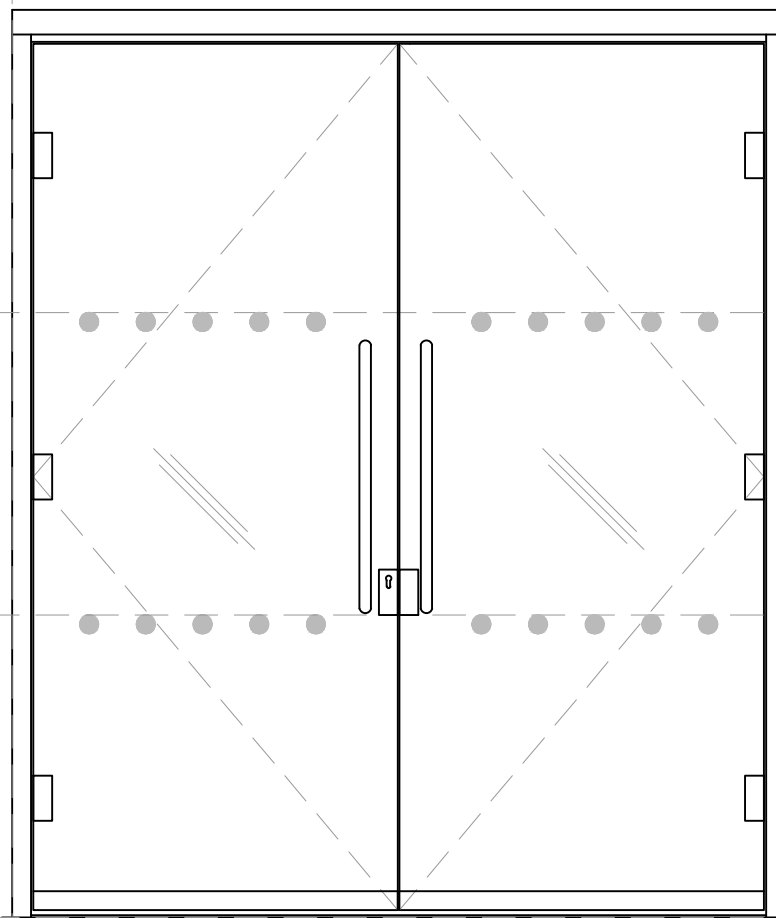

TYPE 5 DOORS: 6D.16 (BOARDROOM)

12MM TOUGHENED SINGLE GLAZED DOUBLE DOOR TO ACHIEVE 34dB
FRAME OPENING: 1010 X 2100MM
DOOR SIZE: 826 X 2040MM X 40M
BLACK (TO MATCH EXISTING)
MANIFESTATION DOTS AS ILLUSTRATED


SATIN STAINLESS STEEL IRONMONGERY
EURO CYLINDER WITH THUMB TURN
EURO ESCUTCHEON

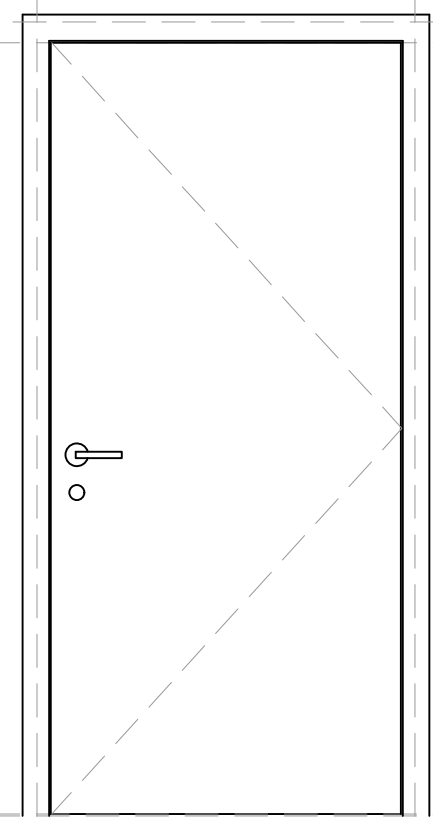

TYPE 6 DOORS: 6D.17 (ACCESSIBLE WC)

LAMINATED SINGLE DOOR (OUTWARD OPENING)
FRAME OPENING: 1010 X 2100MM
DOOR SIZE: 826 X 2040MM X 40M
S'WD CASING: 38MM
ARCHITRAVE: TO MATCH EXISTING

IRONMONGERY TO MATCH EXISTING
ACCESSIBLE WC'S

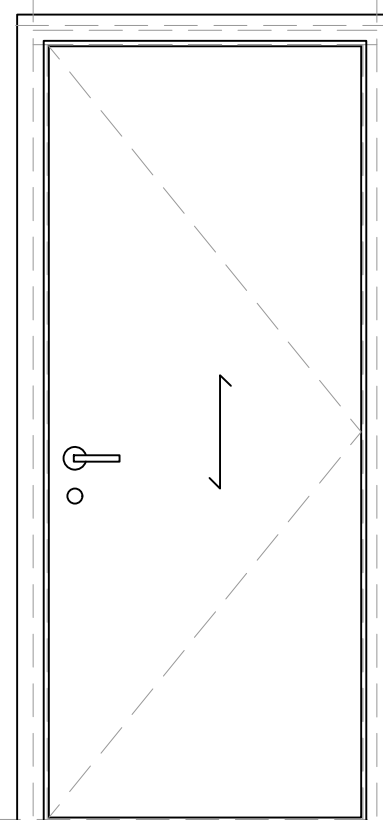

TYPE 7 DOOR: 6D.18 (STORE ROOM)


LAMINATED SINGLE DOOR (TO MATCH EXISTING)
FRAME OPENING: 910 X 2100MM
DOOR SIZE: 826 X 2040MM X 40M
S'WD CASING: 38MM
ARCHITRAVE: TO MATCH EXISTING

IRONMONGERY TO MATCH EXISTING

Notes:

Do not scale from this drawing. All dimensions to be checked on-site by contractor to ensure accuracy prior to any installation. All design work produced by Amspec Ltd is for indicative purposes only. It is the client and contractors responsibility to ensure that building control and fire officer approval have been met prior to commencement of site work

TYPE 9 DOOR: 6D.15 (EXISTING RELOCATED TO MAIN ENTRANCE)

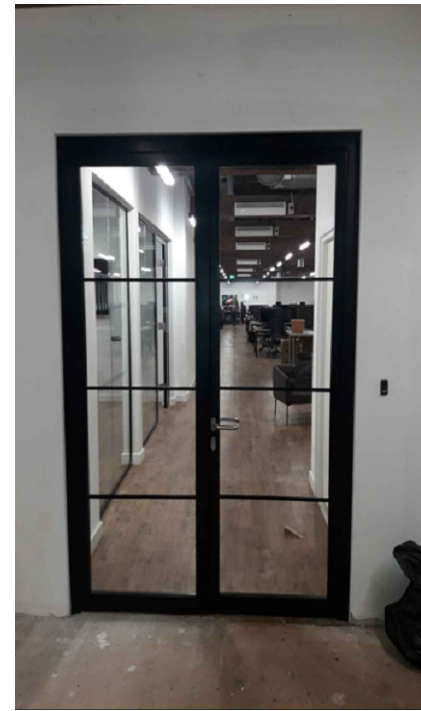

ACCESS CONTROL CARD READER REQUIRED FOR DOORS 6D.15 & 6D.13

CONTRACTS MANAGER TO CONFIRM DOOR SIZES ON-SITE ONCE PARTITIONS INSTALLED

REV: DESCRIPTION: BY: DATE:

STATUS: AS BUILT



CLIENT: OBI
80 MOSLEY STREET
MANCHESTER
M2 3FX

ARCHITECT:

SITE: 18 LOWER BYROM STREET
MANCHESTER

TITLE: LEVEL 6
DOOR SCHEDULE

SCALE AT A1:	DATE:	DRAWN:	CHECKED:
1:100	04.12.19	CR	MS
PROJECT NO:	DRAWING NO:	REVISION:	
1683	06(32)100		