

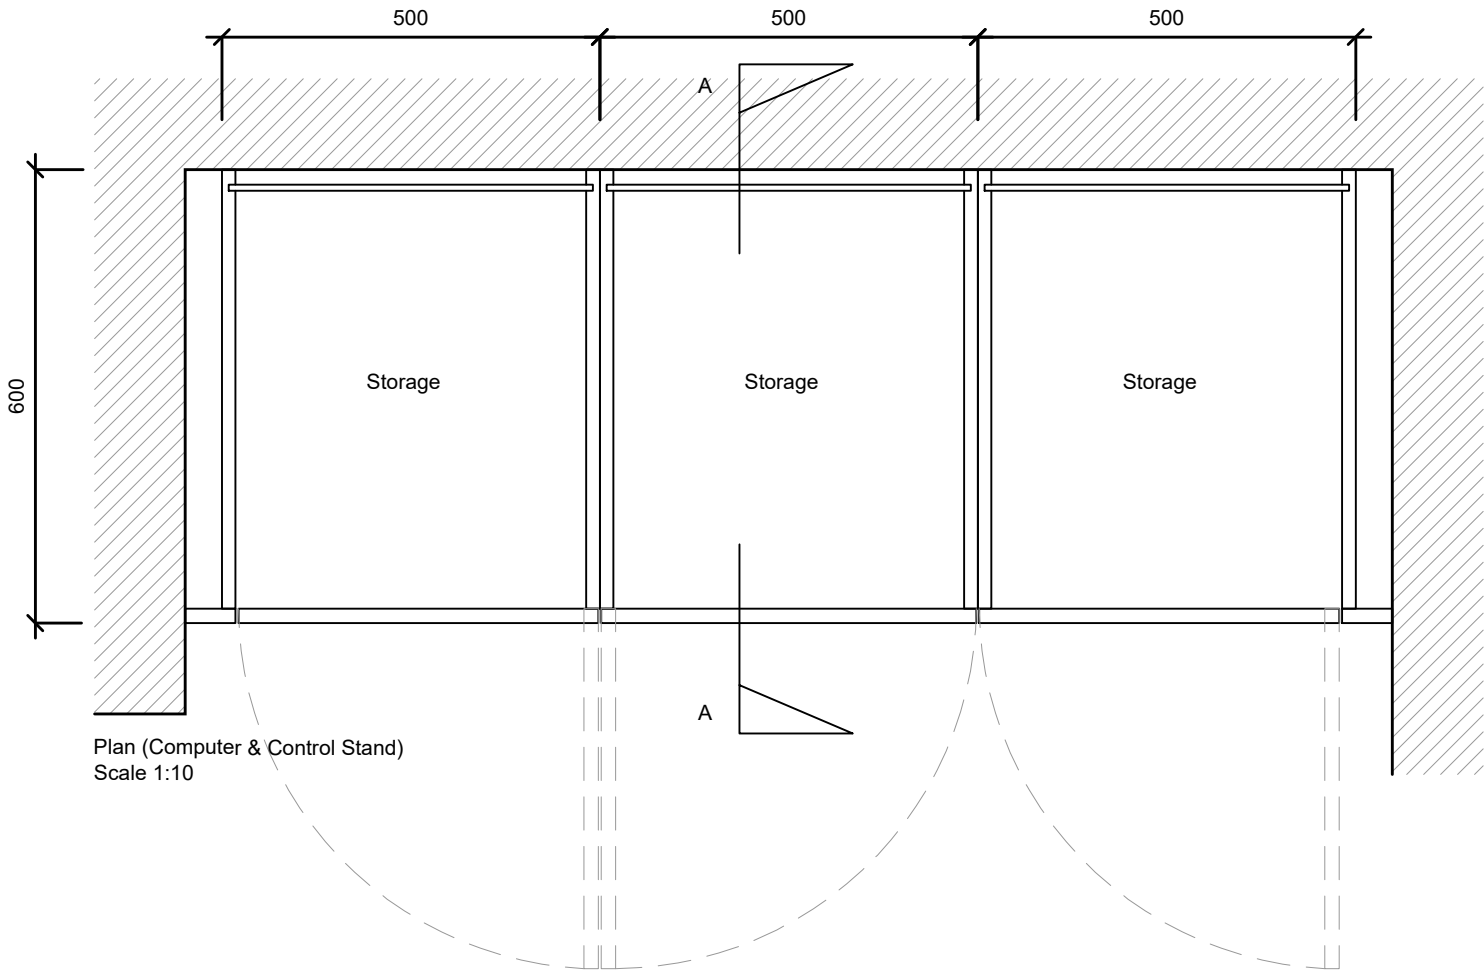



Plan
Scale 1:20

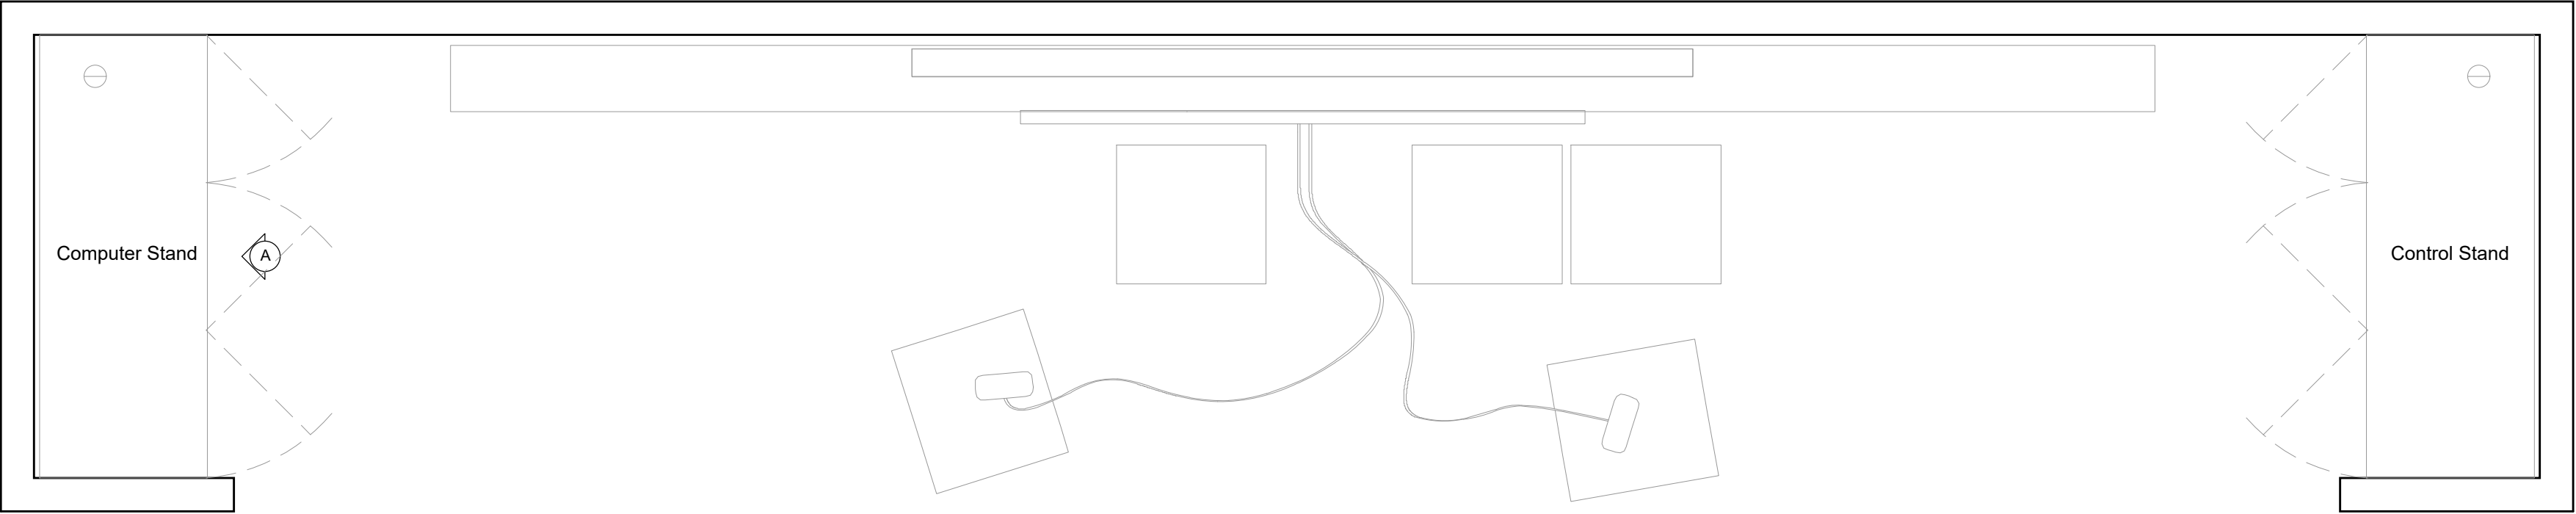


Plan (Computer & Control Stand)
Scale 1:10

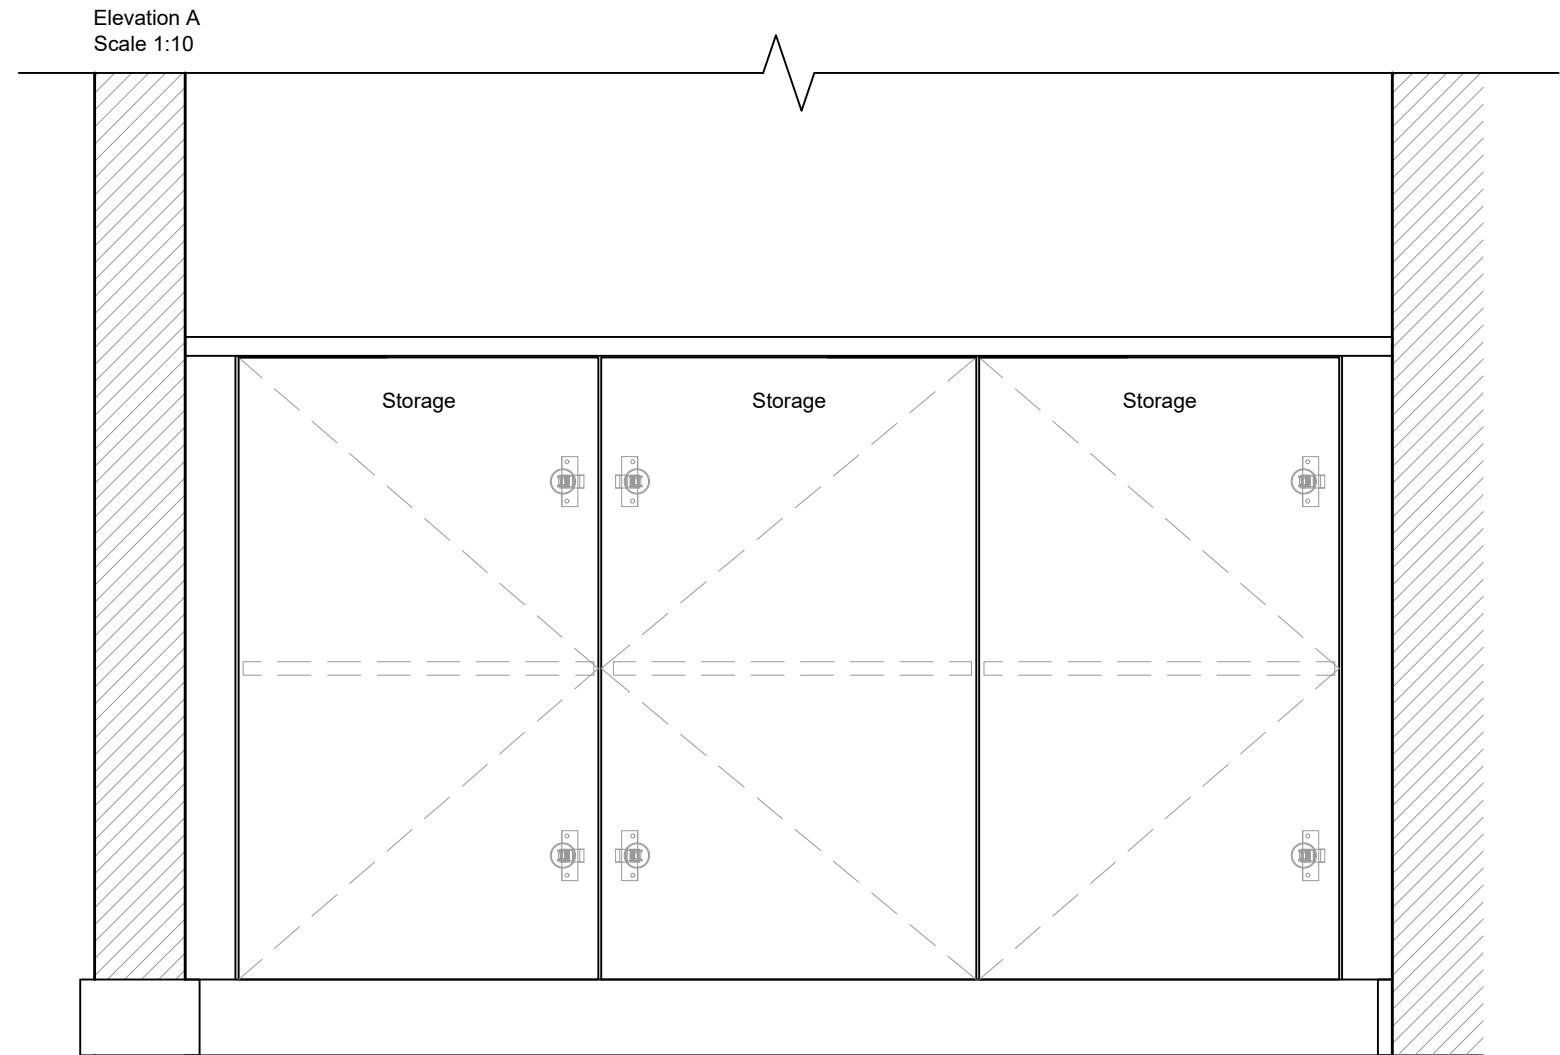

Elevation A
Scale 1:10

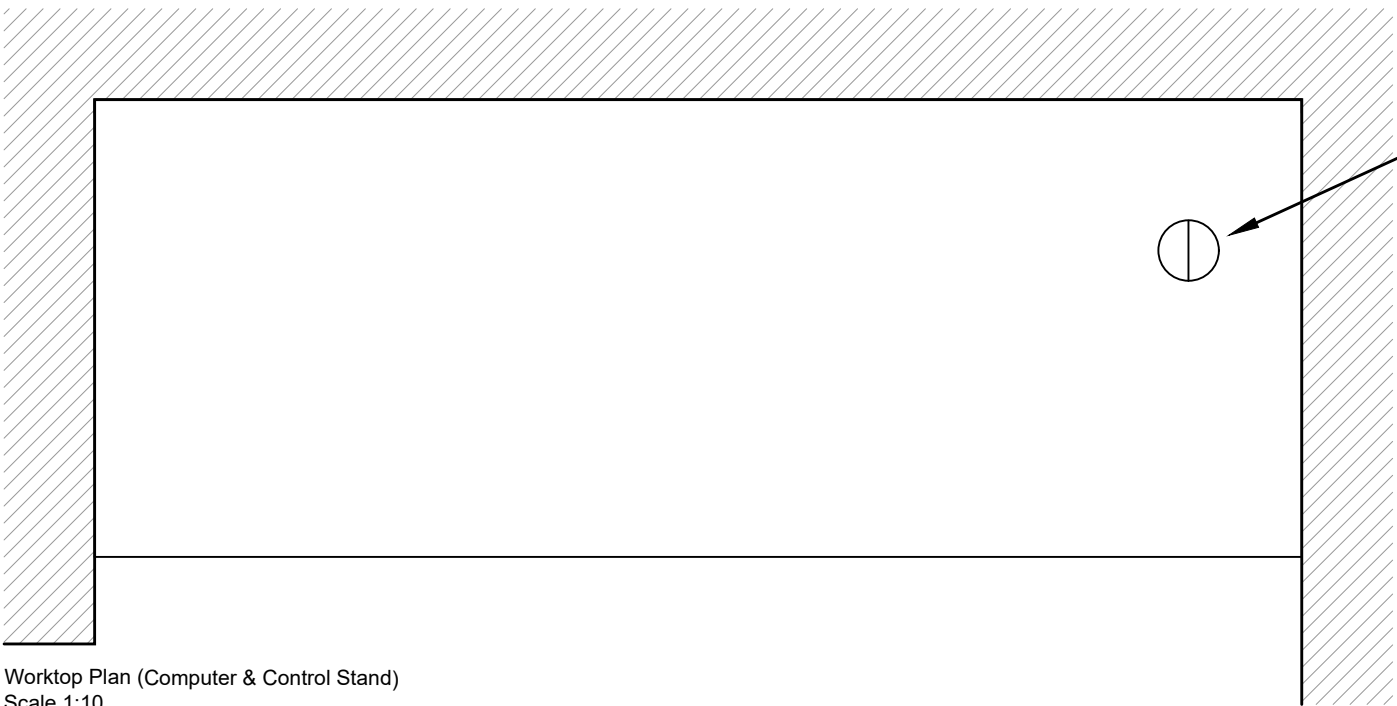

Worktop Plan (Computer & Control Stand)
Scale 1:10

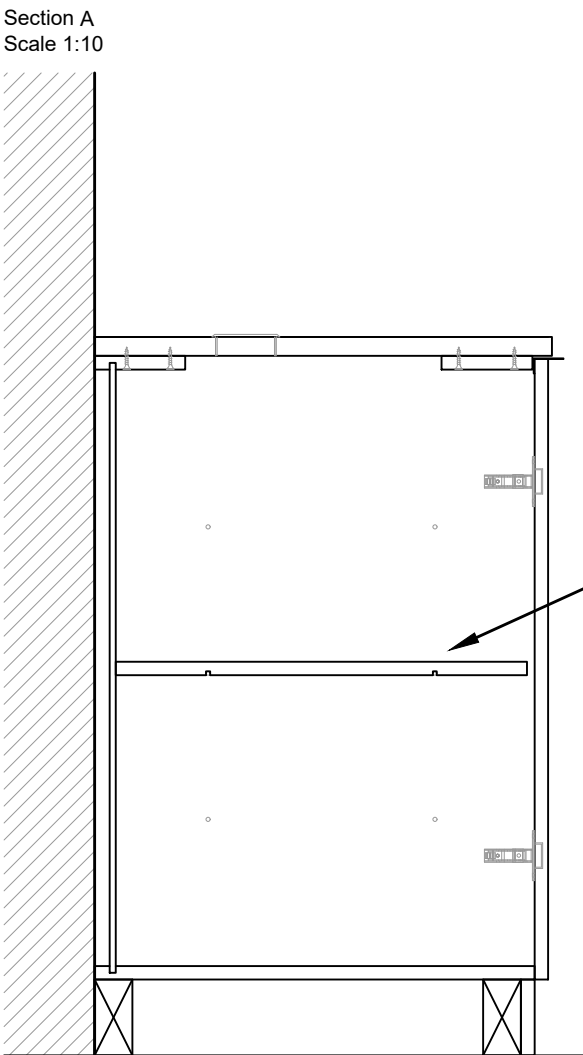

Section A
Scale 1:10

Notes:	
Do not scale from this drawing. All dimensions to be checked on-site by contractor to ensure accuracy prior to any installation. All design work produced by Amspec Ltd is for indicative purposes only. It is the client and contractors responsibility to ensure that building control and fire officer approval have been met prior to commencement of site work.	
Materials	Description
Worktop:	25mm MRMDF Egger U961 PM Graphite Grey Perfect Sense with 2mm ABS edging to match
Internal lining & edging:	18mm MRMDF Kronospan K101 interior lining with 2mm ABS edging to match Egger U961 PM Graphite Grey
Unit back:	8mm Kronospan K101
Doors:	18mm MRMDF Egger U961 PM Graphite Grey Perfect Sense with 2mm ABS edging to match
Plinth:	18mm MRMDF Egger U961 PM Graphite Grey Perfect Sense
Hinges:	Concealed cup hinge 110° integrated soft close, full overlay mounting with standard depth adjustment, Hafele ref. 321.20.850
Grommet:	Black desk grommet ABS resin 75mm cut out, Midshires Electrical & Lighting
Handles:	Trimline brushed stainless steel bar cupboard handle 150mm, Howdens
Shelf supports:	Shelf support plug in 5mm Ø hole with stop, nickel plated ref. 282.42.702

Notes:
Contracts manager to check and confirm all measures on-site. Any discrepancies to be reported to the designer



Egger U961 PM Graphite Grey Perfect Sense Matt



Trimline brushed stainless steel bar cupboard handle 150mm

REV:	DESCRIPTION:	BY:	DATE:
STATUS: AS BUILT			
 DESIGN & BUILD SOLUTIONS t : 01942 621342 f : 01942 226552 www.amspec.co.uk			
CLIENT: OBI 80 MOSLEY STREET MANCHESTER M2 3FX			
ARCHITECT:			
SITE: 18 LOWER BYROM STREET MANCHESTER			
TITLE: LEVEL 6 COMPUTER & CONTROL STANDS			
SCALE AT A2:	DATE:	DRAWN:	CHECKED:
VARIES	26.11.19	CR	MS
PROJECT NO:	DRAWING NO:	REVISION:	
1683	06(71)513		