


Door Type A2 : Ambulant WC Cubicle Door

GENERAL NOTE


To be read in conjunction with Schedule of Works, Door Schedule and GA plans.

3D.15


3D.16

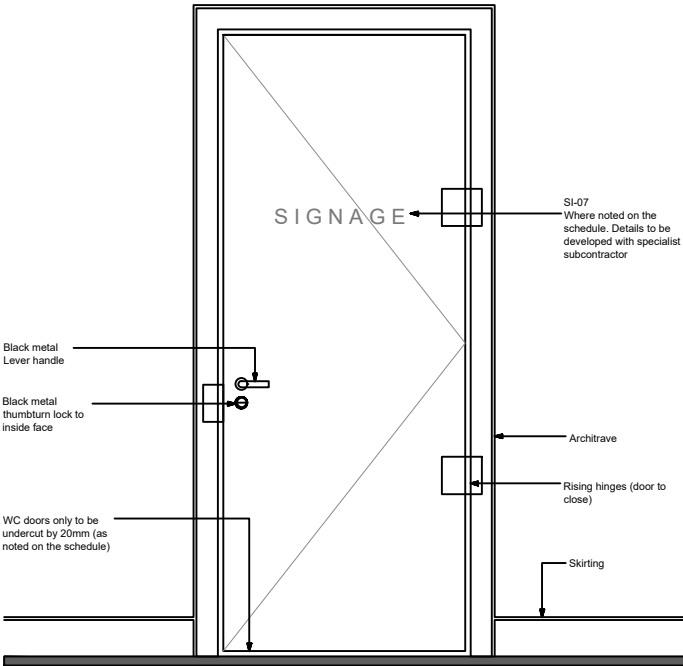

Type A2 : Front Elevation

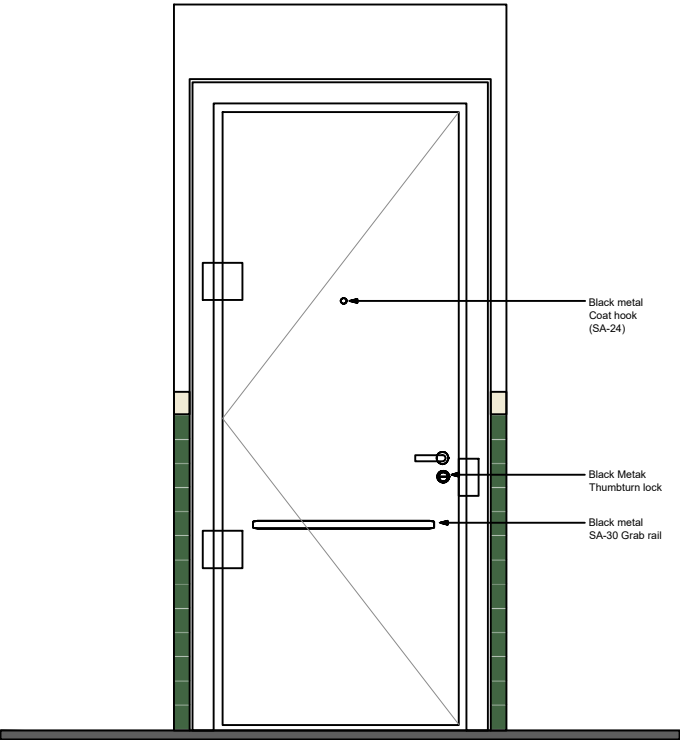

Type A2 : Rear Elevation

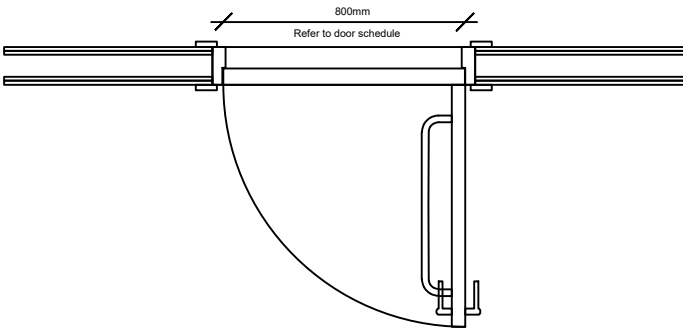

Type A2 : Plan

Door Type A2 : Ambulant WC Cubicle Door

Lacquered Faced Timber Door

NOTES:
44mm thick solid core door.
Fire rating: N/A
Black metal ironmongery

Signage Design TBC
Grab rails within ambulant disabled WC to be by ironmongery subcontractor and to be black metal.
3no. allowed per cubicle.

Notes:

Do not scale from this drawing. All dimensions to be checked on-site by contractor to ensure accuracy prior to any installation. All design work produced by Amspec Ltd is for indicative purposes only. It is the client and contractors responsibility to ensure that building control and fire officer approval have been met prior to commencement of site work

REV:	DESCRIPTION:	BY:	DATE:
STATUS: AS BUILT			
amspec DESIGN & BUILD SOLUTIONS f : 01942 621342 f : 01942 226552 www.amspec.co.uk			
CLIENT:	OBI 80 MOSELY STREET MANCHESTER M2 3FX		
ARCHITECT:			
SITE:	18 LOWER BYROM STREET MANCHESTER		
TITLE:	LEVEL 3 DOOR TYPE A2		
SCALE AT A3: 1:25	DATE: 28.06.19	DRAWN: CR	CHECKED: IC
PROJECT NO: 1683	DRAWING NO: DP_DT-05	REVISION:	