


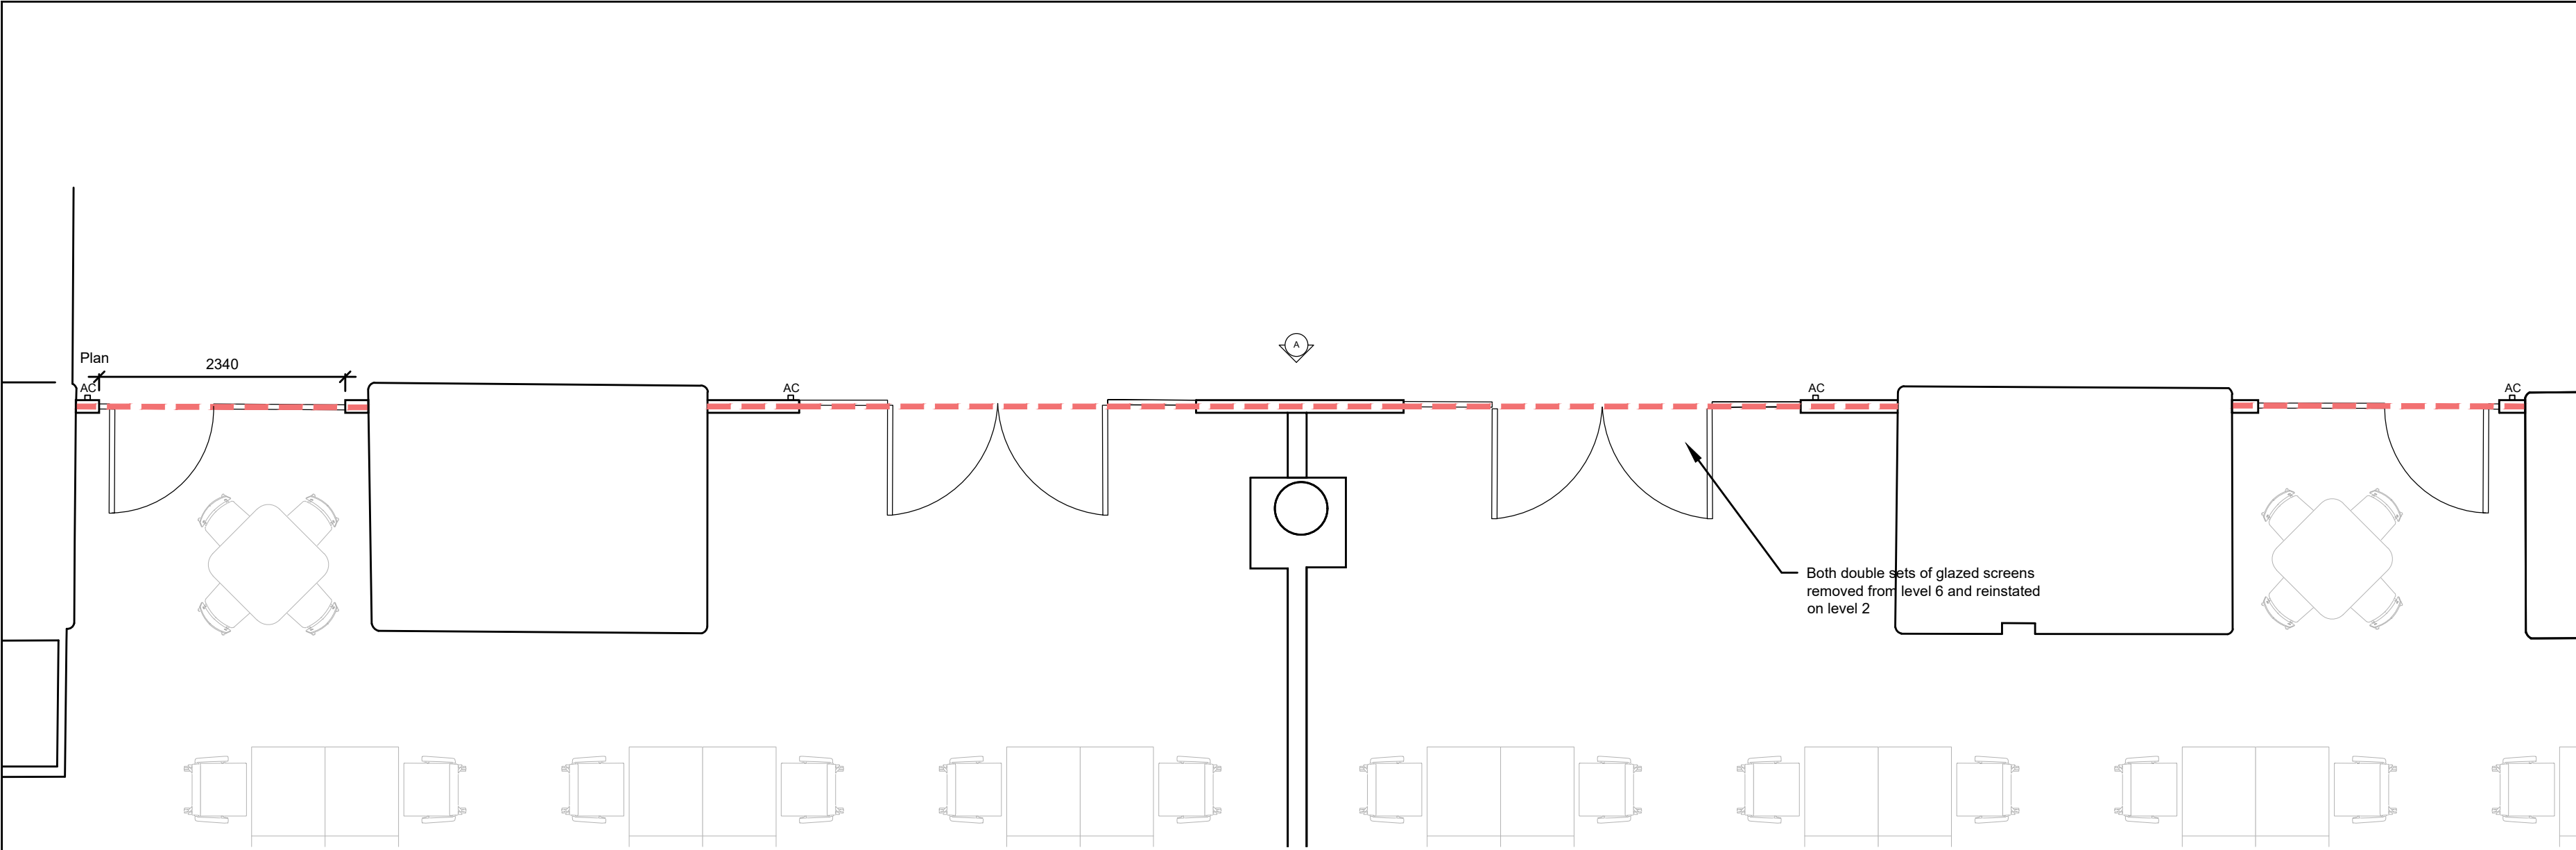


Plan

2340

A

Both double sets of glazed screens removed from level 6 and reinstated on level 2

Elevation A

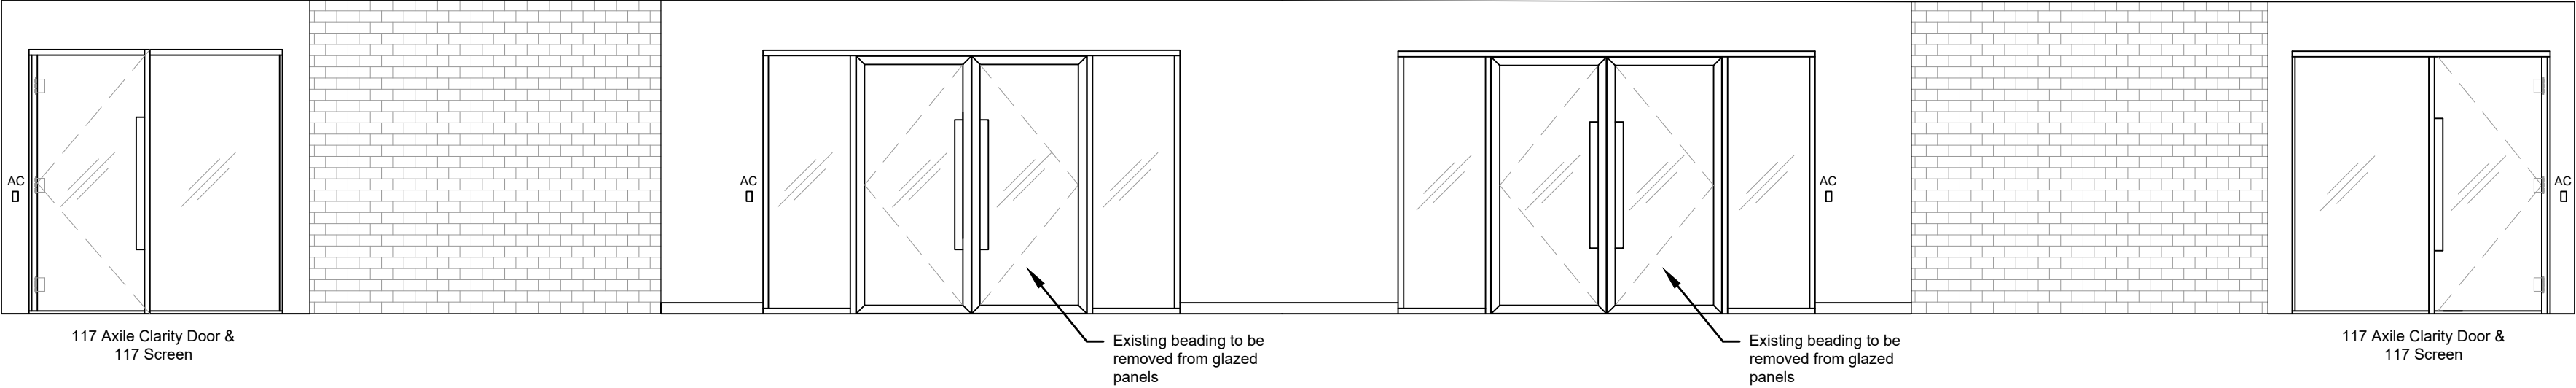

117 Axile Clarity Door & 117 Screen

Existing beading to be removed from glazed panels

Existing beading to be removed from glazed panels

117 Axile Clarity Door & 117 Screen

Notes:

Do not scale from this drawing. All dimensions to be checked on-site by contractor to ensure accuracy prior to any installation. All design work produced by Amspec Ltd is for indicative purposes only. It is the client and contractors responsibility to ensure that building control and fire officer approval have been met prior to commencement of site work.

70mm gypframe 'C' studs @ 400mm ctrs
2 x 12.5mm wallboard
25mm Acoustic partition roll (non FR)

AC = Access Control Card Reader

REV:	DESCRIPTION:	BY:	DATE:
STATUS:		AS BUILT	
amspec DESIGN & BUILD SOLUTIONS f : 01942 621342 f : 01942 226552 www.amspec.co.uk			
CLIENT:	OBI 80 MOSLEY STREET MANCHESTER M2 3FX		
ARCHITECT:			
SITE:	18 LOWER BYROM STREET MANCHESTER		
TITLE:	LEVEL 2 RE-USED GLAZED SCREENS		
SCALE AT A2:	DATE:	DRAWN:	CHECKED:
1:50	18.11.19	CR	MS
PROJECT NO:	DRAWING NO:	REVISION:	
1683	02(22)400		