


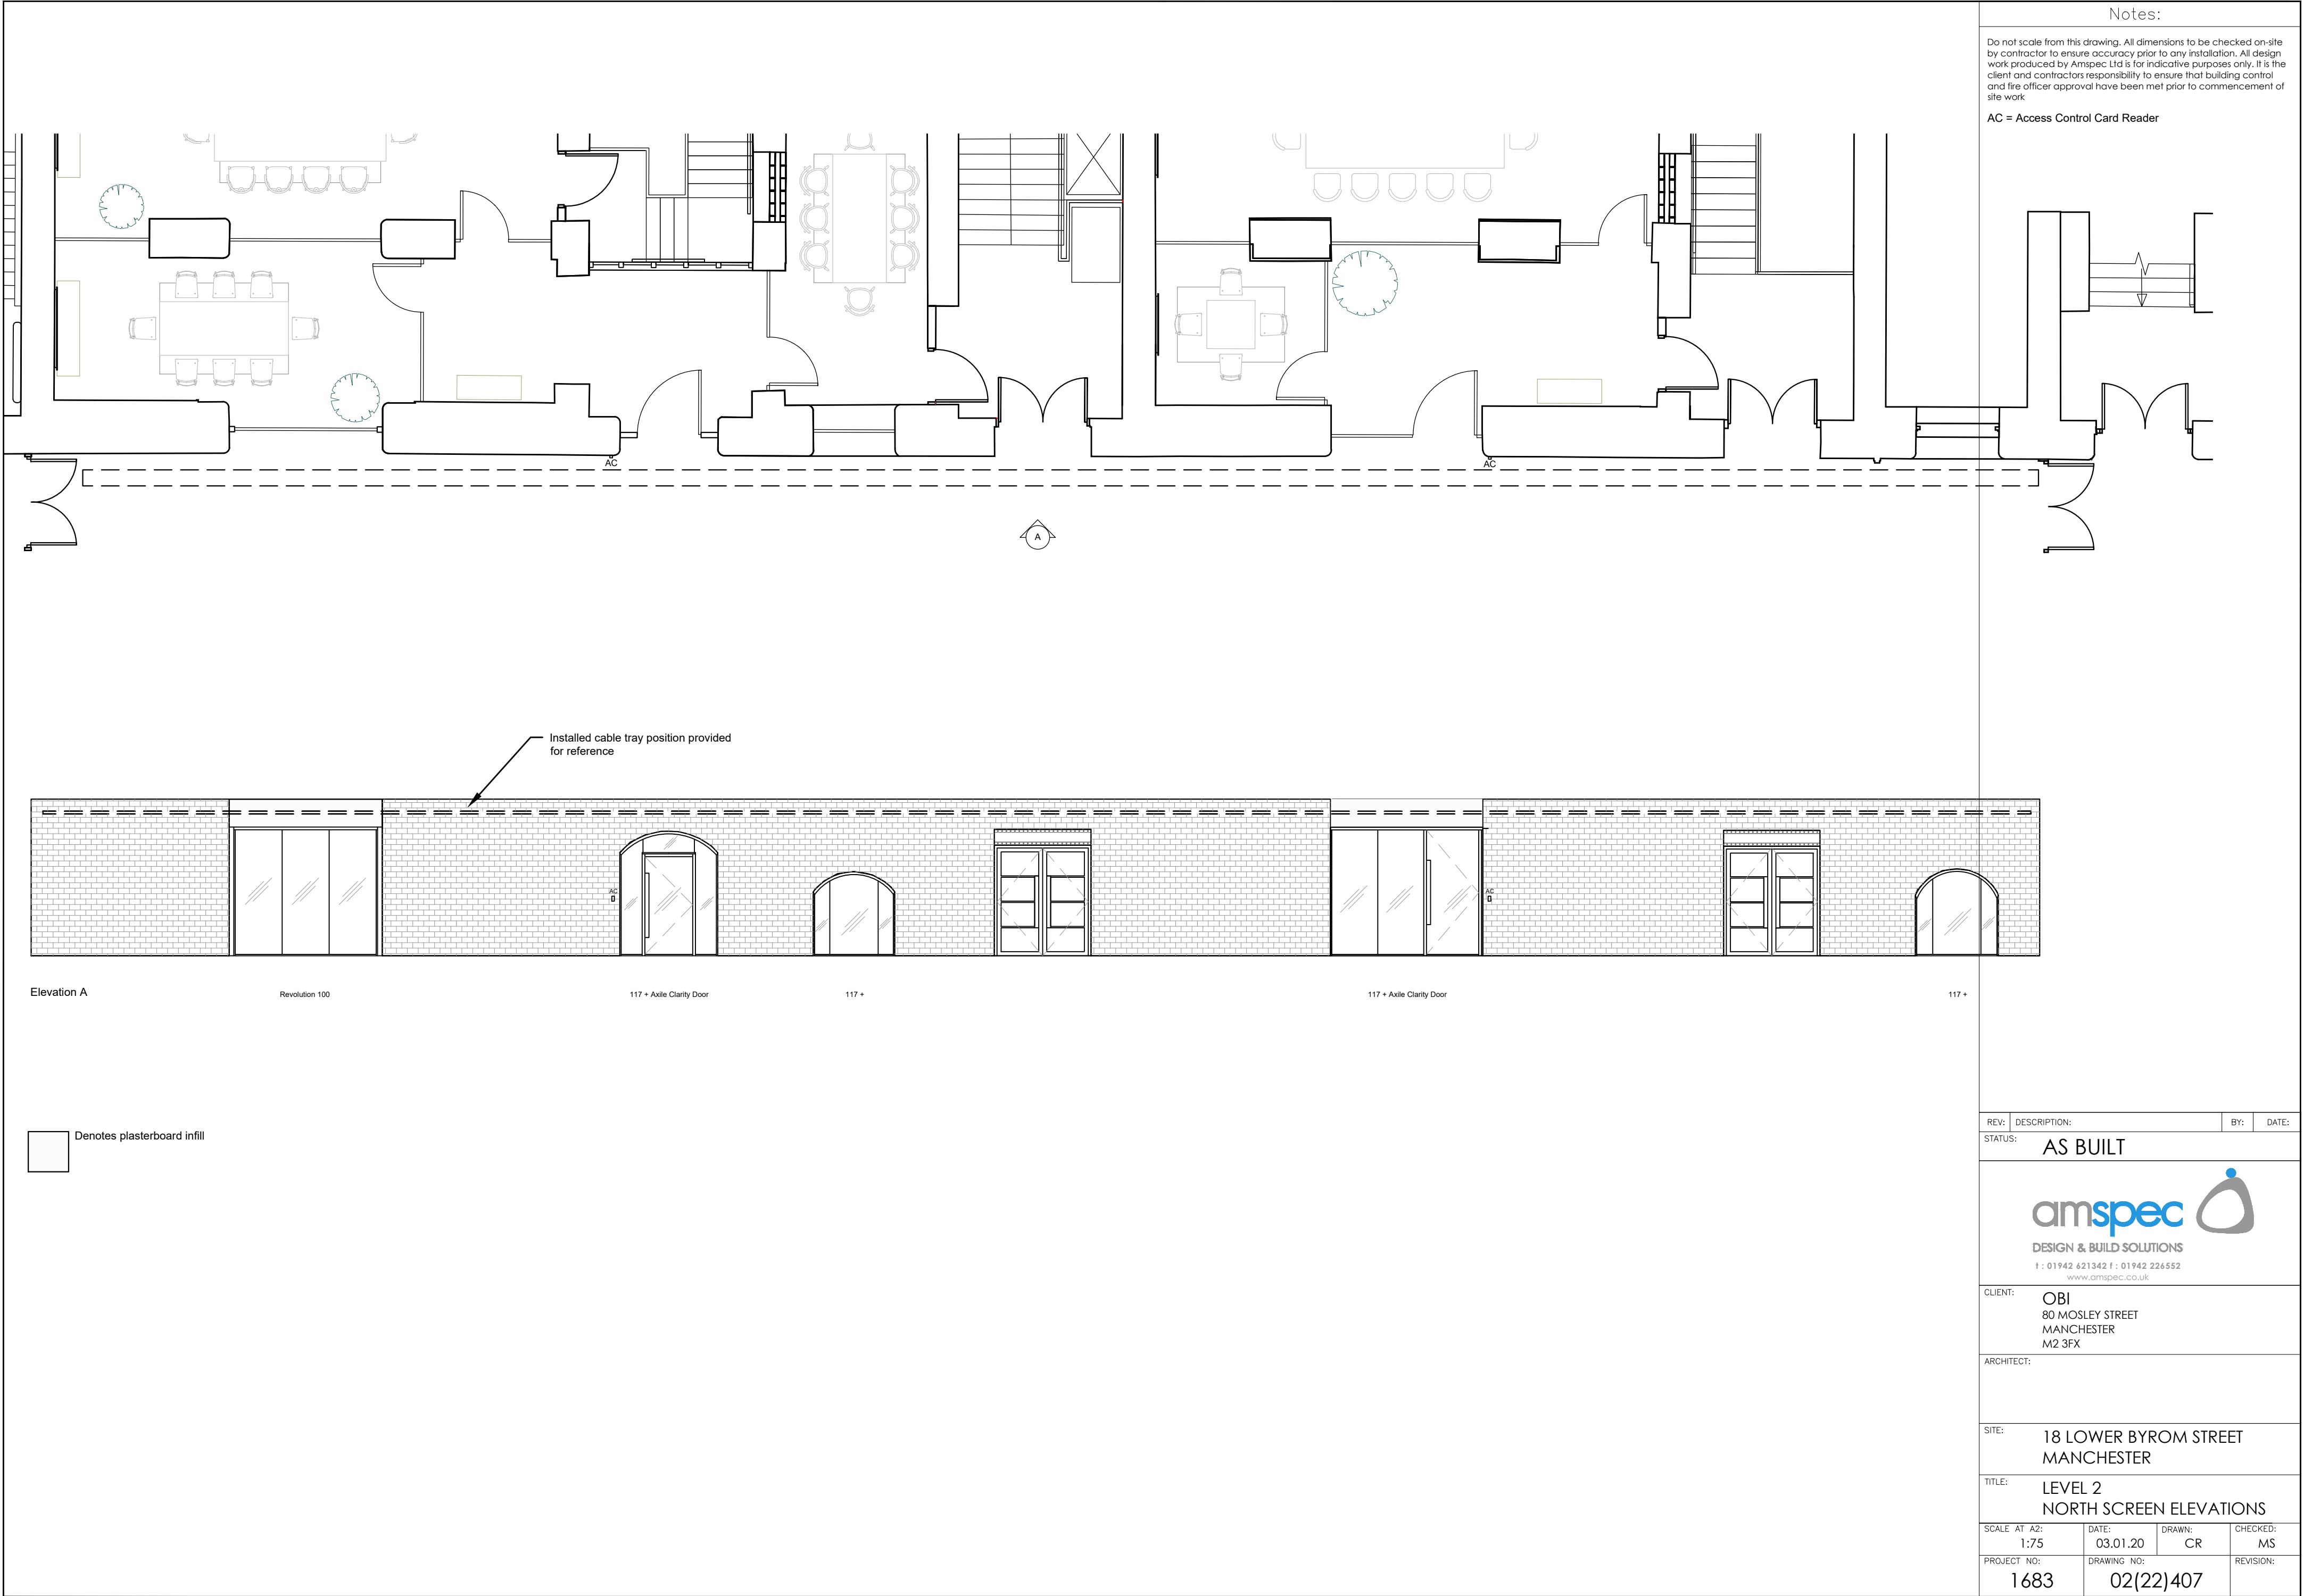

REV:	DESCRIPTION:	BY:	DATE:
STATUS:	AS BUILT		
CLIENT:	OBI 80 MOSLEY STREET MANCHESTER M2 3FX		
ARCHITECT:			
SITE:	18 LOWER BYROM STREET MANCHESTER		
TITLE:	LEVEL 2 NORTH SCREEN ELEVATIONS		
SCALE AT A2:	DATE:	DRAWN:	CHECKED:
1:75	03.01.20	CR	MS
PROJECT NO:	DRAWING NO:	REVISION:	
1683	02(22)407		